

Prepared For:
Anne Arundel County
Department of Public Works

Sloop Cove Stream Restoration

Year 2 Monitoring Report

16-NT-0193/2016-60858



November 2025

Prepared by:



"Integrating Engineering and Environment"

7455 New Ridge Road, Suite T Phone: (410) 694-9401
Hanover, Maryland 21076 Fax: (410) 694-9405
Website: www.baylandinc.com

TABLE OF CONTENTS

1. SUMMARY OF PROJECT DETAILS.....	1
1.1. Project Name.....	1
1.2. Corps Application Tracking Number & State Permit Number.....	1
1.3. Location of Completed Work (Latitude/Longitude).....	1
1.4. Dates of Construction	1
1.5. Applicant Contact Information	1
1.6. Consultant Contact Information	1
2. PROJECT OVERVIEW AND PURPOSE	2
3. PRE-RESTORATION AND POST-CONSTRUCTION CONDITIONS	5
3.1. As-Built Plans	5
3.1.1. Vertical Stability.....	5
4. PHOTOGRAPHS OF SITE	6
5. HYDROLOGY	7
5.1. Pre-Construction Conditions	7
6. GEOMORPHOLOGY	8
6.1. Habitat Assessment.....	8
6.2. Bed Material Characterization	9
7. BIOLOGY.....	10
7.1. Invasive Plants Assessment.....	10
7.2. Vegetation Viability.....	10
7.2.1. Vegetation Identification and Description	10
7.2.2. Vegetation Density and Richness.....	18
8. CONCLUSION	21
8.1. Key Findings	21
9. REFERENCES.....	22

LIST OF FIGURES

Figure 1 – Site Location Map	4
Figure 2 – Vegetation Monitoring Plot Locations	20

LIST OF TABLES

Table 1- Success Criteria for Stream Restoration and Enhancement	3
Table 2 – EPA RBP Results.....	8
Table 3 – 2024 Pebble Count Results.....	9
Table 4 – August 2025 Sloop Cove Vegetation Survey.....	12
Table 5 – Density and Richness of Shrubs & Trees Greater than 10 Inches High	18

APPENDICES

- Appendix A – Photographs
- Appendix B – USACE and MDE Permit Authorizations
- Appendix C – As-Built Plans

1. SUMMARY OF PROJECT DETAILS

1.1. Project Name

Sloop Cove Stream Restoration

1.2. Corps Application Tracking Number & State Permit Number

CENAB-OPR-MN-2016-60858
16-NT-0193

1.3. Location of Completed Work (Latitude/Longitude)

39.14833/-76.56278

1.4. Dates of Construction

October 2023 to June 2024

1.5. Applicant Contact Information

Mrs. Melissa Harlinski
2662 Riva Road, MS-7301,
Annapolis, MD 21401
410-222-4126

1.6. Consultant Contact Information

Zach Tate
Project Scientist
BayLand Consultants & Designers, Inc.
7455 New Ridge Road, Suite T
Hanover, MD 21076
410-694-9401
ztate@baylandinc.com

2. PROJECT OVERVIEW AND PURPOSE

The Sloop Cove Stream Restoration Project (the Project) was intended to restore the incised banks and valley bottom of a channel that drains into Sloop Cove in Glen Burnie, Maryland.

The Project was undertaken to address the stability of a degraded channel, consisting of a North Branch (a perennial stream channel) and a South Branch (an intermittent stream channel). The two branches, located in a valley bottom, had deeply incised banks and were actively deteriorating, resulting in the erosion and deposition of sediment into Sloop Cove after rain events. To minimize shear stress and reduce erosion, the bottom of the channel was raised, and uniform valley slopes were implemented all along the project reach. The width of each valley bottom was maximized to reduce depth and connect the channel to its floodplain. Along with flow control, this provided water quality benefits for the watershed and increased stormwater attenuation. After construction, the North and South Branch observed intermittent flow.

Permit approvals included U.S. Army Corps of Engineers (USACE) Permit No. 2016-60858 issued on May 2, 2022 and the Maryland Department of the Environment (MDE) No. 16-NT-0193 issued on October 25, 2021. The permit authorized the permanent impacts to 2,435 linear feet (LF) of perennial channel and 2,310 square feet of palustrine forested wetland. The Project temporarily impacted 60,995 feet of floodplain and permanently impacted 8,213 square feet of nontidal wetlands buffer. The Project is located at 8042 High Oak Road, Glen Burnie, Anne Arundel County, Maryland.

In accordance with the conditions outlined in the USACE and MDE permit authorizations, the permittee is required to maintain the authorized structures in compliance with the terms and conditions of the permit, as well as the approved plans dated January 2023. Additionally, the permittee must submit an as-built report upon completion of construction and conduct post-construction monitoring over a three-year period. Monitoring reports for Years 1 through 3 are to be submitted by December 31 of the respective monitoring year, in accordance with the permit conditions. MDE requires monitoring for three out of five years on Years 1, 3, and 5 following the completion of construction. However, if the Project is determined to be stable at the end of Year 3, the Authorized Person may request an exemption from the Year 5 stream monitoring requirement.

At a minimum, the monitoring protocols must include baseline conditions, as-built plans, routine inspections, quantifiable measurements of appropriate project-specific parameters based on project goals, stream and project stability monitoring, percent coverage of planted and native vegetation, invasive plant reduction, and photo documentation. Monitoring frequency and success criteria are outlined in Table 1.

This report covers Year 2 (2025) monitoring requirements per Special Condition 5 of the USACE permit authorization (Appendix B). It includes a detailed assessment of structural stability and overall condition, evaluation of vegetation establishment and


viability, and builds upon the baseline data collected during Year 1 (2024) monitoring. Table 1 shows performance standards for stream restoration as described in Condition 4 of the USACE permit authorization.

The Sloop Cove Stream is a multi-thread, partially perennial and partially intermittent channel. Year 2 photographs are included in Appendix A.

Table 1- Success Criteria for Stream Restoration and Enhancement

Level and Category	Parameter	Measurement	Success Criteria	Monitoring Years
Level 1 – Hydrology	Flow Classification (Perennial, Intermittent)	Visual	Meets or exceeds baseline	PC, 3
Level 2 – Hydraulics	NA	NA	NA	NA
Level 3 – Geomorphology	Photographs	Every 300 feet	No visual signs of problematic erosion	PC, 1, 2, 3
	Vertical Stability	Monumented Cross Sections	<0.5 ft thalweg degradation from as-built	AB, 3
	Lateral Stability	NA	NA	NA
	Habitat Assessment	EPA RBP high gradient	Exceeds Baseline	PC, 3
	Vegetative Cover	% cover	>85% cover in LOD	3
Level 4 – Water Quality	NA	NA	NA	NA
Level 5 – Biology	Invasive Plant Reduction	% cover of invasive species in LOD	Less than Baseline	PC, 3

*AB=As-built, PC=Pre-construction, 1-7 corresponds to the monitoring year following construction, NA=Not applicable, EPA RBP= Environmental Protection Agency Rapid Bioassessment Protocol, LOD=Limits of Disturbance

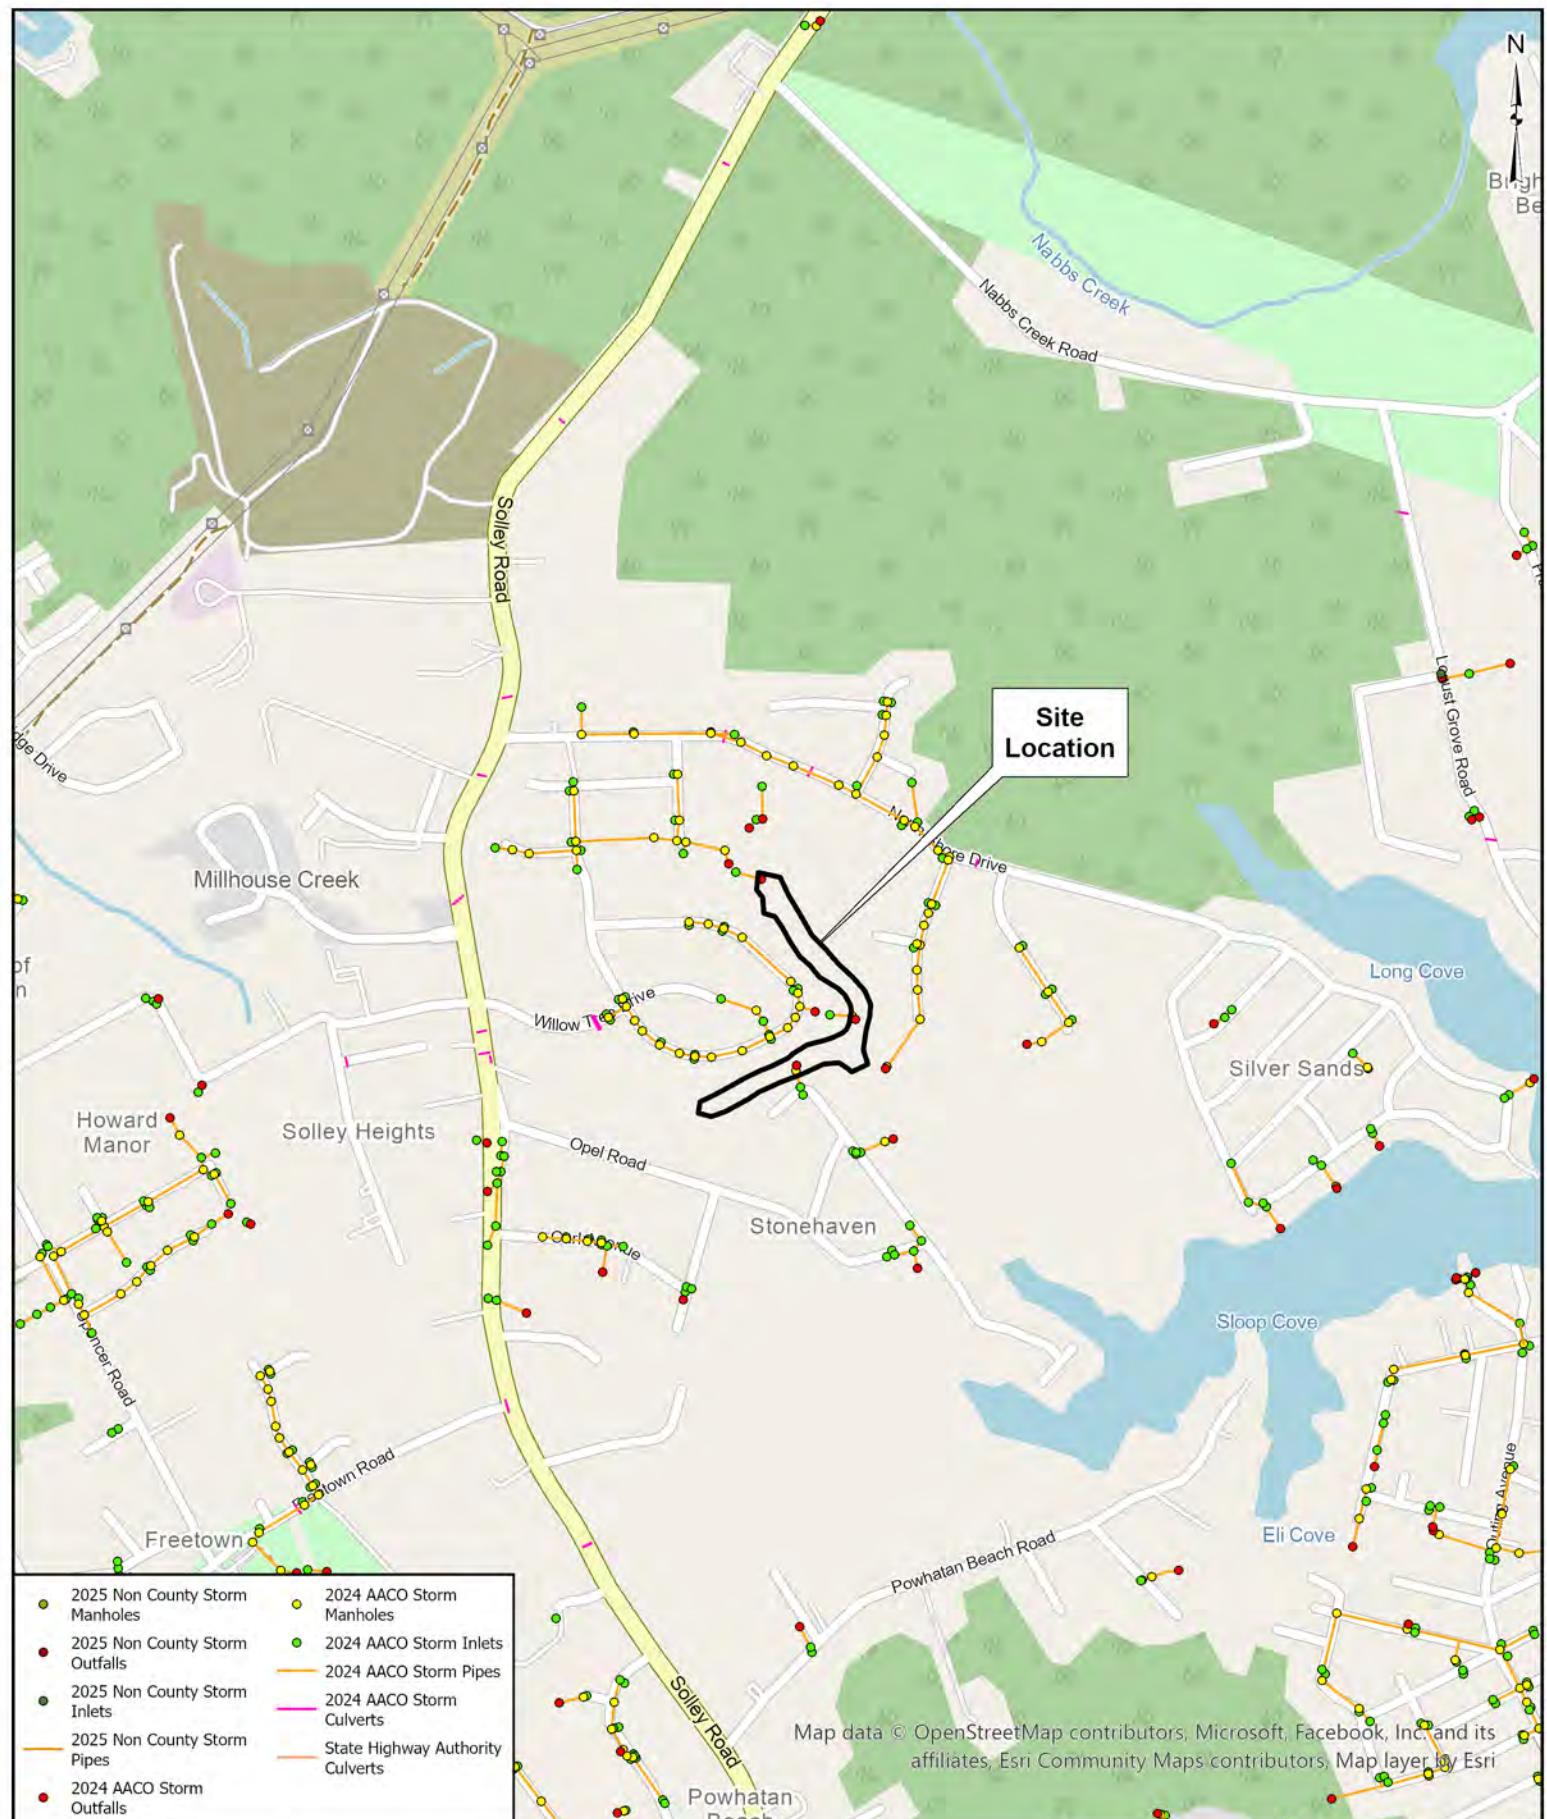

Location: 39.14833 / -76.56278 (Latitude/Longitude)

Address: 8042 High Oak Road, Glen Burnie
Anne Arundel County, Maryland

Bayland
Consultants & Designers, Inc.
"Integrating Engineering and Environment"
7455 New Ridge Road, Suite T
Hanover, Maryland 21076
Phone: (410) 694-9401
Fax: (410) 694-9405
Website: www.baylandinc.com

Figure 1
Sloop Cove
Site Location Map

3. PRE-RESTORATION AND POST-CONSTRUCTION CONDITIONS

3.1. As-Built Plans

The as-built survey was conducted at Sloop Cove Stream on June 18, 2024 to document the current state of the reaches, evaluate stream stability, and establish a baseline condition for the USACE three-year monitoring period. Surveyed as-built drawings to scale with control depicting the final work, are included as Appendix C.

3.1.1. Vertical Stability

The vertical stability of as-built conditions was assessed by surveying and recording bed elevations at 16 monumented cross sections. The as-built cross sections are shown on Sheets 8 through 13 of the As-Built Plans. The surveyed cross-section elevations are consistent with the design plans, exhibiting minimal deviation between the as-built measurements and the proposed conditions specified in the design plans. The cross section measurements will be used as a baseline for comparing changes in the vertical stability for Year 3 (2025).

In Year 1, the as-built cross sections were evaluated, found to be consistent with design, and showed no evidence of thalweg degradation. A vertical stability assessment was not performed in Year 2, but this parameter will be evaluated again in Year 3 in order to document the stability of restoration conditions.

4. PHOTOGRAPHS OF SITE

Photographic documentation was performed during each site visit to establish a comprehensive record of the condition of all constructed features and structures within the project reaches. This photographic record serves to illustrate project success and identify any areas exhibiting instability or requiring corrective action.

During the Year 2 annual stream monitoring visit on October 7, 2025, photographs were systematically captured along the entire project work area at intervals of no more than 300 feet. Photographs were also established at nine locations and taken from consistent vantage points to facilitate direct comparison during subsequent monitoring events. Several pre-construction photos were also used to be able to compare pre- and post-restoration conditions at similar locations along the project reaches. This standardized approach ensures continuity and accuracy in the evaluation of project performance over time.

Photographic documentation provided a visual comparison of pre-construction and post-construction conditions (Appendix A), clearly illustrating improvements in channel stability, floodplain connectivity, and habitat quality. The images demonstrate the success of the stream restoration efforts, showcasing reduced bank erosion, enhanced floodplain connectivity, and the establishment of riparian vegetation. Compared to photographs taken in Year 1, the channel area along the North, South, and Main Stems is beginning to flourish with wetland vegetation. The banks and structures all remained stable, and the expected increase in vegetative growth will serve to further support a stable channel and productive ecosystem.

5. HYDROLOGY

5.1. Pre-Construction Conditions

The North Branch and South Branch are both tributaries of Sloop Cove. Pre-construction, the North Branch was a perennial channel, and the South Branch was an intermittent stream channel. The two branches join into a perennial main stem that is approximately 1,400 feet upstream to the mouth of Sloop Cove. The drainage area of the North Branch is approximately 93 acres, while the drainage area for the South Branch is approximately 56 acres. Prior to restoration, surface runoff after rain events would drain into the valley channel, which was already destabilized by past land manipulation, and flow downstream in a singular, high velocity stream. The force of the stormwater led to the vertical and horizontal degradation of the stream channel over time, creating an entrenched channel with deeply incised banks. The sediment that eroded from the banks would then be carried downstream into Sloop Cove, causing a slow build-up of sediment that impacted habitat and necessitated dredging (Land Studies, 2016).

Post-construction hydrology will be evaluated through visual assessments conducted during Year 3 monitoring to determine whether it meets or exceeds the established baseline conditions.

6. GEOMORPHOLOGY

6.1. Habitat Assessment

The EPA Rapid Bioassessment Protocol (RBP) habitat assessment is a standardized methodology used to evaluate physical habitat conditions within stream systems. This protocol assesses key habitat parameters, including substrate composition, channel morphology, bank stability, riparian buffer quality, and flow characteristics, to determine overall stream health and ecological functionality.

For the Project, the RBP habitat assessment was conducted to establish baseline conditions prior to construction and evaluate post-construction improvements. Metrics such as sediment deposition, embeddedness, and bank erosion were quantified to determine habitat quality and stability. The results of the assessment provide a comparative analysis of pre- and post-restoration conditions, serving as a performance indicator for the effectiveness of the implemented design.

The pre-construction RBP scoring results were estimated using pre-construction photos and the existing biology section of the *Functional Uplift Assessment Report* (Land Studies, 2016). The pre-construction RBP scoring results are included in Table 2 and indicate little to no macroinvertebrate or fish community exists within the channel. The channel bed has downcut through multiple feet of sandy loam and into the underlying clay parent material. As a result, the existing bed materials areas provide little to no habitat in terms of epifaunal substrate (Land Studies, 2016). This will be compared to post-construction conditions in Year 3.

Table 2 – EPA RBP Results			
Rating System	Measurement Index	Sloop Cove Pre-Restoration Score	Pre-Restoration Narrative Ranking
EPA RBP	Aquatic Habitat	74	Marginal Stream Conditions

The EPA RBP will be assessed again in Year 3 and scores should increase across most parameters, especially as vegetation becomes established during the next few growing seasons.

6.2. Bed Material Characterization

Bed material was analyzed using the Wolman Pebble count methodology. Two pebble counts were taken in Year 1, including a representative count in the North Branch and at the Cross Section 1 weir step (Table 3).

A pebble count will be conducted again in Year 3, as it is a biennial requirement by MDE, and will be compared to the Year 1 pebble count results to quantify the mobilization of substrate material.

Table 3 – 2024 Pebble Count Results		
Parameter	XS-1	Representative
D ₃₅	0.062	0.062
D ₅₀	0.53	1.1
D ₈₄	3.8	9.6
D ₉₅	7.1	27

7. BIOLOGY

7.1. Invasive Plants Assessment

An assessment of pre-construction conditions was based on a *Simplified Forest Stand Delineation Report* (Wetland Studies and Solutions, Inc., 2019) and identified the presence and extent of invasive plant species based on 1/100th acre plot. The within the project Limits of Disturbance (LOD). Plot 1, located along the South Branch, was estimated to have 25 percent invasive vegetation cover, with *Celastrus orbiculatus* (Oriental bittersweet) identified as the dominant species. As Plot 1 is the only plot with available pre-construction data on invasive species cover, this area along the South Branch will be reassessed in Year 3 to evaluate changes and measure the effectiveness of invasive species management efforts.

During construction at a segment of the downstream end of the North Branch, invasive bamboo (*Phyllostachys spp.*) was eradicated using a combination of mechanical removal and targeted herbicide application. The removal of invasive bamboo in this area supports the restoration objectives by promoting the establishment of native plant species and enhancing riparian habitat quality. Monitoring will continue to ensure successful long-term suppression of bamboo and other invasive species.

This baseline data establishes a reference point for evaluating changes in invasive species coverage and the success of future riparian restoration and management efforts.

7.2. Vegetation Viability

Post-construction monitoring of vegetation viability is conducted to assess the establishment, health, and success of planted and naturally regenerating vegetation within the project area, as required by state permit conditions. Monitoring involves quantitative visual assessments of plant species composition, abundance, and percent ground cover within riparian and wetland zones. To facilitate consistent data collection, 10 permanent monitoring plots (Figure 2) were established in 2024 using rebar markers, allowing for precise replication in subsequent monitoring years.

Monitoring results will determine whether vegetation meets established success criteria outlined in the state permit and guide any necessary corrective actions, such as supplemental planting or invasive species management, to support long-term stabilization and ecological function.

7.2.1. Vegetation Identification and Description

Species composition and abundance were documented at the 10 monitoring plot locations within the restored channel's floodplain during a site visit conducted on August 6, 2025. This assessment was performed during the peak growing season to capture optimal vegetation conditions. Data collected includes the number of living trees and

shrubs exceeding 10 inches in height, presented in approximate order of percent cover, as detailed in Table 4. Additionally, the species of plants under 10 inches in height and the percentage of bare ground within each plot were recorded and are also summarized in Table 4.

Table 4 – August 2025 Sloop Cove Vegetation Survey

Cross Section	Plot #	Location	Number of Living Trees or Shrubs at Least 10" in Height	Tree/Shrub Plant Species (greater than 10" high)	Herbaceous Plant Species (less than 10" high)	Percent Bare Ground
NA	1	Right Bank	1	<ul style="list-style-type: none"> Bald cypress (<i>Taxodium distichum</i>) 	<ul style="list-style-type: none"> soft rush (<i>Juncus effusus</i>) white turtlehead (<i>Chelone glabra</i>) red maple (<i>Acer rubrum</i>) lurid sedge (<i>Carex lurida</i>) eastern redbud (<i>Cercis canadensis</i>) upland bentgrass (<i>Agrostis perennans</i>) crooked-stemmed aster (<i>Symphyotrichum prenanthoides</i>) small-spiked false nettle (<i>Boehmeria cylindrica</i>) Virginia wildrye (<i>Elymus virginicus</i>) wild bergamot (<i>Monarda fistulosa</i>) white clover (<i>Trifolium repens</i>) blue ridge blueberry (<i>Vaccinium pallidum</i>) roundleaf greenbrier (<i>Smilax rotundifolia</i>) sweet gum (<i>Liquidambar styraciflua</i>) late-flowering thoroughwort (<i>Eupatorium serotinum</i>) 	85
NA	2	Left Bank	2	<ul style="list-style-type: none"> Eastern redcedar (<i>Juniperus virginiana</i>) Sweetbay (<i>Magnolia virginiana</i>) 	<ul style="list-style-type: none"> white oak (<i>Quercus alba</i>) upland bentgrass (<i>Agrostis perennans</i>) trailing lespedeza (<i>Lespedeza procumbens</i>) white turtlehead (<i>Chelone glabra</i>) red maple (<i>Acer rubrum</i>) lurid sedge (<i>Carex lurida</i>) common boneset (<i>Eupatorium perfoliatum</i>) swamp milkweed (<i>Asclepias incarnata</i>) white clover (<i>Trifolium repens</i>) blue mistflower (<i>Conoclinium coelestinum</i>) Virginia wildrye (<i>Elymus virginicus</i>) dog fennel (<i>Eupatorium capillifolium</i>) 	90

Table 4 – August 2025 Sloop Cove Vegetation Survey

Cross Section	Plot #	Location	Number of Living Trees or Shrubs at Least 10" in Height	Tree/Shrub Plant Species (greater than 10" high)	Herbaceous Plant Species (less than 10" high)	Percent Bare Ground
NA	3	Left Bank	1	<ul style="list-style-type: none"> Eastern redcedar (<i>Juniperus virginiana</i>) 	<ul style="list-style-type: none"> lurid (<i>Carex lurida</i>) white turtlehead (<i>Chelone glabra</i>) soft rush (<i>Juncus effusus</i>) whitegrass (<i>Leersia virginica</i>) coastal sweet pepperbush (<i>Clethra alnifolia</i>) soft rush (<i>Juncus effusus</i>) poverty rush (<i>Juncus tenuis</i>) common boneset (<i>Eupatorium perfoliatum</i>) green bulrush (<i>Scirpus atrovirens</i>) marsh seedbox (<i>Ludwigia palustris</i>) Virginia wildrye (<i>Elymus virginicus</i>) late-flowering thoroughwort (<i>Eupatorium serotinum</i>) 	30

Table 4 – August 2025 Sloop Cove Vegetation Survey

Cross Section	Plot #	Location	Number of Living Trees or Shrubs at Least 10" in Height	Tree/Shrub Plant Species (greater than 10" high)	Herbaceous Plant Species (less than 10" high)	Percent Bare Ground
NA	4	Right Bank	1	<ul style="list-style-type: none"> Bald cypress (<i>Taxodium distichum</i>) 	<ul style="list-style-type: none"> lurid sedge (<i>Carex lurida</i>) trailing lespedeza (<i>Lespedeza procumbens</i>) coastal sweet pepperbush (<i>Clethra alnifolia</i>) roundleaf greenbrier (<i>Smilax rotundifolia</i>) red maple (<i>Acer rubrum</i>) lowbush blueberry (<i>Vaccinium angustifolium</i>) blue ridge blueberry (<i>Vaccinium pallidum</i>) common boneset (<i>Eupatorium perfoliatum</i>) butterfly milkweed (<i>Asclepias tuberosa</i>) late-flowering thoroughwort (<i>Eupatorium serotinum</i>) green bulrush (<i>Scirpus atrovirens</i>) common sowthistle (<i>Sonchus oleraceus</i>) hairy crabgrass (<i>Digitaria sanguinalis</i>) white mulberry (<i>Morus alba</i>) common yellow woodsorrel (<i>Oxalis stricta</i>) Allegheny hawkweed (<i>Hieracium paniculatum</i>) sweet gum (<i>Liquidambar styraciflua</i>) 	70

Table 4 – August 2025 Sloop Cove Vegetation Survey

Cross Section	Plot #	Location	Number of Living Trees or Shrubs at Least 10" in Height	Tree/Shrub Plant Species (greater than 10" high)	Herbaceous Plant Species (less than 10" high)	Percent Bare Ground
NA	5	Right Bank	0		<ul style="list-style-type: none"> • rough barnyardgrass (<i>Echinochloa muricata</i>) • lurid sedge (<i>Carex lurida</i>) • red maple (<i>Acer rubrum</i>) • sericea lespedeza (<i>Lespedeza cuneata</i>) • whitegrass (<i>Leersia virginica</i>) • white clover (<i>Trifolium repens</i>) • butterfly milkweed (<i>Asclepias tuberosa</i>) • common boneset (<i>Eupatorium perfoliatum</i>) • blue ridge blueberry (<i>Vaccinium pallidum</i>) • porcelain berry (<i>Ampelopsis glandulosa</i>) • green bulrush (<i>Scirpus atrovirens</i>) • Allegheny hawkweed (<i>Hieracium paniculatum</i>) • Virginia wildrye (<i>Elymus virginicus</i>) 	70
NA	6	Right Bank	3	<ul style="list-style-type: none"> • 2 - Bald cypress (<i>Taxodium distichum</i>) • Common winterberry (<i>Ilex verticillata</i>) 	<ul style="list-style-type: none"> • common rush (<i>Juncus effusus</i>) • red maple (<i>Acer rubrum</i>) • poverty rush (<i>Juncus tenuis</i>) • Virginia wildrye (<i>Elymus virginicus</i>) • sericea lespedeza (<i>Lespedeza cuneata</i>) • rough barnyardgrass (<i>Echinochloa muricata</i>) • American burnweed (<i>Erechtites hieraciifolius</i>) • redtop panicgrass (<i>Coleataenia rigidula</i>) • hairy crabgrass (<i>Digitaria sanguinalis</i>) 	85

Table 4 – August 2025 Sloop Cove Vegetation Survey

Cross Section	Plot #	Location	Number of Living Trees or Shrubs at Least 10" in Height	Tree/Shrub Plant Species (greater than 10" high)	Herbaceous Plant Species (less than 10" high)	Percent Bare Ground
NA	7	Right Bank	4	<ul style="list-style-type: none"> Pin oak (<i>Quercus palustris</i>) Eastern redcedar (<i>Juniperus virginiana</i>) American holly (<i>Ilex opaca</i>) common winterberry (<i>Ilex verticillata</i>) 	<ul style="list-style-type: none"> trailing lespedeza (<i>Lespedeza procumbens</i>) red maple (<i>Acer rubrum</i>) whitegrass (<i>Leersia virginica</i>) red clover (<i>Trifolium pratense</i>) Virginia wildrye (<i>Elymus virginicus</i>) common boneset (<i>Eupatorium perfoliatum</i>) squarrose sedge (<i>Carex squarrosa</i>) lurid sedge (<i>Carex lurida</i>) blue vervain (<i>Verbena hastata</i>) sweet gum (<i>Liquidambar styraciflua</i>) crownvetch (<i>Securigera varia</i>) slender yellow woodsorrel (<i>Oxalis dillenii</i>) butterfly milkweed (<i>Asclepias tuberosa</i>) 	60
NA	8	Left Bank	1	<ul style="list-style-type: none"> Sweetbay (<i>Magnolia virginiana</i>) 	<ul style="list-style-type: none"> lurid sedge (<i>Carex lurida</i>) red maple (<i>Acer rubrum</i>) marsh seedbox (<i>Ludwigia palustris</i>) porcelain berry (<i>Ampelopsis glandulosa</i>) blue vervain (<i>Verbena hastata</i>) Virginia creeper (<i>Parthenocissus quinquefolia</i>) red maple (<i>Acer rubrum</i>) eastern gamagrass (<i>Tripsacum dactyloides</i>) Virginia wildrye (<i>Elymus virginicus</i>) butterfly milkweed (<i>Asclepias tuberosa</i>) Queen Anne's lace (<i>Ducus carota</i>) 	75

Table 4 – August 2025 Sloop Cove Vegetation Survey

Cross Section	Plot #	Location	Number of Living Trees or Shrubs at Least 10" in Height	Tree/Shrub Plant Species (greater than 10" high)	Herbaceous Plant Species (less than 10" high)	Percent Bare Ground
NA	9	Left Bank	1	<ul style="list-style-type: none"> Red maple (<i>Acer rubrum</i>) 	<ul style="list-style-type: none"> red maple (<i>Acer rubrum</i>) roundleaf greenbrier (<i>Smilax rotundifolia</i>) common rush (<i>Juncus effusus</i>) blue vervain (<i>Verbena hastata</i>) lurid sedge (<i>Carex lurida</i>) common boneset (<i>Eupatorium perfoliatum</i>) Virginia wildrye (<i>Elymus virginicus</i>) marsh seedbox (<i>Ludwigia palustris</i>) sweet gum (<i>Liquidambar styraciflua</i>) green bulrush (<i>Scirpus atrovirens</i>) redtop panicgrass (<i>Coleataenia rigidula</i>) 	40
NA	10	Right Bank	3	<ul style="list-style-type: none"> American holly (<i>Ilex opaca</i>) Eastern redcedar (<i>Juniperus virginiana</i>) Northern spicebush (<i>Lindera benzoin</i>) 	<ul style="list-style-type: none"> Chinese wisteria (<i>Wisteria sinensis</i>) Virginia wildrye (<i>Elymus virginicus</i>) 	95

7.2.2. Vegetation Density and Richness


Vegetation density was quantified by calculating the number of woody plants exceeding 10 inches in height relative to the surface area of each sample plot. Each plot consists of a six-foot radius circular area, encompassing a total surface area of 113.1 square feet. Species richness, defined as the total number of distinct plant species over 10 inches in height, was also recorded for each plot as a general indicator of biodiversity. While species richness provides insights into overall species diversity, it does not account for the proportional abundance or spatial distribution of individual species within the plots. The results of the vegetation density and species richness assessments conducted in September 2024 and 2025 are presented in Table 5.

Table 5 – Density and Richness of Shrubs & Trees Greater than 10 Inches High			
2024			
Plot #	Location of Plot Center Point	Plant Density (#/ft ²)	Species Richness
1	Right bank	<0.01	1
2	Left bank	0.02	2
3	Left bank	0.02	2
4	Right bank	0.03	3
5	Right bank	<0.01	1
6	Left bank	0.02	2
7	Right bank	0.04	4
8	Left bank	<0.01	1
9	Left bank	<0.01	1
10	Right bank	0.04	4
2025			
Plot #	Location of Plot Center Point	Plant Density (#/ft ²)	Species Richness
1	Right bank	<0.01	1
2	Left bank	0.02	2
3	Left bank	<0.01	1
4	Right bank	<0.01	1
5	Right bank	0	0
6	Right bank	0.02	2
7	Right bank	0.04	4
8	Left bank	<0.01	1
9	Left bank	<0.01	1
10	Right bank	0.03	3

In Year 2, tree and shrub abundance and diversity decreased slightly compared to 2024 (Year 1). This reduction could be attributed to factors such as deer browsing, competition, or natural plant mortality. The decrease in abundance likely contributed to the lower species richness observed in Year 2. However, despite some evidence of browsing, most surviving trees and shrubs exhibited noticeable growth and were larger in 2025 than in 2024.

Plot #10 was the only plot found to have a decrease in plant cover (primarily herbaceous) from 2024 to 2025. The upstream extent of the southern reach appeared to have been treated for invasive plants using a broad-spectrum herbicide.

It is expected that Year 3 (2026) and future monitoring will demonstrate an increase in vegetation density as plants mature and additional growth occurs within the restored area. These trends will be assessed to ensure the site continues to meet performance standards and long-term ecological objectives.

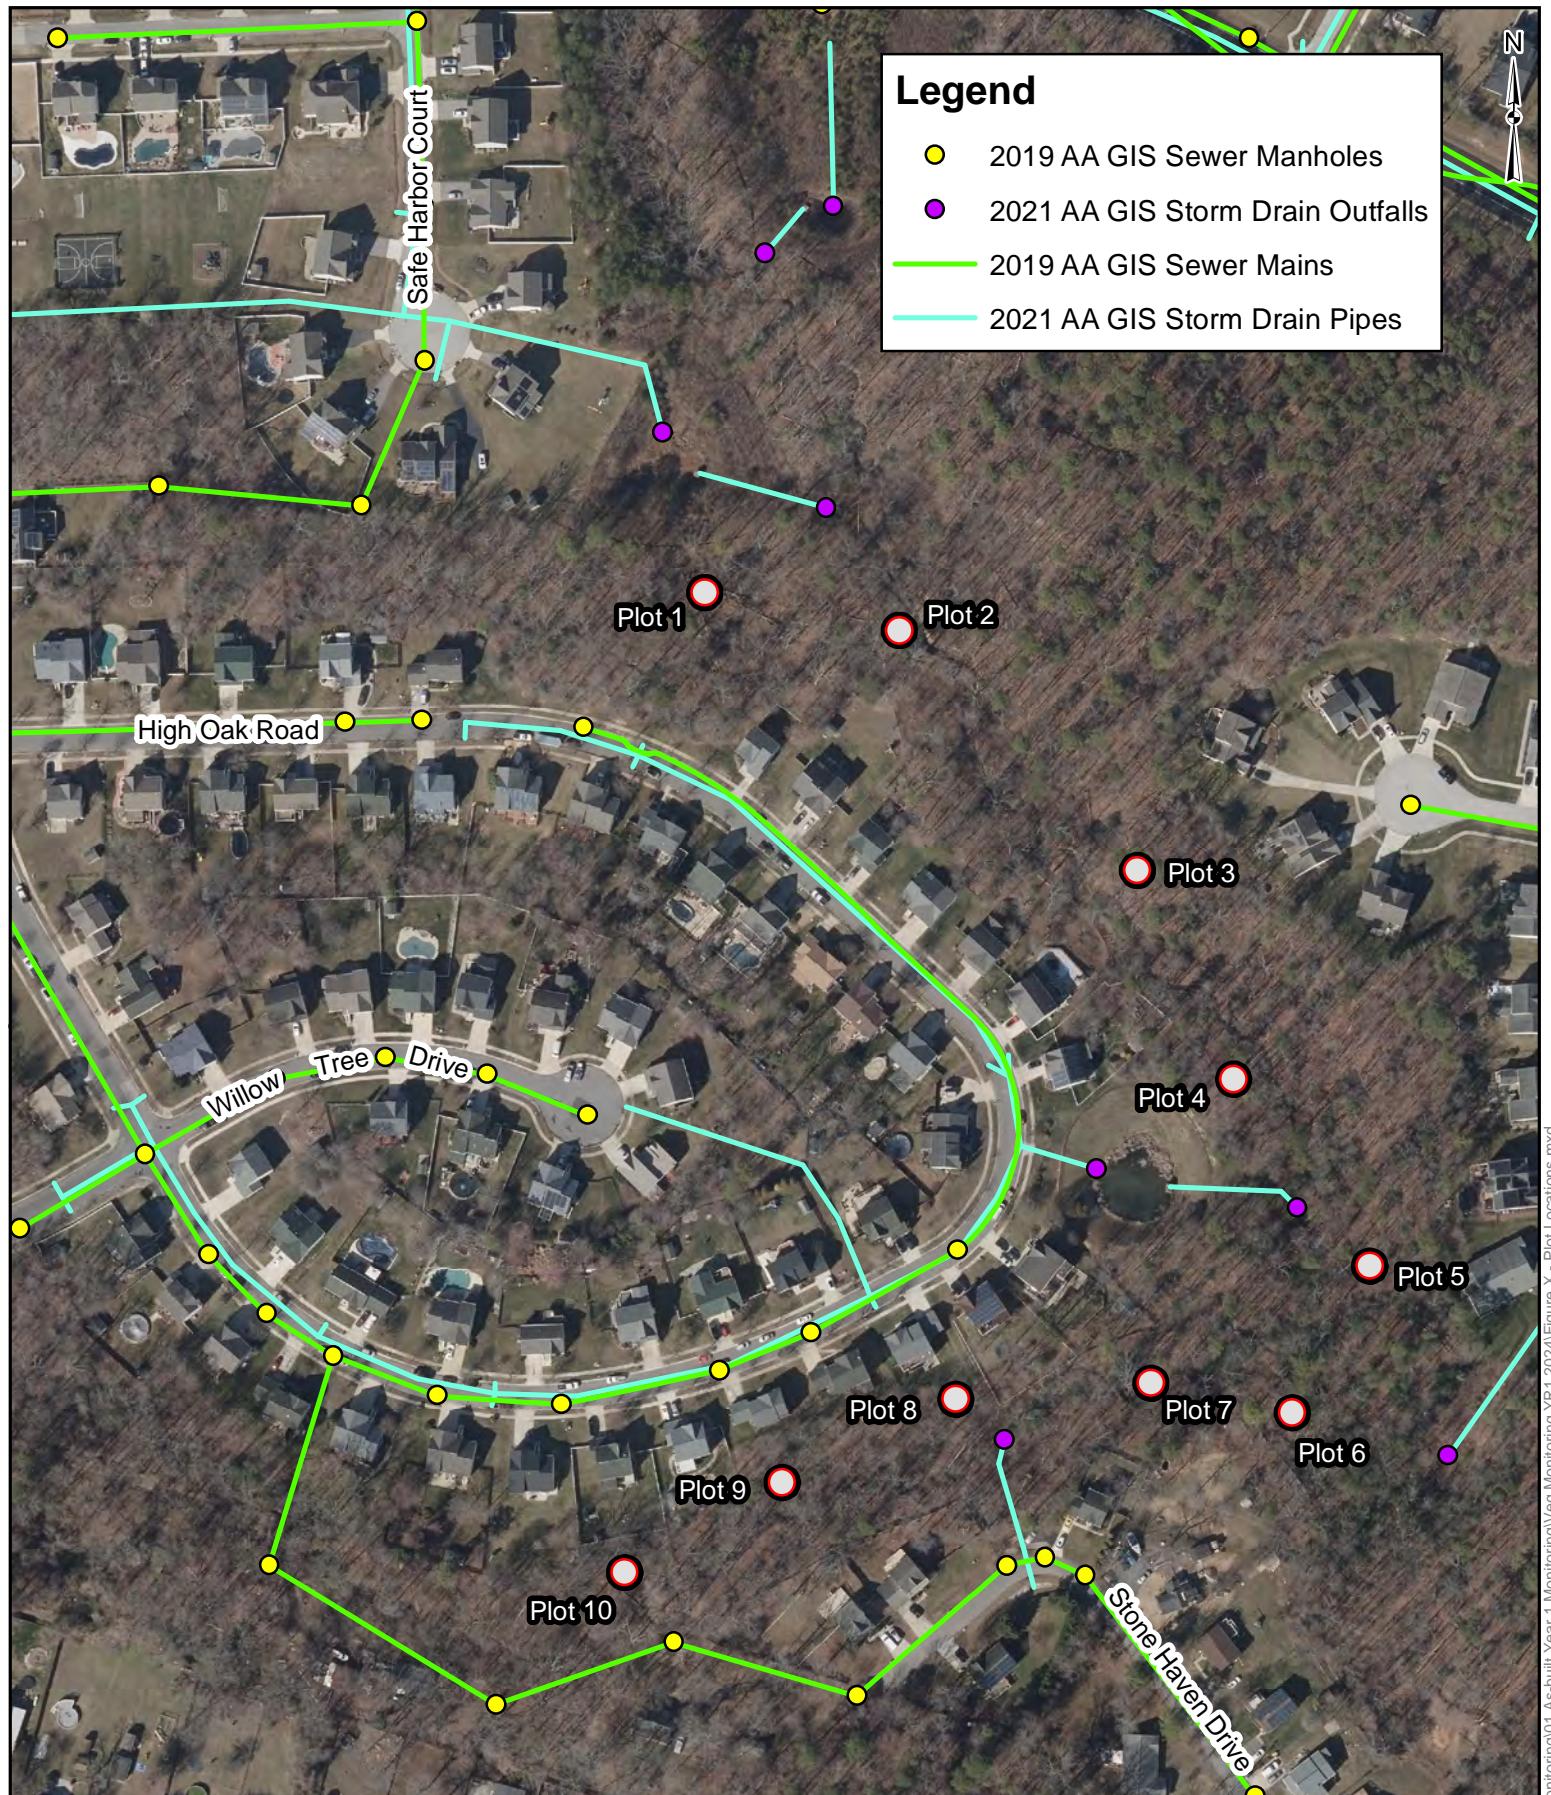

200 100 0 200
1" = 200' Feet

BayLand
Consultants & Designers, Inc.
"Integrating Engineering and Environment"
7455 New Ridge Road, Suite T
Hanover, Maryland 21076
Phone: (410) 694-9401
Fax: (410) 694-9405
Website: www.baylandinc.com

Figure 2
Sloop Cove
Vegetation Monitoring
Plot Locations

8. CONCLUSION

The Sloop Cove Stream Restoration Project continues to demonstrate progress toward long-term stability and ecological recovery within the North and South Branch channels for Year 2. The Project's regenerative design has effectively stabilized previously incised banks, reestablished floodplain connectivity, and reduced sediment delivery to Sloop Cove. Construction was completed in compliance with USACE and MDE permit conditions, and the Year 1 monitoring results established a solid baseline for assessing subsequent site performance. Year 2 monitoring results were compared to Year 1 where applicable and will also be evaluated against Year 3 results to assess trends over time.

8.1. Key Findings

Photographic Documentation: Photo documentation at permanent photo stations confirmed continued stabilization of constructed features and floodplain benches. Comparison of Year 1 and Year 2 photographs shows increased vegetative cover, improved bank stability, and the development of emergent and riparian vegetation along the channel margins. Minor areas of bare soil observed immediately post-construction are now largely vegetated, and no significant signs of erosion or channel adjustment were noted.

Vegetation Viability: Monitoring at 10 permanent plots indicated relatively consistent tree and shrub density across the floodplain, with the exception of the upstream extent of the southern reach. Minor reductions in species richness were observed, which could be attributed to natural mortality or browsing pressure. Most surviving vegetation exhibited increased height and vigor, consistent with expectations for Year 2 growth.

Overall, the Year 2 results indicate that the Project remains stable and continues to progress toward meeting the performance standards outlined in the USACE and MDE permits. Observed conditions support the conclusion that the restored stream and floodplain are developing as intended, with improving vegetation structure and habitat function. Year 3 monitoring will provide a critical performance evaluation to confirm vertical stability, habitat enhancement, and vegetation viability and cover, ensuring the site remains on a positive trajectory toward achieving full ecological success and long-term sustainability.

9. REFERENCES

Land Studies. May 2016. *Sloop Cove Retrofit Design Report*.

Land Studies. May 2016. *Sloop Cove Retrofit Functional Uplift Assessment Report*.

Wetland Studies and Solutions, Inc. January 2019. *Sloop Cove Stream Restoration Simplified Forest Stand Delineation Report*.

APPENDIX A

Photographs

Sloop Cove Year 2 Monitoring Photos



Upstream end of North Branch (October 7, 2025)



Middle of North Branch (October 7, 2025)



Middle of North Branch (October 7, 2025)



Downstream end of North Branch (October 7, 2025)



Main stem (October 7, 2025)



Main stem (October 7, 2025)



Downstream end of South Branch (October 7, 2025)



Middle of South Branch (October 7, 2025)



Upstream end of South Branch (October 7, 2025)



Outfall upstream of North Branch (October 7, 2025)



Main stem that connects to Sloop Cove (October 7, 2025)



Tree near Photo Location 2 (October 7, 2025)

Pre-Construction AB-XS10

February 2019 upstream

Post-Construction AB-XS10

October 2024 downstream



October 2024 upstream



October 2025 downstream



October 2025 upstream

Pre-Construction AB-XS4



January 2008 upstream



January 2008 downstream

Post-Construction AB-XS4



October 2024 downstream



October 2024 upstream



October 2025 downstream



October 2025 upstream

*Note: Pre- and post-construction photos are not located at the same exact location. However, post-construction photo locations will be replicated throughout the 3-year monitoring period.

Photo Location 1



October 2024 upstream (Year 1)



October 2024 downstream (Year 1)



October 2025 upstream (Year 2)



October 2025 downstream (Year 2)

Photo Location 2



October 2024 upstream (Year 1)



October 2024 downstream (Year 1)



October 2025 upstream (Year 2)



October 2025 downstream (Year 2)

Photo Location 3



October 2024 upstream (Year 1)



October 2024 downstream (Year 1)



October 2025 upstream (Year 2)



October 2025 downstream (Year 2)

Photo Location 4



October 2024 upstream (Year 1)



October 2024 downstream (Year 1)



October 2025 upstream (Year 2)



October 2025 downstream (Year 2)

Photo Location 5



October 2024 (Year 1)



October 2025 (Year 2)

Photo Location 6



October 2024 (Year 1)



October 2025 (Year 2)

Photo Location 7



October 2024 upstream (Year 1)



October 2024 downstream (Year 1)



October 2025 upstream (Year 2)



October 2025 downstream (Year 2)

Photo Location 8



October 2024 upstream (Year 1)



October 2024 downstream (Year 1)



October 2025 upstream (Year 2)



October 2025 downstream (Year 2)

Photo Location 9



October 2024 upstream (Year 1)



October 2024 downstream (Year 1)



October 2025 upstream (Year 2)



October 2025 downstream (Year 2)

APPENDIX B

USACE and MDE Permit Authorizations



DEPARTMENT OF THE ARMY
U. S. ARMY CORPS OF ENGINEERS, BALTIMORE DISTRICT
ATTN: BALTIMORE DISTRICT
2 HOPKINS PLAZA
BALTIMORE, MARYLAND 21201-2930

May 2, 2022

Operations Division

Ms. Melissa Harlinski
Anne Arundel County
Department of Public Works
2662 Riva Road, MS-7301
Annapolis, Maryland 21401

Dear Ms. Harlinski:

This is in reference to your application, **CENAB-OPR-MN-2016-60858 (AA DPW/Sloop Cove/Stream Restoration/TMDL)**, dated May 2021, for Department of Army (DA) verification of Nationwide Permit (NWP) authorization to restore approximately 2,400 linear feet of Sloop Cove. In April 2022, you requested a new authorization letter, as your previous authorization has expired. The purpose of the project is to provide headwater stream conditions suitable for epifaunal colonization, reduce bank erosion, and reduce sediment pollution to the Chesapeake Bay. You propose to raise an incised stream bed and install log grade control structures, with minimal use of rock near project transitions. You propose to establish a multi-threaded stream with low shear stress conditions suitable for colonization by macroinvertebrate and semiaquatic fauna. Additionally, you propose to install native riparian plantings for terrestrial habitat and shading. The proposed work will result in permanent impacts to 2,435 linear feet (10,434 sq. ft.) of perennial streams, 2,310 sq. ft. of permanent impacts to palustrine forested wetlands, and temporary impacts to 100 linear feet (800 sq. ft.) of perennial stream during stream diversion. All stream and wetland impacts will be remediated onsite, and the project will provide a net gain in stream functions. The proposed project is located at 39.14833, -76.56278 in Pasadena, Anne Arundel County, Maryland.

This waterway has been determined to be within our regulatory jurisdiction and the activity proposed does require Department of the Army authorization.

Our evaluation has determined that the proposed work, if accomplished in accordance with the enclosed plan(s) is authorized by Nationwide Permit (NWP)s for purposes of Section 404 of the Clean Water Act as published in the January 13, 2021 Federal Register, Final Notice of Issuance, Reissuance, and Modification of NWPs (86 FR 2744) and/or the December 27, 2021 Federal Register, Final Notice of Issuance, Reissuance, and Modification of NWPs (86 FR 73522), NWP number(s) 27, provided all state authorizations are granted. If any of the information contained in the application and/or plan(s) is later found to be in error, this authorization may be subject to modification, suspension, or revocation.

Please note that you must comply with the general conditions and activity-specific impact limits and requirements for NWP 27, including Water Quality Certification (WQC) conditions, if appropriate, at the following link:

<https://www.nab.usace.army.mil/Missions/Regulatory/NWP/>. If you are not able to access the conditions, please contact the project manager for a hard copy.

In addition, we have determined that the project-specific special conditions below must also be followed in performing the work to ensure that the project impacts to the aquatic environment are minimal:

1. You must contact Mr. Nick Ozburn of this office at (410) 395-4662 one day prior to commencing construction of the authorized work.
2. A copy of this DA permit and plans must be available on site at the time of construction. A final set of construction drawings (stamped) must be submitted to this office (Attn: Mr. Nick Ozburn, CENAB-OP-RMN) prior to commencement of construction.
3. The permittee must allow representatives of the Corps to enter the project area to inspect the ongoing or completed work.
4. The permittee must monitor the stream and wetland restoration project for three (3) years following the completion of the project and prepare monitoring reports. Monitoring requirements are listed below. Monitoring frequency and success criteria are outlined in Table 1.

At a minimum, the monitoring reports must:

- a. Classify stream flow before and after construction (Perennial, intermittent, and ephemeral).
- b. Evaluate stream stability by performing monumented valley-wide cross-sections to document channel shape, thalweg and elevations at riffle crests (or top of grade control). Cross-sections must be monumented using metal survey stakes, and locations must be noted on the as-built report. A minimum of 1 cross-section for every 300 linear feet of stream work is required. In general, two cross-sections must be installed near the downstream limits of the project, two near the upstream limits of the project, and at least one cross-section must be installed on each tributary where construction has occurred. Further, a monumented cross-section must occur upstream any abrupt elevation changes exceeding 1 ft (if they occur), and the remaining cross-sections must be distributed evenly throughout the remainder of the project area. Cross-sections must be shown in a graphical display which overlays previous cross-sections per location in annual reports.

- c. Report vegetation species and cover.
- d. Evaluate stream habitat quality using an assessment method such as EPAs Rapid Bioassessment Protocol (RBP) high gradient stream habitat form. Results of the stream habitat assessment must be shown for all monitoring years assessed at the time the report is submitted, including preconstruction in each monitoring report.
- e. Photograph site conditions annually along the entire stream restoration project area at 300 foot intervals and at points demonstrating project success and locations of instability.
- f. Identify any necessary corrective measures and provide notes on a copy of a project planset.

Table 1. Success Criteria for Stream Restoration and Enhancement

Level and Category	Parameter	Measurement	Success Criteria	Monitoring Years
1-Hydrology	Flow Classification (Perennial, intermittent)	Visual	Meets or exceeds baseline	PC, 3
2-Hydraulics	NA	NA	NA	NA
3- Geomorphology	Photographs	Every 300 feet	No visual signs of problematic erosion	PC, 1, 2, 3
	Vertical Stability	Monumented Cross Sections	<0.5 ft thalweg degradation from as-built	AB, 3
	Lateral Stability	NA	NA	NA
	Habitat Assessment	EPA RBP high gradient	Exceeds Baseline	PC, 3
	Vegetative Cover	% cover	>85% cover in LOD	3
4-Water Quality	NA	NA	NA	NA
5-Biology	Invasive Plant Reduction	% cover invasive species in LOD	Less than Baseline	PC, 3

Table 1 showing performance standards for stream restoration as described in Condition 4. AB=As-built, PC=Pre-construction, 1-7 corresponds to the monitoring year following construction, NA = Not applicable

- 5. The permittee must submit annual reports to the USACE Baltimore District Office-Enforcement and Compliance Section. Please include your Corps permit number on your monitoring report and submit to the following link: NAB-Regulatory@usace.army.mil, for three (3) years after project construction, on

the results of the monitoring efforts by December 31 of the monitoring year. If necessary, the permittee must coordinate with the regulatory agencies concerning applicable remedial measures. Monitoring reports are required for years 2 and 3 as well as an as-built monitoring report upon project construction completion.

6. The permittee must prepare an invasive species eradication and maintenance plan to remove non-native invasive plant species within the project site if annual site visits document their presence. The plan must be submitted to the Corps for approval along with the annual monitoring report.
7. The permittee must maintain the as-built integrity of the authorized stream restoration project and must ensure that the restoration is functionally mature and self-sustaining. **The permittee must provide to the Corps an as-built survey of the project within 90 days of construction completion. The permittee must notify and provide to the Corps, a detailed description and construction plans for any necessary corrective measures, including maintenance and repair, or alteration in any way, of the permitted stream restoration 15 days prior to performance of such corrective measures for Corps review and approval.**
8. The permittee must assume all liability for accomplishing the corrective work should the Corps determine the project has not been fully satisfactory. If the Corps does not find the project satisfactory, the permittee will be required to develop a remediation plan and an extension of monitoring time may be required to cover any necessary remedial work.
9. Best management practices must be employed to minimize impacts to wetlands and waterways. Temporary disturbance to wetlands and waterways must be restored to preconstruction conditions or better, including replanting as necessary or directed by the Corps.
10. The project site will be seeded with a pollinator seed mix which includes milkweed (genus *Asclepias*) in areas with full sunlight to support declining monarch butterfly populations. A final planting plan must be submitted to the Corps with the as-built report. The Corps will provide example seed mix lists for guidance on the planting plan.
11. In order to minimize fish and wildlife mortality during construction, a good faith effort must be made by the contractor to flush and/or relocate fish and wildlife species from within the limit of disturbance prior to construction.
12. If the Corps determines the project to be successful and stable prior to year 3, some monitoring requirements may be abbreviated. If the Corps determines the project to be unstable and not meeting success criteria by year 3, the Corps may require remediation and additional monitoring.

Please note that as of the date of this authorization, your project is in compliance with Section 7 of the Endangered Species Act. However, new species may be listed, or additional populations found. Therefore, it is your responsibility to ensure that construction of the authorized work does not adversely affect any existing or newly listed federally endangered or threatened species. Information on threatened and endangered species and their critical habitat can be obtained from the offices of the U.S Fish and Wildlife Service and National Marine Fisheries Service or their web pages at: <https://ecos.fws.gov/ipac> and <https://www.greateratlantic.fisheries.noaa.gov/protected/section7/guidance/maps/index.html> respectively.

Please note that you are required to submit a signed certification documenting completion of the authorized activity and implementation of any required compensatory mitigation. An example of the information that is required is posted on the Baltimore District webpage at: <https://www.nab.usace.army.mil/Portals/63/NAB-xxxx-xxxx XXXX Universal CompCert Final.pdf>. The signed certification should be emailed to the Regulatory Branch email at nab-regulatory@usace.army.mil **within 60 days with CENAB-OPR-MN-2016-60858 (AA DPW/Sloop Cove/Stream Restoration/TMDL)**, in the subject line following completion of the authorized work and any required mitigation. Your signature on the certification verifies your understanding that the work was completed in accordance with the terms and conditions associated with your Department of the Army permit.

This verification is valid until the NWP is modified, reissued, or revoked. The NWPs issued in the January 13, 2021, Federal Register, Final Notice of Issuance, Reissuance, and Modification of NWPs (86 FR 2744) and/or the December 27, 2021, Federal Register, Final Notice of Issuance, Reissuance, and Modification of NWPs (86 FR 73522) expire on March 14, 2026. It is incumbent upon you to remain informed of changes to the NWPs. We will issue a public notice when the NWPs are reissued. Furthermore, if you commence or are under contract to commence this activity before the date that the relevant NWP is modified or revoked, you will have twelve (12) months from the date of the modification or revocation of the NWP to complete the activity under the present terms and conditions of this NWP.

After you have obtained all required federal, state, and/or local authorizations, you may proceed with the authorized work.

When the structures or work authorized by this NWP are still in existence at the time the property is transferred, the terms and conditions of this NWP, including any special conditions, will continue to be binding on the new owner(s) of the property. To validate the transfer of this NWP and the associated liabilities associated with compliance with its terms and conditions, have the transferee sign and date below. A copy of this NWP verification signed by the transferee must be submitted to the Baltimore District to validate the transfer.

If you have any questions concerning this matter, please contact me by phone or email at **(410) 395-4662 or Nicholas.R.Ozburn@usace.army.mil.**

Sincerely,

A handwritten signature in black ink that reads "Nick Ozburn". The signature is fluid and cursive, with "Nick" on the top line and "Ozburn" on the bottom line.

Nick Ozburn
Senior Project Manager

Cc: Ms. Randah Kamel, MDE Waterway Construction Division
(Randah.Kamel@maryland.gov)

CENAB-OPR-MN-2016-60858 (AA DPW/Sloop Cove/Stream Restoration/TMDL)

TRANSFeree SIGNATURE


DATE

TELEPHONE NO.

PRINTED NAME


ADDRESS

To identify how we can better serve you, we need your help. Please take the time to fill out our customer service survey at: <https://regulatory.ops.usace.army.mil/customer-service-survey/>

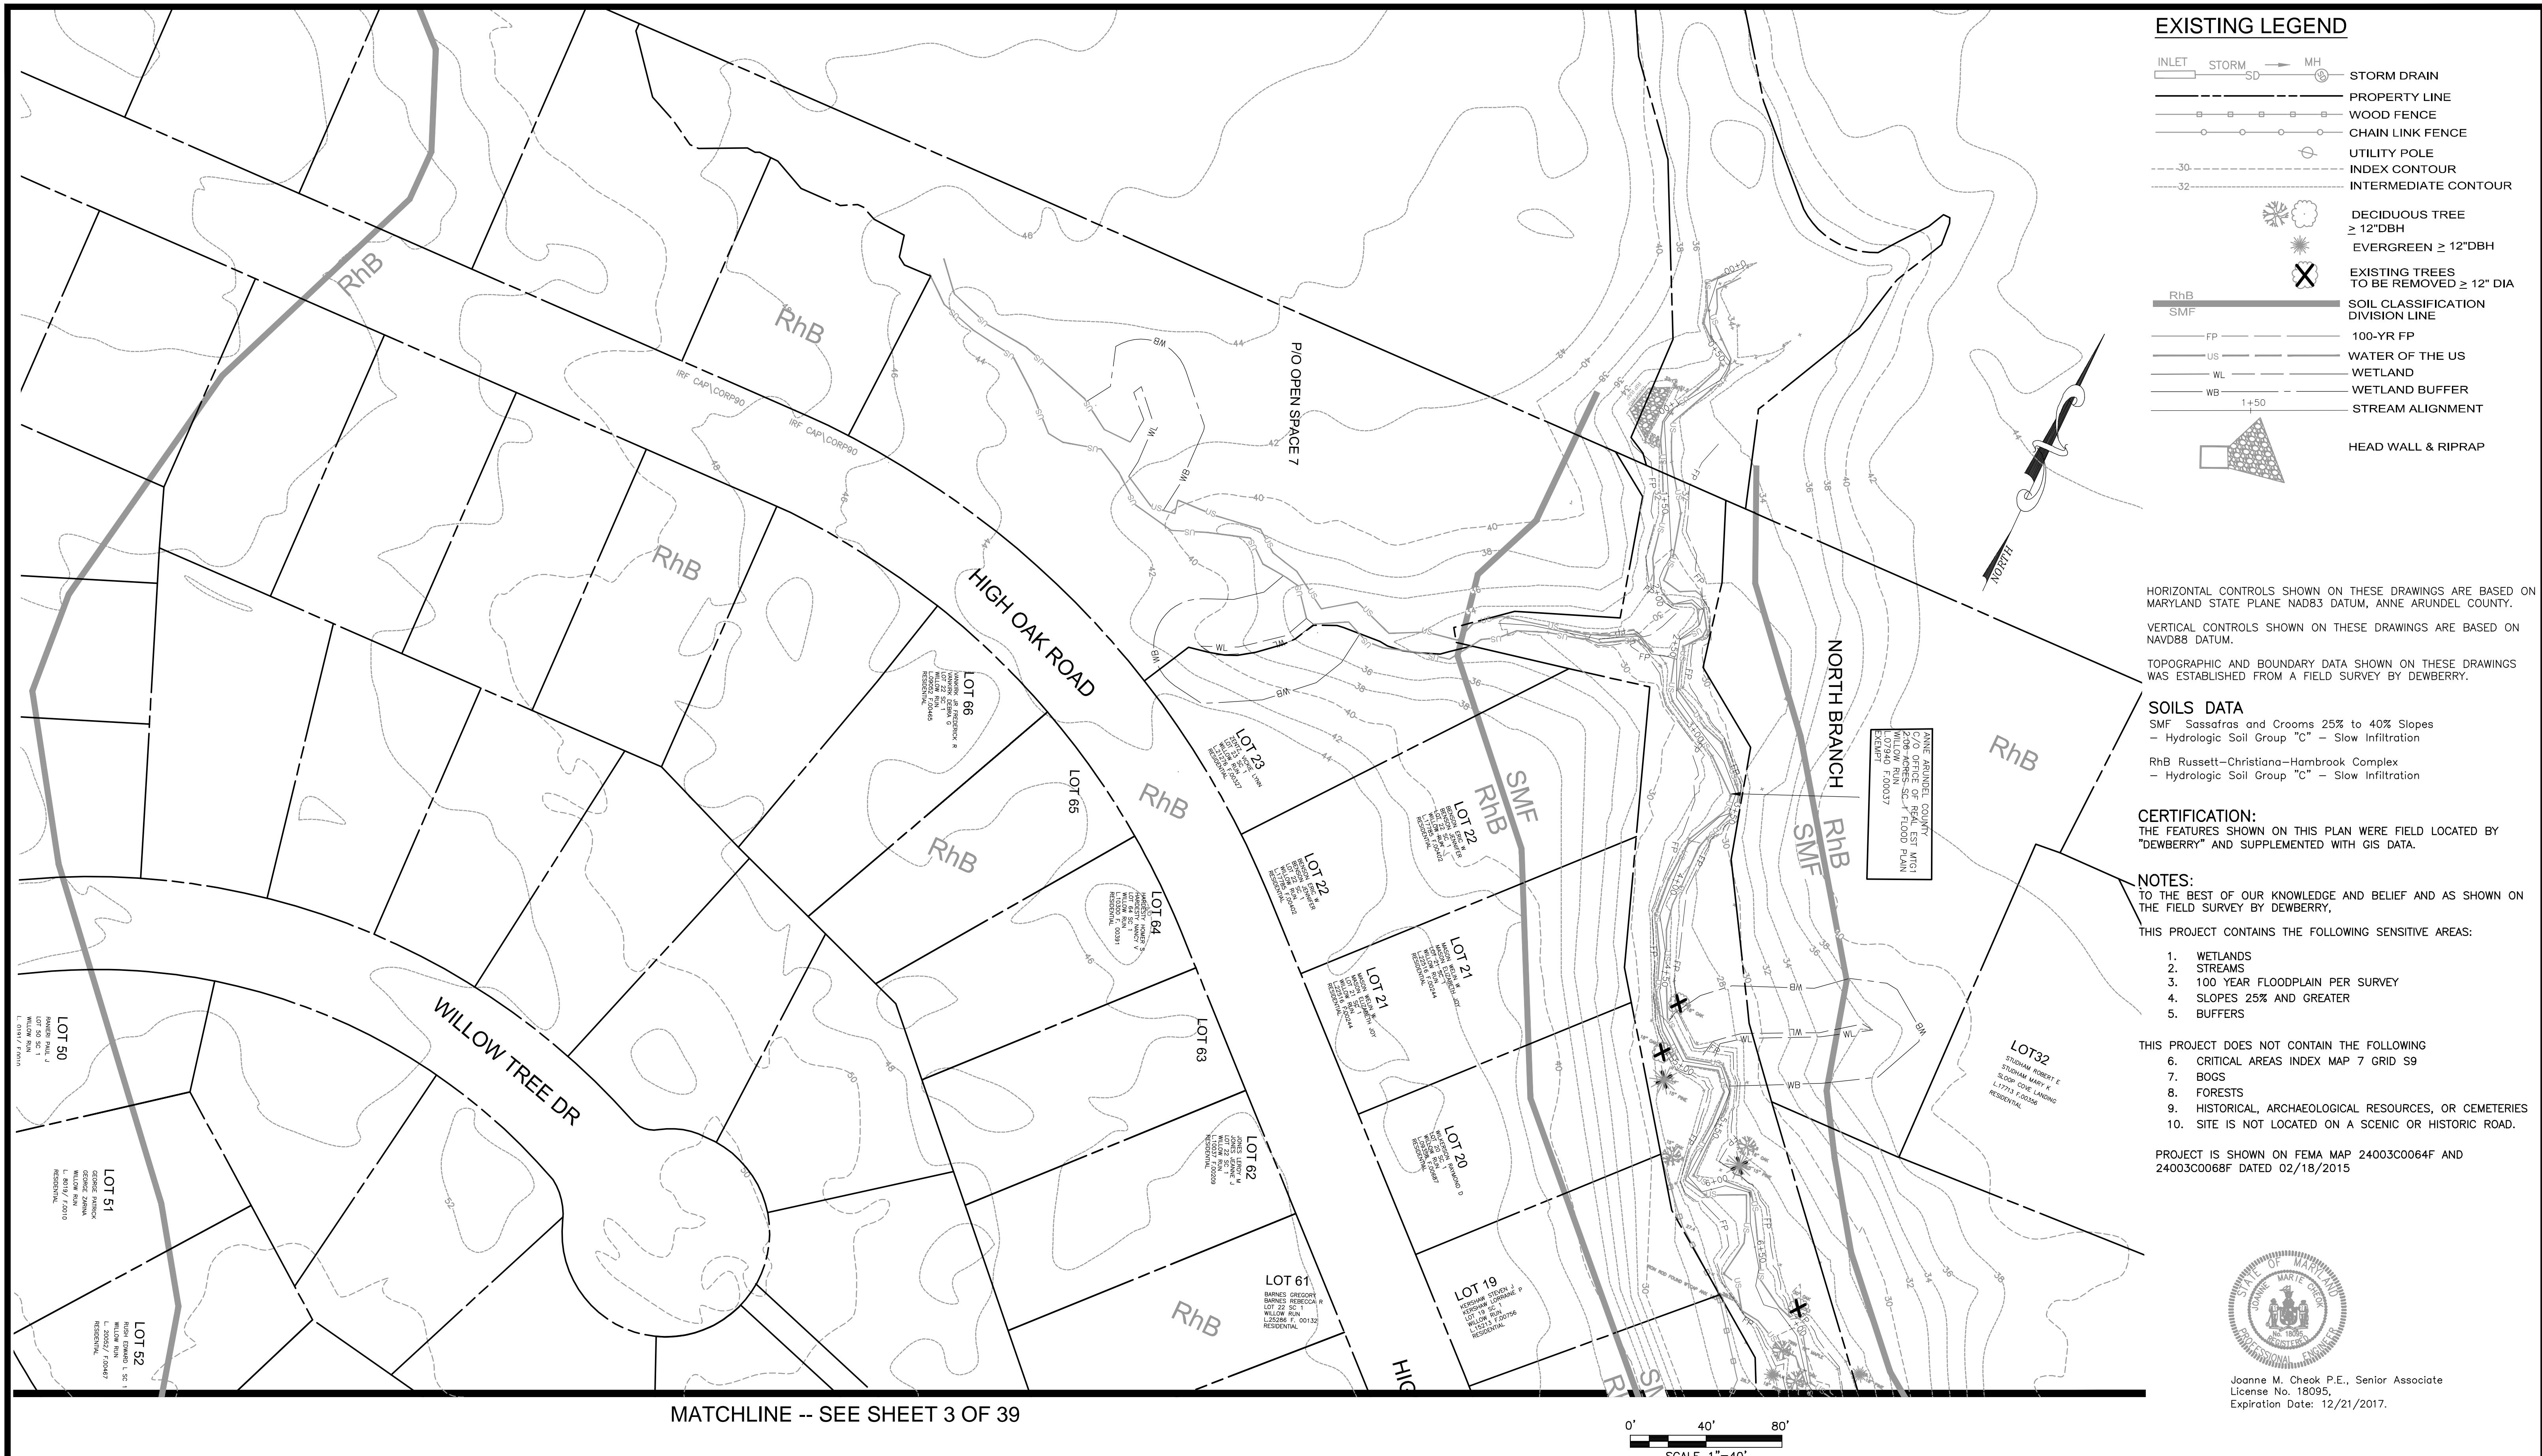

OWNER/DEVELOPER/APPLICANT		CIVIL ENGINEER A.A. County ID #721		REVISIONS				ANNE ARUNDEL COUNTY			
				NO	Description	BY	DATE	DEPARTMENT OF PUBLIC WORKS			
717-627-4440 fax: 717-627-4660 landstudies.com 315 North Street Lititz, PA 17543	Dewberry 2101 Gaither Road Suite #340 Rockville, MD 20850 Contact: Joanne M. Cheek, Senior Associate Phone: (301) 337-2856 Fax: (301) 258-7607		2/22/2018	PROFESSIONAL CERTIFICATION	I hereby certify that these documents were prepared or approved by me, and that I am a duly licensed professional engineer under the laws of the State of Maryland, License No. 18095, Expiration Date: 12/21/2022.	APPROVED	DATE	APPROVED	DATE	STREAM RESTORATION PLAN	
						CHIEF ENGINEER		PROJECT MANAGER			
						APPROVED	DATE	APPROVED	DATE		
						ASSISTANT CHIEF ENGINEER		CHIEF, RIGHT OF WAY			
										3rd District	
EXISTING CONDITIONS SLOOP COVE RETROFIT SITE 1											
Tax Map 16 Grid 05											
Anne Arundel County											

MATCHLINE -- SEE SHEET 2 OF 39

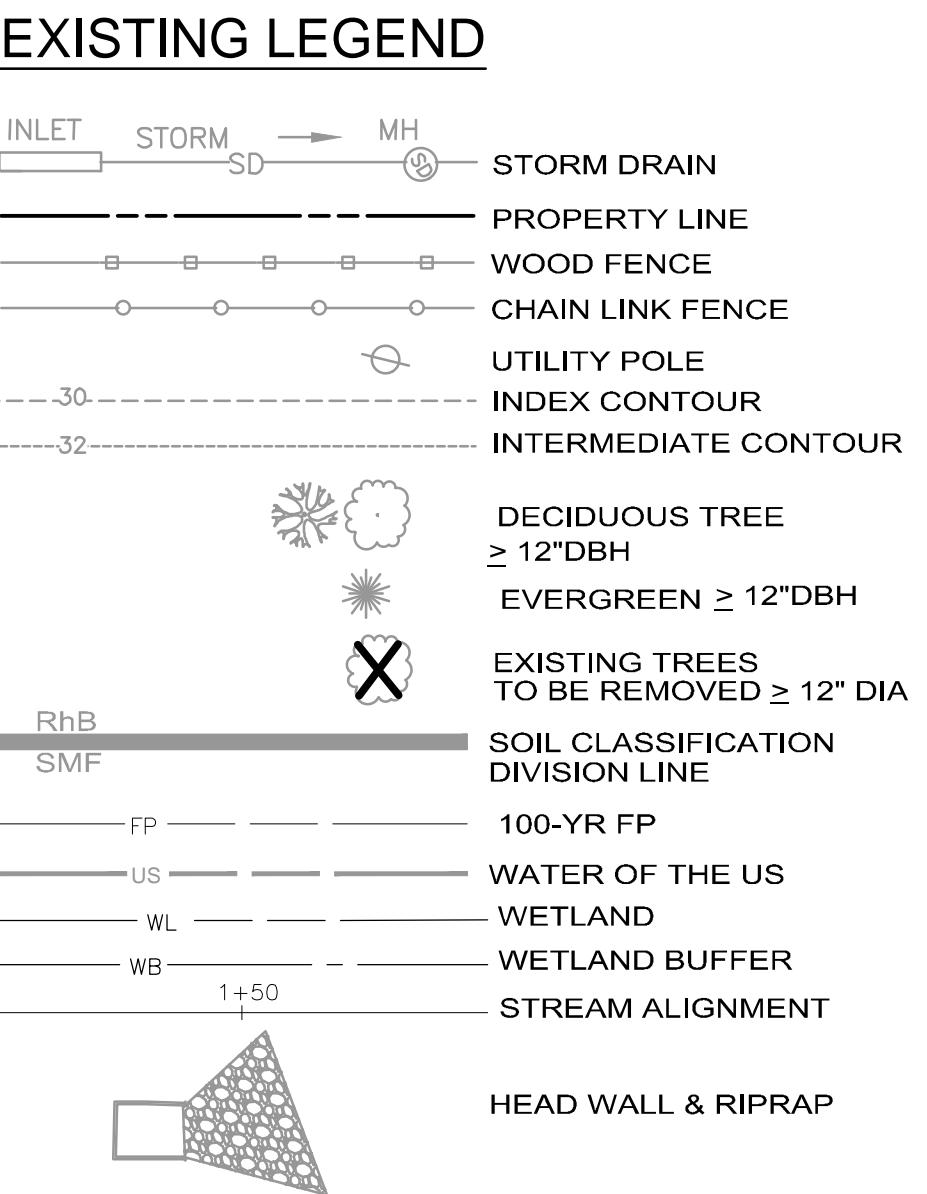

HORIZONTAL CONTROLS SHOWN ON THESE DRAWINGS ARE BASED ON MARYLAND STATE PLANE NAD83 DATUM, ANNE ARUNDEL COUNTY.

VERTICAL CONTROLS SHOWN ON THESE DRAWINGS ARE BASED ON NAVD88 DATUM.

TOPOGRAPHIC AND BOUNDARY DATA SHOWN ON THESE DRAWINGS WAS ESTABLISHED FROM A FIELD SURVEY BY DEWBERRY.

SOILS DATA

SMF Sassafras and Crooms 25% to 40% Slopes

- Hydrologic Soil Group "C" - Slow Infiltration

Rhb Russet-Christiana-Hambrook Complex

- Hydrologic Soil Group "C" - Slow Infiltration

CERTIFICATION:

THE FEATURES SHOWN ON THIS PLAN WERE FIELD LOCATED BY "DEWBERRY" AND SUPPLEMENTED WITH GIS DATA.

NOTES:

TO THE BEST OF OUR KNOWLEDGE AND BELIEF AND AS SHOWN ON THE FIELD SURVEY BY DEWBERRY,

THIS PROJECT CONTAINS THE FOLLOWING SENSITIVE AREAS:

1. WETLANDS
2. STREAMS
3. 100 YEAR FLOODPLAIN PER SURVEY
4. SLOPES 25% AND GREATER
5. BUFFERS

THIS PROJECT DOES NOT CONTAIN THE FOLLOWING

6. CRITICAL AREAS INDEX MAP 7 GRID S9
7. BOGS
8. FORESTS
9. HISTORICAL, ARCHAEOLOGICAL RESOURCES, OR CEMETERIES
10. SITE IS NOT LOCATED ON A SCENIC OR HISTORIC ROAD.

PROJECT IS SHOWN ON FEMA MAP 24003C0064F AND 24003C0068F DATED 02/18/2015



Joanne M. Cheek P.E., Senior Associate
License No. 18095,
Expiration Date: 12/21/2017.

0' 40' 80'
SCALE 1"=40'


OWNER/DEVELOPER/APPLICANT

717-627-4440
fax: 717-627-4660
landstudies.com
315 North Street | Lititz, PA 17543

CIVIL ENGINEER

A.A. County ID #721

Dewberry
2101 Gaither Road
Suite #340
Rockville, MD 20850
Contact: Joanne M. Cheek, Senior Associate
Phone: (301) 337-2856
Fax: (301) 258-7607

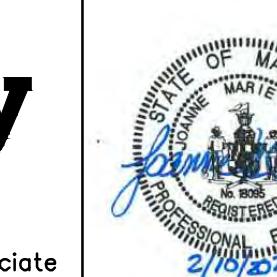

Professional Certification: I hereby certify that these documents were prepared or approved by me, and that I am a duly licensed professional engineer under the laws of the State of Maryland, License No. 18095, Expiration Date: 12/21/2022.

REVISIONS

NO	Description	BY	DATE
		APPROVED	DATE
		CHIEF ENGINEER	PROJECT MANAGER
		APPROVED	APPROVED
		ASSISTANT CHIEF ENGINEER	CHIEF, RIGHT OF WAY

ANNE ARUNDEL COUNTY

DEPARTMENT OF PUBLIC WORKS


STREAM RESTORATION PLAN

EXISTING CONDITIONS
SLOOP COVE RETROFIT SITE 1

3rd District

Tax Map 16 Grid 05

Anne Arundel County

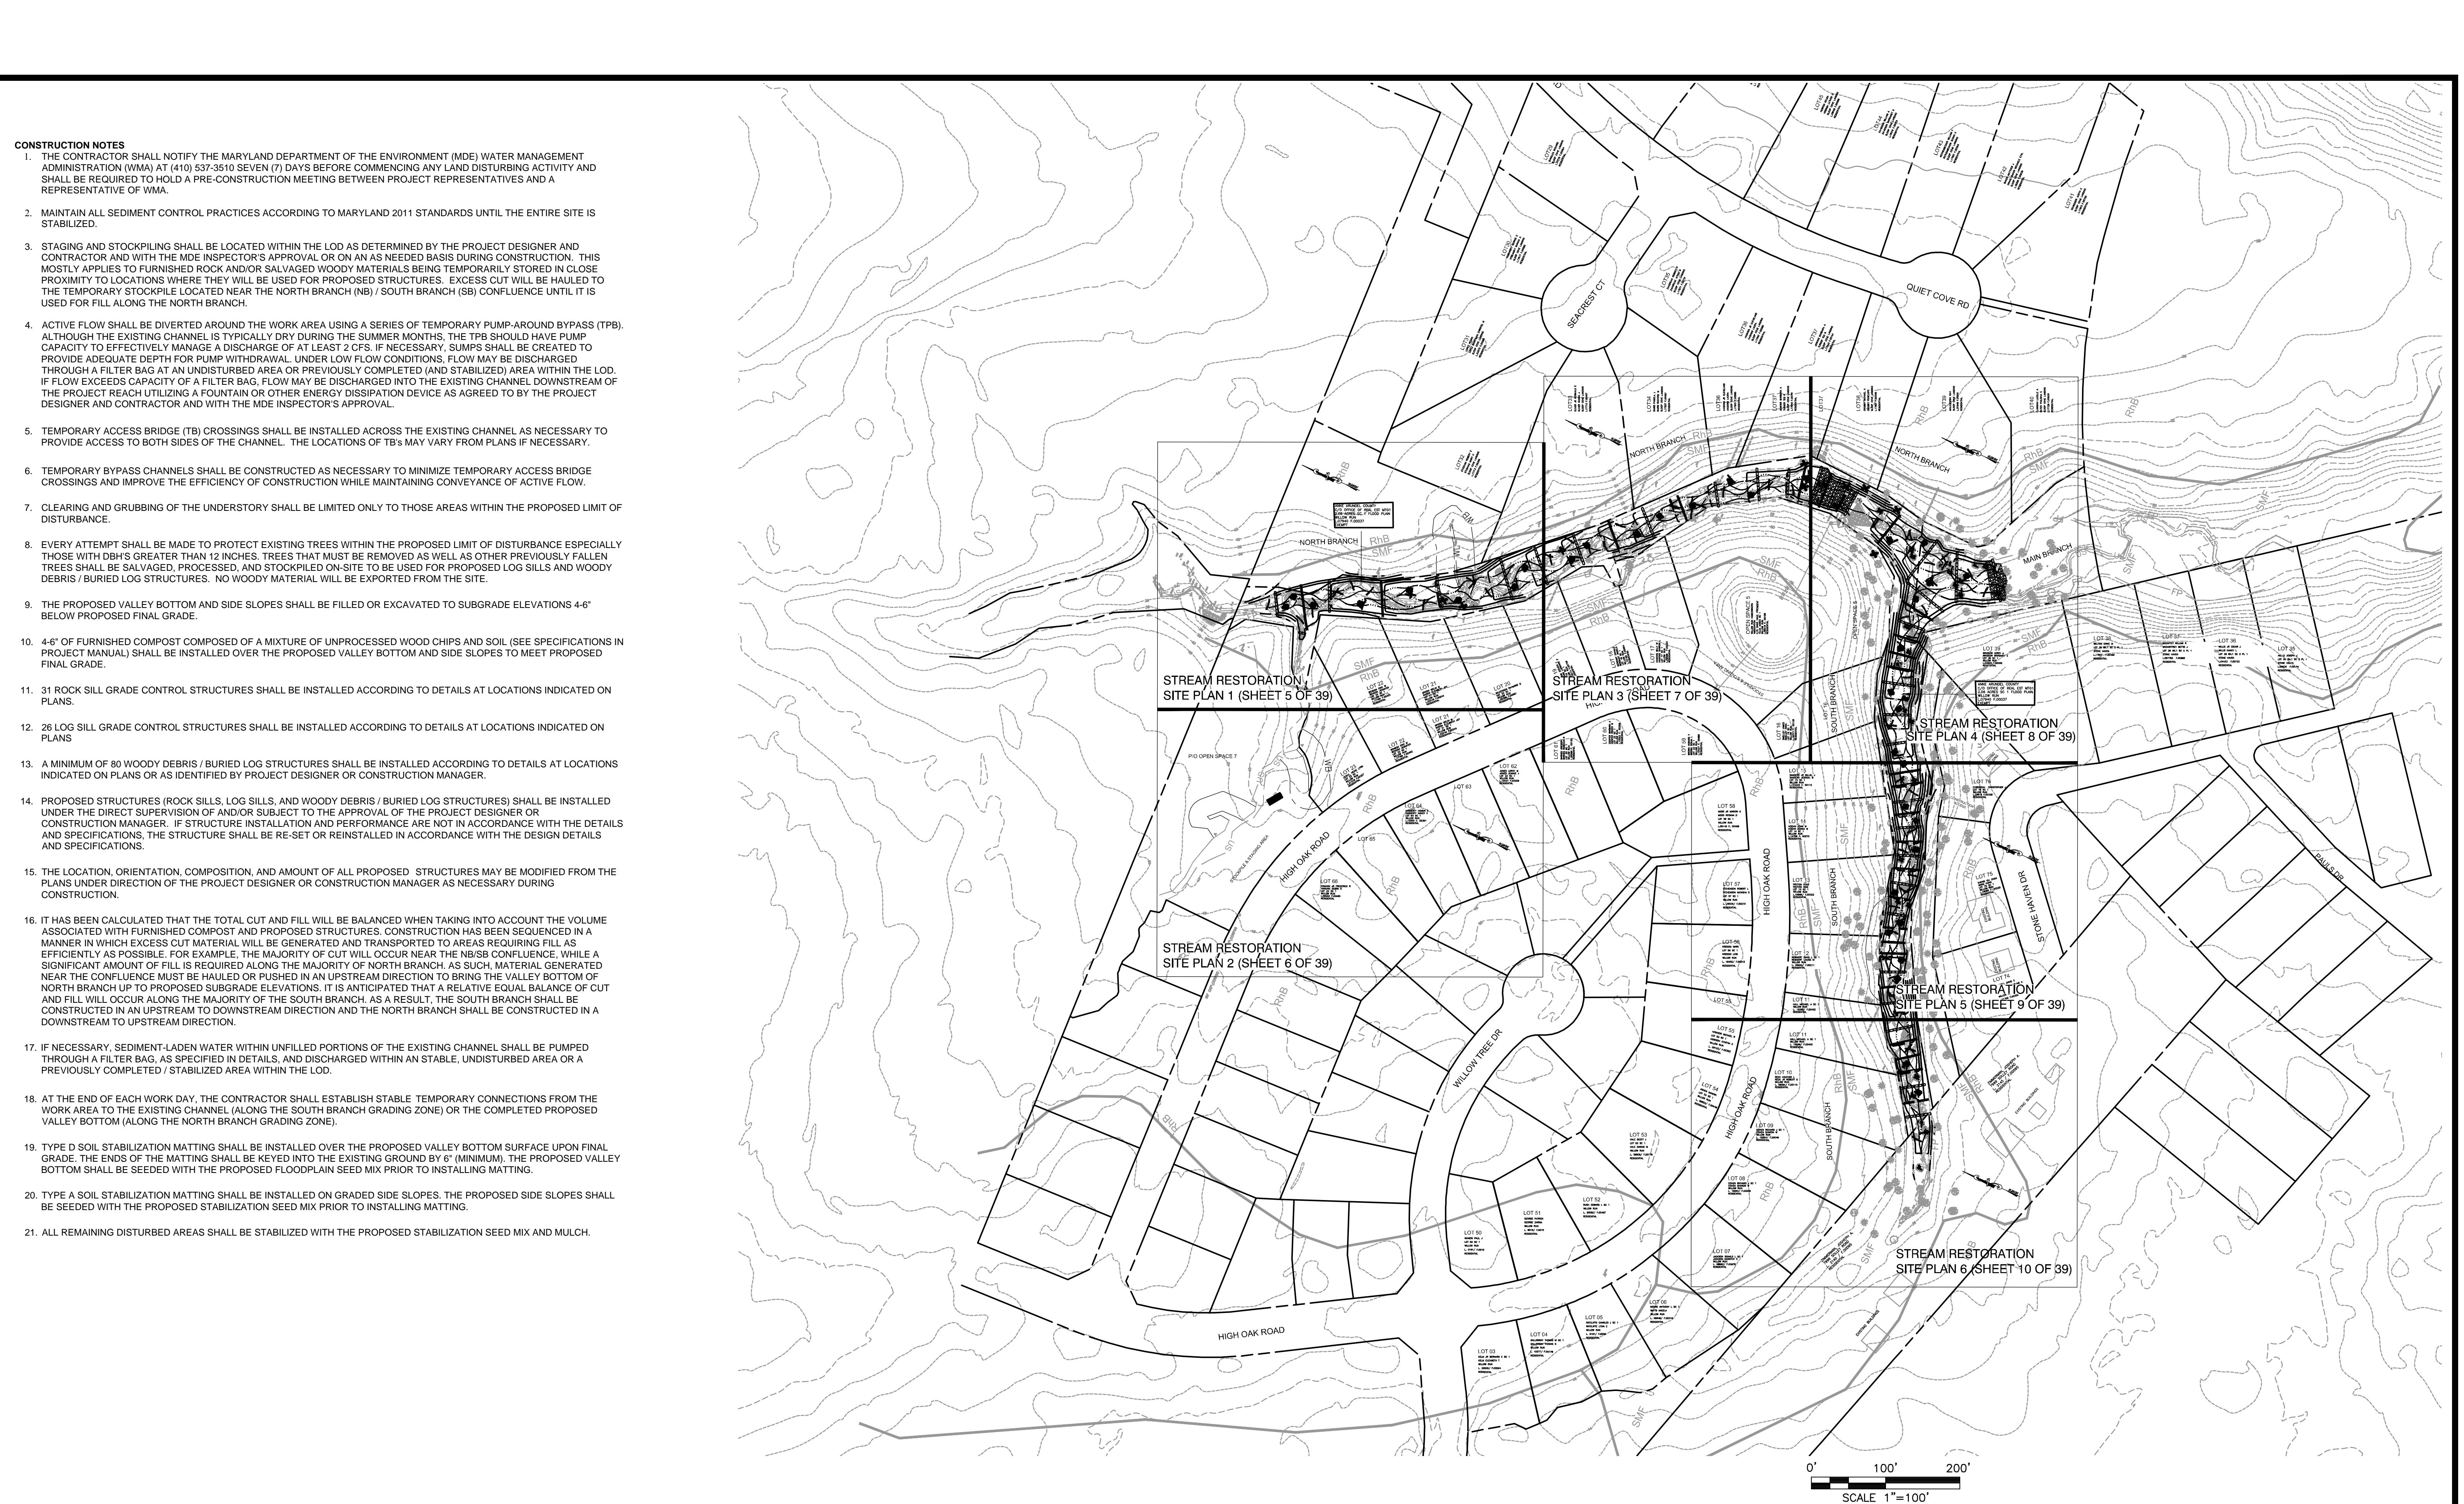

PROJECT 2008 File\Stop Cove_50017963\CAD\CIVIL\Site Plan - Construction\10 - SP-STRM-REST.dwg 2/10/2021 3:47:28 PM, nemegul

OWNER/DEVELOPER/APPLICANT		CIVIL ENGINEER A.A. County ID #721		REVISIONS	ANNE ARUNDEL COUNTY					
NO	Description	BY	DATE		APPROVED	DATE	APPROVED	DATE	DEPARTMENT OF PUBLIC WORKS	STREAM RESTORATION PLAN
					APPROVED	DATE	APPROVED	DATE	SCALE: As Shown	
					CHIEF ENGINEER		PROJECT MANAGER		DRAWN BY: Bif/R, Anchors	
					APPROVED	DATE	APPROVED	DATE	CHECKED BY: J. Cheek	
					ASSISTANT CHIEF ENGINEER		CHIEF, RIGHT OF WAY		SHEET NO: 4 OF 39	
									PROJECT NO: 50017963	
									PROPOSAL NO:	
									3rd District	
									Tax Map 16 Grid 05	
									Anne Arundel County	

**STREAM RESTORATION OVERVIEW
SLOOP COVE RETROFIT SITE 1**

EXISTING LEGEND

INLET STORM SD MH STORM DRAIN

PROPERTY LINE

WOOD FENCE

CHAIN LINK FENCE

UTILITY POLE

INDEX CONTOUR

INTERMEDIATE CONTOUR

DECIDUOUS TREE
≥ 12"DBH

EVERGREEN ≥ 12"DBH

EXISTING TREES
TO BE REMOVED ≥ 12" DIA

RhB

SMF

SOIL CLASSIFICATION
DIVISION LINE

100-YR FP

WATER OF THE US

WL

WB

1+50

STREAM ALIGNMENT

HEAD WALL & RIPRAP

PROPOSED LEGEND

23

CONTOUR

ROCK SILL (RS)

LOG SILL (LS)

SUBSURFACE ARMORING (SA)

WOODY DEBRIS/BURIED LOG STRUCURE

LOD

LIMITS OF DISTURBANCE

CROSS SECTION

SB-XS# NBT-XS# NB-XS#

LS-19 22

LOG SILL

RS-16 22

ROCK SILL

FP


1+50

100-YR FP

VALLEY ALIGNMENT

THEORETICAL CHANNEL SYSTEM*

*The theoretical channel system is conceptual. The multiple threads will not be constructed as shown, but represent the individual flow paths that may develop and evolve over time.

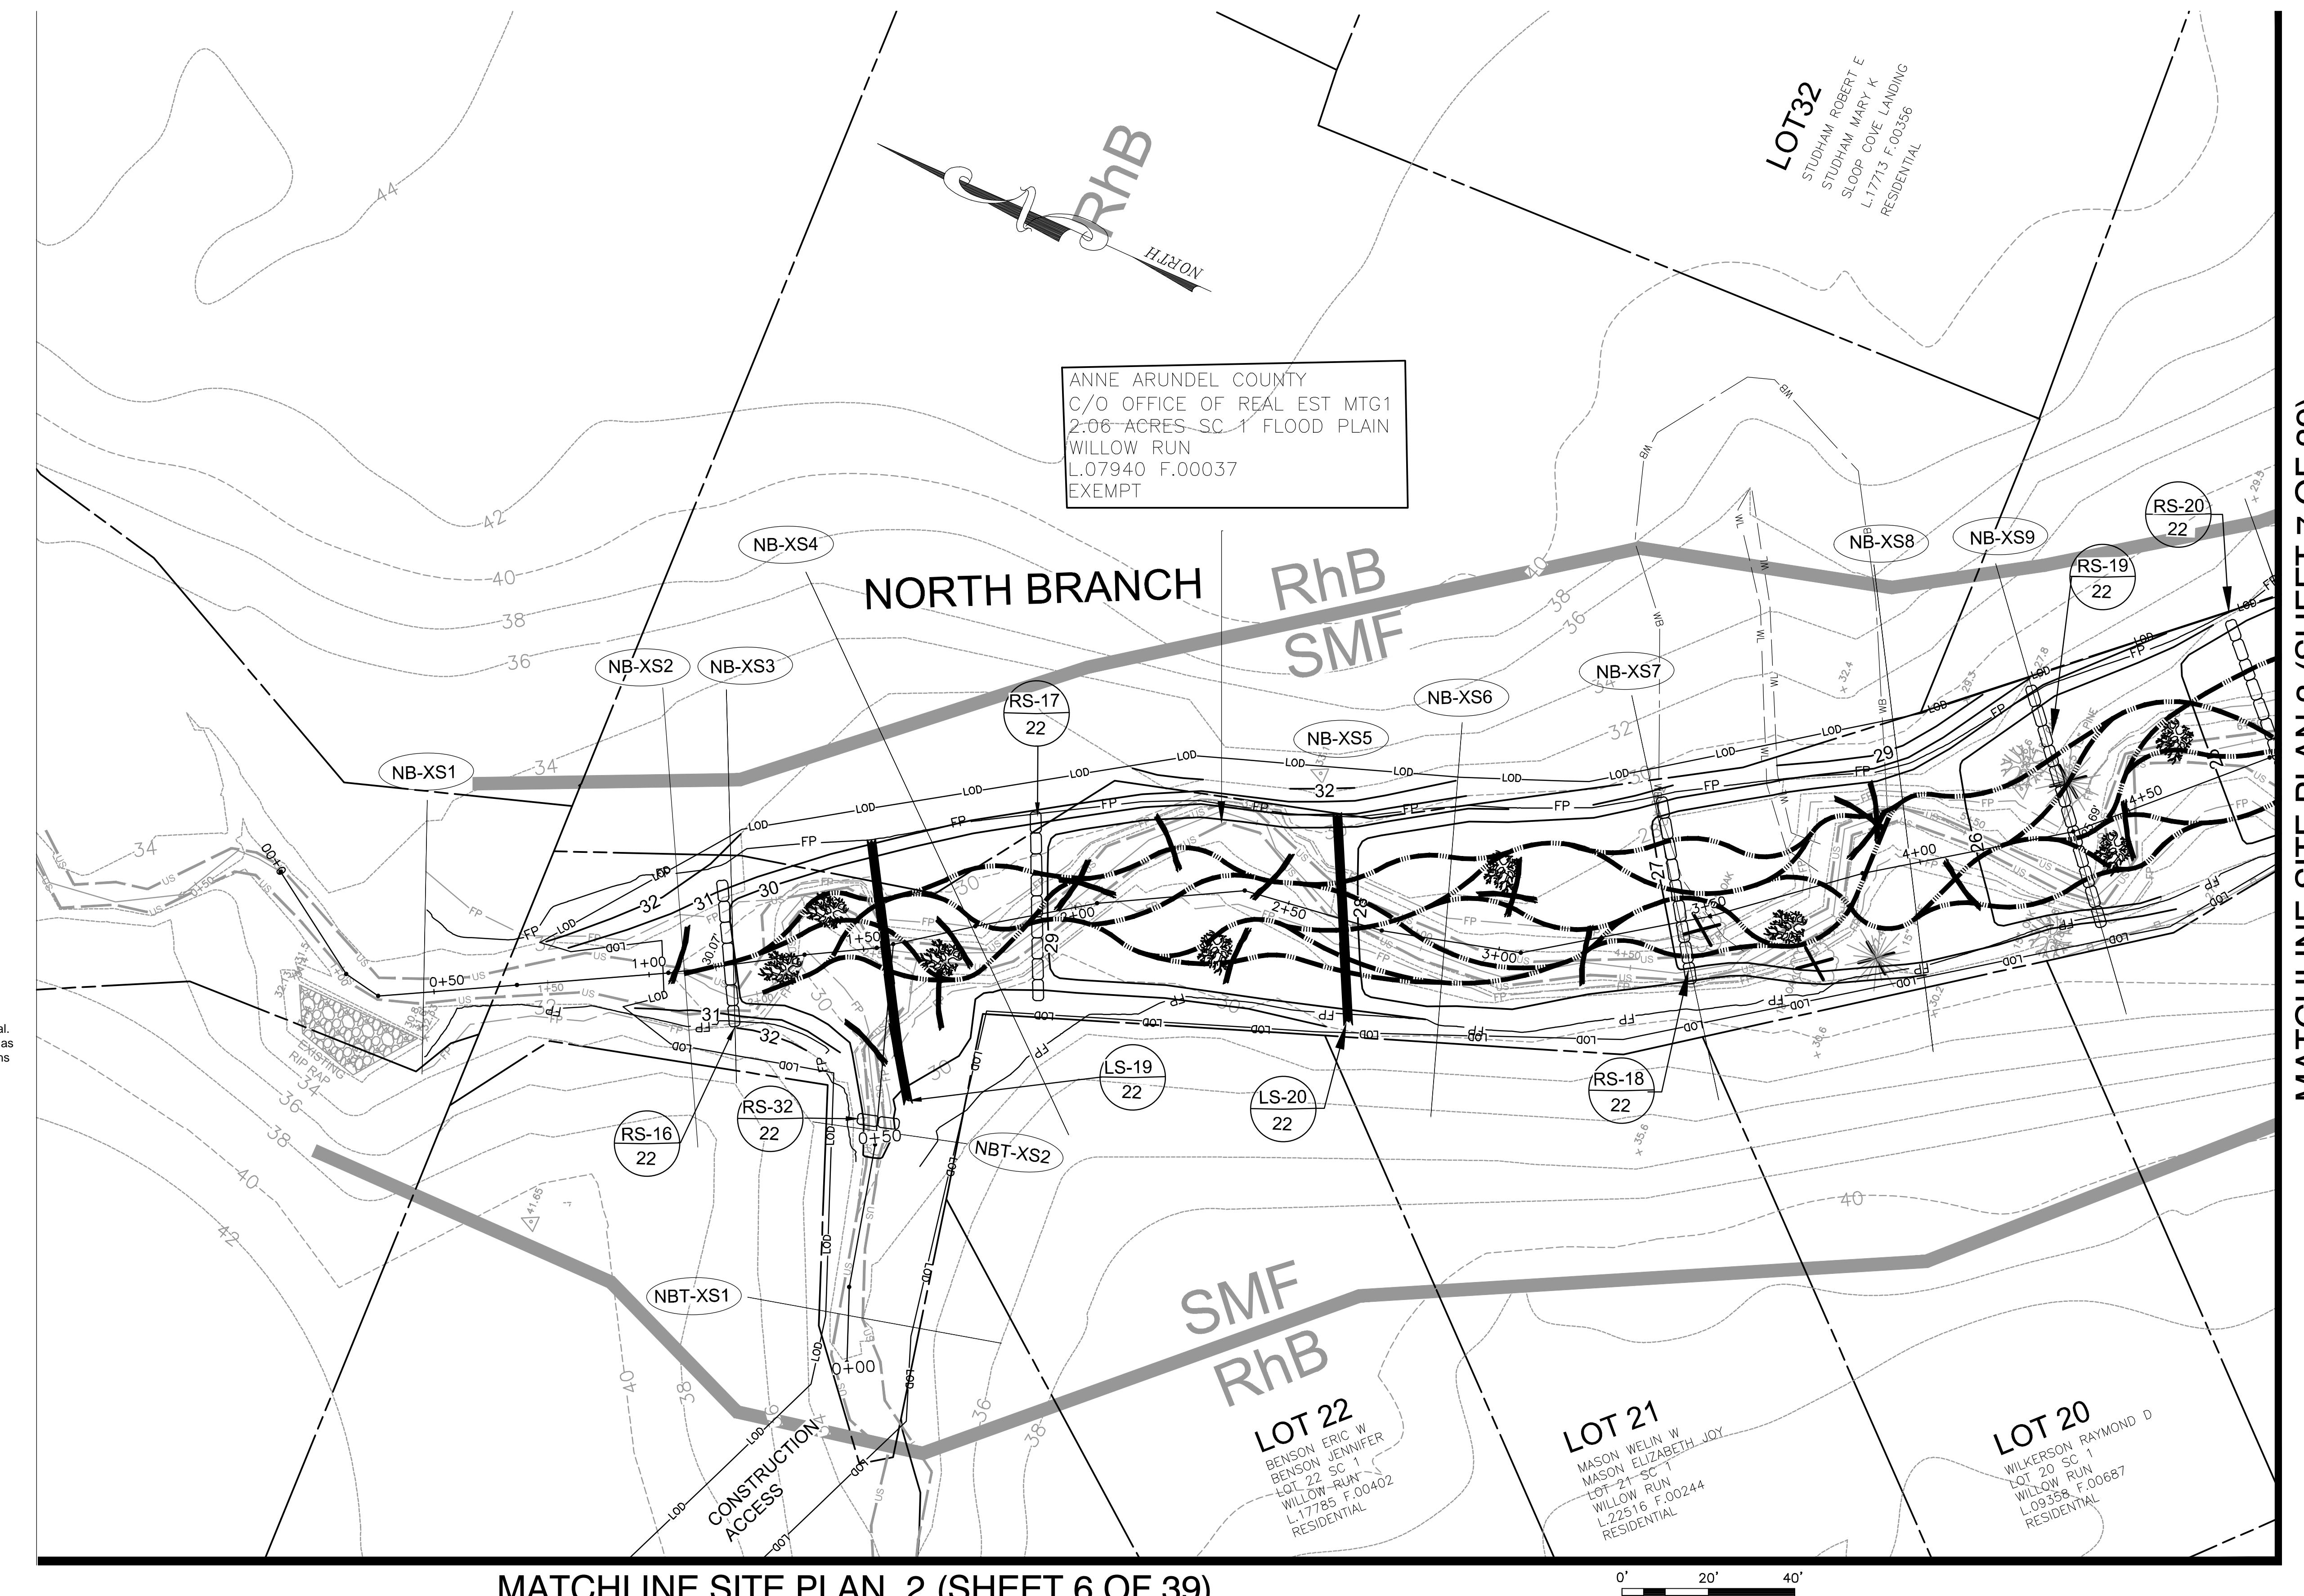

MATCHLINE SITE PLAN 2 (SHEET 6 OF 39)

SCALE 1"=20'

ANNE ARUNDEL COUNTY
DEPARTMENT OF PUBLIC WORKS

RESTORATION SITE PLAN 1

OOP COVE RETROFIT SITE 1

3rd District

Tax Map 16 Grid 05

Anne Arundel County

OWNER/DEVELOPER/APPLICANT

717-627-4440
fax: 717-627-4660
landstudies.com
land@landstudies.com
315 North Street | Lititz, PA 17543

CIVIL ENGINEER
A.A. County ID #721

A circular official seal of the State of Maryland. The outer ring contains the words "THE STATE OF MARYLAND" at the top and "PROFESSIONAL ENGINEER" at the bottom. The inner circle features a central illustration of a lighthouse and a ship, with the word "CHECK" written vertically along the right side of the inner circle. A blue ink signature, appearing to read "John Doe", is written across the center of the seal.

Professional Certification
I certify that these documents
were prepared or approved by
me, that I am a duly licensed
professional engineer under the
laws of the State of Michigan.


n: I hereby
ments were
y me, and
ed
nder the
aryland,
/2022

ANNE ARUNDEL COUNTY
DEPARTMENT OF PUBLIC WORKS


DATE	APPROVED	DATE	SCALE: As Shown	STREAM RESTORATION PLAN
			DRAWN BY: BJF/R. Anchors	RESTORATION SITE PLAN 1 SLOOP COVE RETROFIT SITE 1
	PROJECT MANAGER		CHECKED BY: J. Cheok	
DATE	APPROVED	DATE	SHEET NO: 5 OF 39	
			PROJECT NO: 50017963	
ER	CHIEF RIGHT OF WAY		PROPOSAL NO:	3rd District

MATCHLINE SITE PLAN 1 (SHEET 5 OF 39)


EXISTING LEGEND

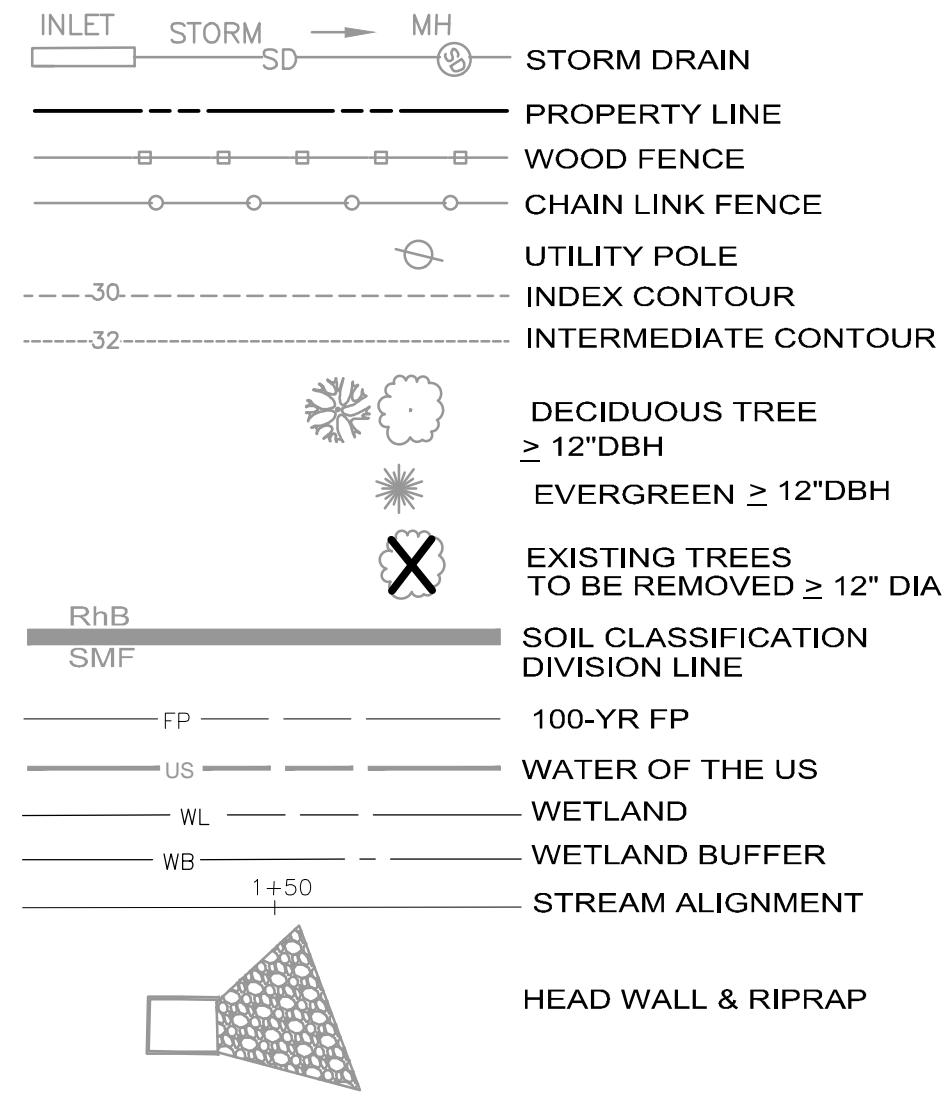

PROPOSED LEGEND

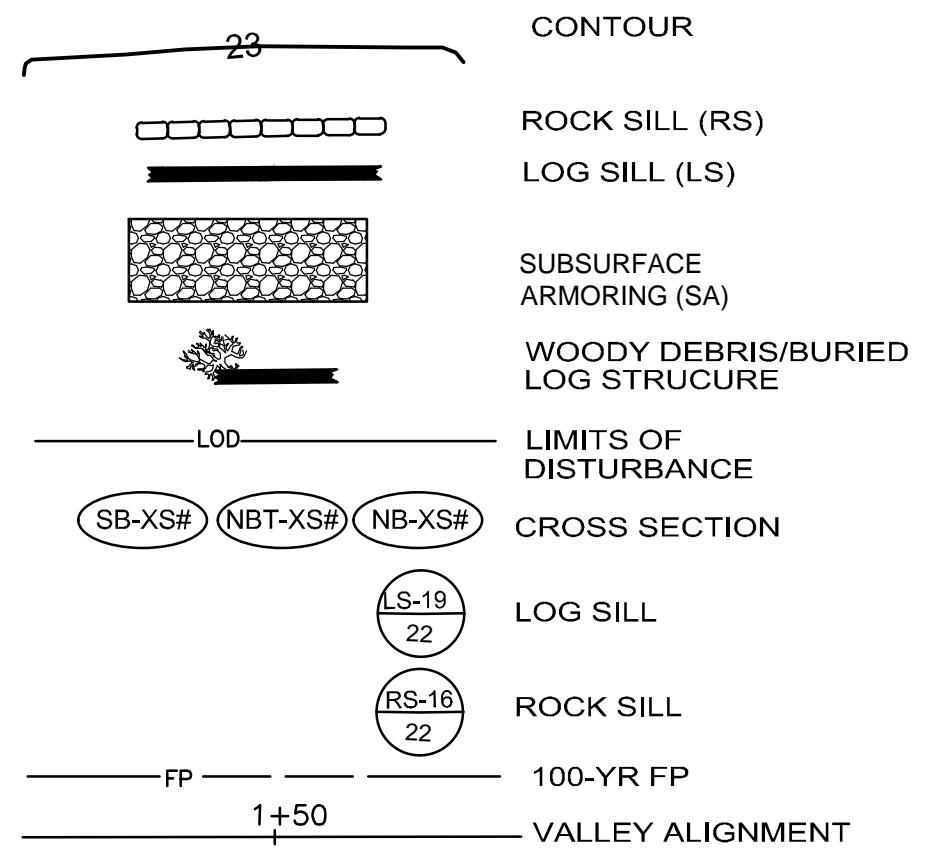

- * The theoretical channel system is conceptual. The multiple threads will not be constructed as shown, but represent the individual flow paths that may develop and evolve over time.

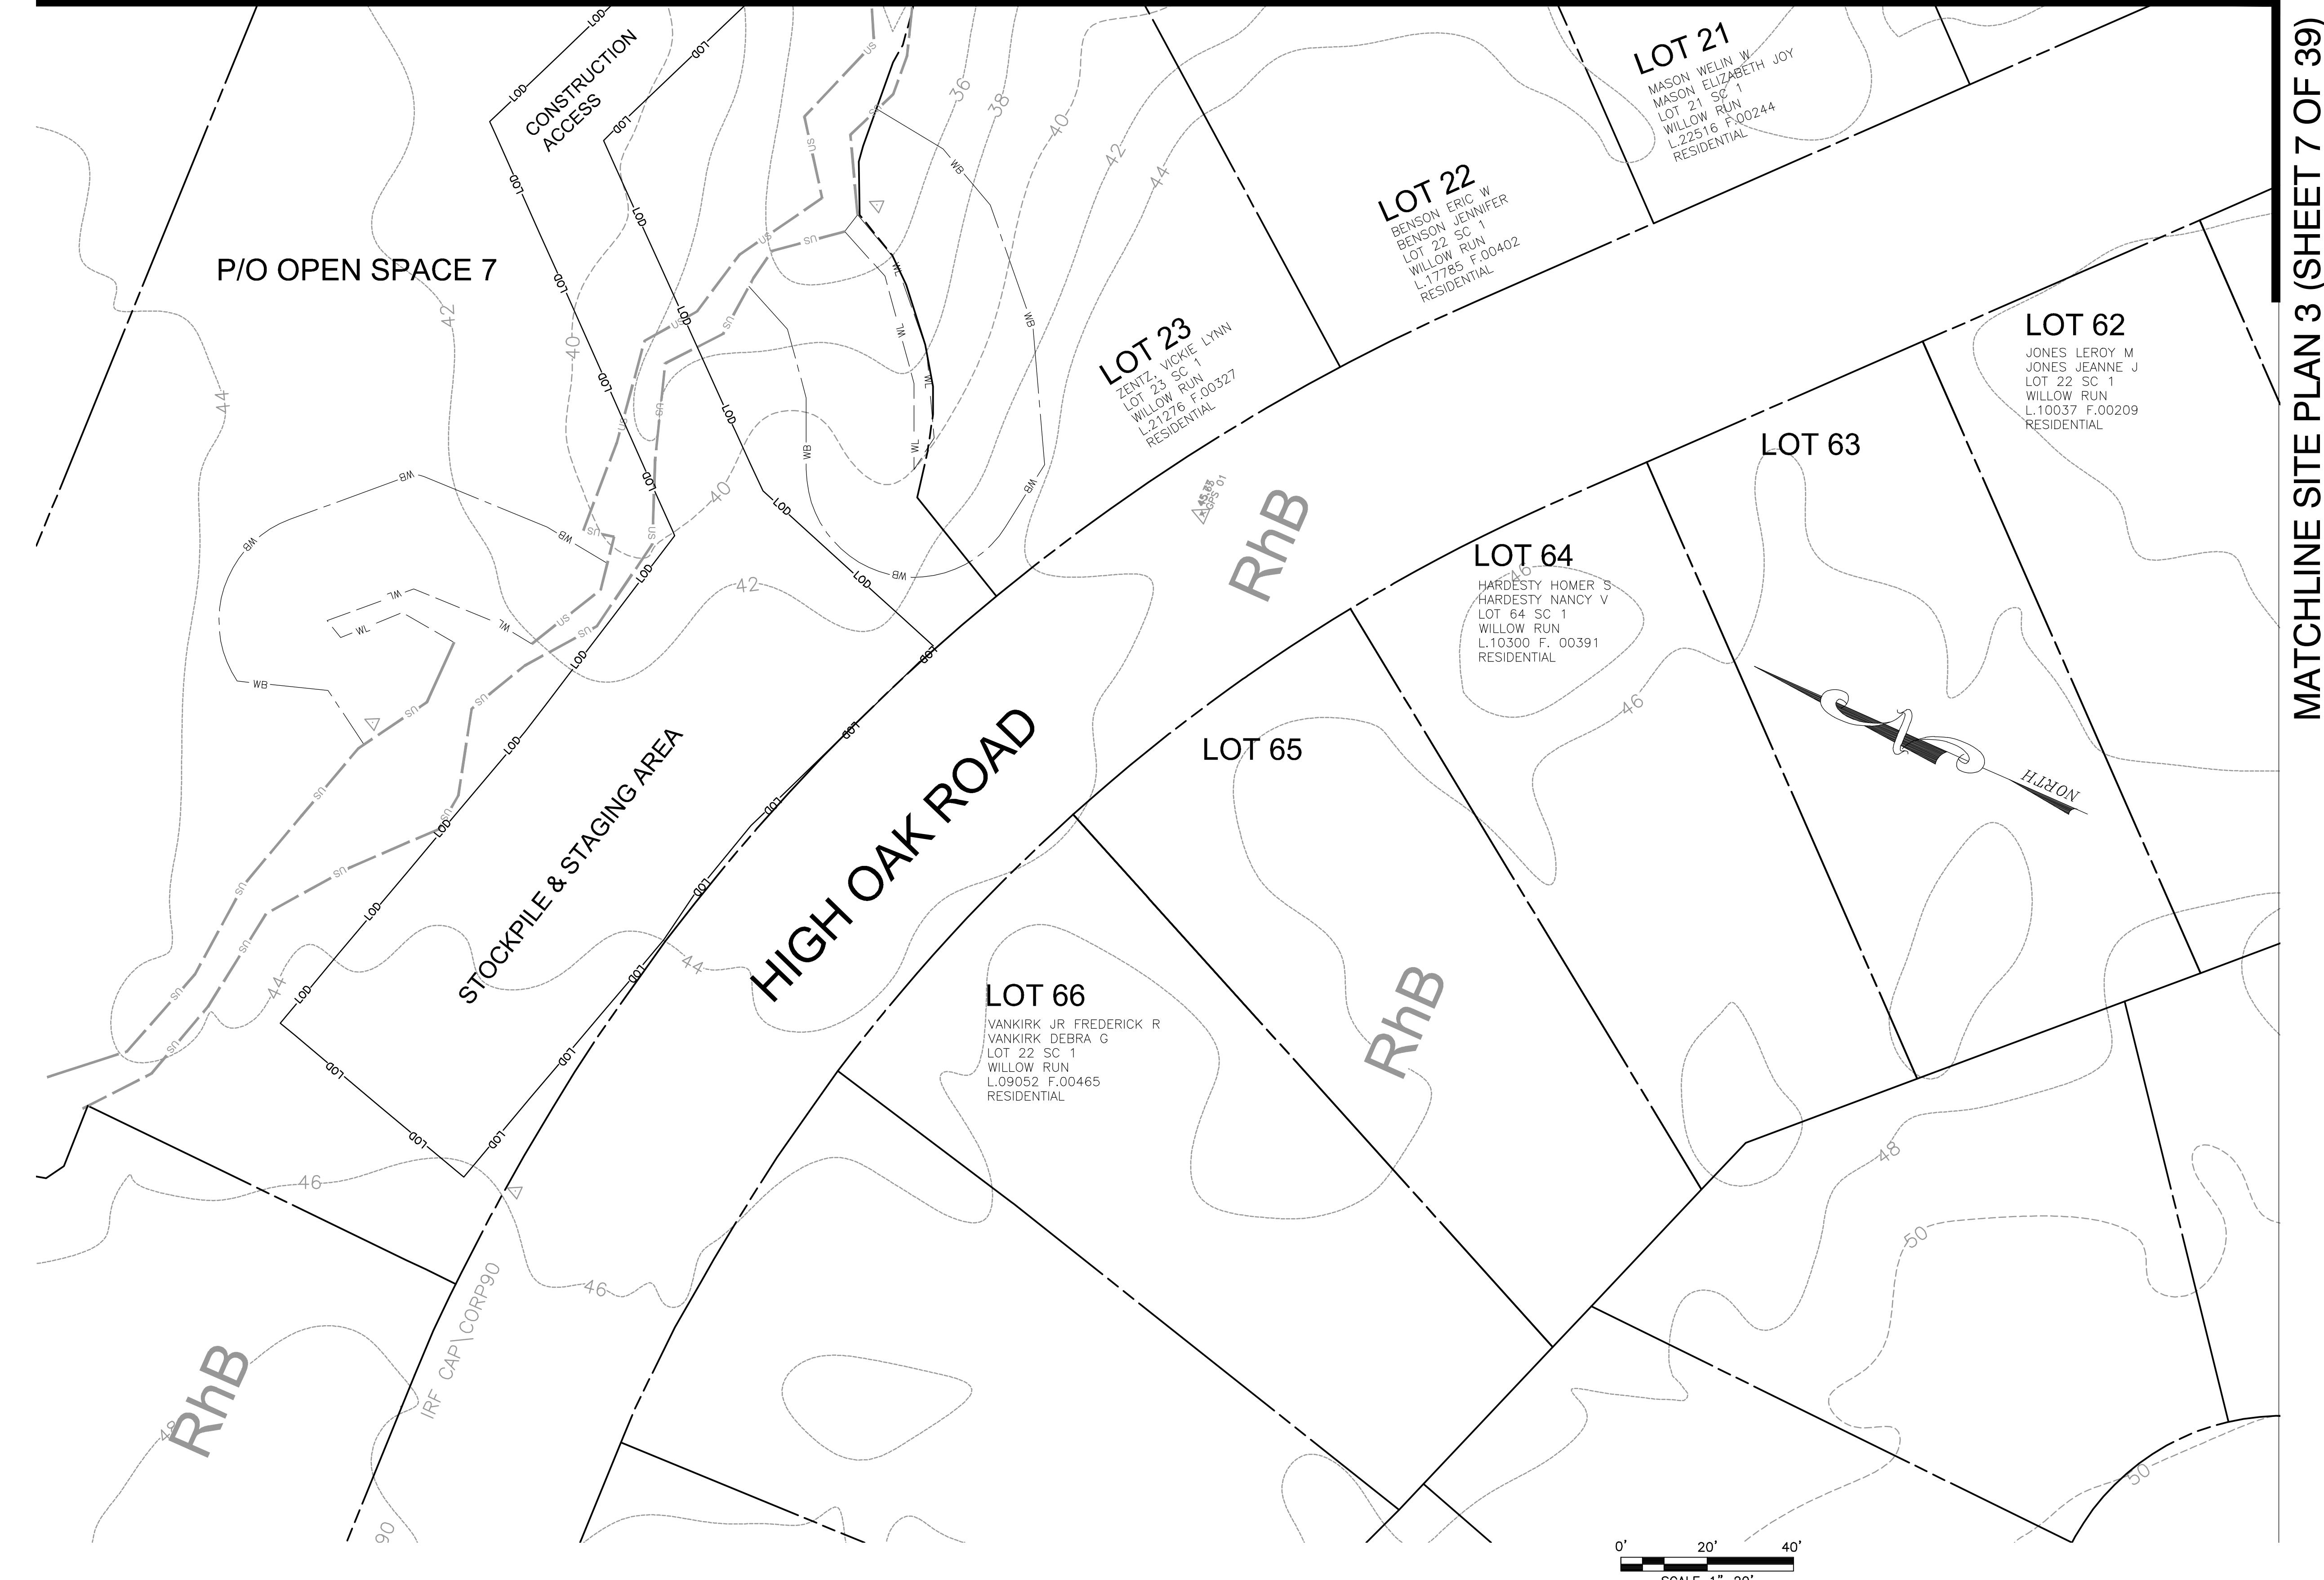

SINE ADLINDEL COUNTY

DEPARTMENT OF PUBLIC WORKS

STREAM RESTORATION PLAN

RESTORATION SITE PLAN 2

SLOOP COVE RETROFIT SITE 1

Tax Map 16 Grid 05 Anne Arundel County

Anne Arundel County

OWNER/DEVELOPER/APPLICANT

717-627-4440
fax: 717-627-4660

landstudies.com
land@landstudies.com

315 North Street | Lititz, PA 17543

CIVIL ENGINEER
A.A. County ID #721



CIVIL ENGINEER
A.A. County ID #721

Background

newspaper

Gaither Road
#342

#340
ville, MD 20850

act: Joanne M. Cheek, Seni

e: (301) 337-2856

(301) 258-7607

 MARYLAND STATE CHECK 1995 ENGINEER REGISTERED 18095 12/21/2014	
<p>Professional Certification I, [Signature], certify that these documents were prepared or approved by me and that I am a duly licensed professional engineer under the laws of the State of Maryland.</p> <p>License No. 18095, Expiration Date: 12/21/2014</p>	

ANNE ARUNDEL COUNTY
DEPARTMENT OF PUBLIC WORKS

PROVED	DATE	APPROVED	DATE	SCALE: As Shown	STREAM RESTORATION PLAN				
				DRAWN BY: BJF/R. Anchors	RESTORATION SITE PLAN 2				
CHIEF ENGINEER		PROJECT MANAGER		CHECKED BY: J. Cheok					
				SHEET NO: 6 OF 39					
				PROJECT NO: 50017963					
				PROPOSAL NO:					
PROVED		DATE		ASSISTANT CHIEF ENGINEER		CHIEF, RIGHT OF WAY	3rd District	SLOOP COVE RETROFIT SITE 1	Tax Map 16 Grid 05


EXISTING LEGEND

INLET	STORM SD	MH	STORM DRAIN
PROPERTY LINE	WOOD FENCE	CHAIN LINK FENCE	UTILITY POLE
INDEX CONTOUR	INTERMEDIATE CONTOUR		
-30	-32		
DECIDUOUS TREE ≥ 12"DBH	EVERGREEN ≥ 12"DBH		
X			
EXISTING TREES TO BE REMOVED ≥ 12" DIA			
RhB	SMF		SOIL CLASSIFICATION DIVISION LINE
FP	100-YR FP		
US	WATER OF THE US		
WL	WETLAND		
WB	WETLAND BUFFER		
1+50			
HEAD WALL & RIPRAP			

PROPOSED LEGEND

CONTOUR	
ROCK SILL (RS)	
LOG SILL (LS)	
SUBSURFACE ARMORING (SA)	
WOODY DEBRIS/BURIED LOG STRUCTURE	
LOD	LIMITS OF DISTURBANCE
SB-XS#	NBT-XS#
LS-19	NB-XS#
LS-16	
RS-16	22
ROCK SILL	
100-YR FP	
1+50	VALLEY ALIGNMENT

THEORETICAL CHANNEL SYSTEM*
*The theoretical channel system is conceptual.
The multiple threads will not be constructed as shown, but represent the individual flow paths that may develop and evolve over time.

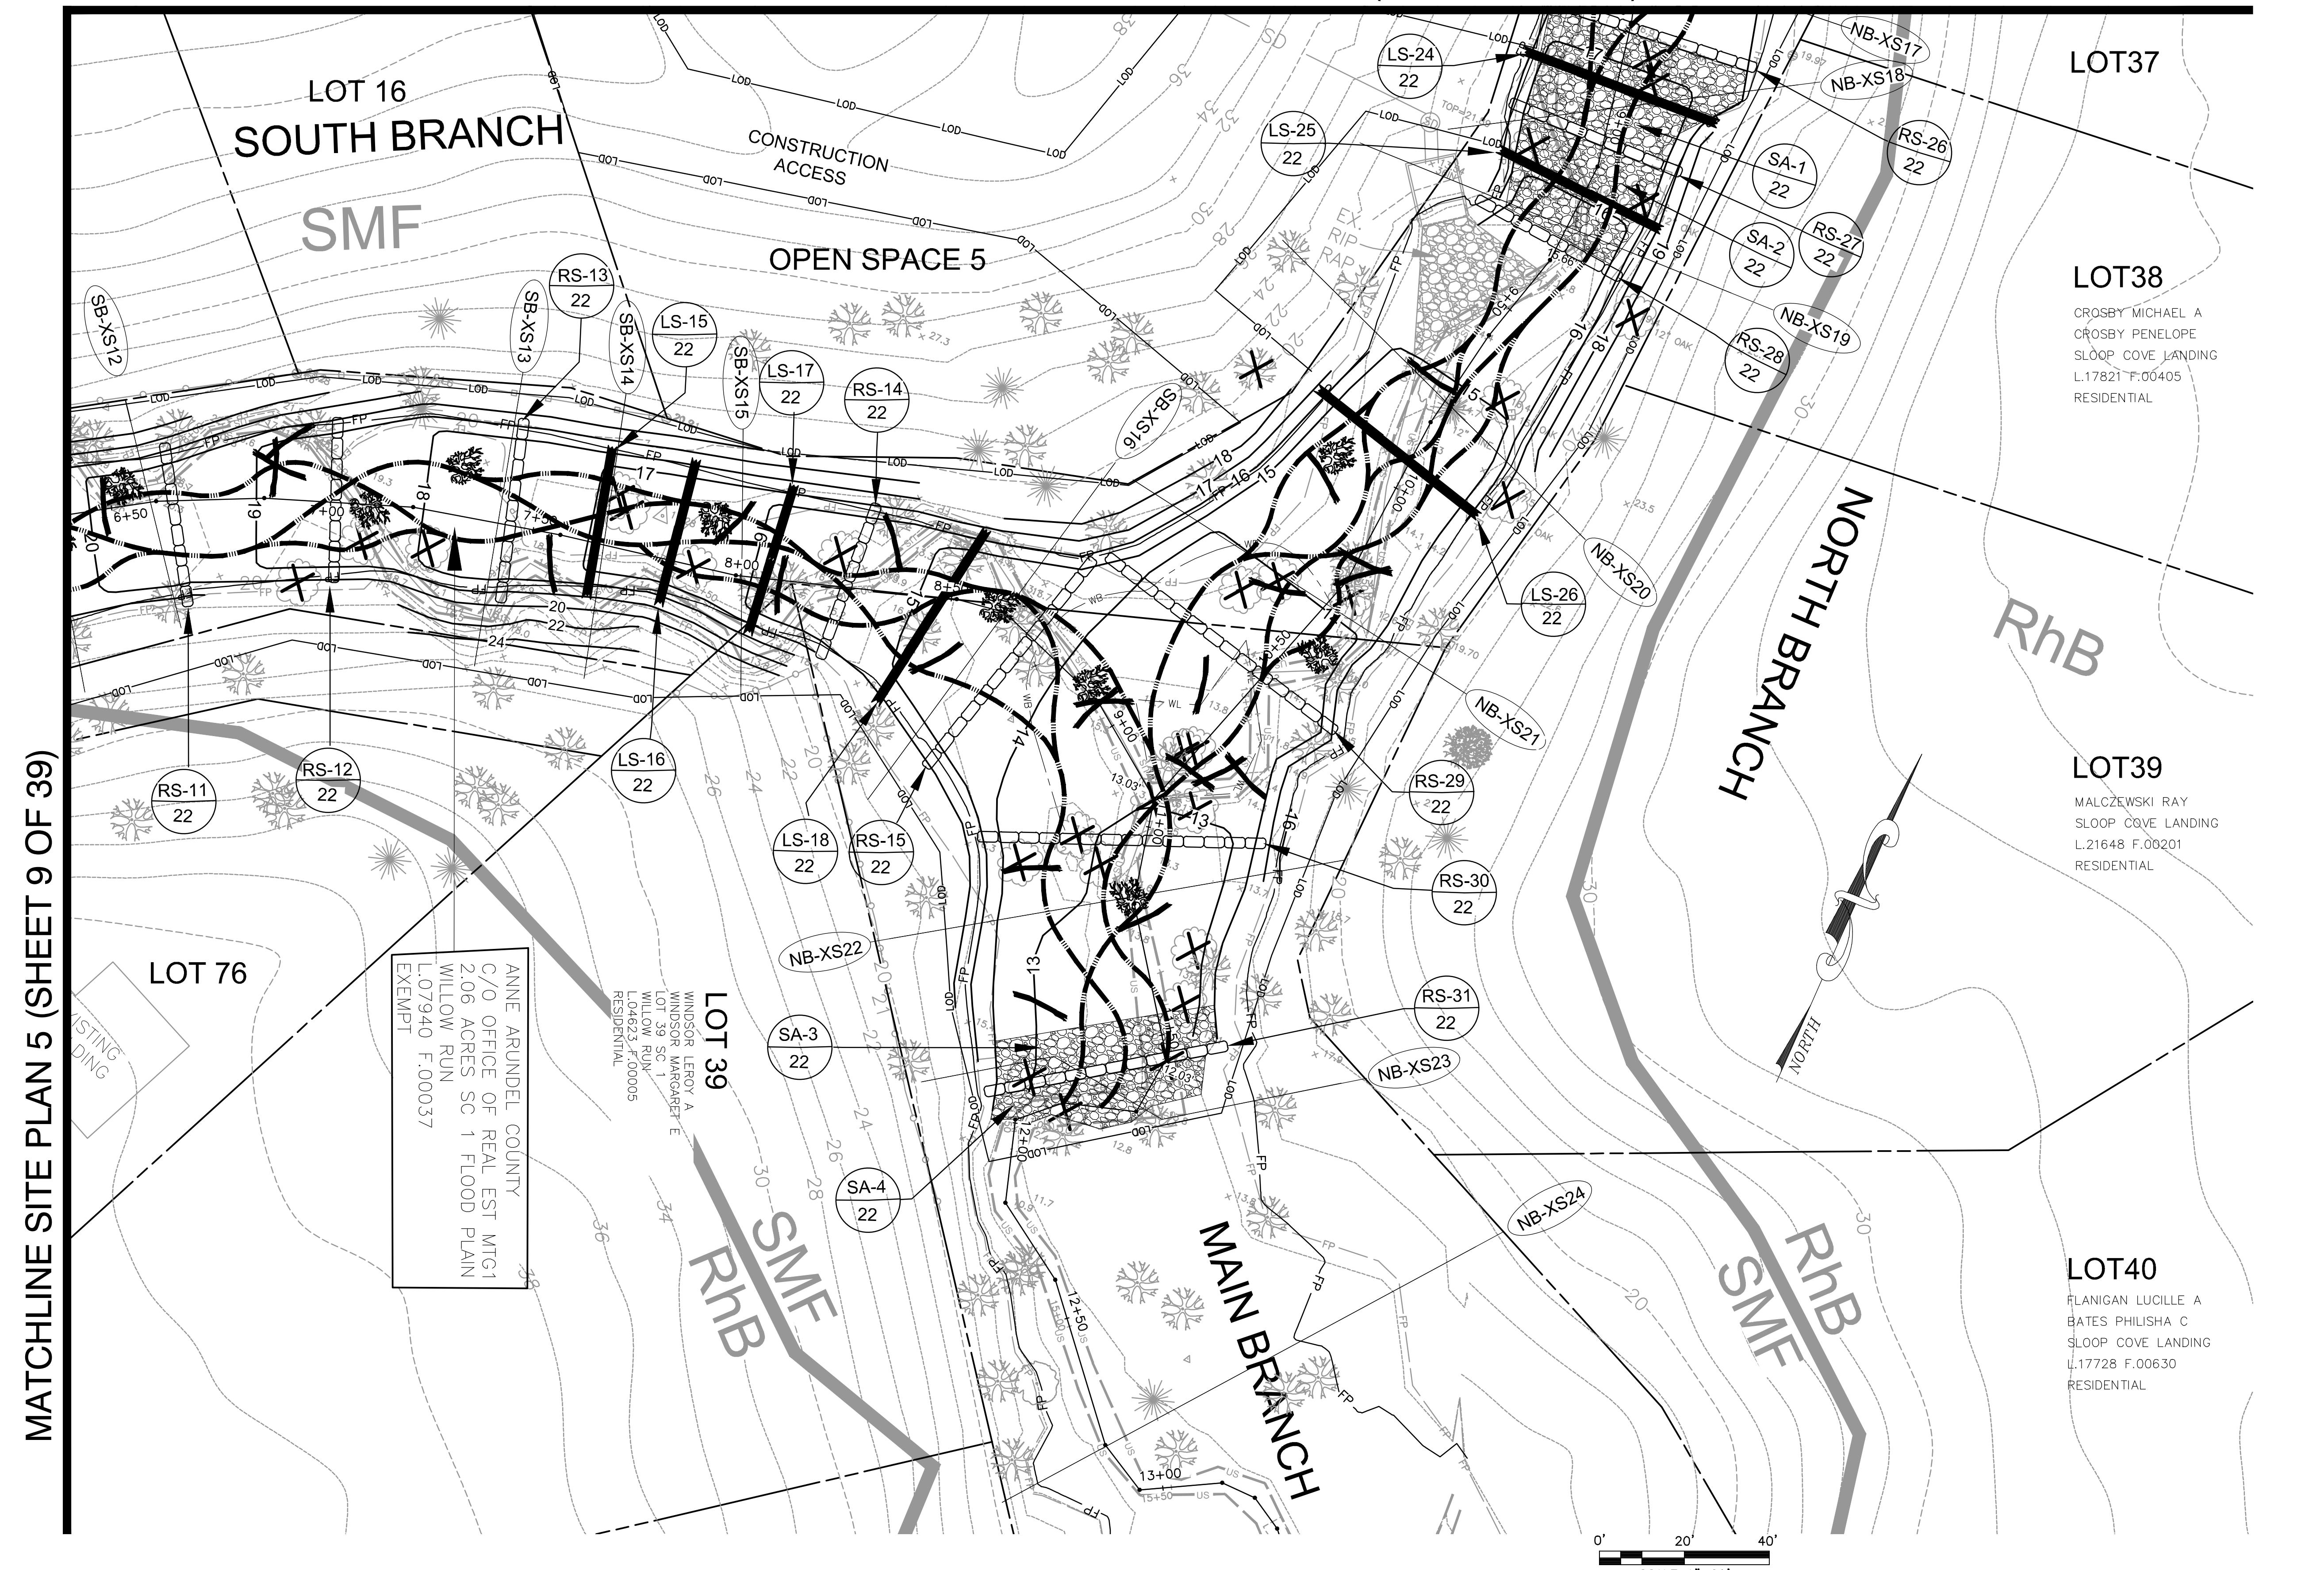MATCHLINE SITE PLAN 3 (SHEET 7 OF 39)


MATCHLINE SITE PLAN 4 (SHEET 8 OF 39)

EXISTING LEGEND

INLET	STORM SD	MH
PROPERTY LINE		
WOOD FENCE		
CHAIN LINK FENCE		
INDEX CONTOUR		
INTERMEDIATE CONTOUR		
DECIDUOUS TREE ≥ 12"DBH		
EVERGREEN ≥ 12"DBH		
X	EXISTING TREES TO BE REMOVED ≥ 12" DIA	
RhB	SOIL CLASSIFICATION DIVISION LINE	
SMF		
FP	100-YR FP	
US	WATER OF THE US	
WL	WETLAND	
WB	WETLAND BUFFER	
1+50	STREAM ALIGNMENT	
	HEAD WALL & RIPRAP	

PROPOSED LEGEND

CONTOUR	23
ROCK SILL (RS)	
LOG SILL (LS)	
SUBSURFACE ARMORING (SA)	
WOODY DEBRIS/BURIED LOG STRUCTURE	
LOD	LIMITS OF DISTURBANCE
SB-XS# NBT-XS# NB-XS#	CROSS SECTION
LS-19 22	LOG SILL
RS-16 22	ROCK SILL
FP	100-YR FP
1+50	VALLEY ALIGNMENT

THEORETICAL CHANNEL SYSTEM*
*The theoretical channel system is conceptual.
The multiple threads will not be constructed as
shown, but represent the individual flow paths
that may develop and evolve over time.

LOT 58

MOSS JR MARION G
MOSS ROSANA D
LOT 58 SC 1
WILLOW RUN
L.09145 F. 00468
RESIDENTIAL

HIGH OAK ROAD

LOT 56

KRESSIG MARK
LOT 56 SC 1
KRESSIG LOIS
WILLOW RUN
L. 18450/ F.00215
RESIDENTIAL

LOT 55

HALL MICHAEL A SC 1
WILLOW RUN
L. 15299/ F.00402
RESIDENTIAL

LOT 11

REMMERT DAVID L SC 1
REMMERT LOUISE M
WILLOW RUN
L. 09653/ F.00211
RESIDENTIAL

LOT 12

NO

LOT 13

SB-XS8

LOT 11

LOT 12

SB-XS5

LOT 13

SB-XS8

LOT 11

LOT 12

SB-XS5

LOT 14

SB-XS10

LOT 14

LOT 15

SB-XS11

LOT 15

LS-14 22

LOT 14

LOT 15

LS-13 22

LOT 16

LS-12 22

LOT 16

LOT 17

LS-11 22

LOT 17

LS-10 22

LOT 17

LOT 18

LS-9 22

LOT 18

LS-8 22

LOT 18

LOT 19

LS-7 22

LOT 19

LS-6 22

LOT 19

LOT 20

RS-4 22

LOT 20

RS-5 22

LOT 20

LOT 21

RS-6 22

LOT 21

RS-7 22

LOT 21

LOT 22

RS-8 22

LOT 22

RS-9 22

LOT 22

LOT 23

RS-10 22

LOT 23

RS-11 22

LOT 23

LOT 24

RS-12 22

LOT 24

RS-13 22

LOT 24

LOT 25

RS-14 22

LOT 25

RS-15 22

LOT 25

LOT 26

RS-16 22

LOT 26

RS-17 22

LOT 26

LOT 27

RS-18 22

LOT 27

RS-19 22

LOT 27

LOT 28

RS-20 22

LOT 28

RS-21 22

LOT 28

LOT 29

RS-22 22

LOT 29

RS-23 22

LOT 29

LOT 30

RS-24 22

LOT 30

RS-25 22

LOT 30

LOT 31

RS-26 22

LOT 31

RS-27 22

LOT 31

LOT 32

RS-28 22

LOT 32

RS-29 22

LOT 32

LOT 33

RS-30 22

LOT 33

RS-31 22

LOT 33

LOT 34

RS-32 22

LOT 34

RS-33 22

LOT 34

LOT 35

RS-34 22

LOT 35

RS-35 22

LOT 35

LOT 36

RS-36 22

LOT 36

RS-37 22

LOT 36

LOT 37

RS-38 22

LOT 37

RS-39 22

LOT 37

LOT 38

RS-40 22

LOT 38

RS-41 22

LOT 38

LOT 39

RS-42 22

LOT 39

RS-43 22

LOT 39

LOT 40

RS-44 22

LOT 40

RS-45 22

LOT 40

LOT 41

RS-46 22

LOT 41

RS-47 22


LOT 41

LOT 42


RS-48

MATCHLINE SITE PLAN 5 (SHEET 9 OF 39)


EXISTING LEGEND

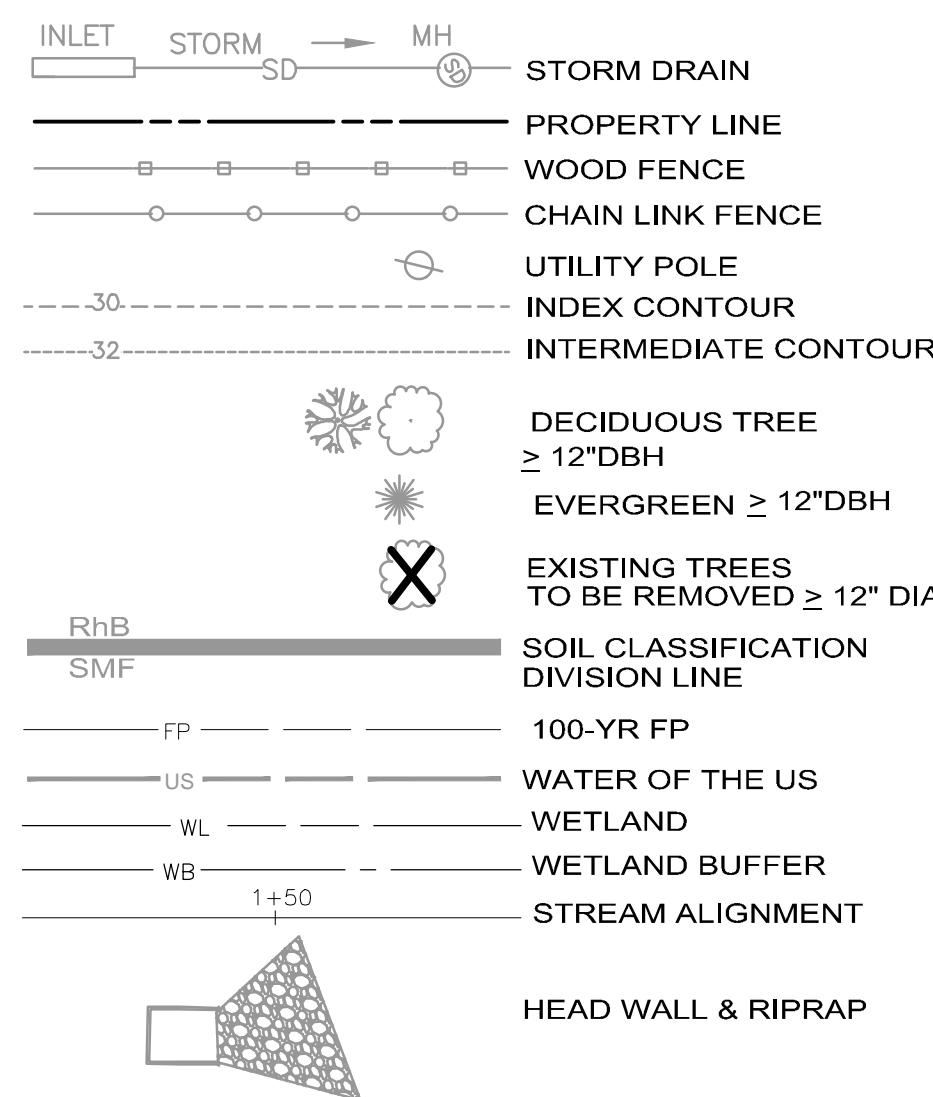

PROPOSED LEGEND

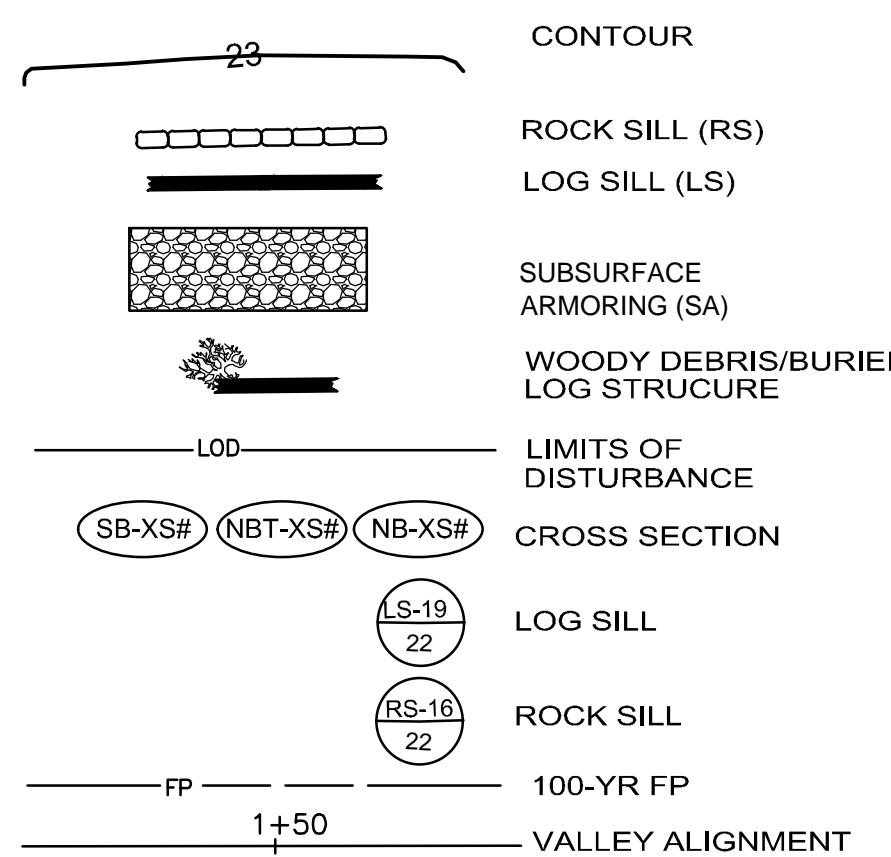

THEORETICAL CHANNEL SYSTEM
The theoretical channel system is conceptual. The multiple threads will not be constructed as shown, but represent the individual flow paths that may develop and evolve over time.

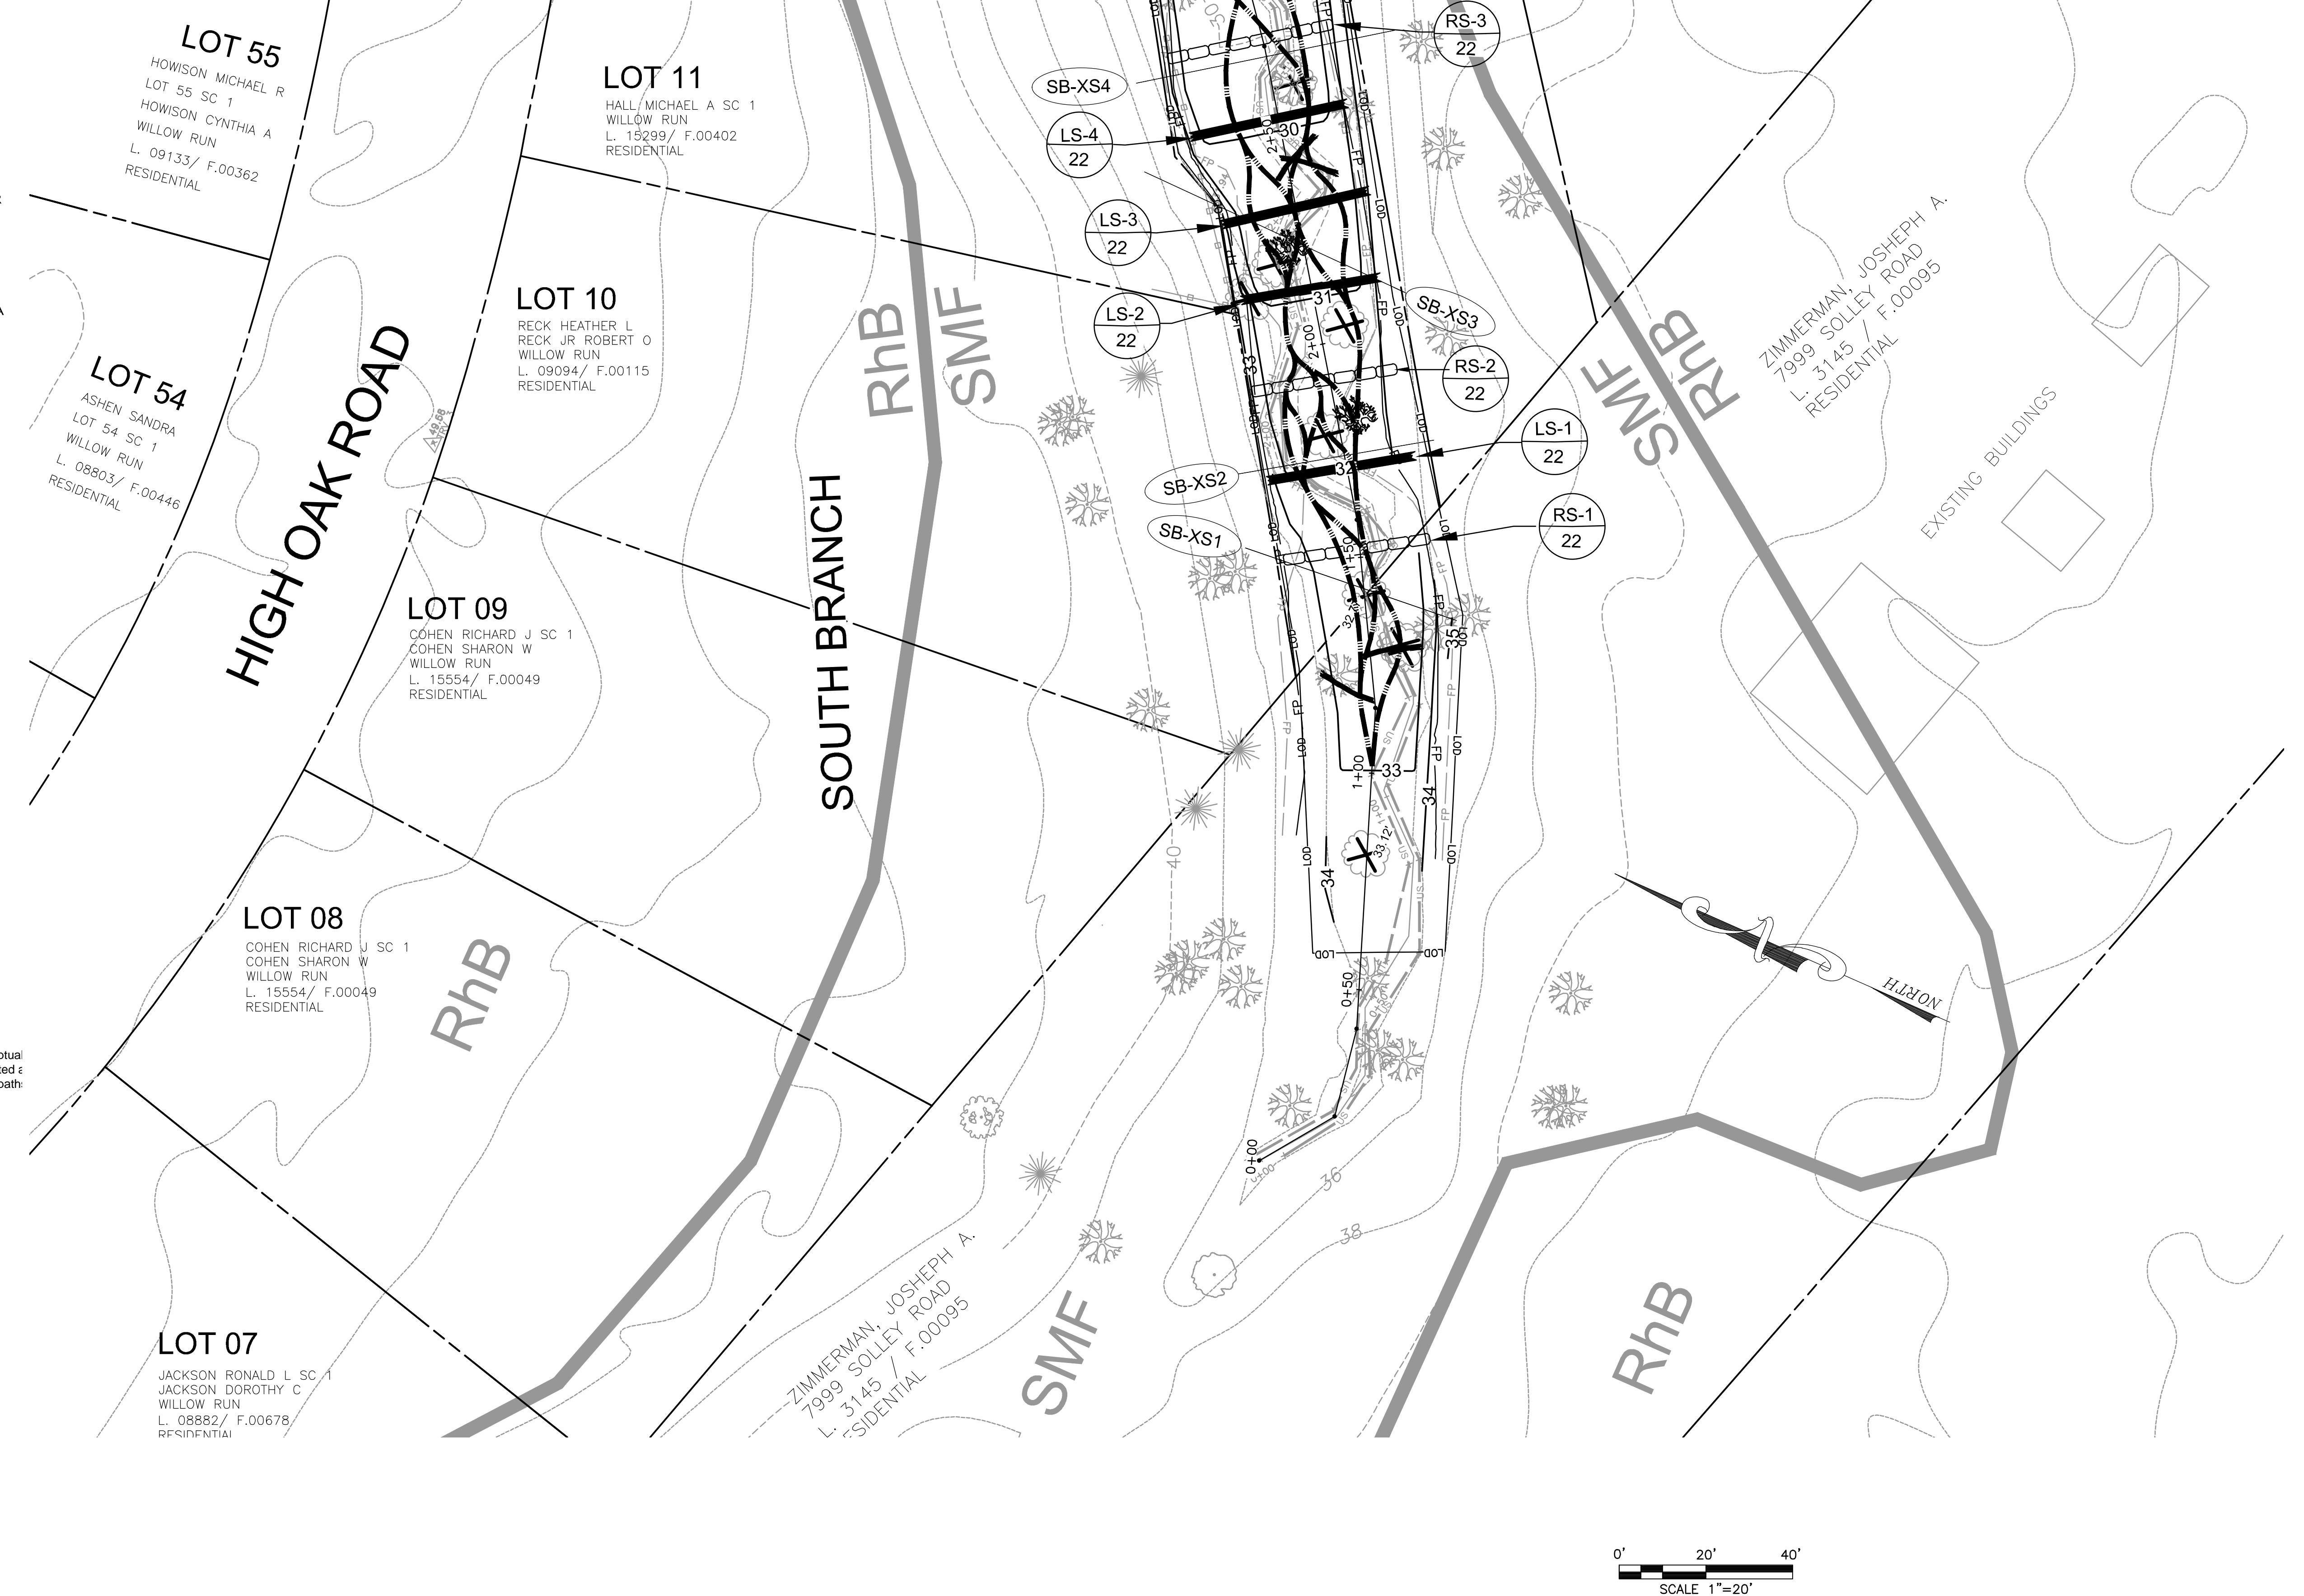

ANNE ARUNDEL COUNTY

DEPARTMENT OF PUBLIC WORKS

STREAM RESTORATION PLAN

RESTORATION SITE PLAN 6
SLOOP COVE RETROFIT SITE 1

Tax Map 16 Grid 05

Anne Arundel County

OWNER/DEVELOPER/APPLICANT

2022084

CIVIL ENGINEER
A.A. County ID #721

2022084



2022084

717-627-4440
fax: 717-627-4660
landstudies.com
315 North Street | Lititz, PA 17543

Professional Certification: I hereby certify that these documents were prepared or approved by me, and that I am a duly licensed professional engineer under the laws of the State of Maryland, License No. 18095, Expiration Date: 12/21/2022.

REVISIONS

NO

Description

BY

DATE

APPROVED

DATE

CHIEF ENGINEER

PROJECT MANAGER

CHECKED BY: J. Cheek

SHEET NO: 10 OF 39

PROJECT NO: 50017963

PROPOSAL NO:


ASSISTANT CHIEF ENGINEER

CHIEF, RIGHT OF WAY

3rd District

MATCHLINE STA. 6+20, (SEE SHEET 12 OF 39)

N. BRANCH LONGITUDINAL PROFILE

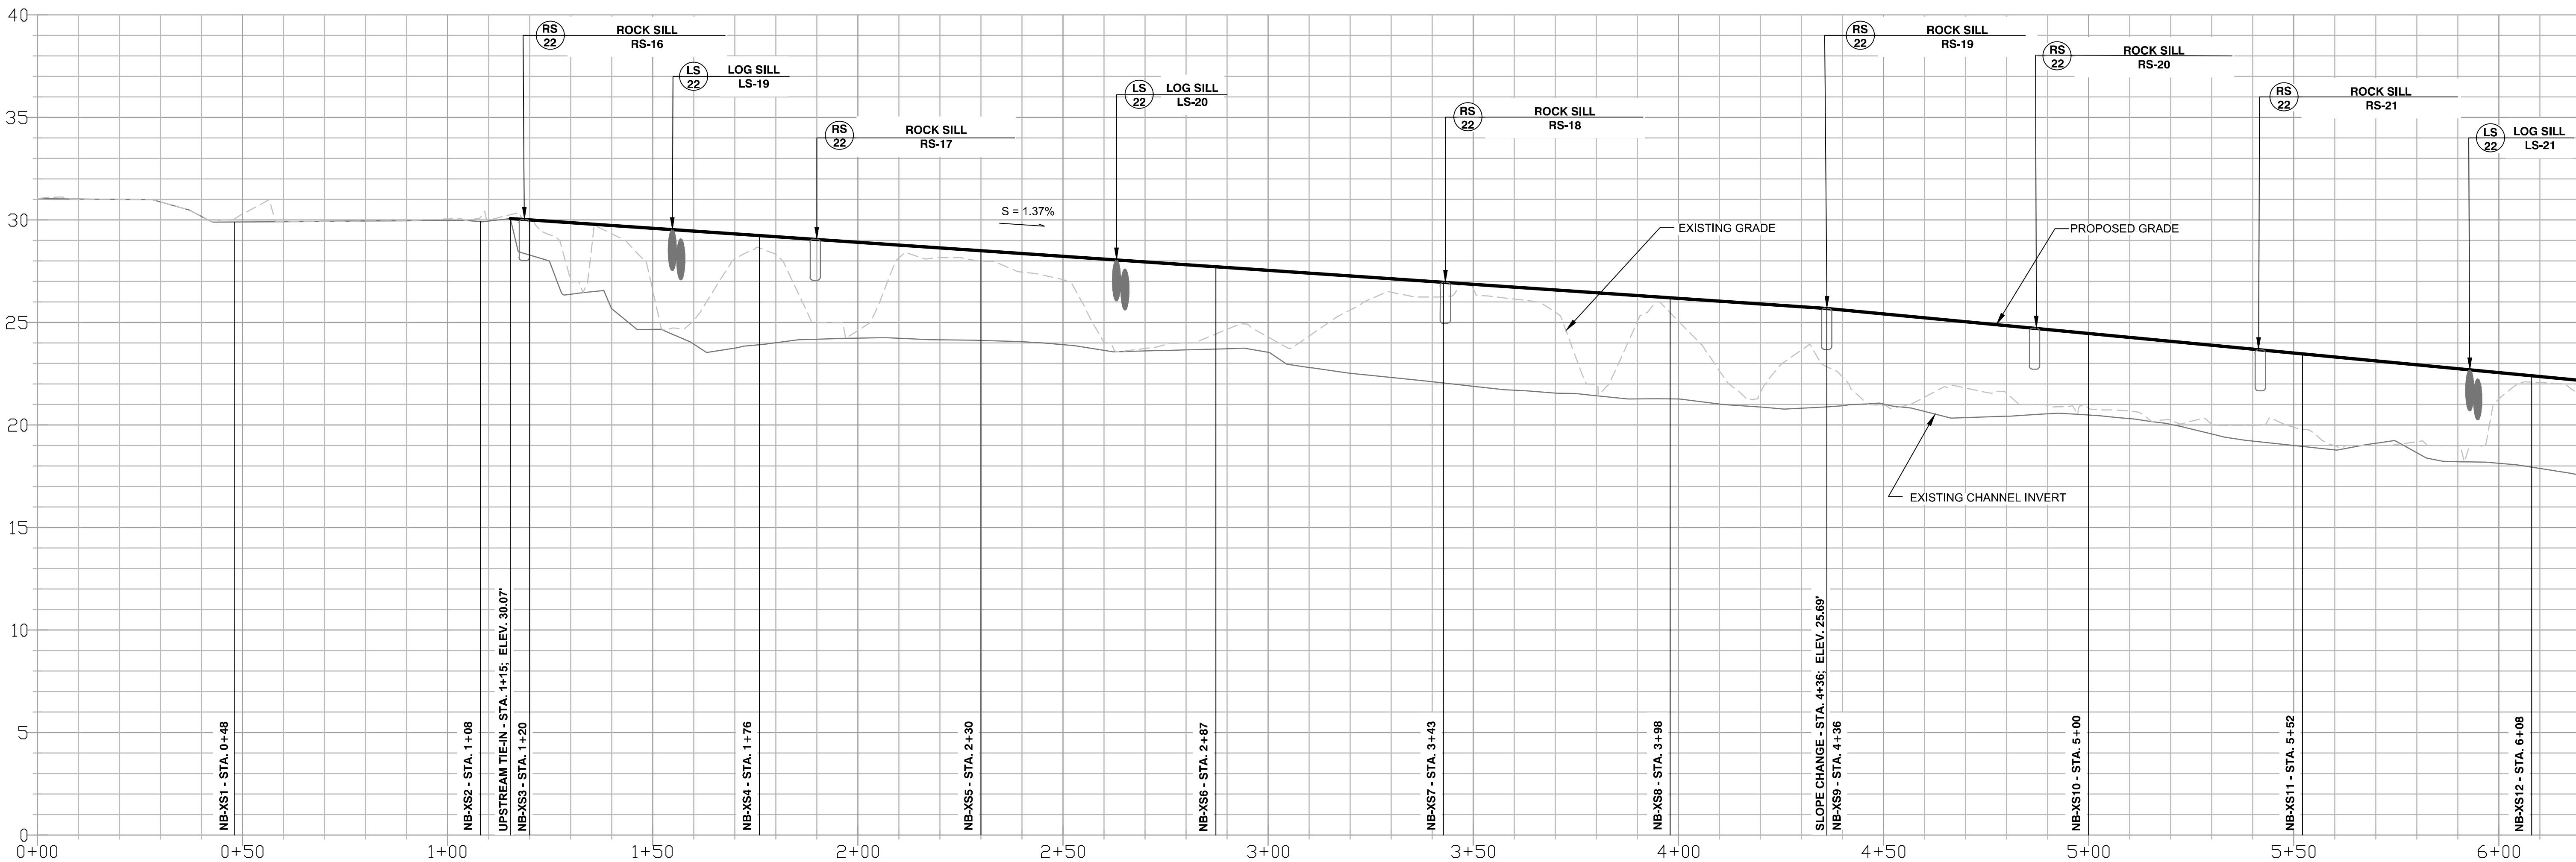

HORIZ: 1" = 20'
VERT: 1" = 4'
0' 20' 40'

OWNER/DEVELOPER/APPLICANT		CIVIL ENGINEER A.A. County ID #721		REVISIONS				ANNE ARUNDEL COUNTY DEPARTMENT OF PUBLIC WORKS STREAM RESTORATION PLAN					
Land Studies	717-627-4440 fax: 717-627-4660 landstudies.com 3115 North Street Lititz, PA 17543	Dewberry	2101 Gaither Road Suite #340 Rockville, MD 20850 Contact: Joanne M. Cheek, Senior Associate Phone: (301) 337-2856 Fax: (301) 258-7607	2/22/24	NO	Description	BY	DATE	APPROVED	DATE	APPROVED	DATE	SCALE: As Shown
									CHIEF ENGINEER	PROJECT MANAGER	CHECKED BY: J. Cheek		DRAWN BY: Bill R. Anchors
									APPROVED	DATE	SHEET NO: 11 OF 39		CHECKED BY: J. Cheek
									ASSISTANT CHIEF ENGINEER	DATE	PROJECT NO: 50017963		PROPOSAL NO:
									CHIEF, RIGHT OF WAY		3rd District		


NORTH BRANCH PROFILE 1
SLOOP COVE RETROFIT SITE 1

Tax Map 16 Grid 05

Anne Arundel County


MATCHLINE STA. 6+20 (SEE SHEET 11 OF 39)

N. BRANCH LONGITUDINAL PROFILE

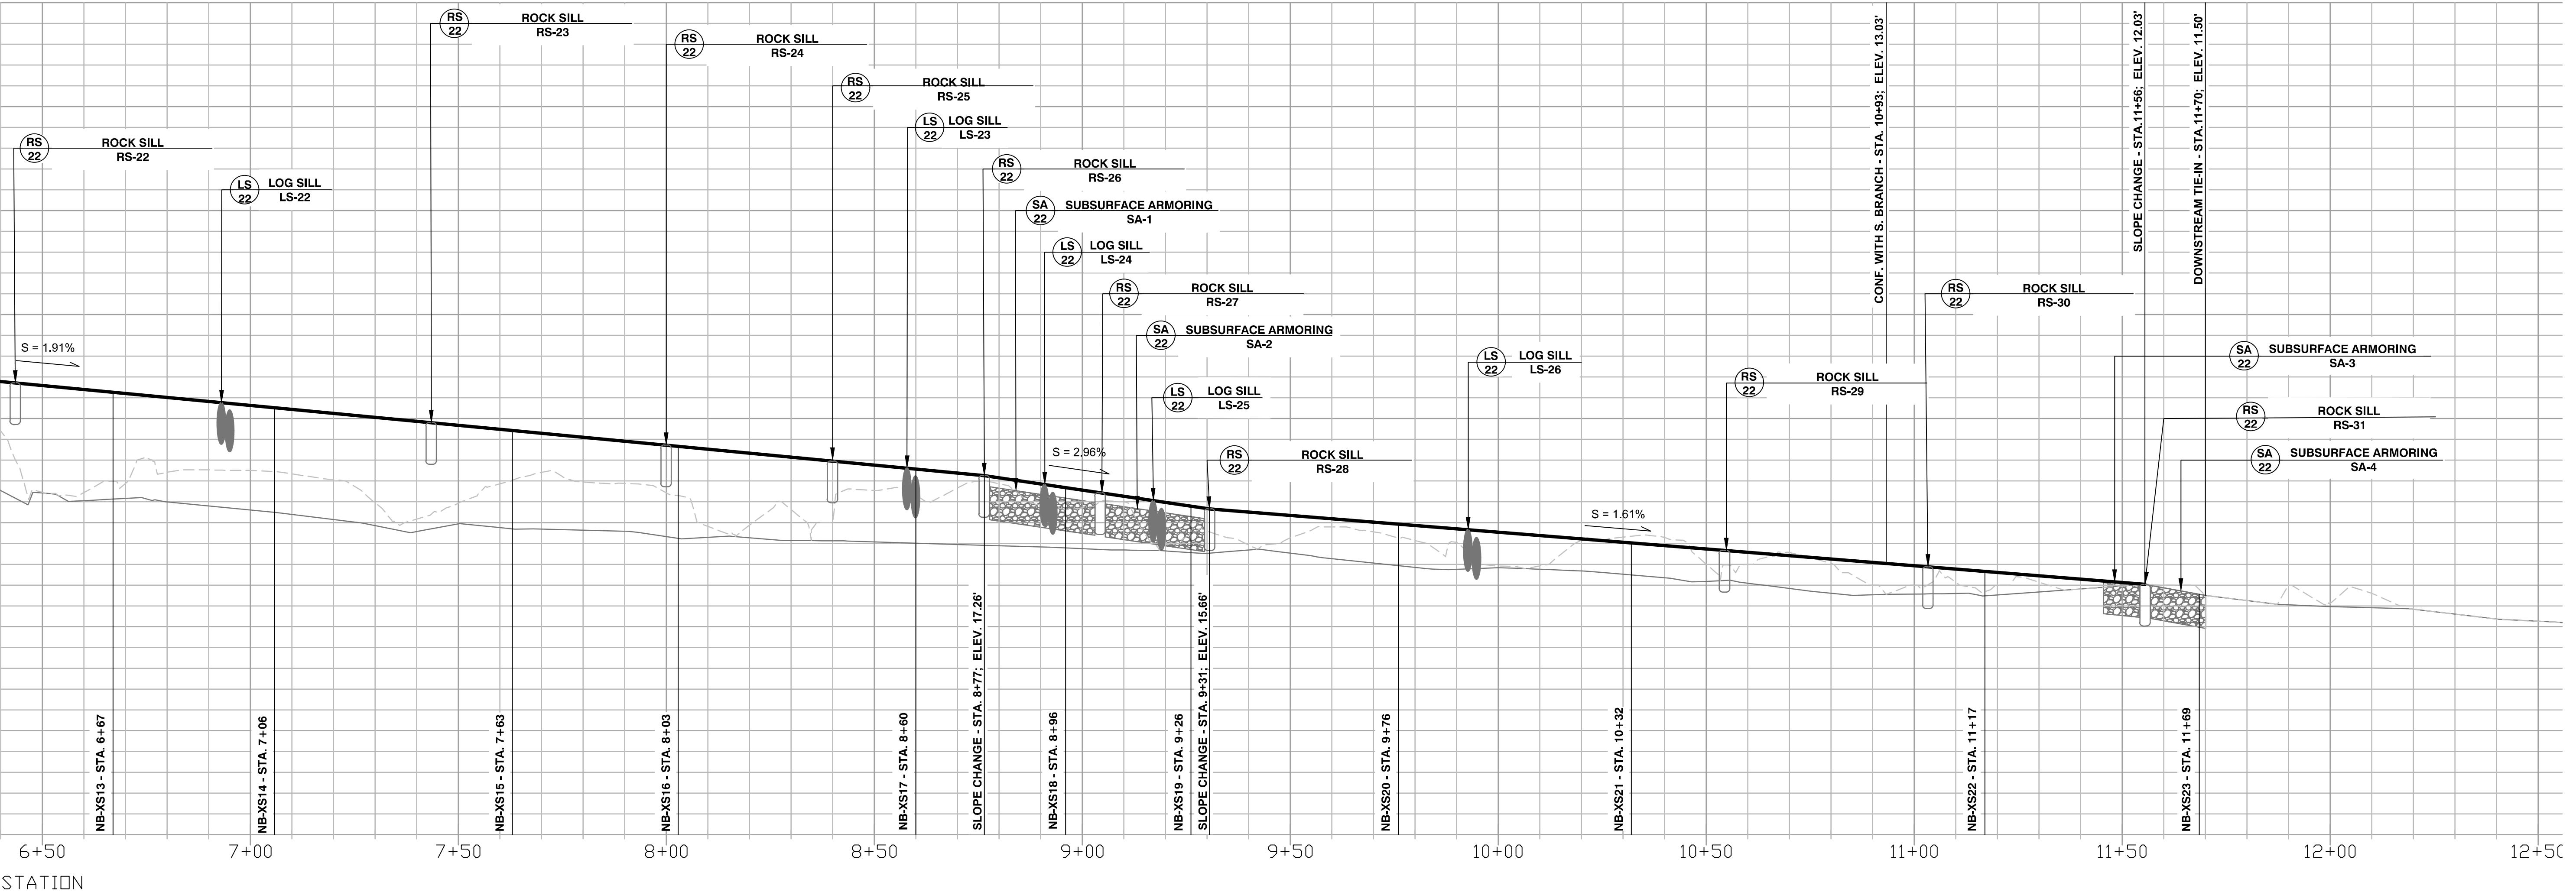



HORIZ: 1" = 20'
VERT: 1" = 4'
20' 40'

S. BRANCH LONGITUDINAL PROFILE

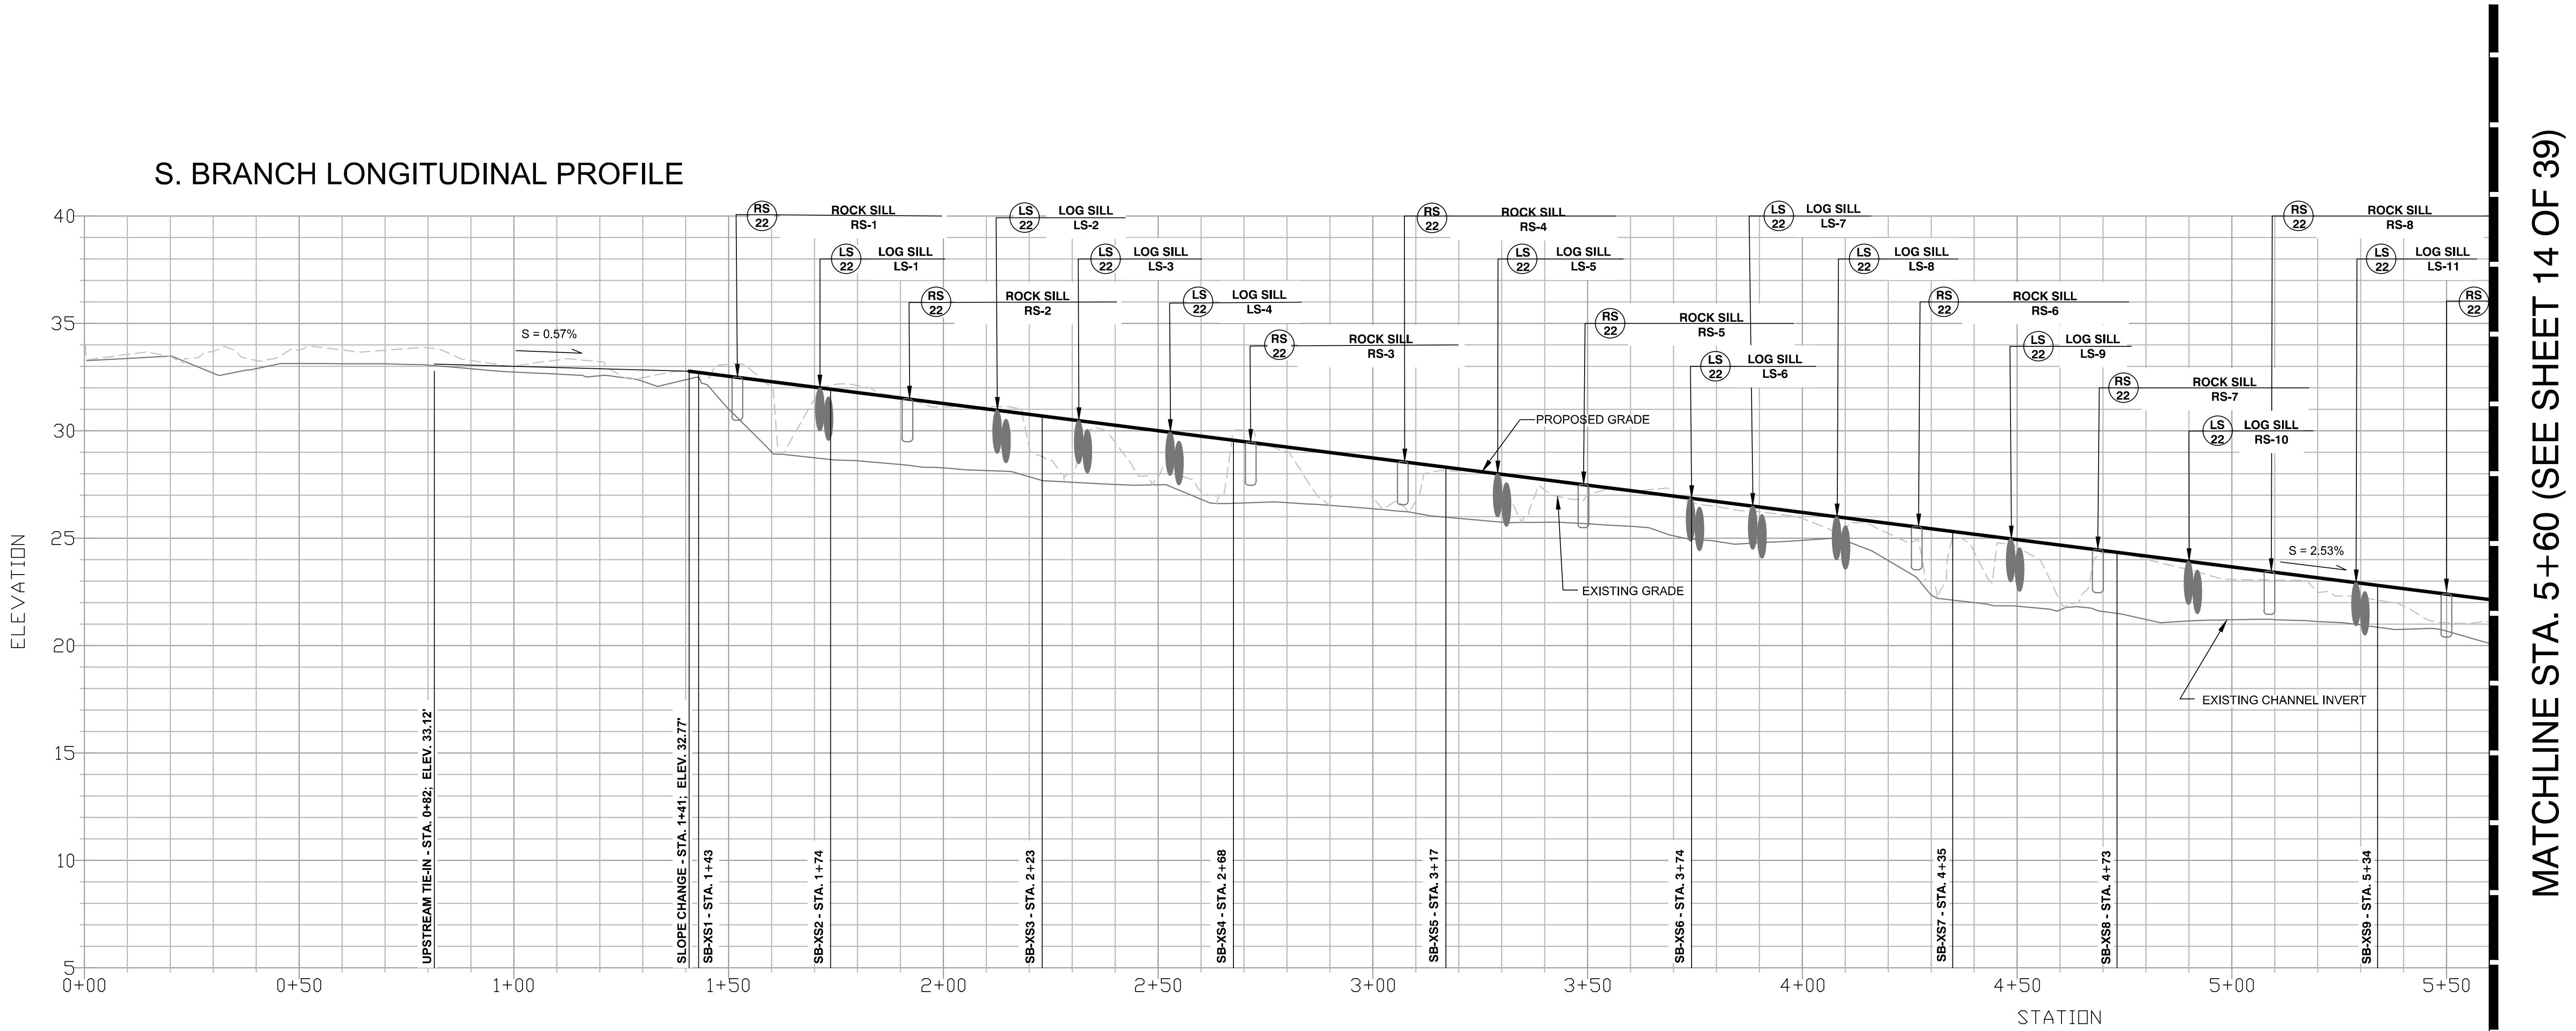


MATCHLINE STA. 5+60 (SEE SHEET 14 OF 39)


HORIZ: 1" = 20'
VERT: 1" = 4'
20' 40'

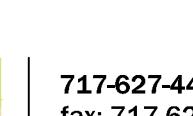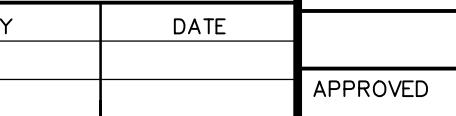OWNER/DEVELOPER/APPLICANT		CIVIL ENGINEER A.A. County ID #721		ANNE ARUNDEL COUNTY		REVISIONS					
	717-627-4440 fax: 717-627-4660 landstudies.com land@landstudies.com 315 North Street Lititz, PA 17543	 Dewberry 2101 Gaither Road Suite #340 Rockville, MD 20850 Contact: Joanne M. Check, Senior Associate Phone: (301) 337-2856 Fax: (301) 258-7607	PA 042324	 STATE OF MARYLAND JOANNE M. CHECK PROFESSIONAL ENGINEER No. 18095 REGISTERED 2/10/2024	DEPARTMENT OF PUBLIC WORKS STREAM RESTORATION PLAN SOUTH BRANCH PROFILE 1 SLOOP COVE RETROFIT SITE 1 3rd District Anne Arundel County Tax Map 16 Grid 05	NO	Description	BY	DATE		
						APPROVED	DATE	APPROVED	DATE	SCALE: As Shown	STREAM RESTORATION PLAN
						CHIEF ENGINEER	PROJECT MANAGER	CHECKED BY: J. Check		DRAWN BY: B.F.R. Anchors	
						APPROVED	DATE	APPROVED	DATE	SHETON: 13 OF 39	License No. 18095, Expiration Date: 12/21/2022.
						ASSISTANT CHIEF ENGINEER	CHEIR, RIGHTOWAY	PROPOSAL NO:		PROJECT NO: 5001793	

MATCHLINE STA. 5+60 (SEE SHEET 13 OF 39)

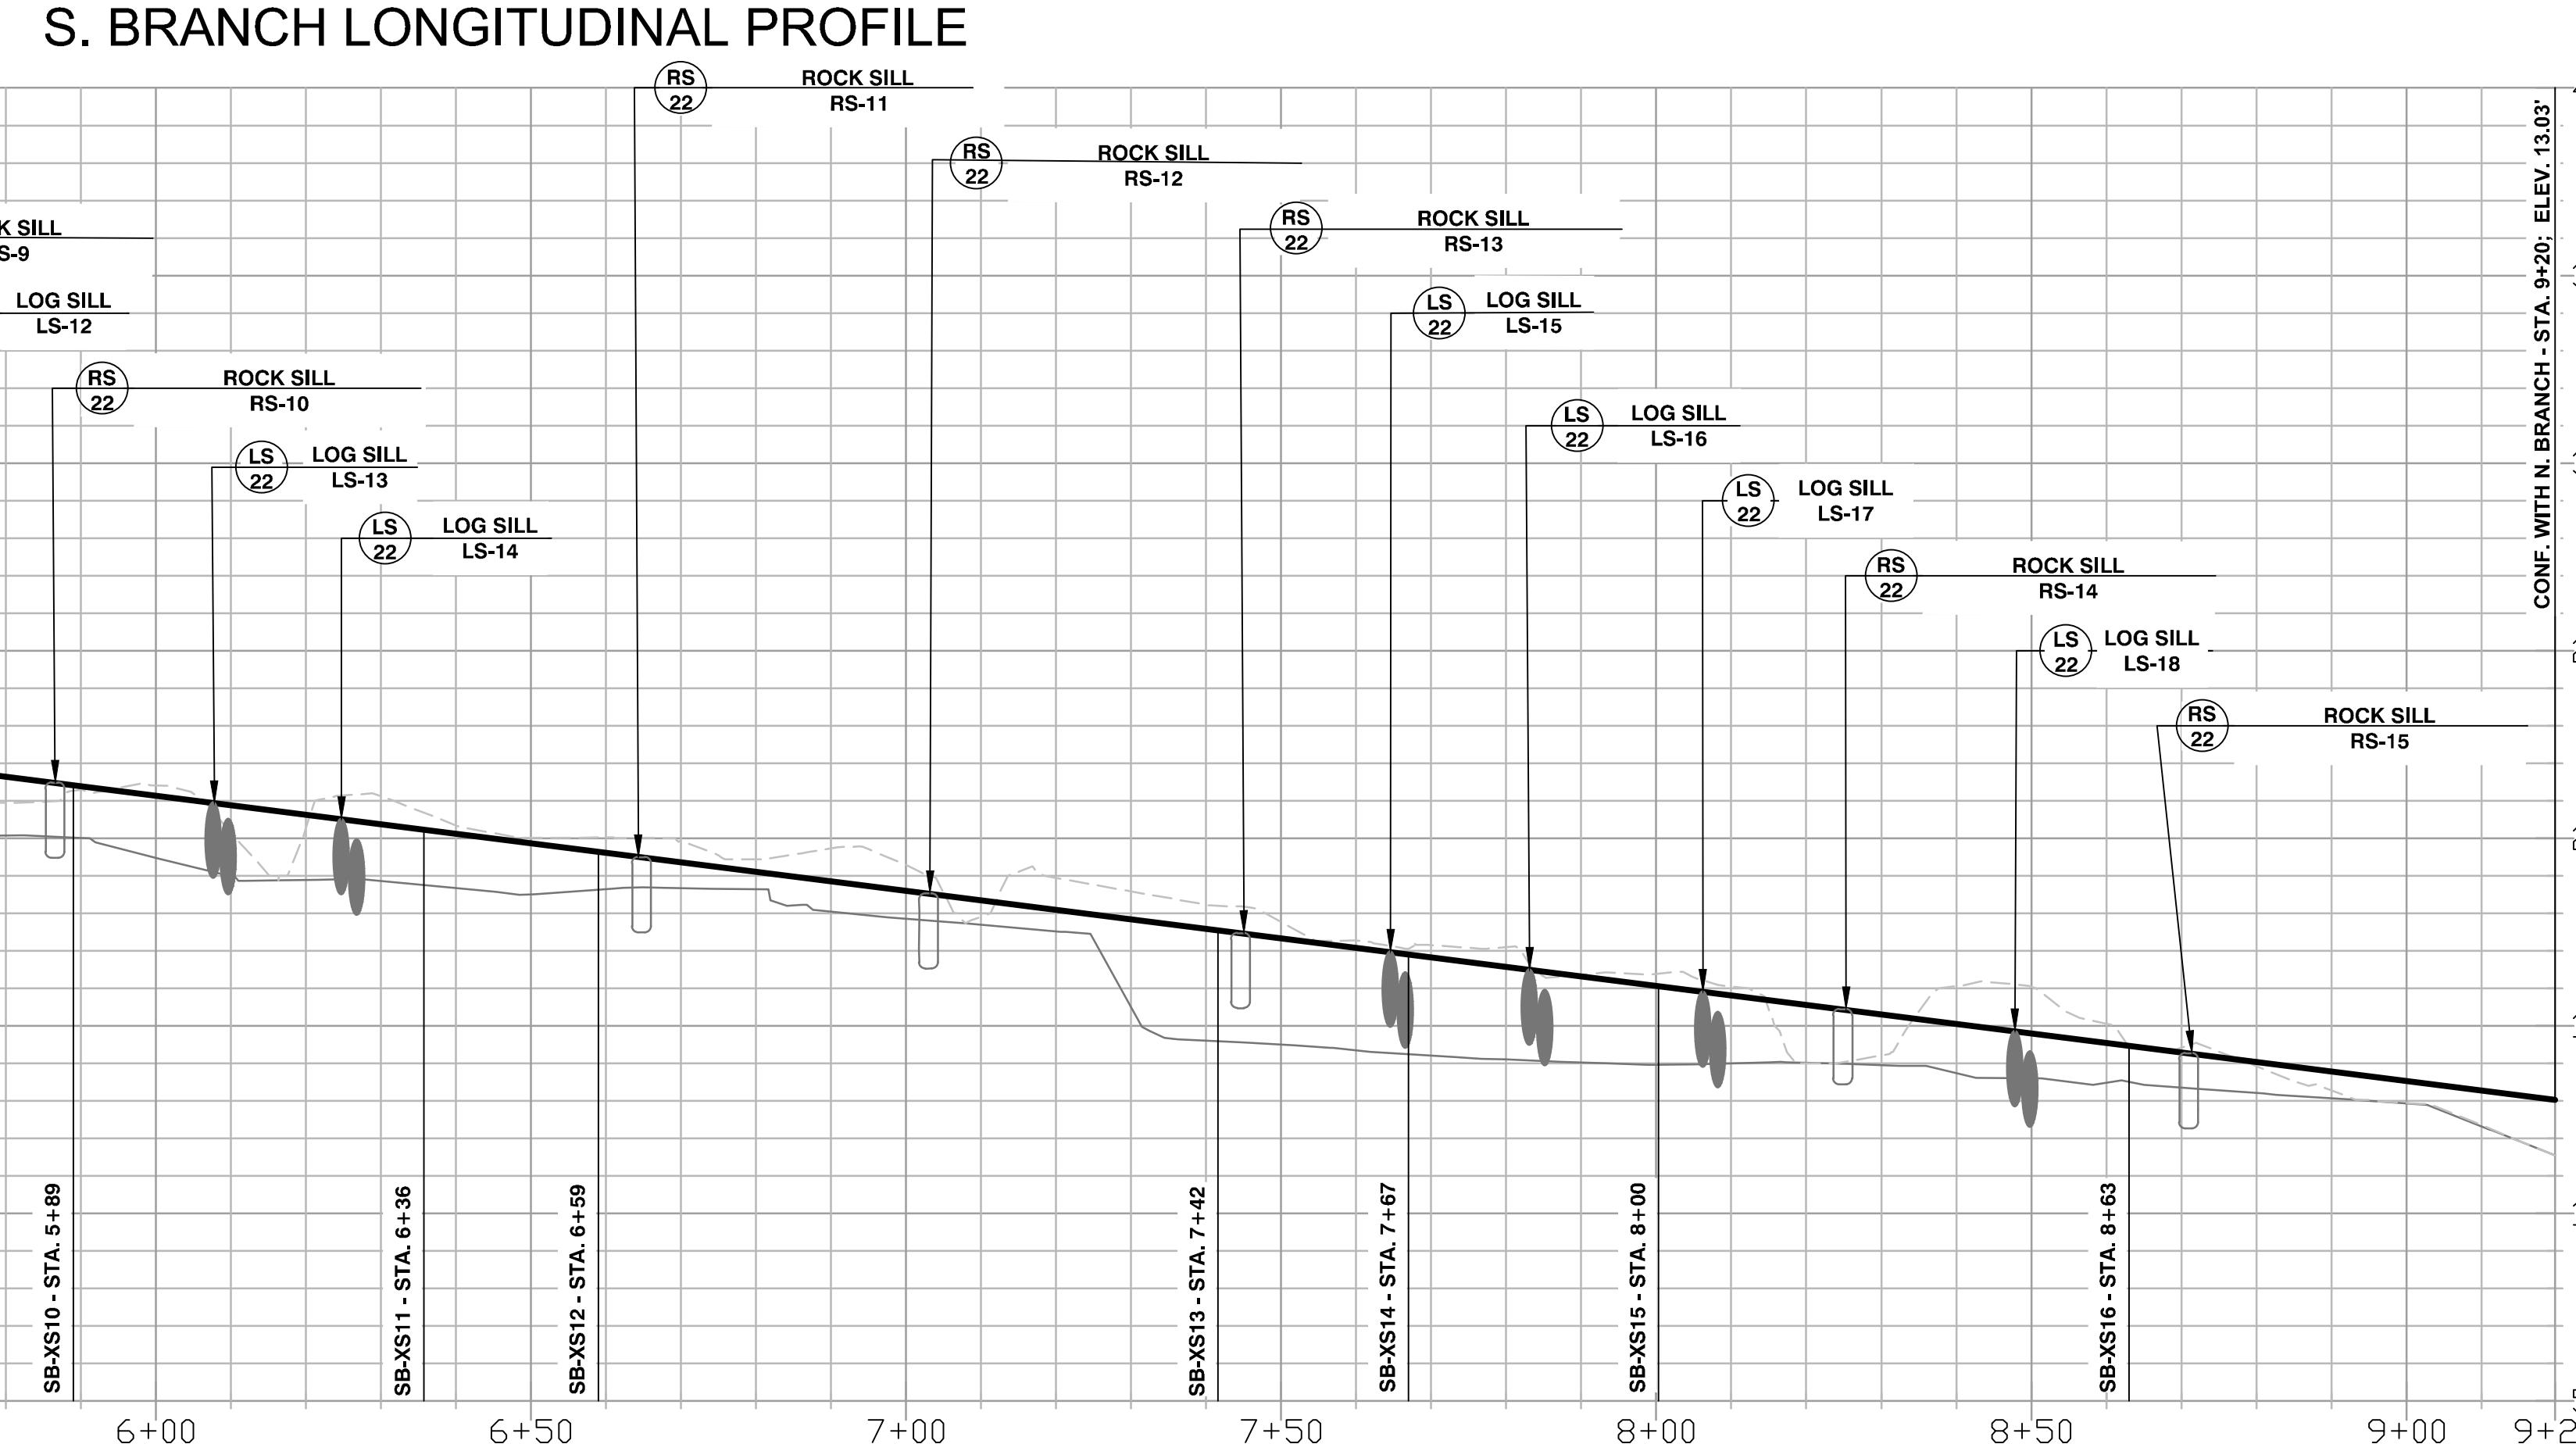

N. BRANCH TRIBUTARY LONGITUDINAL PROFILE

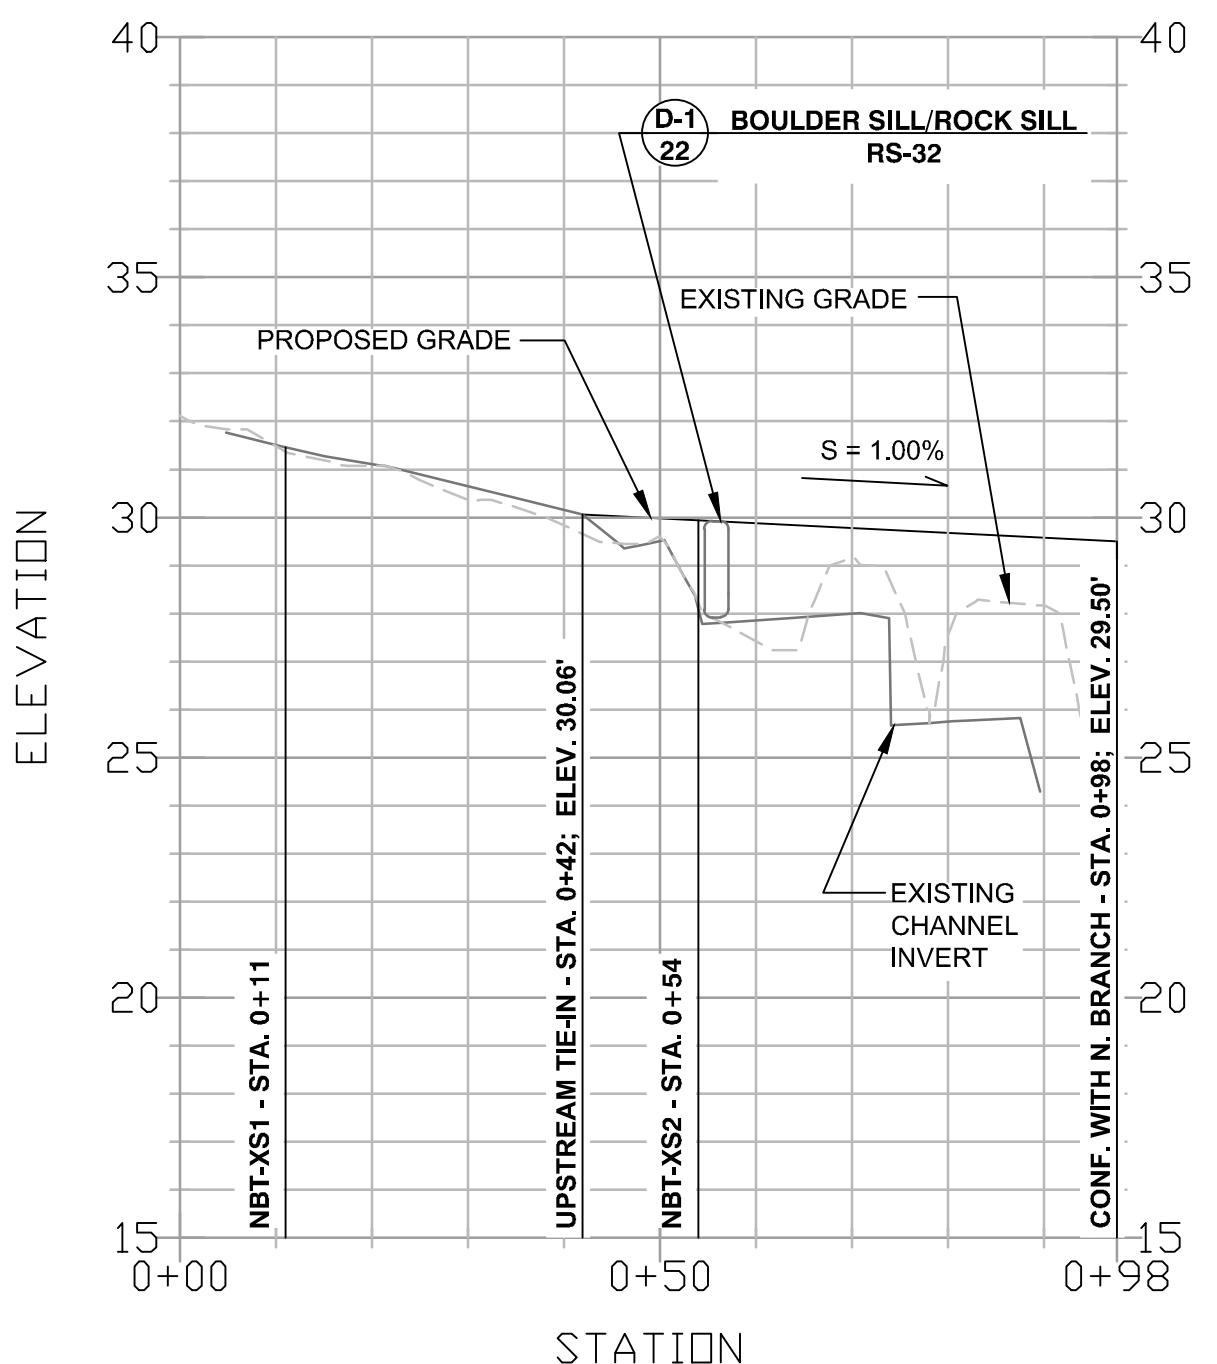

OWNER/DEVELOPER/APPLICANT
717-627-4440
fax: 717-627-4660
landstudies.com
land@landstudies.com
315 North Street | Lititz, PA 17545



CIVIL ENGINEER
A.A. County ID #721



Dewberry

2101 Gaither Road
Suite #340
Rockville, MD 20850

Contact: Joanne M. Cheok, Senior Associate
Phone: (301) 337-2856
Fax: (301) 258-7607



Professional Certification
certify that these documents
prepared or approved by
that I am a duly licensed
professional engineer under
laws of the State of Maryland.

License No. 18095,
Expiration Date: 12/21/2021

ANNE ARUNDEL COUNTY
DEPARTMENT OF PUBLIC WORKS
Shown **STREAM RESTORATION PLAN**
/R. Anchors
J. Cheok
14 OF 39
50017963
3rd District
**SOUTH BRA
SLOOP COVE**
Tax M

SOUTH BRANCH PROFILE 2







SILOOP COVE RETROFIT SITE 1

3rd District



Tax Map 16 Grid 05







Anne Arundel County

Appendix B - 21

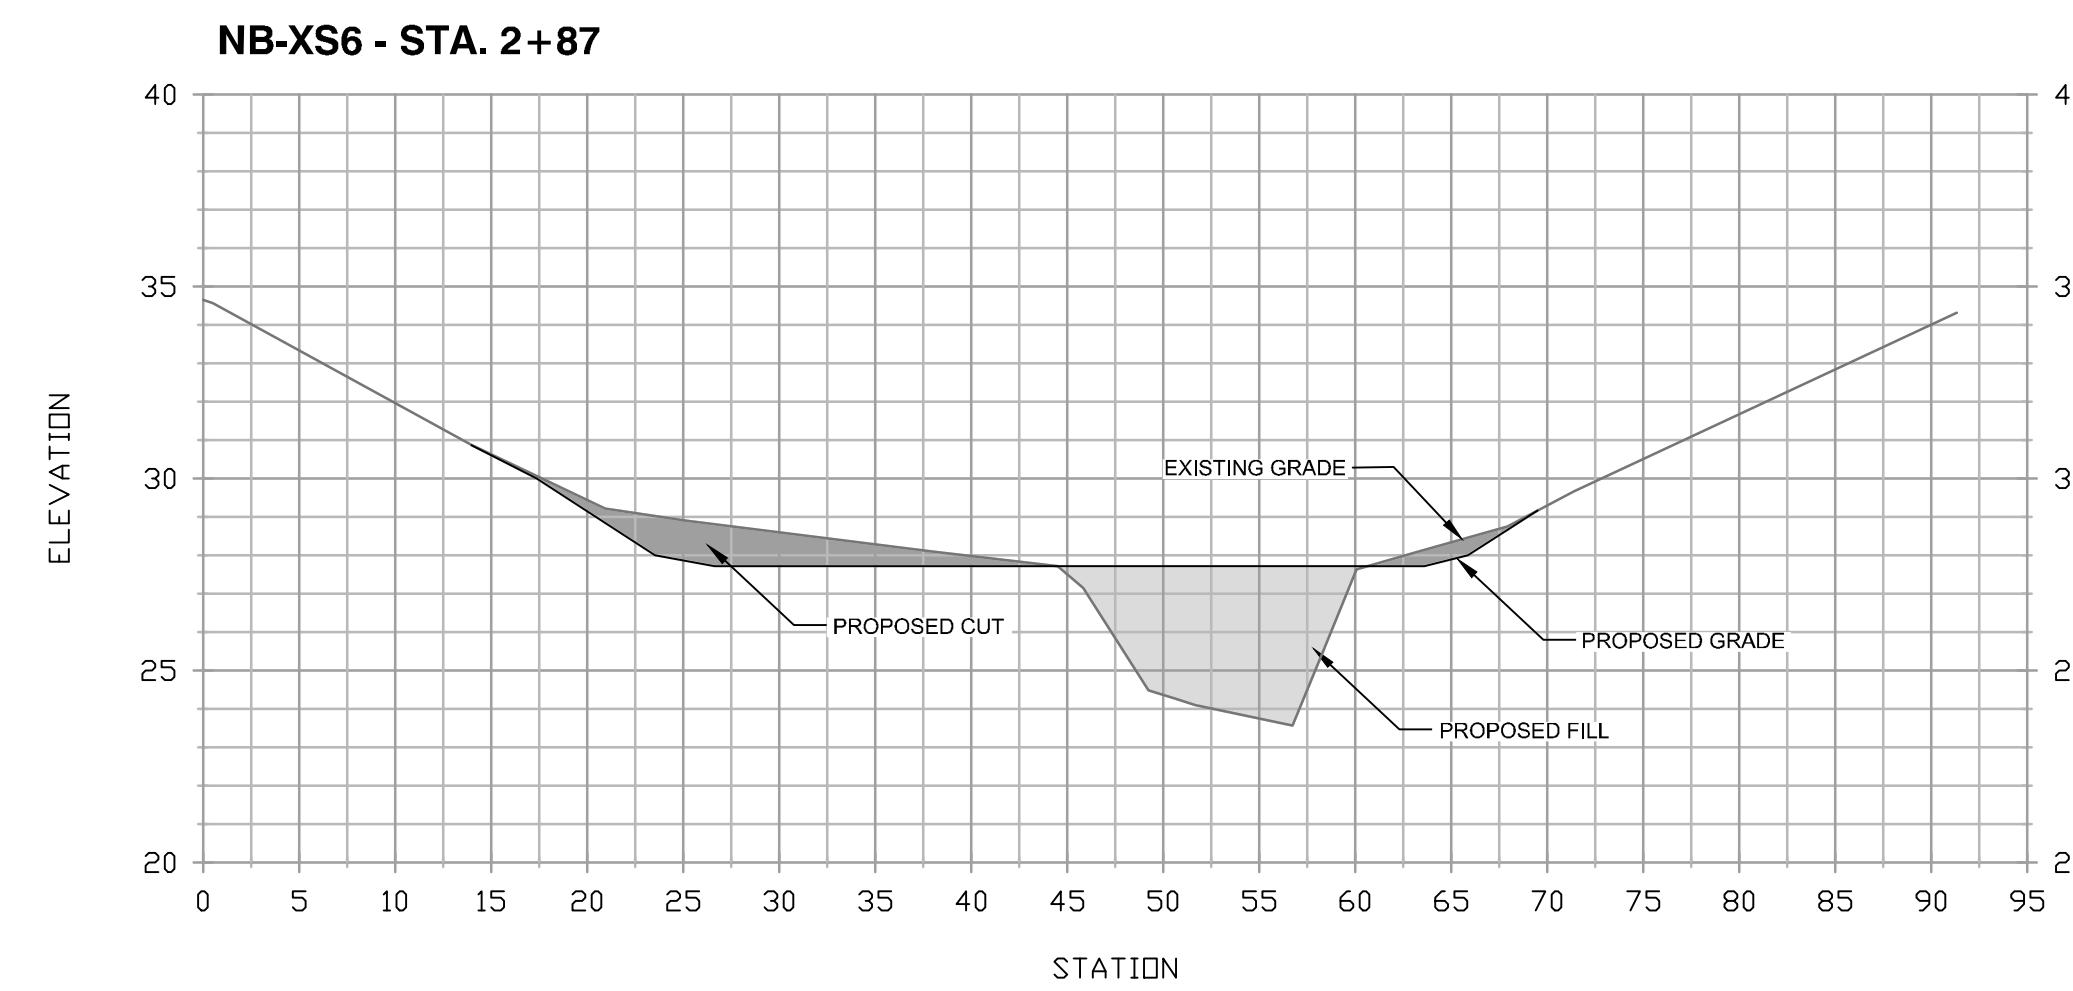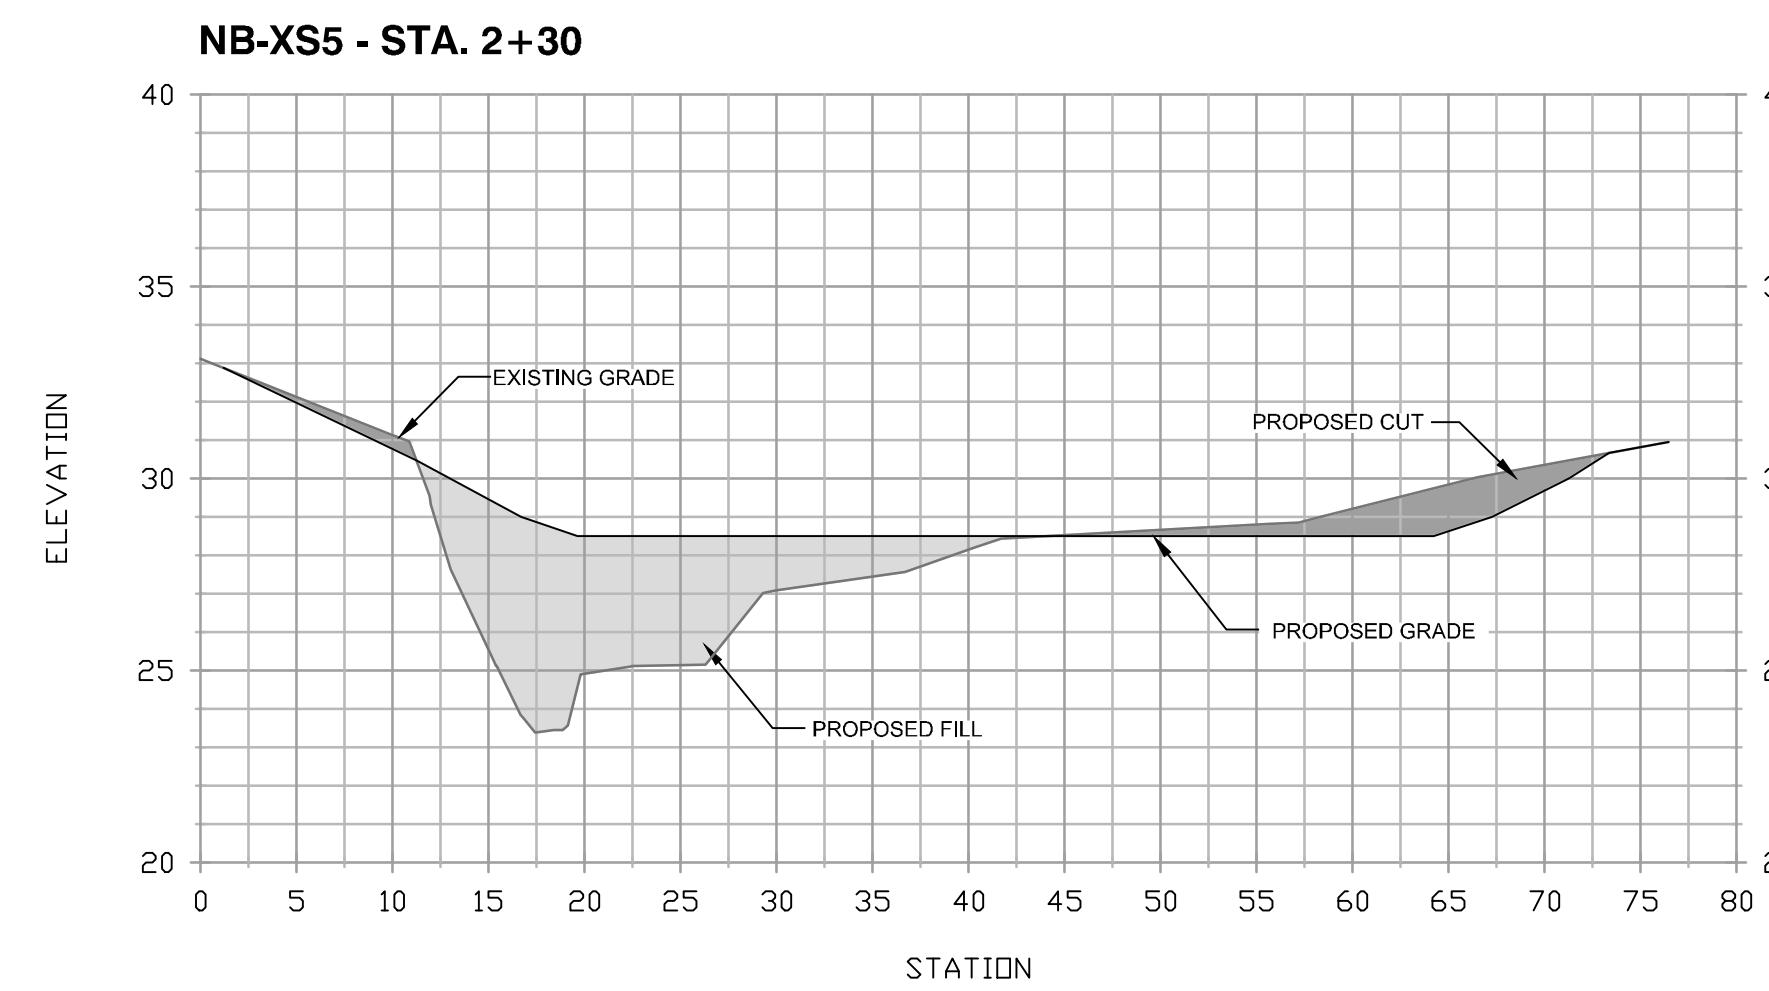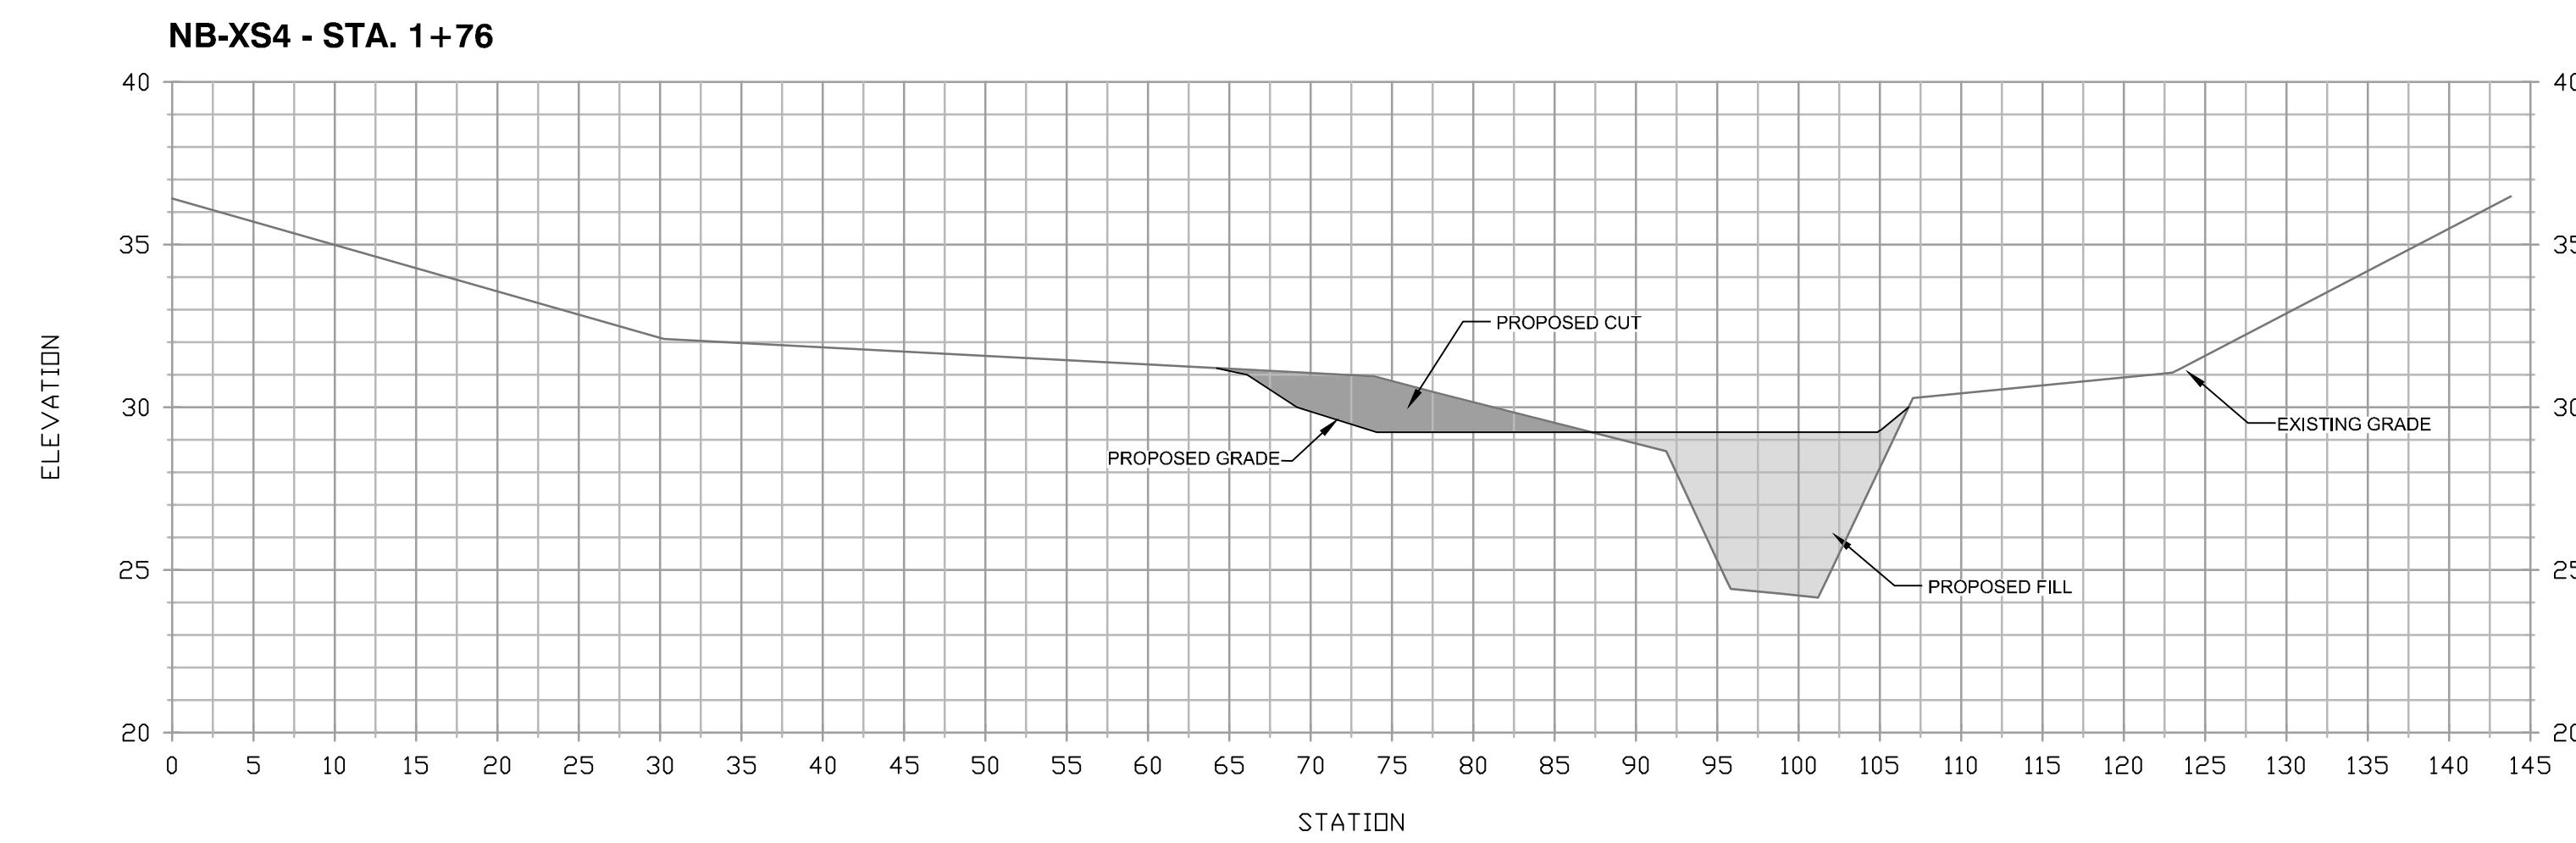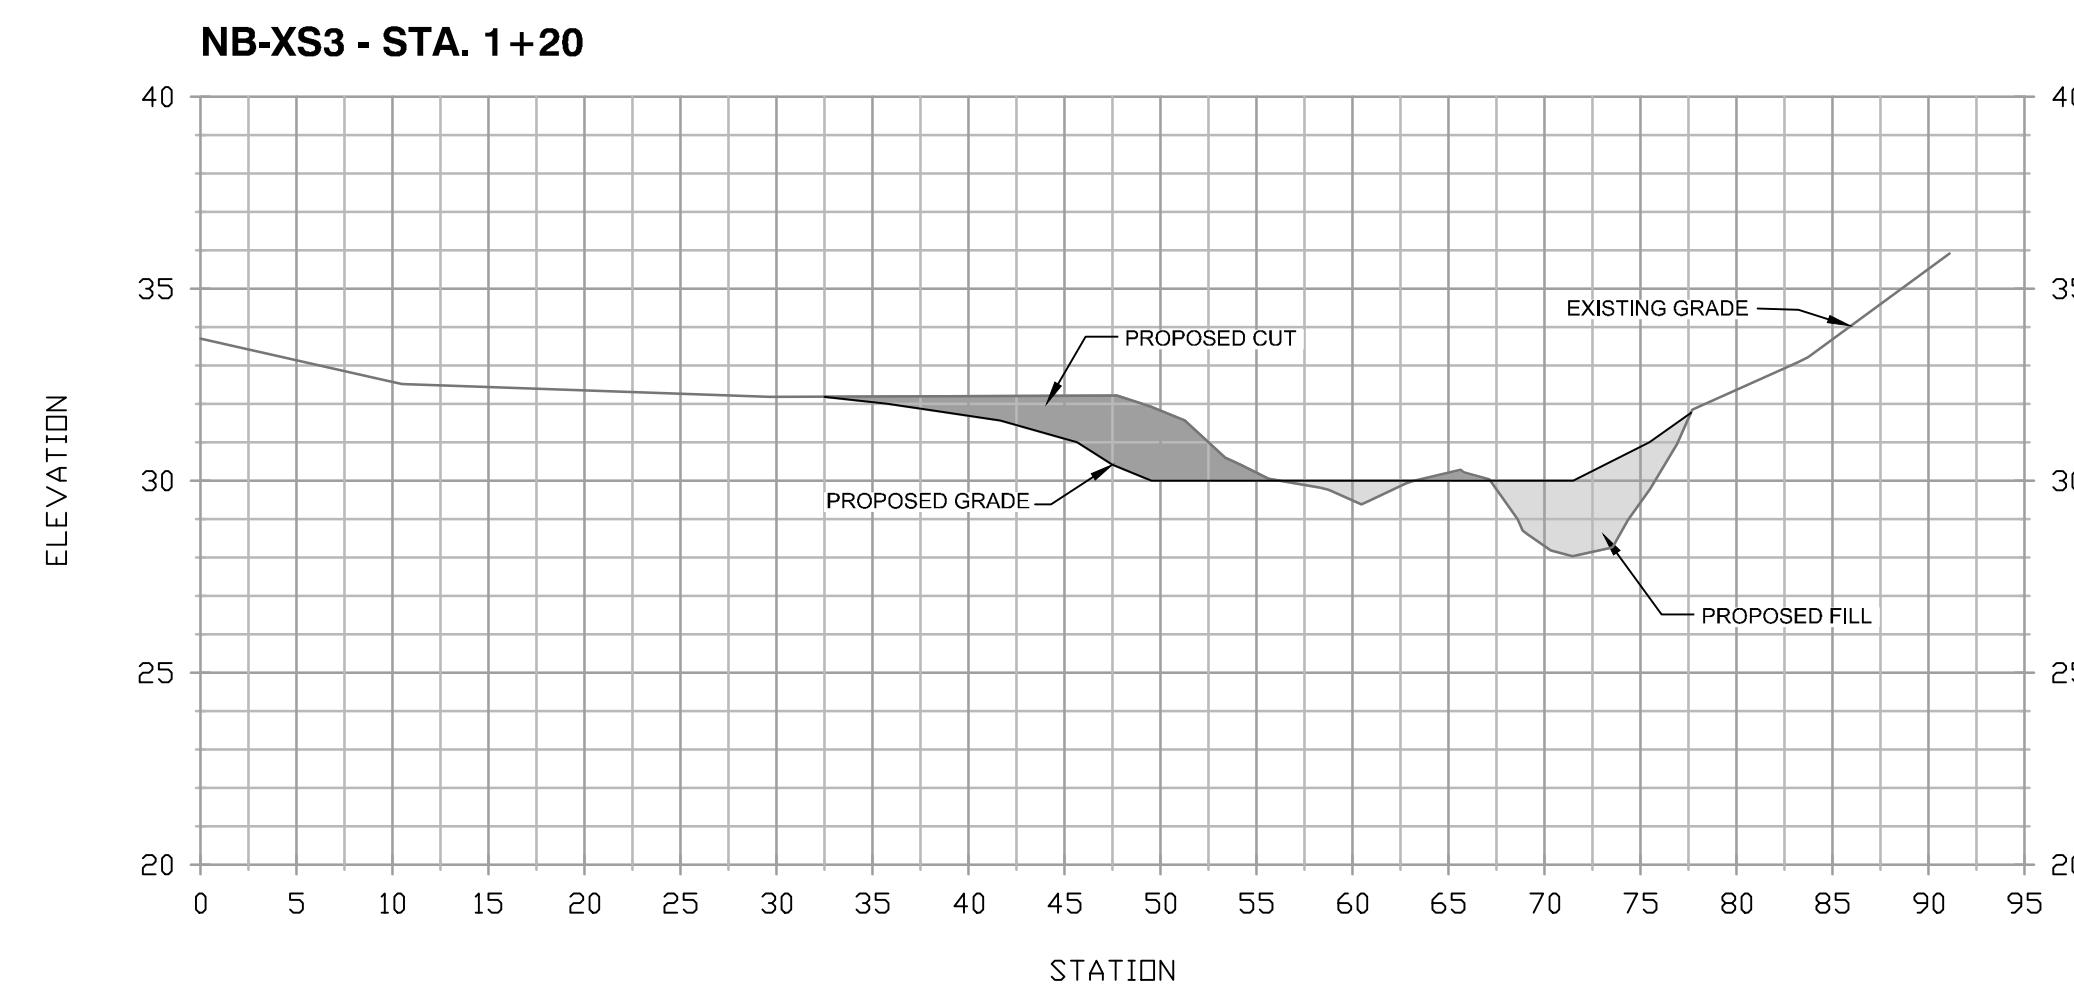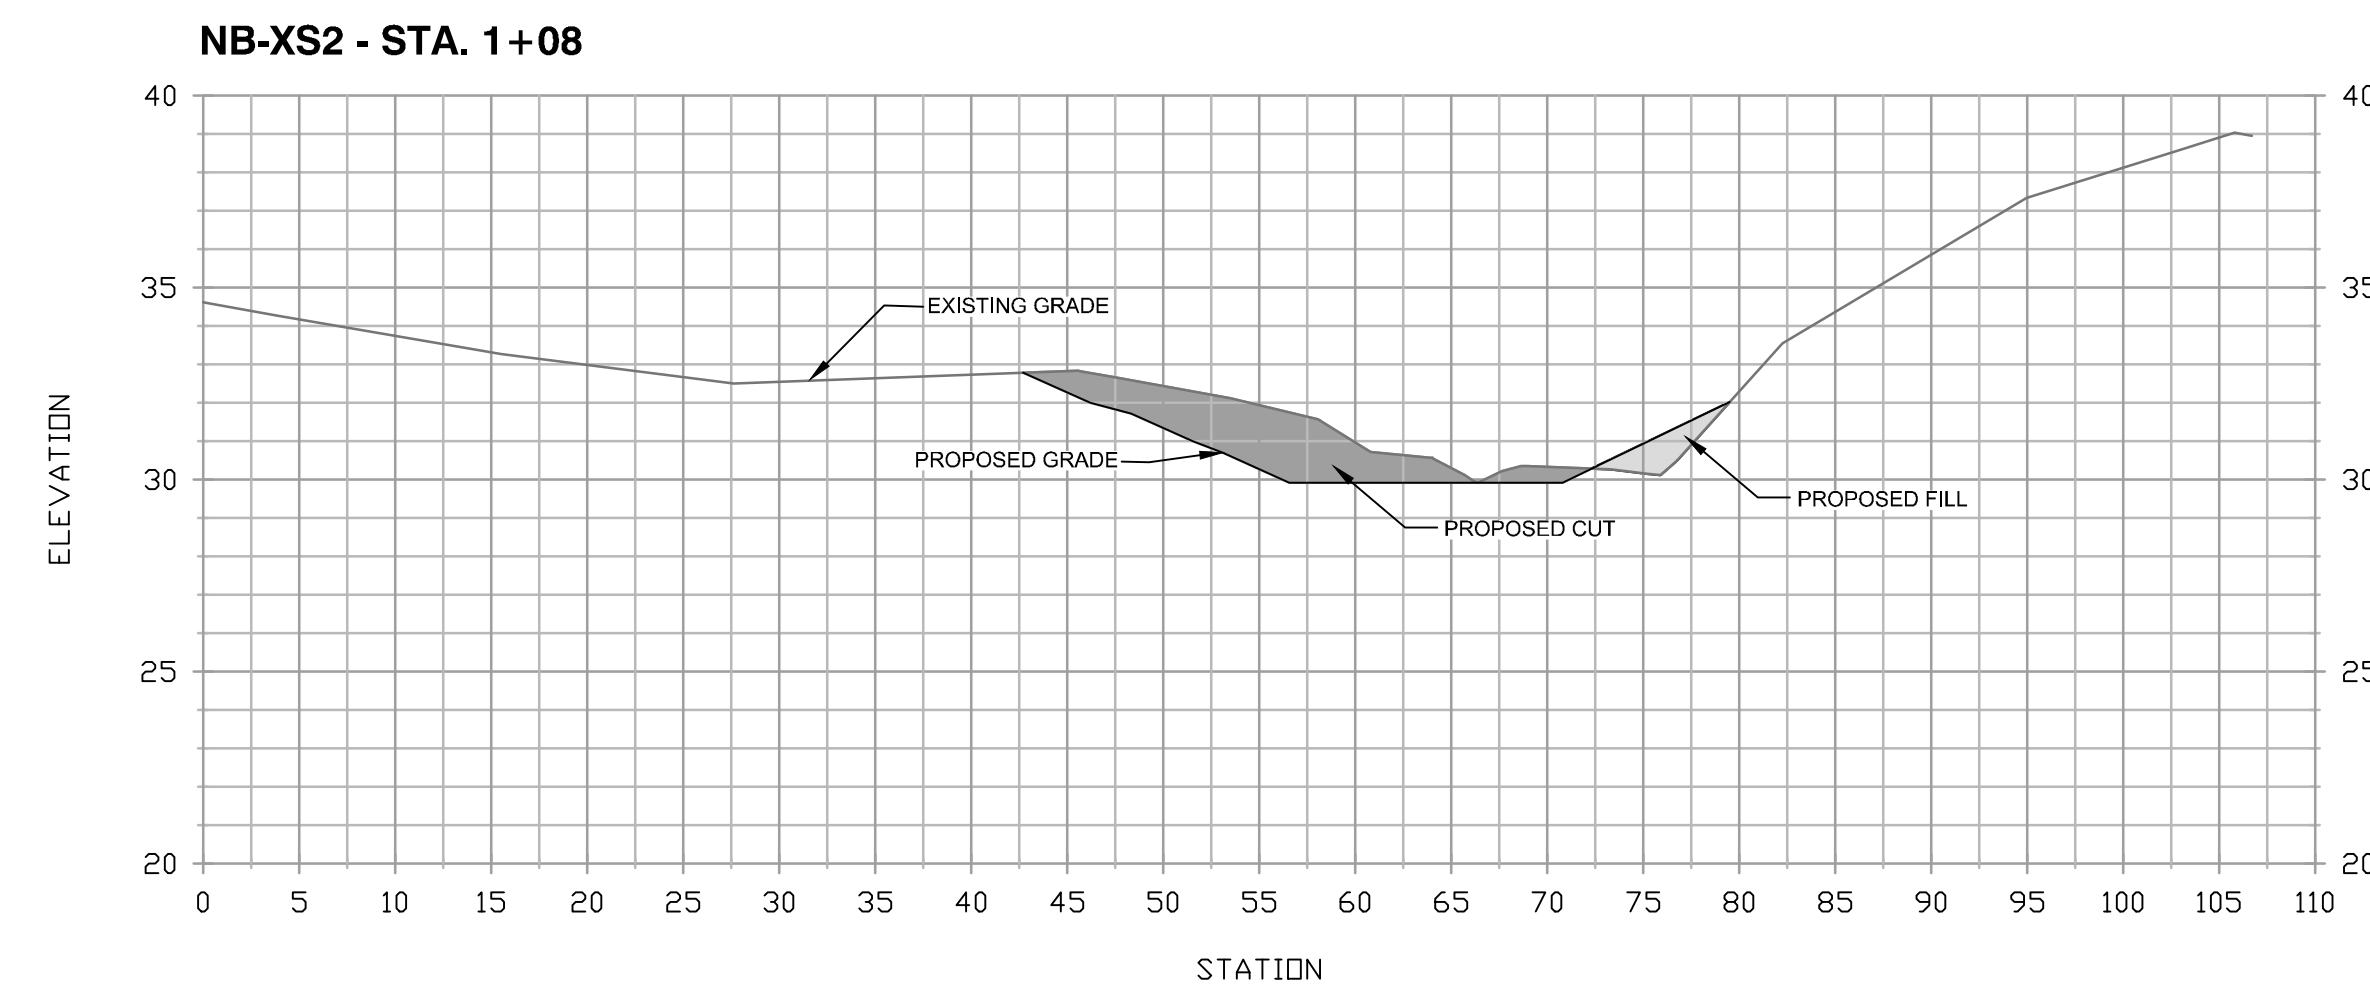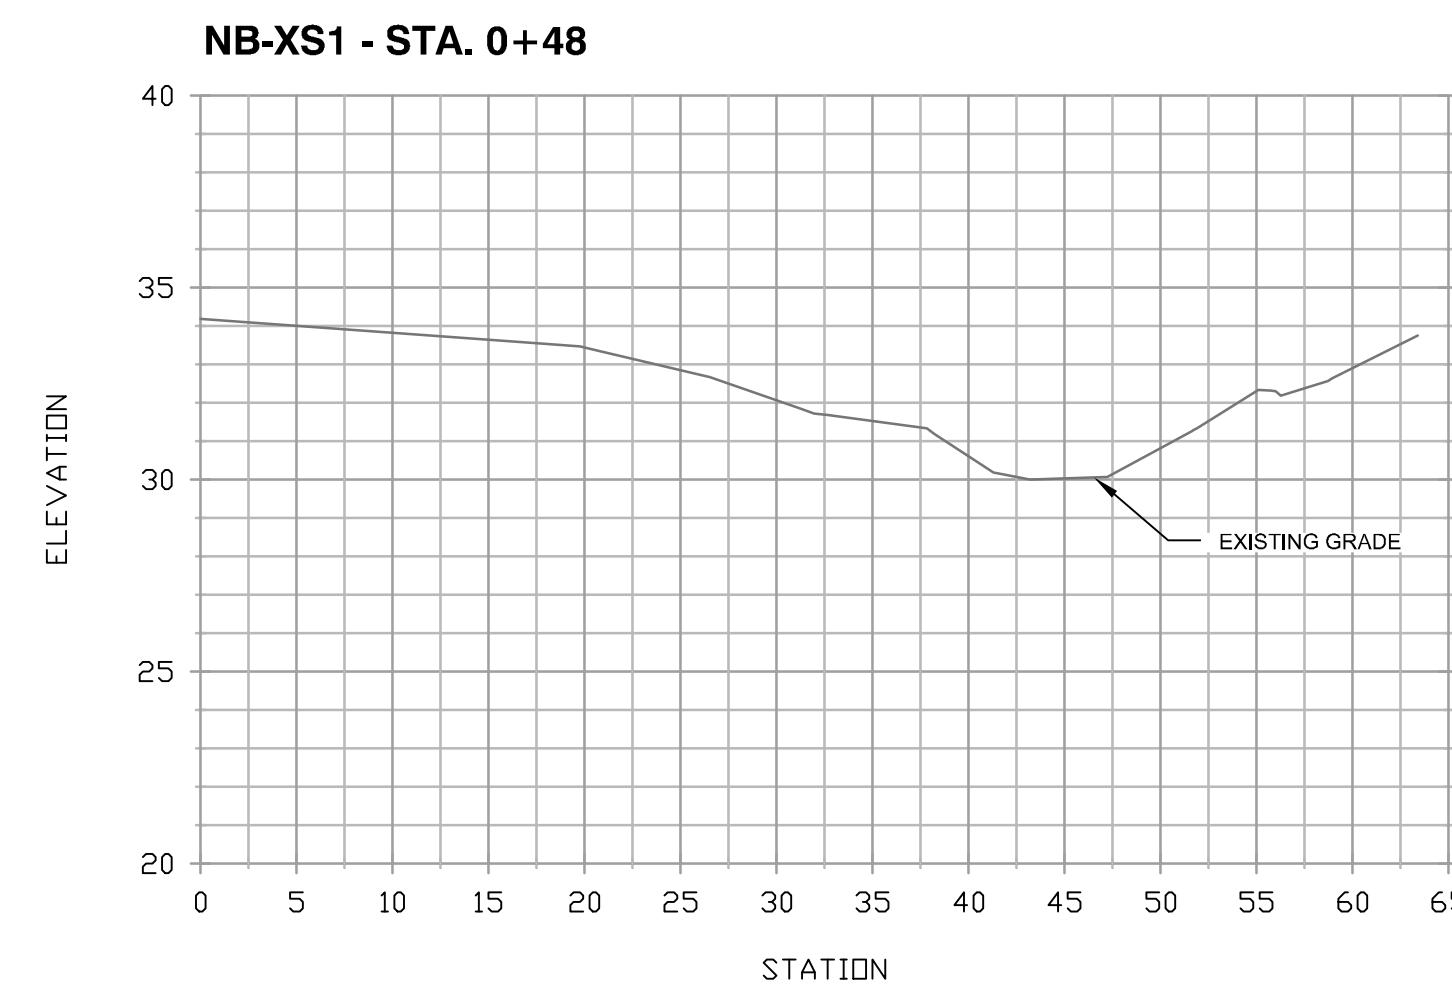







HORIZ: 1" = 10'
VERT: 1" = 5'
0' 10' 20'

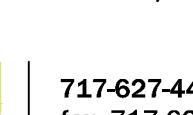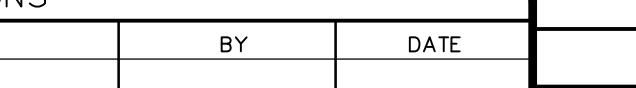
OWNER/DEVELOPER/APPLICANT		CIVIL ENGINEER A.A. County ID #721		REVISIONS	
 717-627-4440 fax: 717-627-4660 landstudies.com land@landstudies.com 315 North Street Lititz, PA 17543		 Dewberry 2101 Gaither Road Suite #340 Rockville, MD 20850 Contact: Joanne M. Cheok, Senior Associate Phone: (301) 337-2856 Fax: (301) 258-7607		ANNE ARUNDEL COUNTY DEPARTMENT OF PUBLIC WORKS STREAM RESTORATION PLAN NORTH BRANCH CROSS SECTION 1 SLOOP COVE RETROFIT SITE 1 3rd District Tax Map 16 Grid 05 Anne Arundel County	
PA 042324		 Joanne M. Cheok PROFESSIONAL ENGINEER No. 18095 2/10/2024		Professional Certification: I hereby certify that these documents were prepared or approved by me, and that I am a duly licensed professional engineer under the laws of the State of Maryland, License No. 18095, Expiration Date: 12/21/2022. APPROVED DATE APPROVED DATE SCALE: As Shown DRAWN BY: B.F.R. Anchors CHIEF ENGINEER PROJECT MANAGER CHECKED BY: J. Cheok APPROVED DATE APPROVED DATE SHEET NO. 15 OF 39 PROJECT NO. 5017963 ASSISTANT CHIEF ENGINEER PROPOSAL NO: CHEF. RIGHT OF WAY	

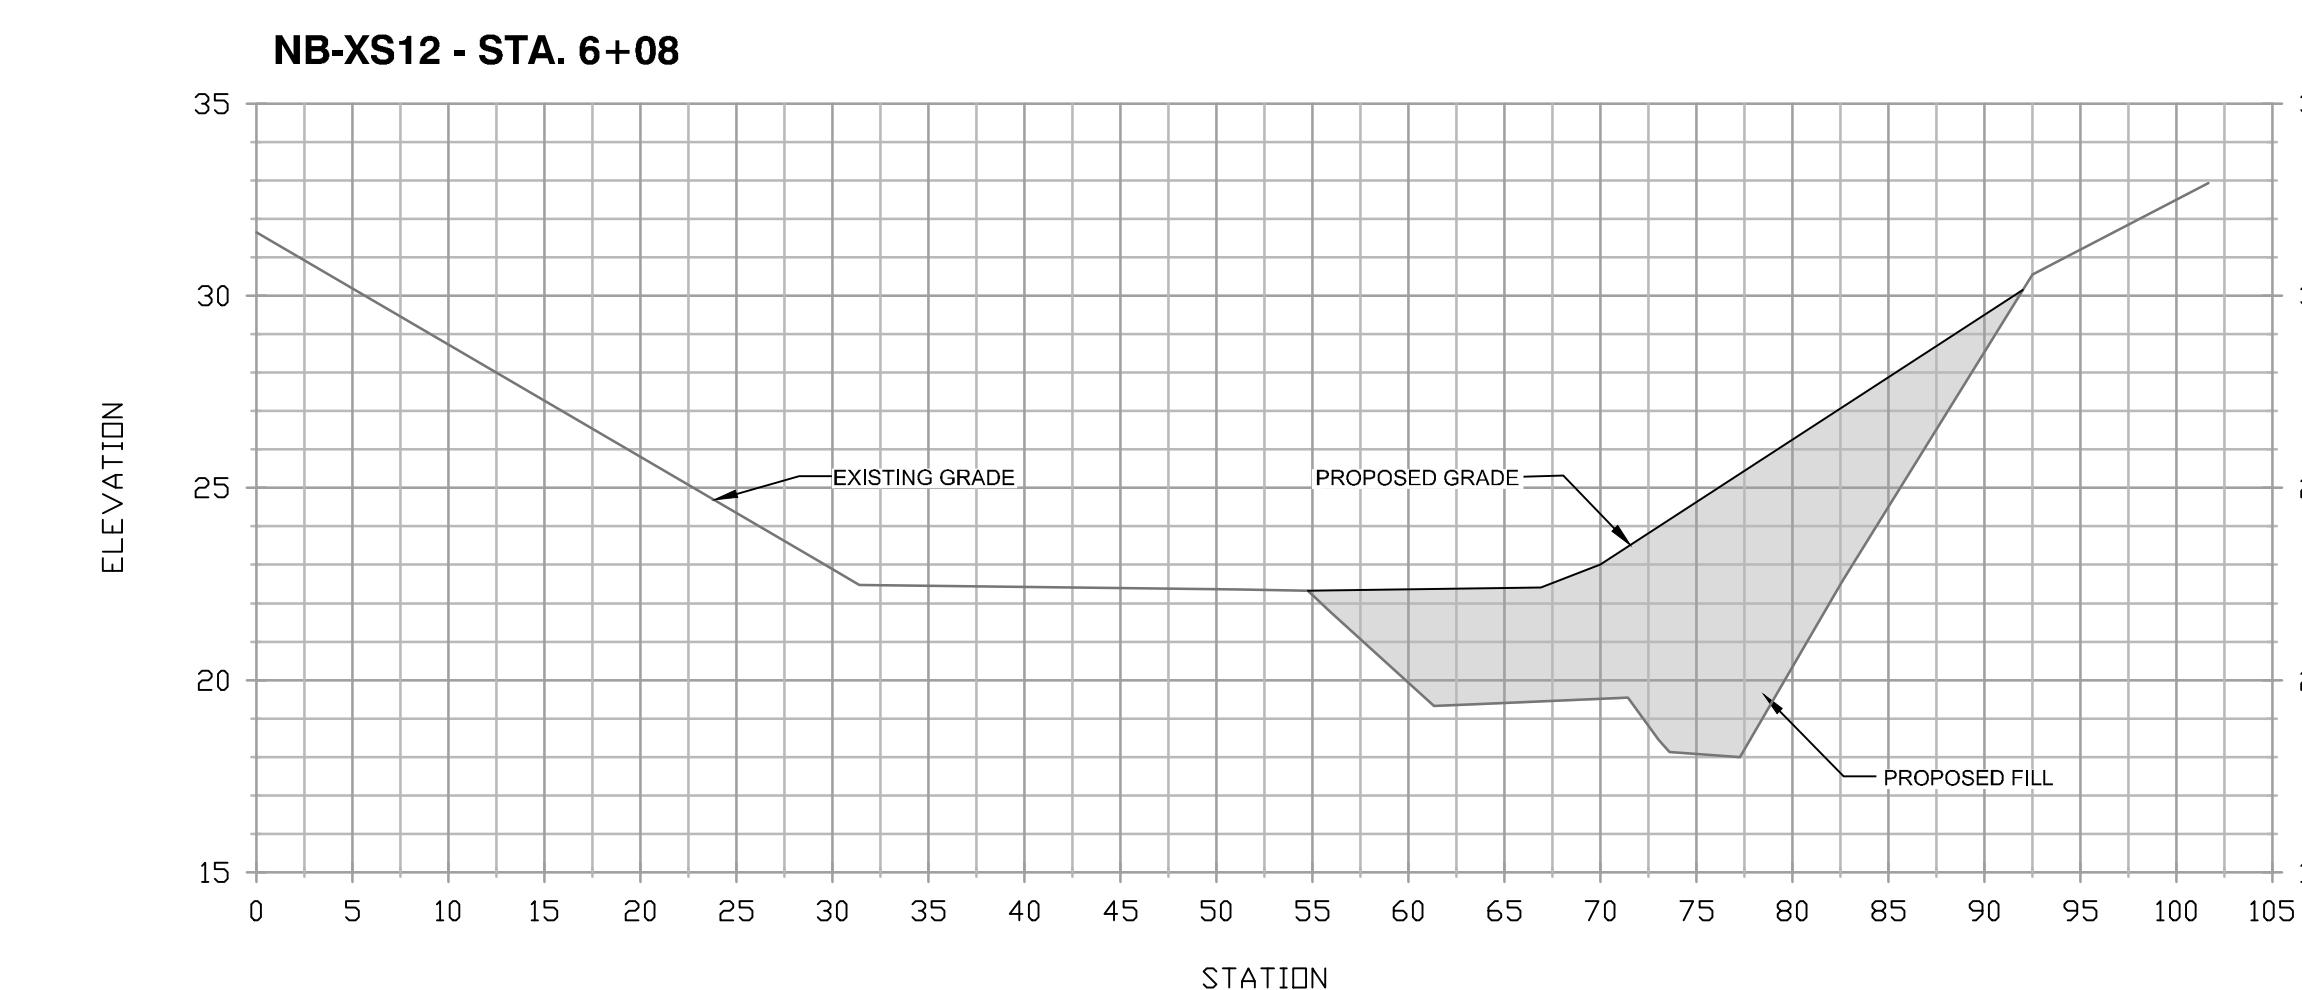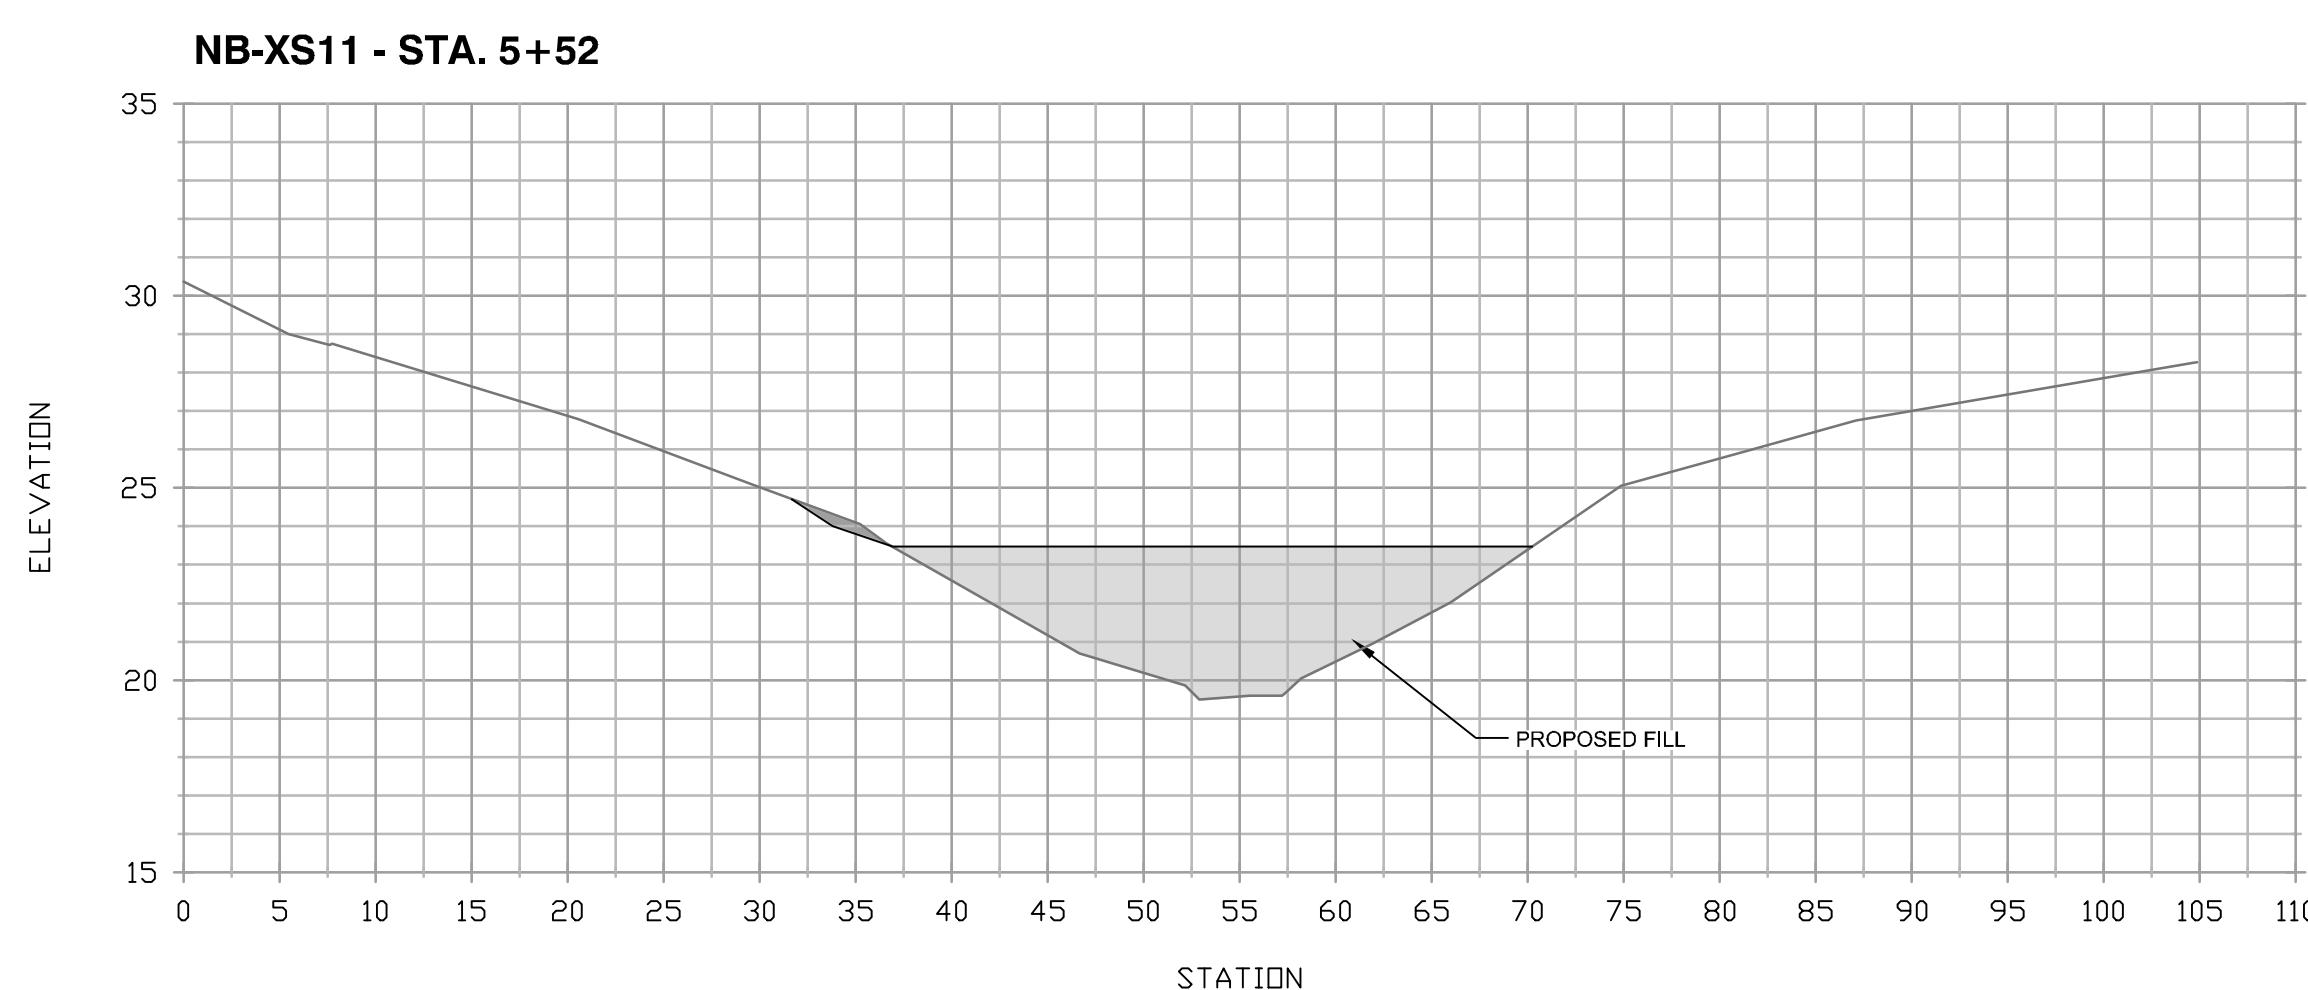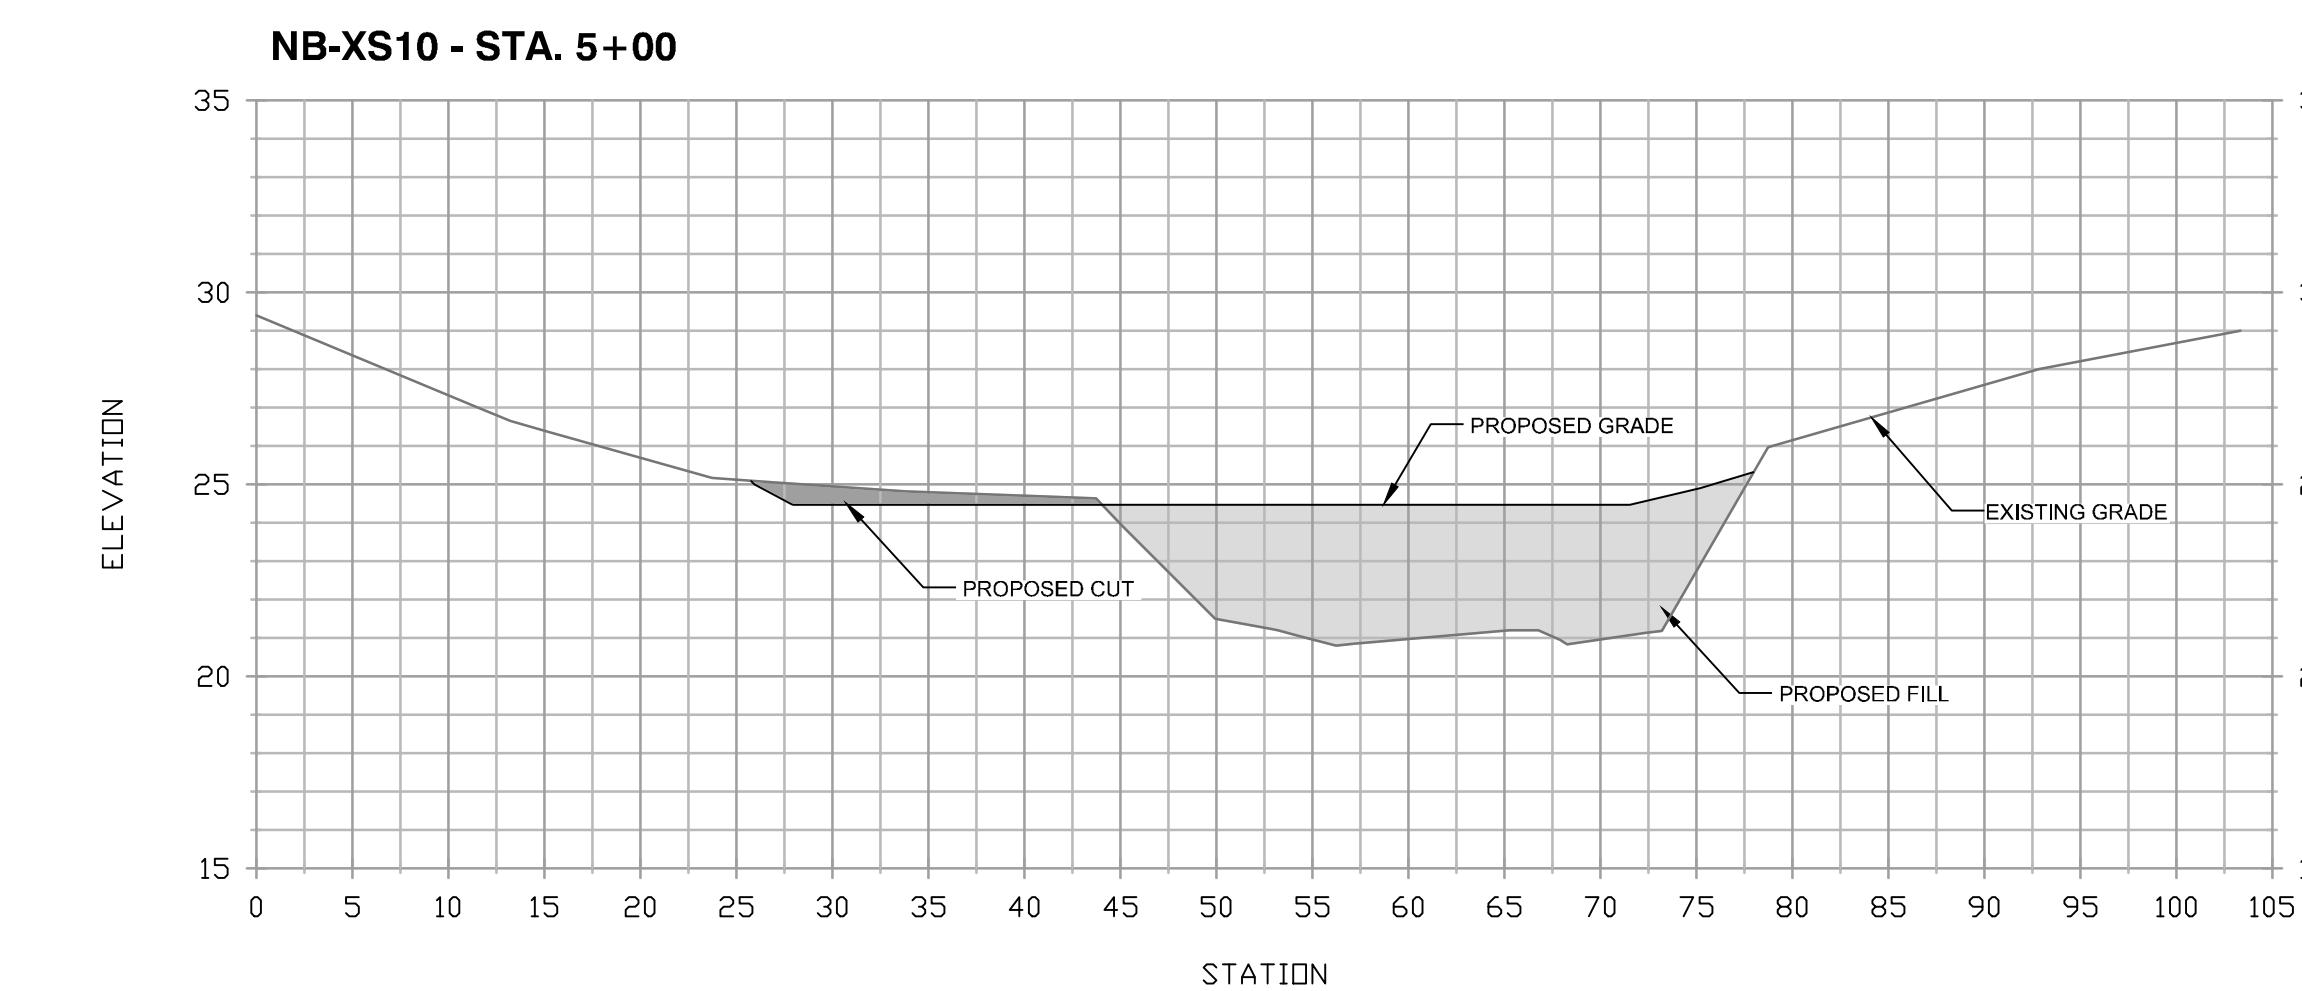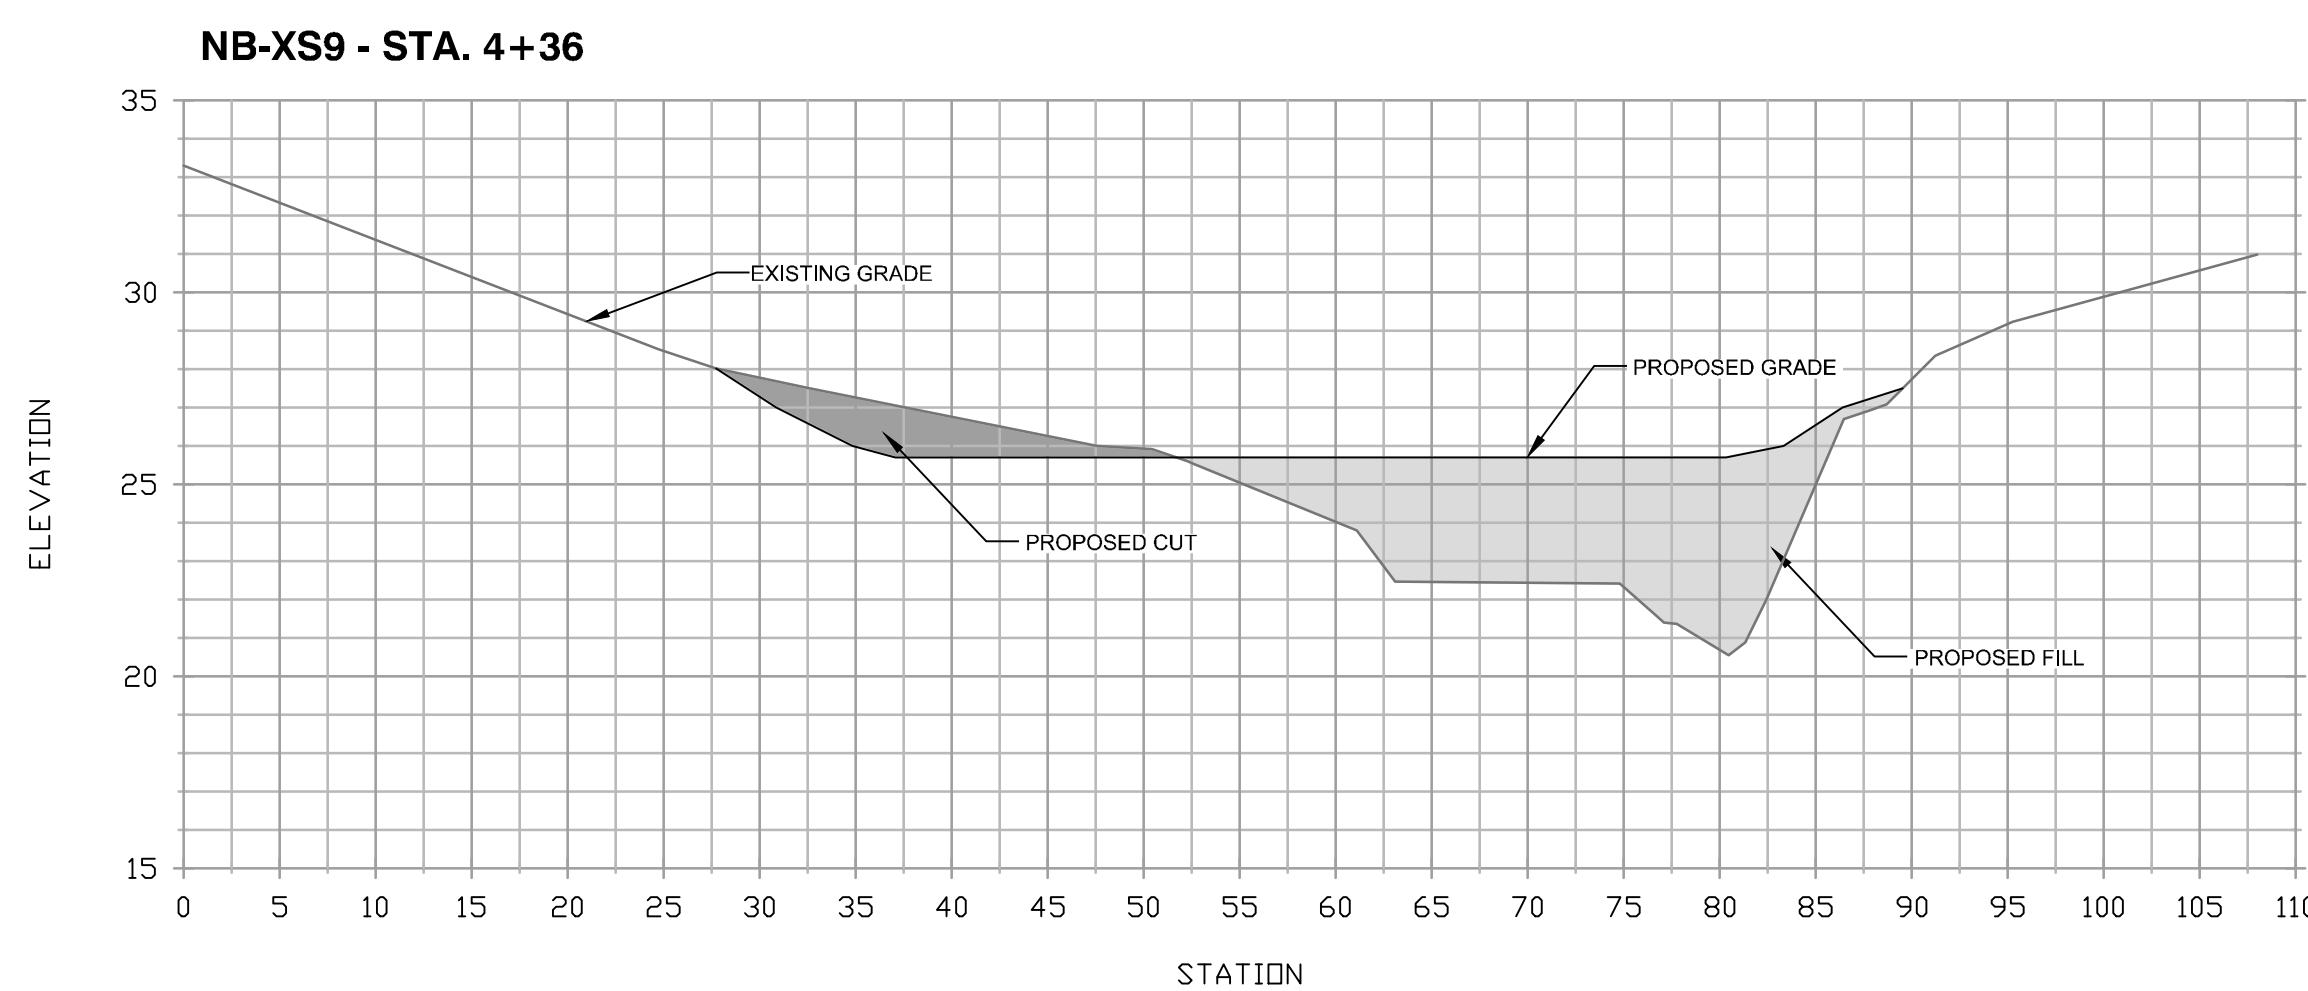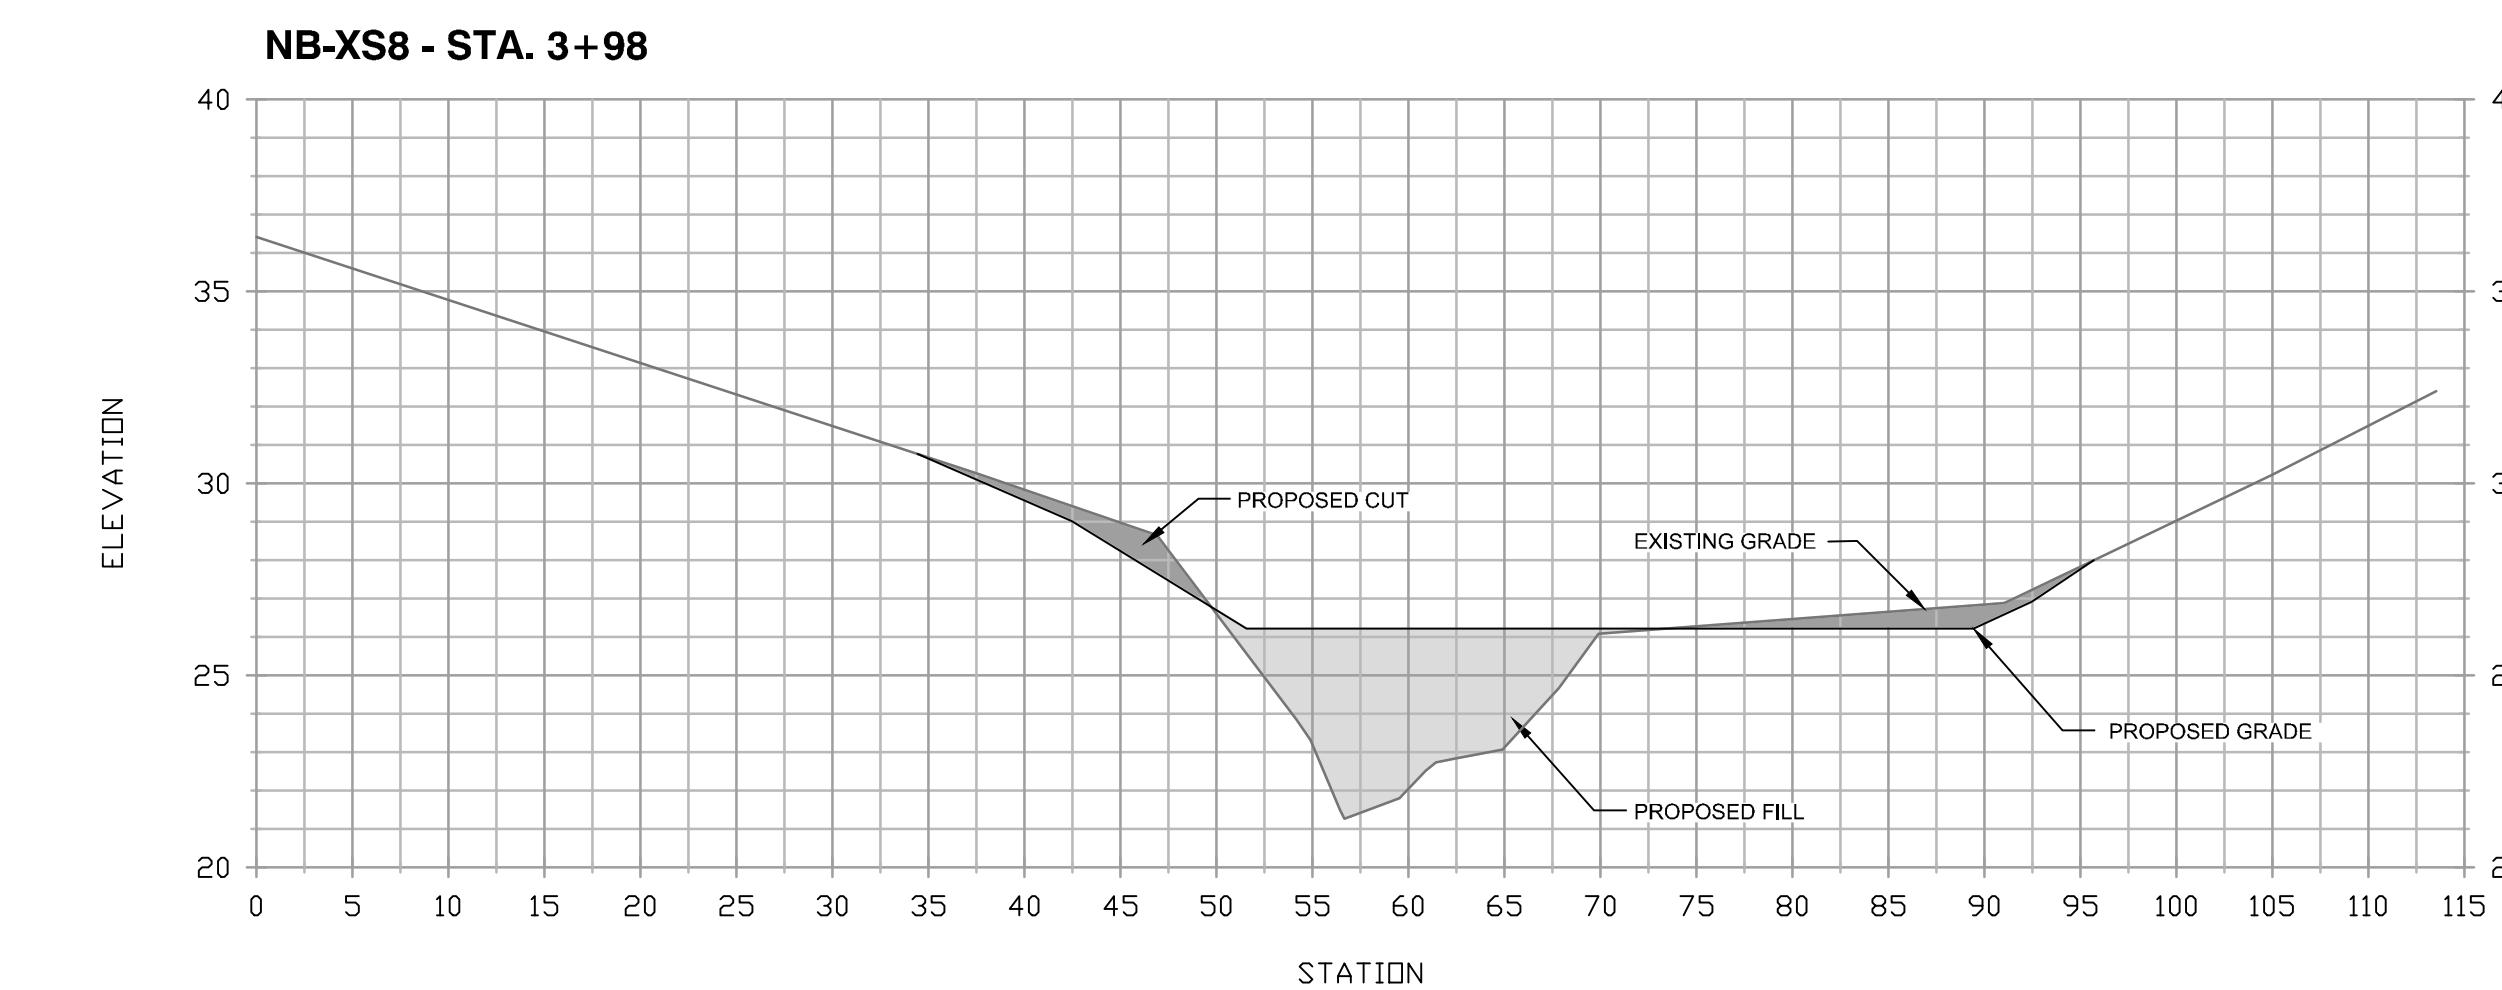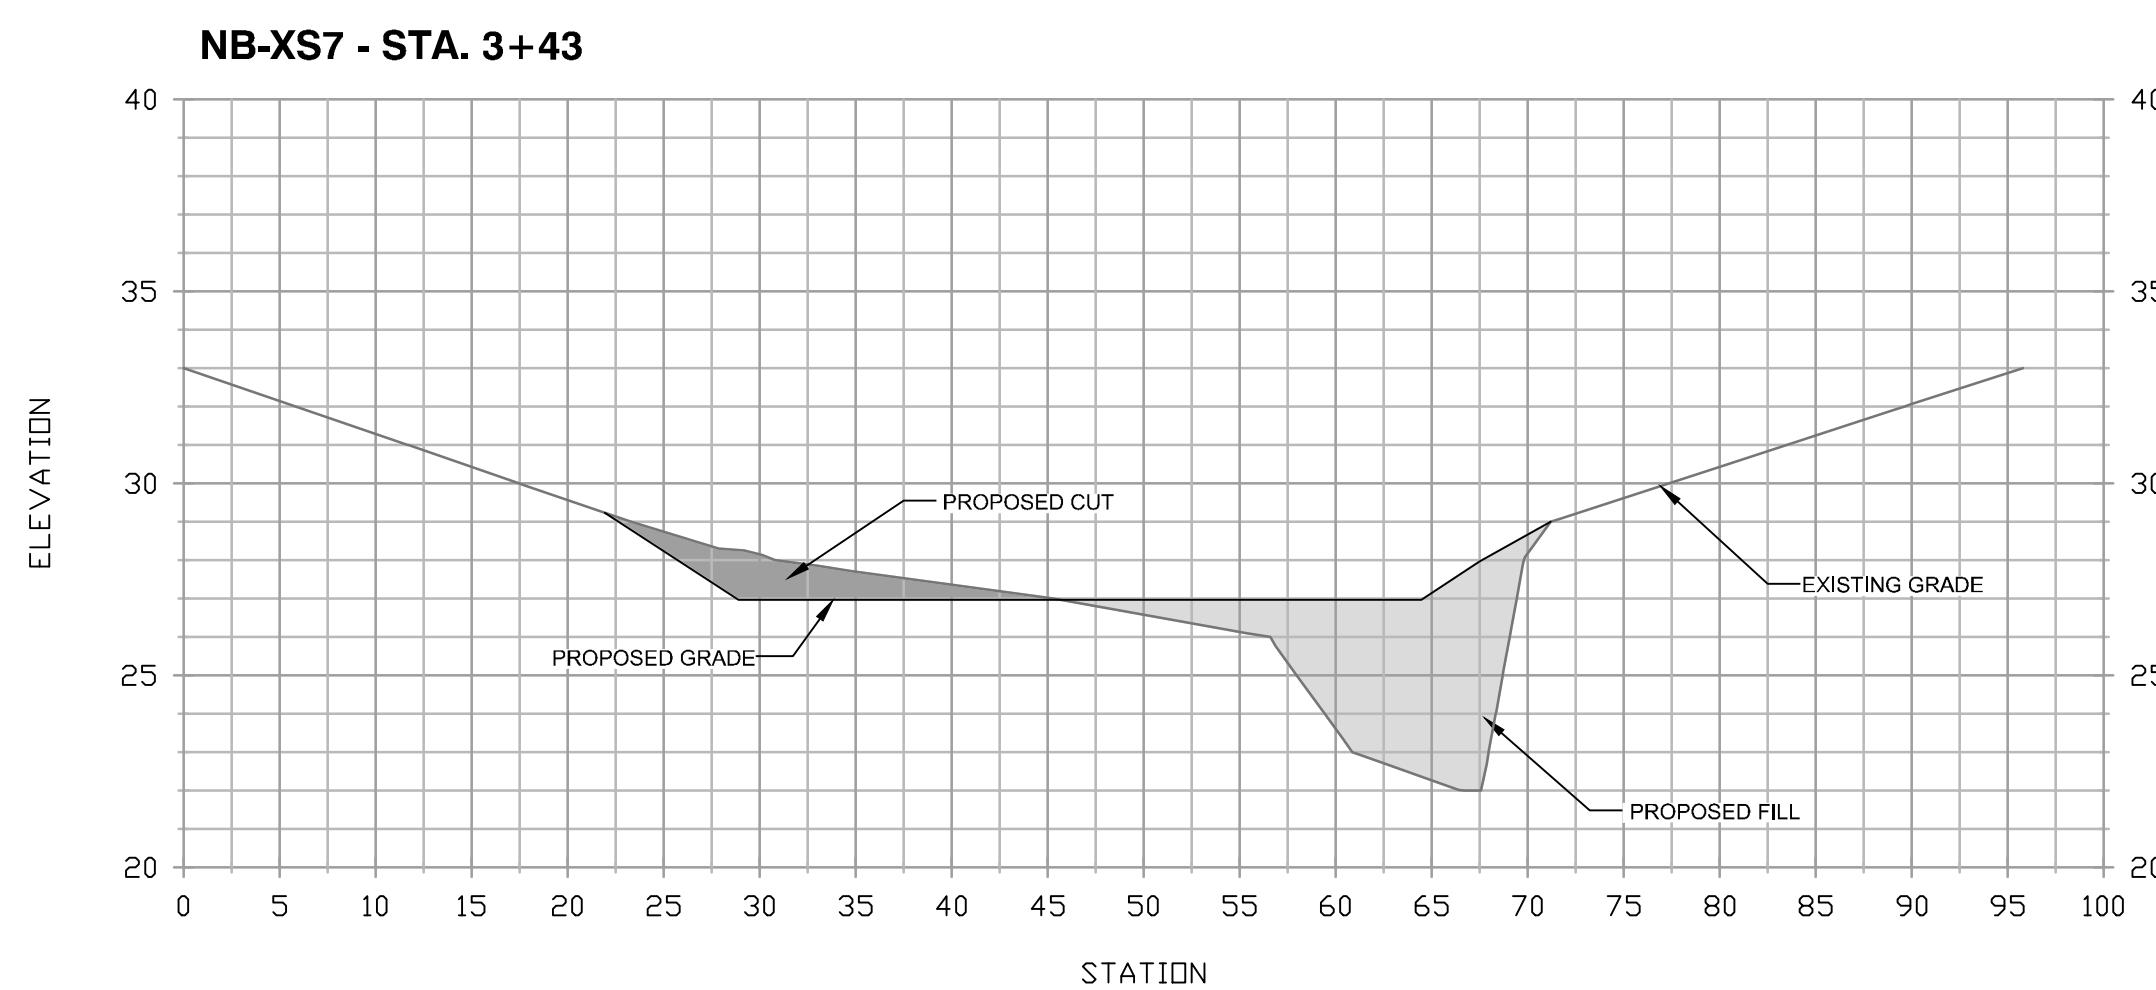

HORZ: 1" = 10'
VERT: 1" = 5'
0' 10' 20'

OWNER/DEVELOPER/APPLICANT		CIVIL ENGINEER A.A. County ID #721		REVISIONS				ANNE ARUNDEL COUNTY DEPARTMENT OF PUBLIC WORKS STREAM RESTORATION PLAN					
	717-627-4440 fax: 717-627-4660 landstudies.com tandl@landstudies.com 315 North Street Lititz, PA 17543			Professional Certification: I hereby certify that these documents were prepared or approved by me, and that I am a duly licensed professional engineer under the laws of the State of Maryland, License No. 18095, Expiration Date: 12/21/2022.	NO	Description	BY	DATE	APPROVED	DATE	APPROVED	DATE	
									CHIEF ENGINEER	PROJECT MANAGER			
									APPROVED	DATE	APPROVED	DATE	
									ASSISTANT CHIEF ENGINEER	CHIEF, RIGHT OF WAY			
NORTH BRANCH CROSS SECTION 2 SLOOP COVE RETROFIT SITE 1													
3rd District													
Tax Map 16 Grid 05													
Anne Arundel County													

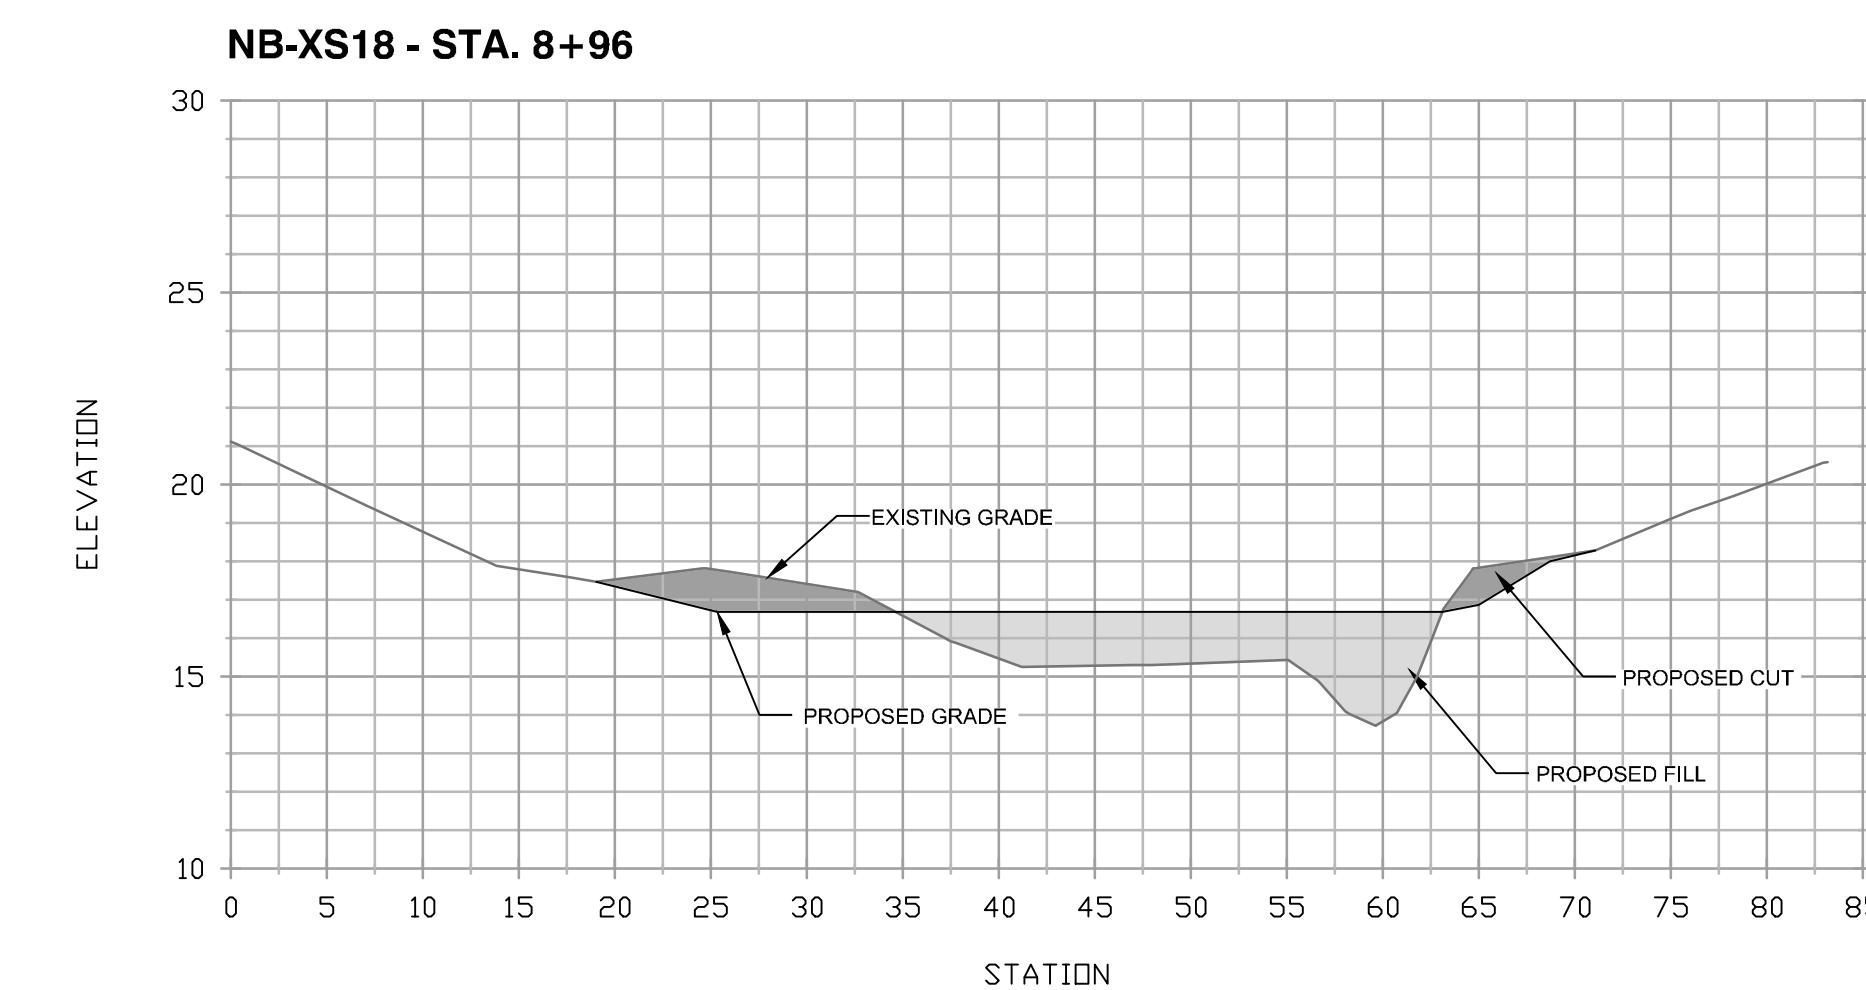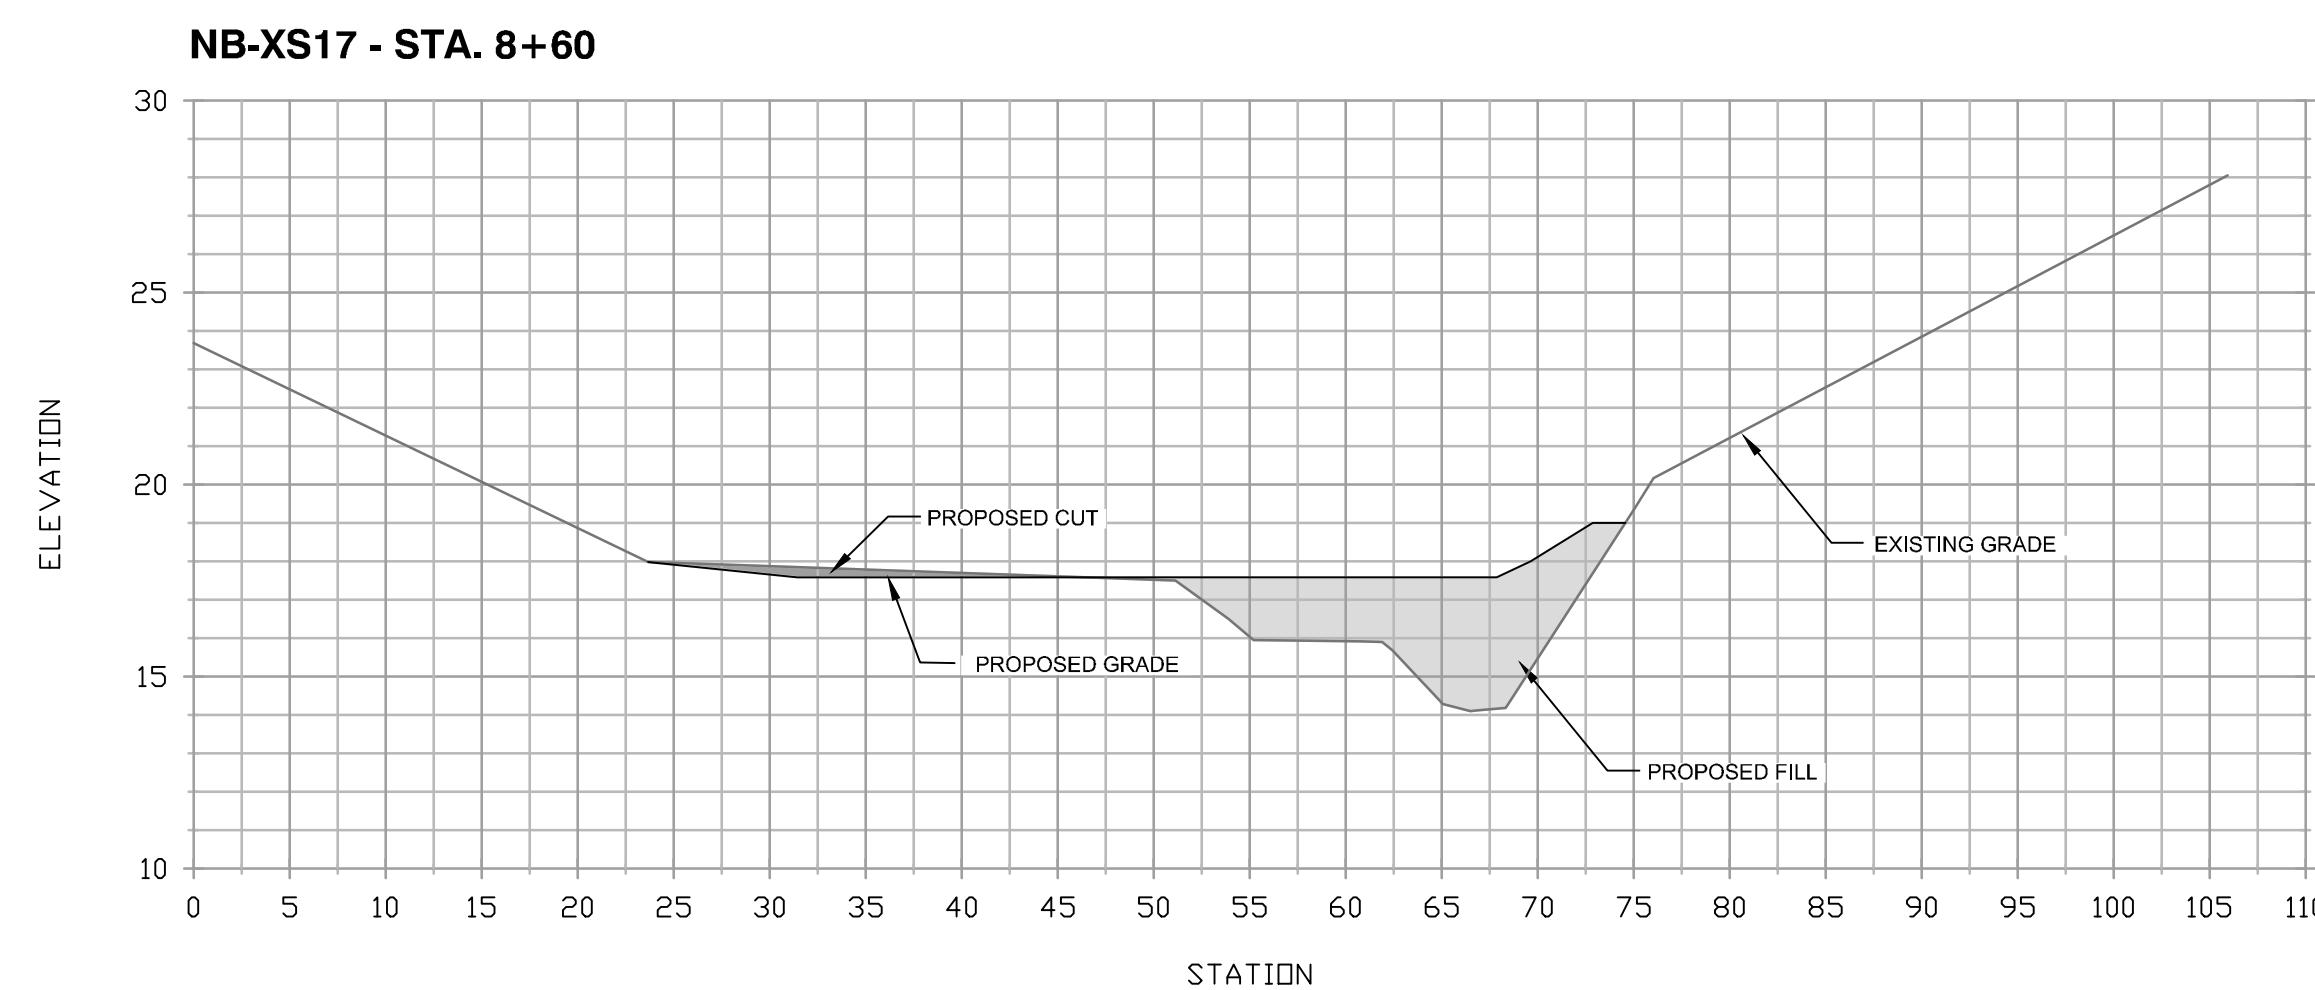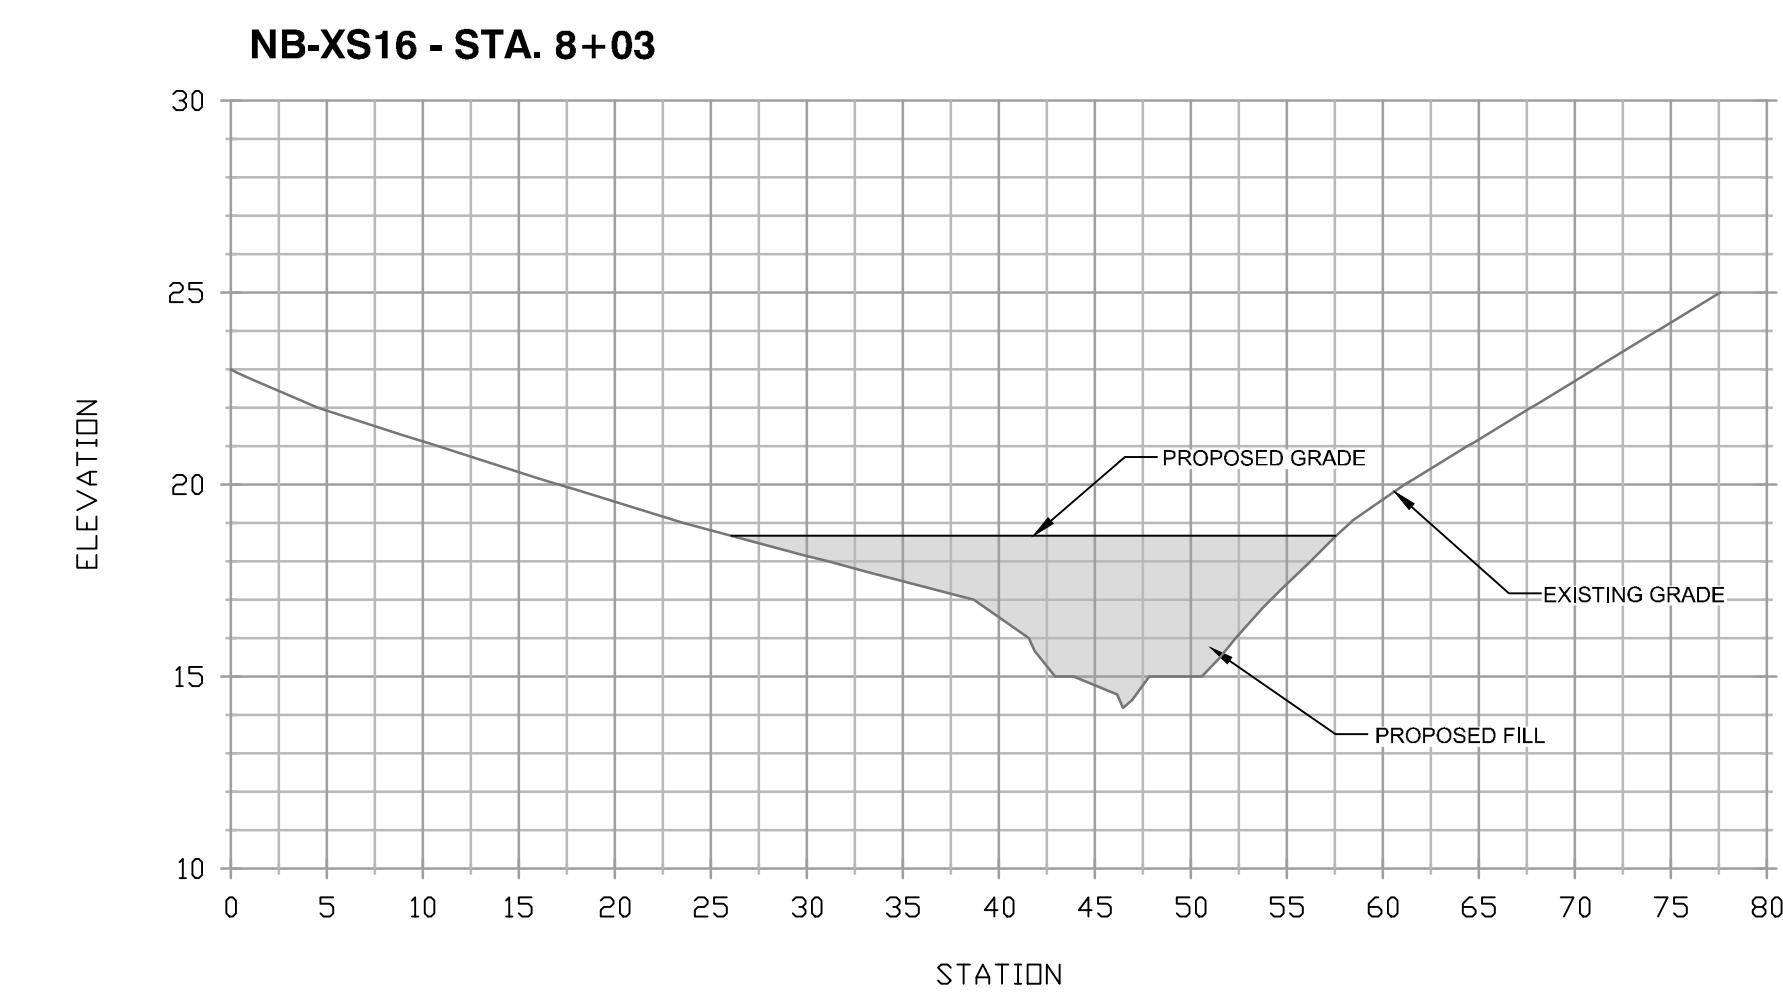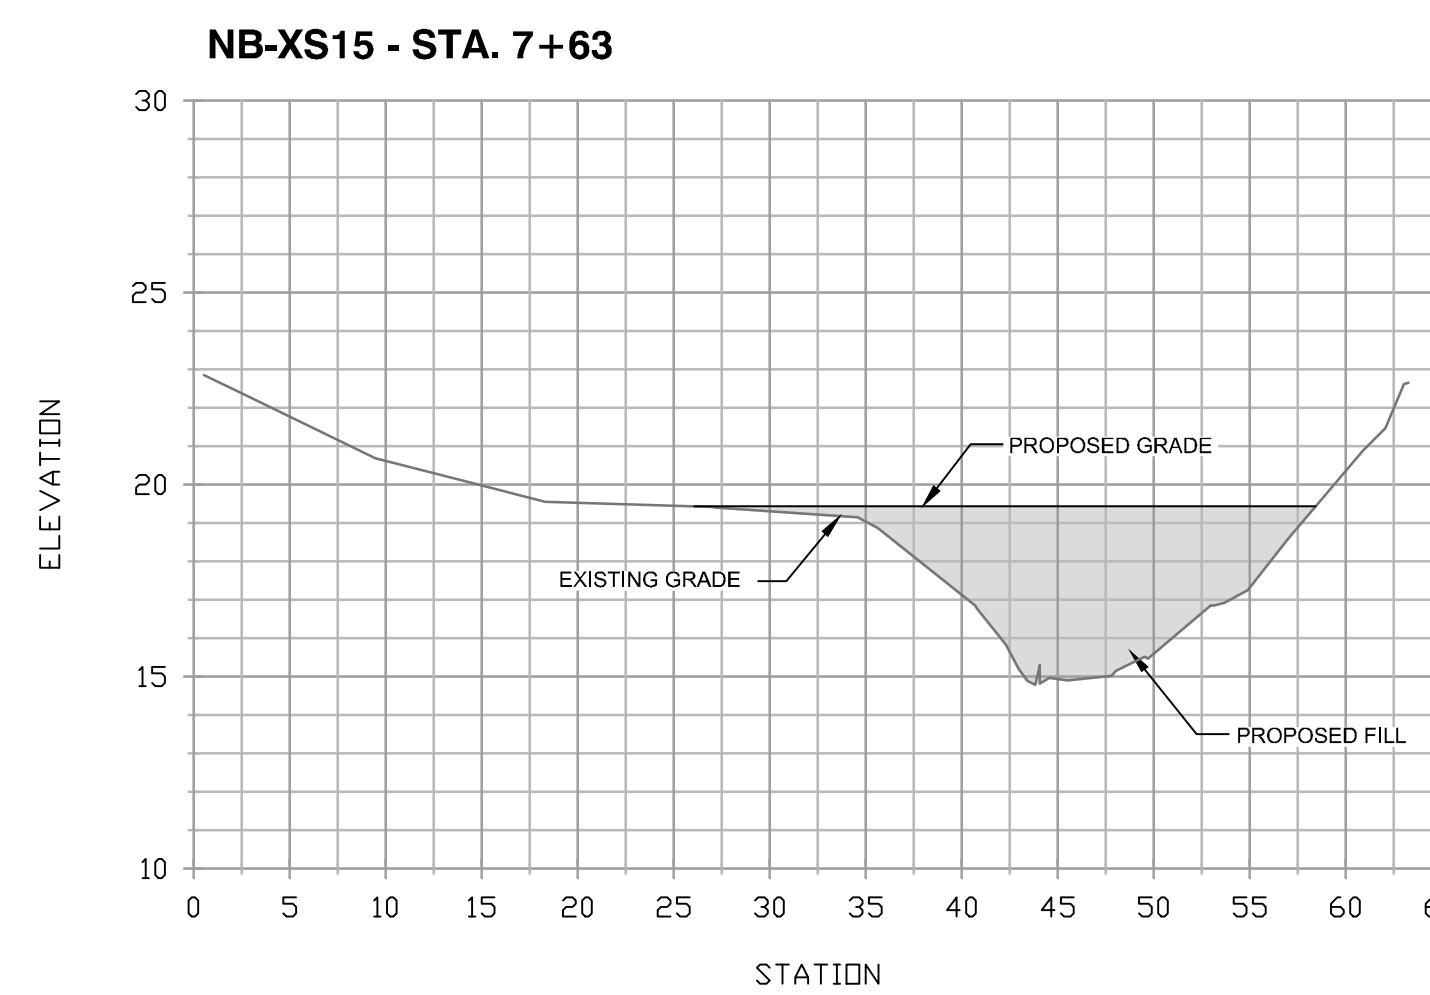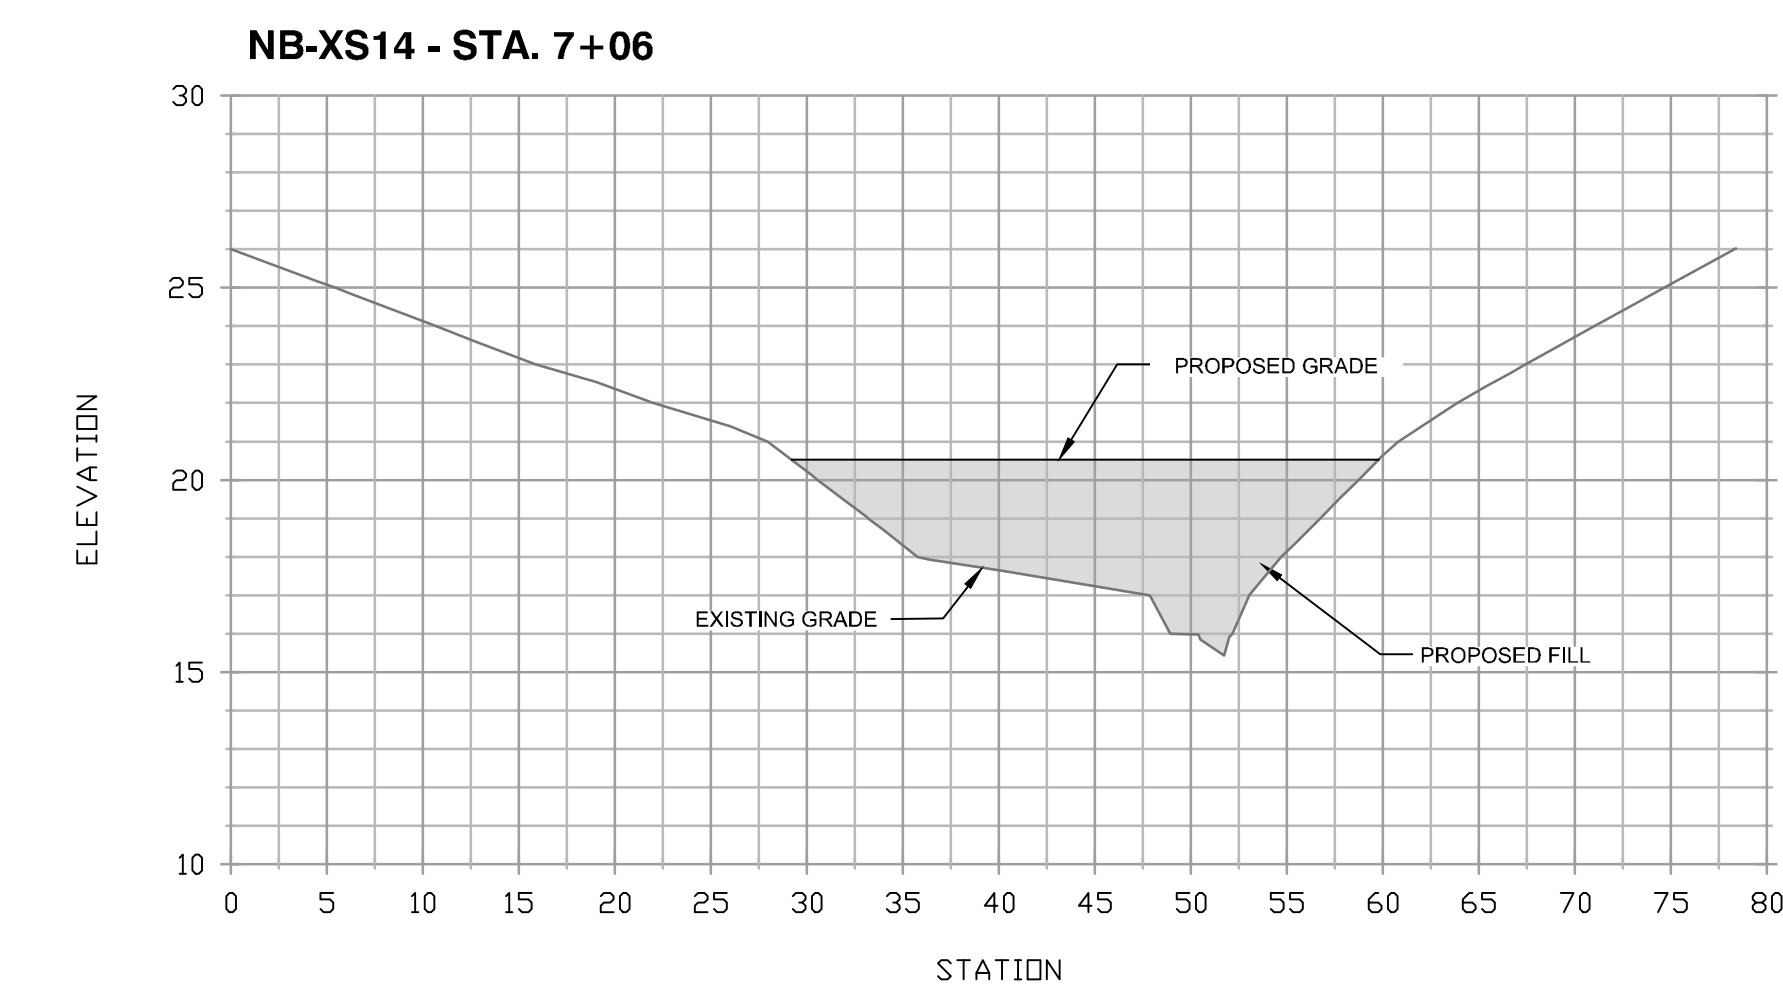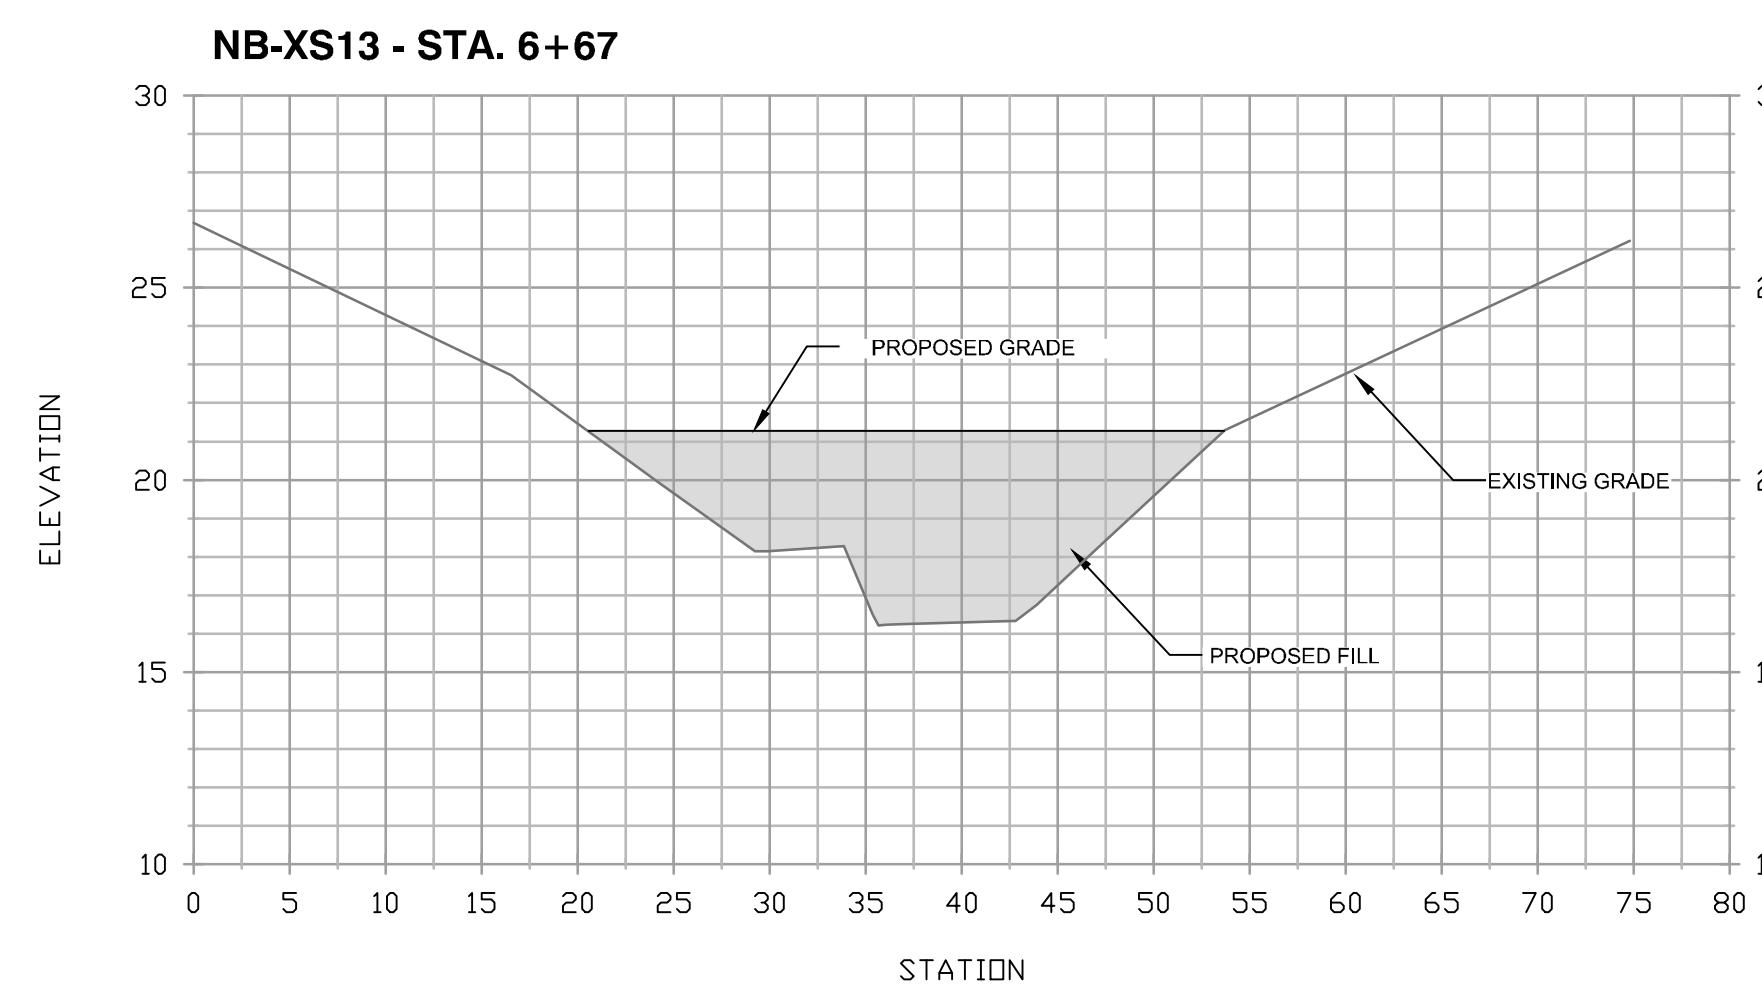







HORIZ: 1" = 10'
VERT: 1" = 5'
0' 10' 20'

OWNER/DEVELOPER/APPLICANT		CIVIL ENGINEER A.A. County ID #721		REVISIONS				ANNE ARUNDEL COUNTY DEPARTMENT OF PUBLIC WORKS STREAM RESTORATION PLAN					
	717-627-4440 fax: 717-627-4660 landstudies.com land@landstudies.com 315 North Street Lititz, PA 17543			Professional Certification: I hereby certify that these documents were prepared or approved by me, and that I am a duly licensed professional engineer under the laws of the State of Maryland, License No. 18095, Expiration Date: 12/21/2022.	NO	Description	BY	DATE	APPROVED	DATE	APPROVED	DATE	SCALE: As Shown DRAWN BY: Bill /R. Anchors CHIEF ENGINEER PROJECT MANAGER CHECKED BY: J. Cheek APPROVED
													SHEET NO: 17 OF 39 PROJECT NO: 50017963 ASSISTANT CHIEF ENGINEER CHIEF, RIGHT OF WAY PROPOSAL NO: 3rd District

NORTH BRANCH CROSS SECTION 3
SLOOP COVE RETROFIT SITE 1

Tax Map 16 Grid 05

Anne Arundel County

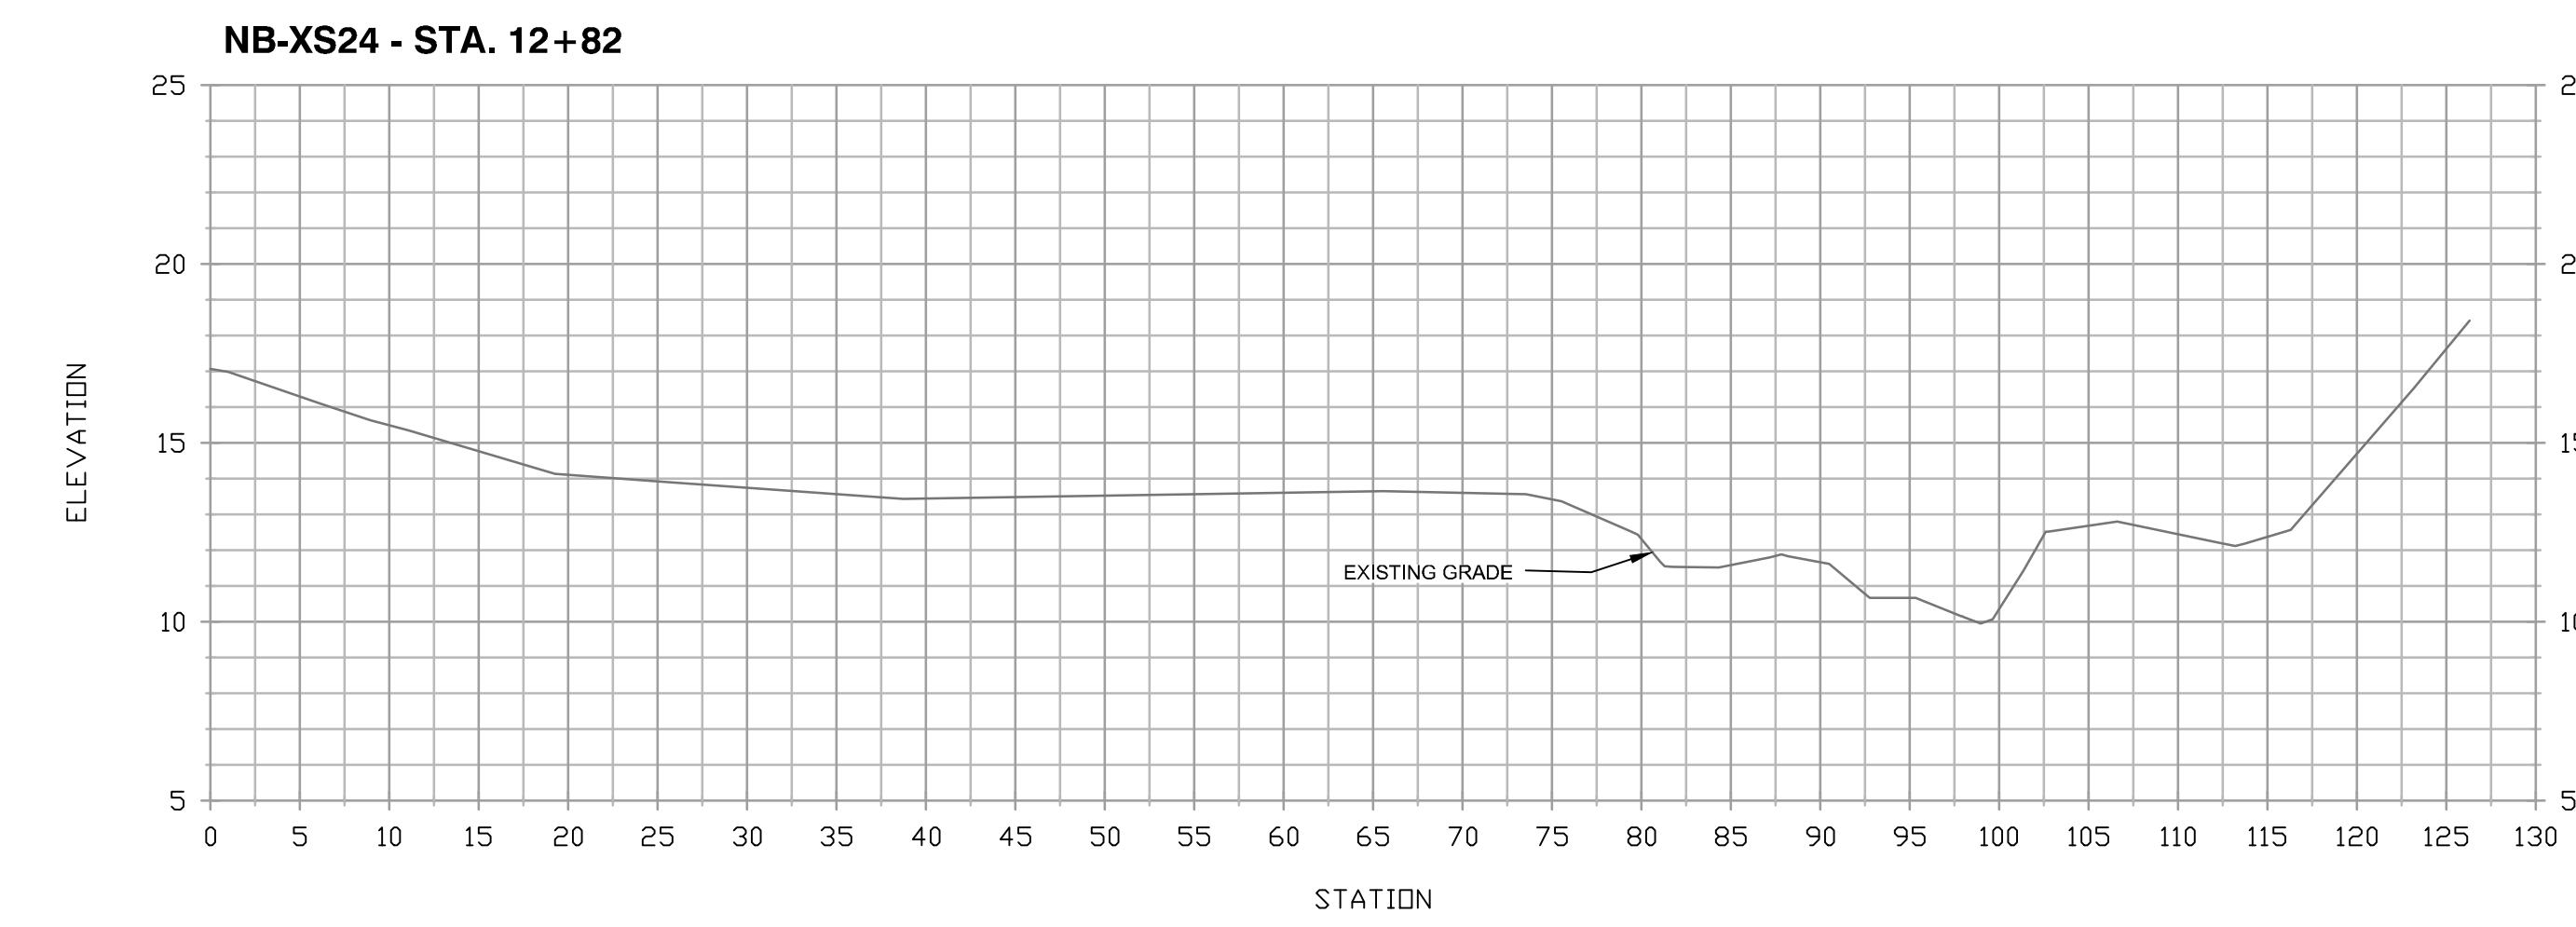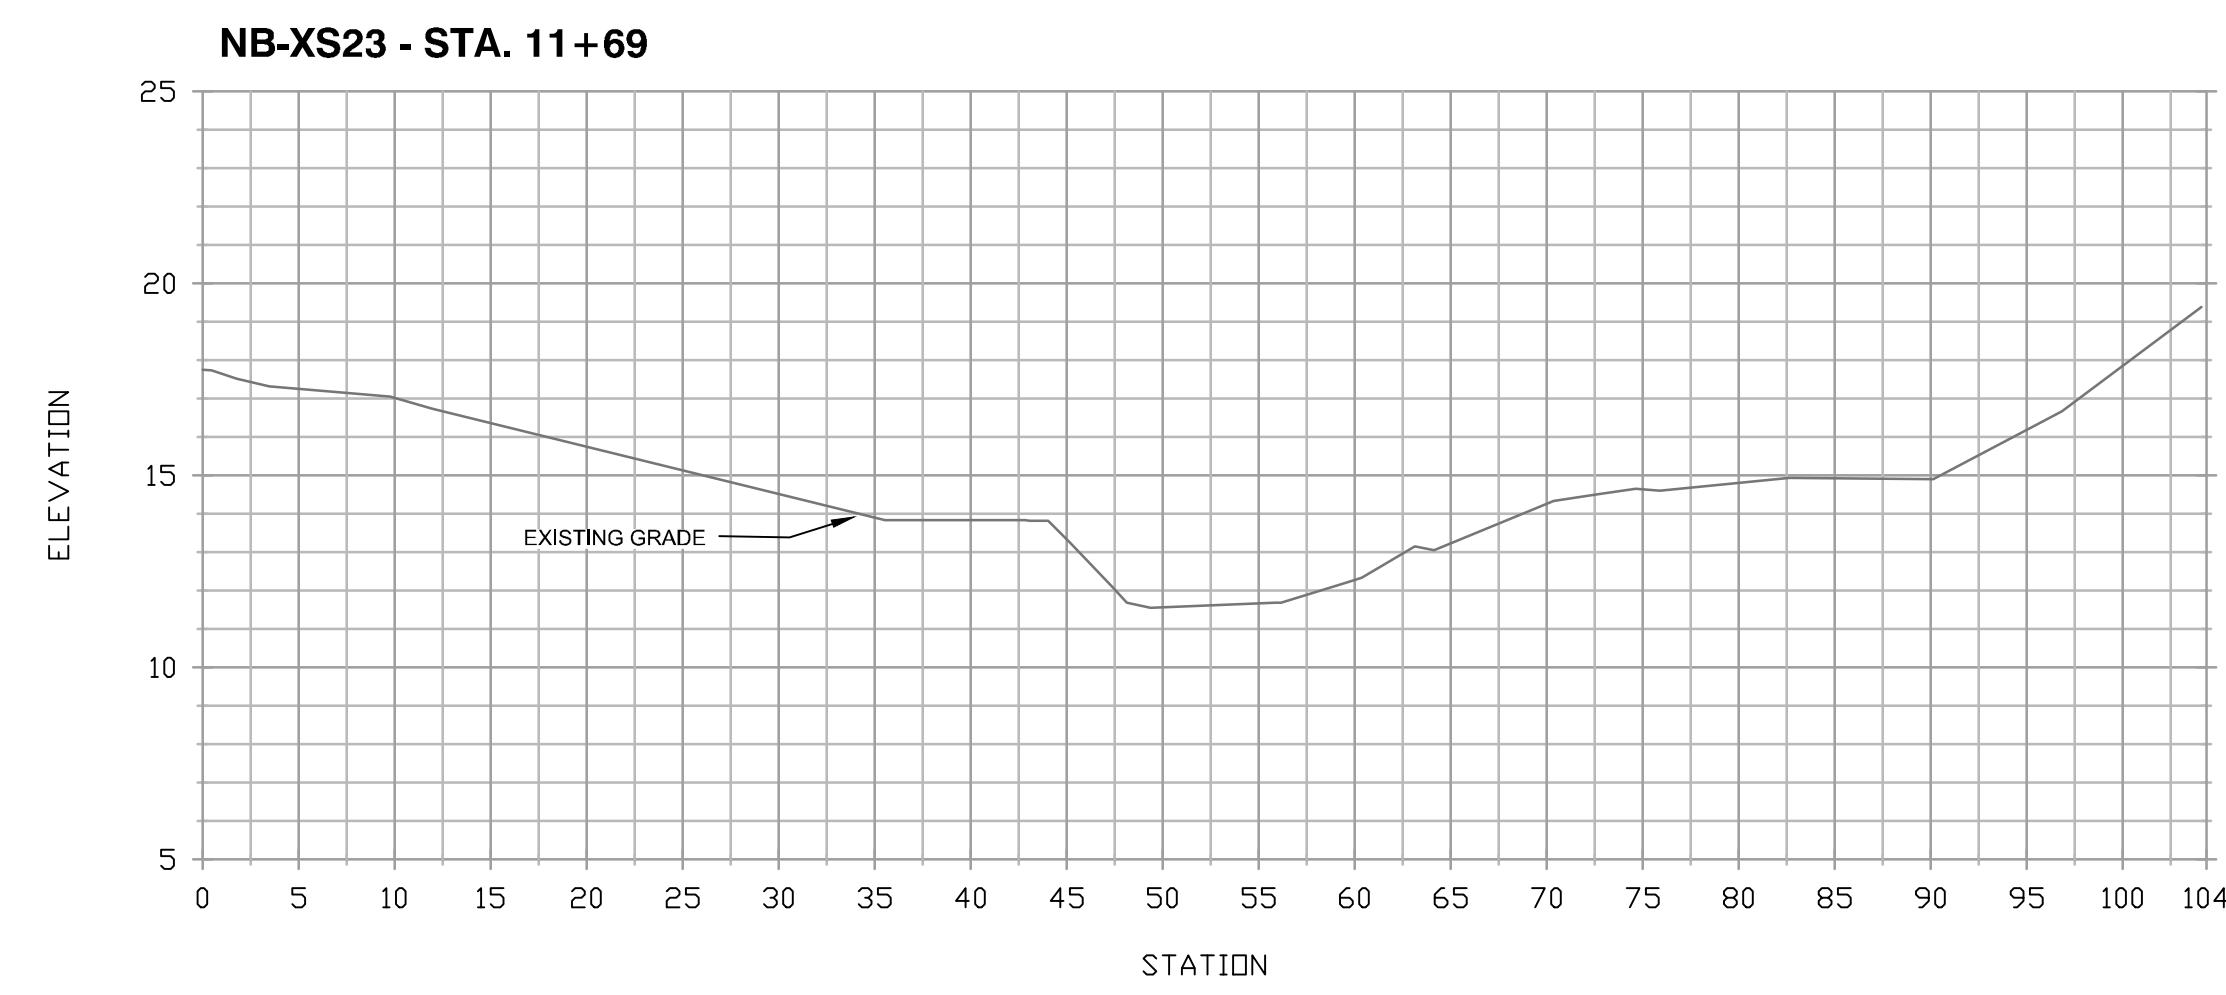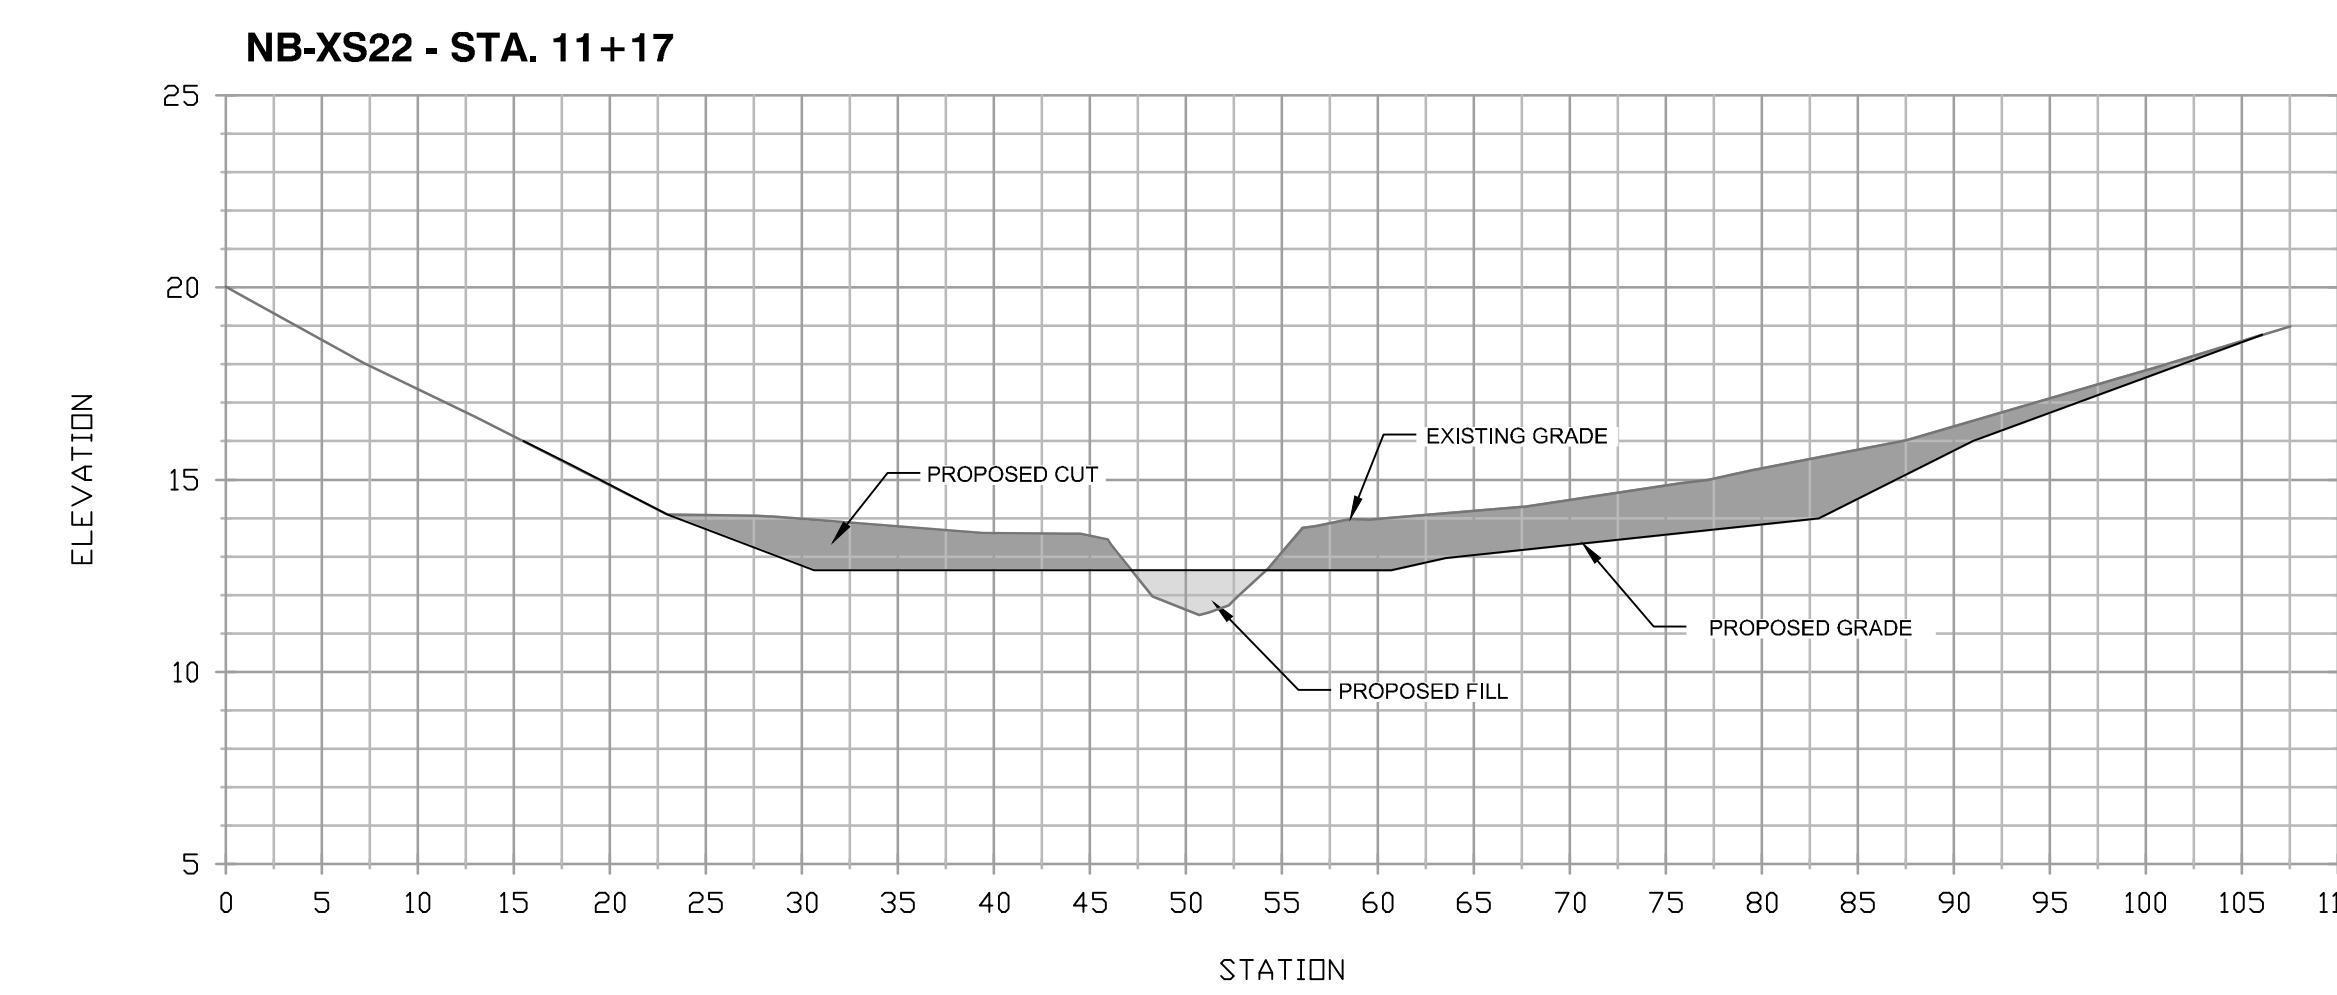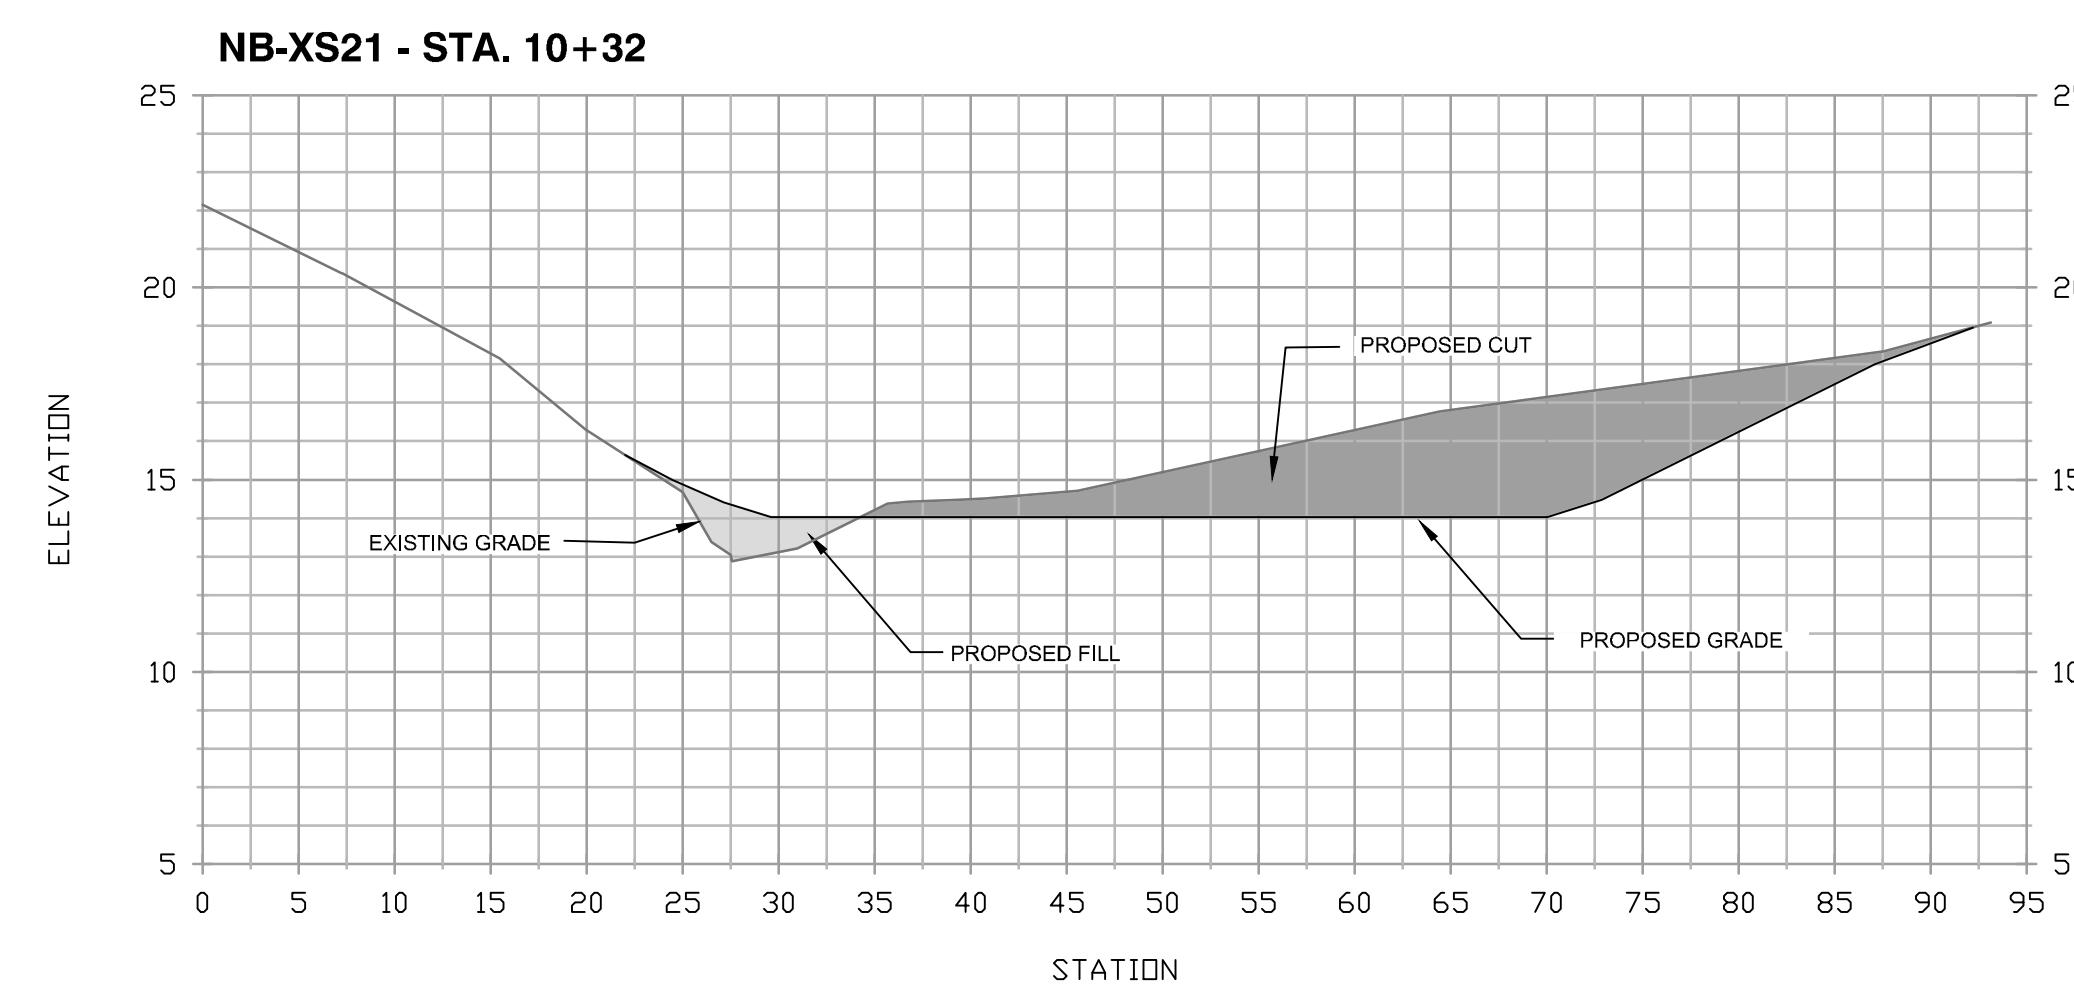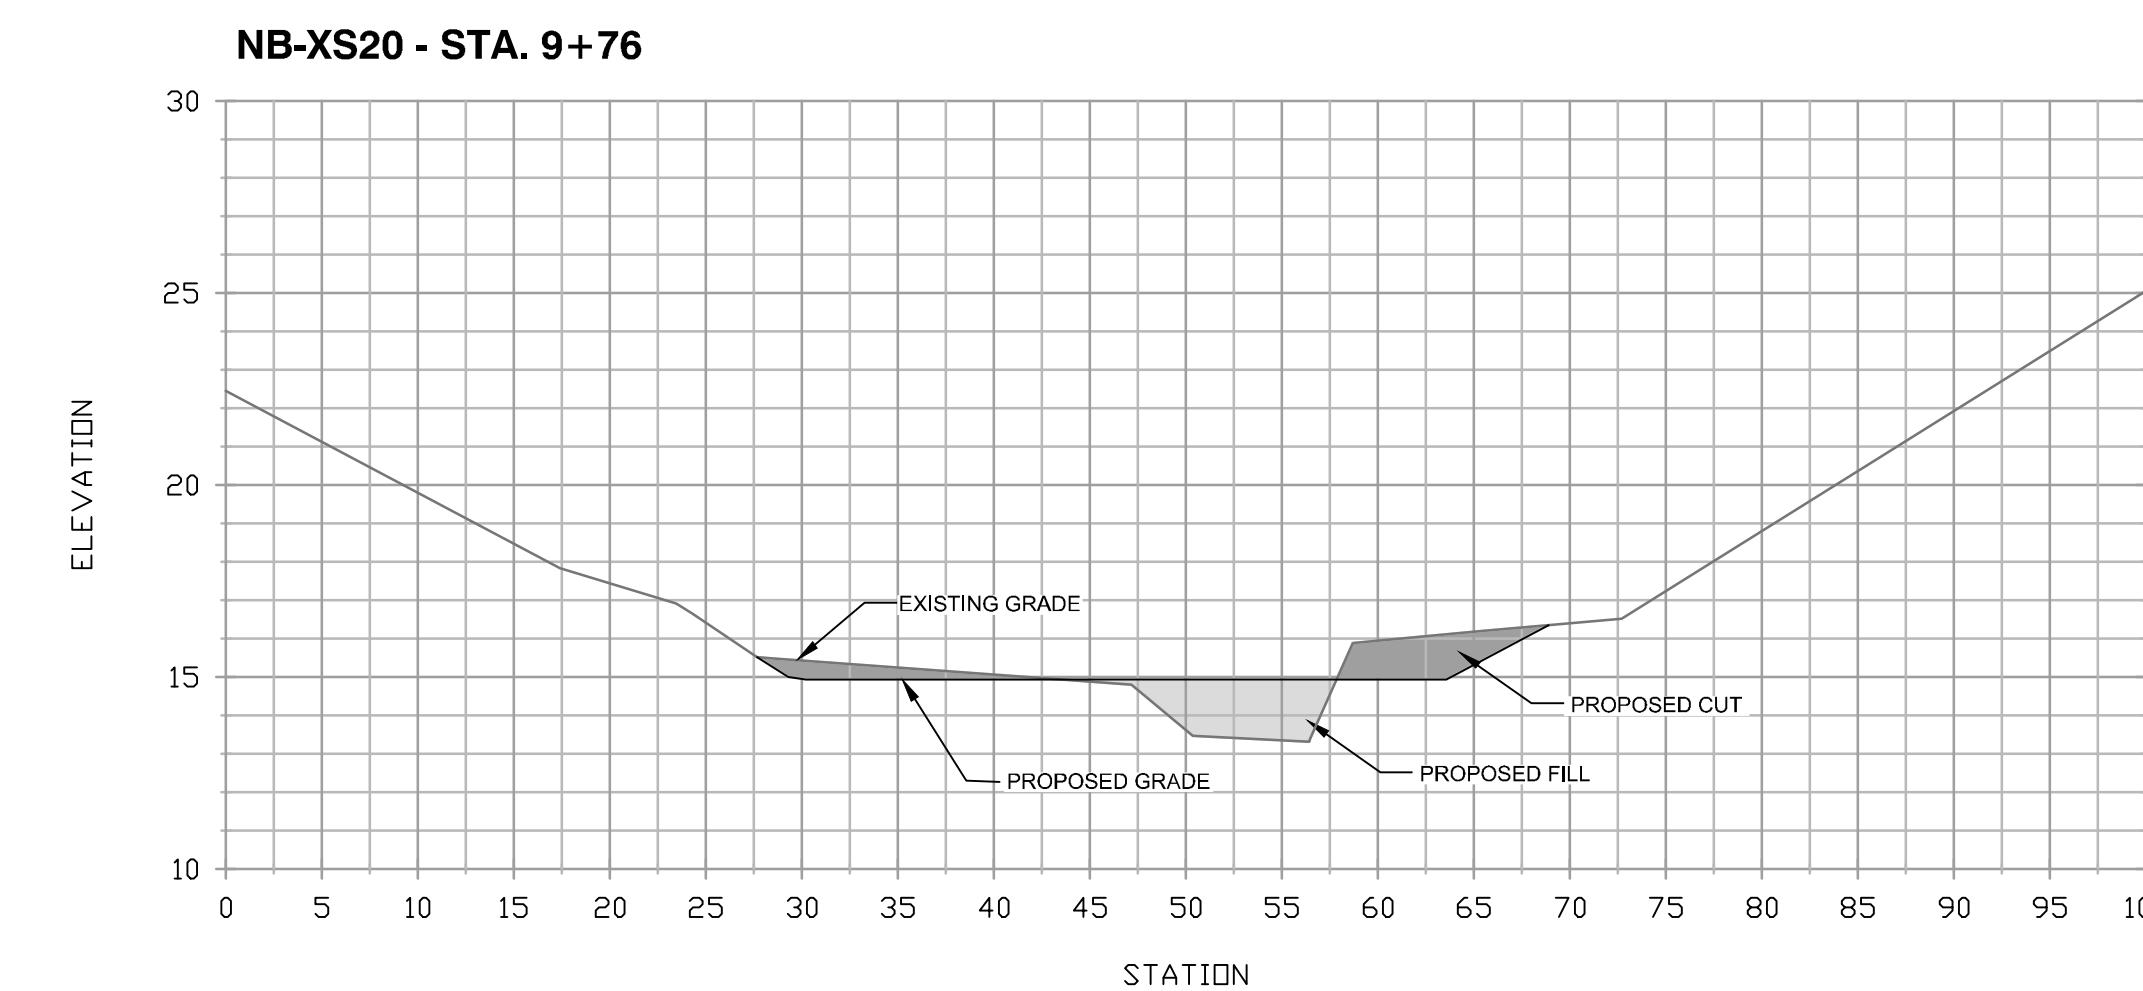
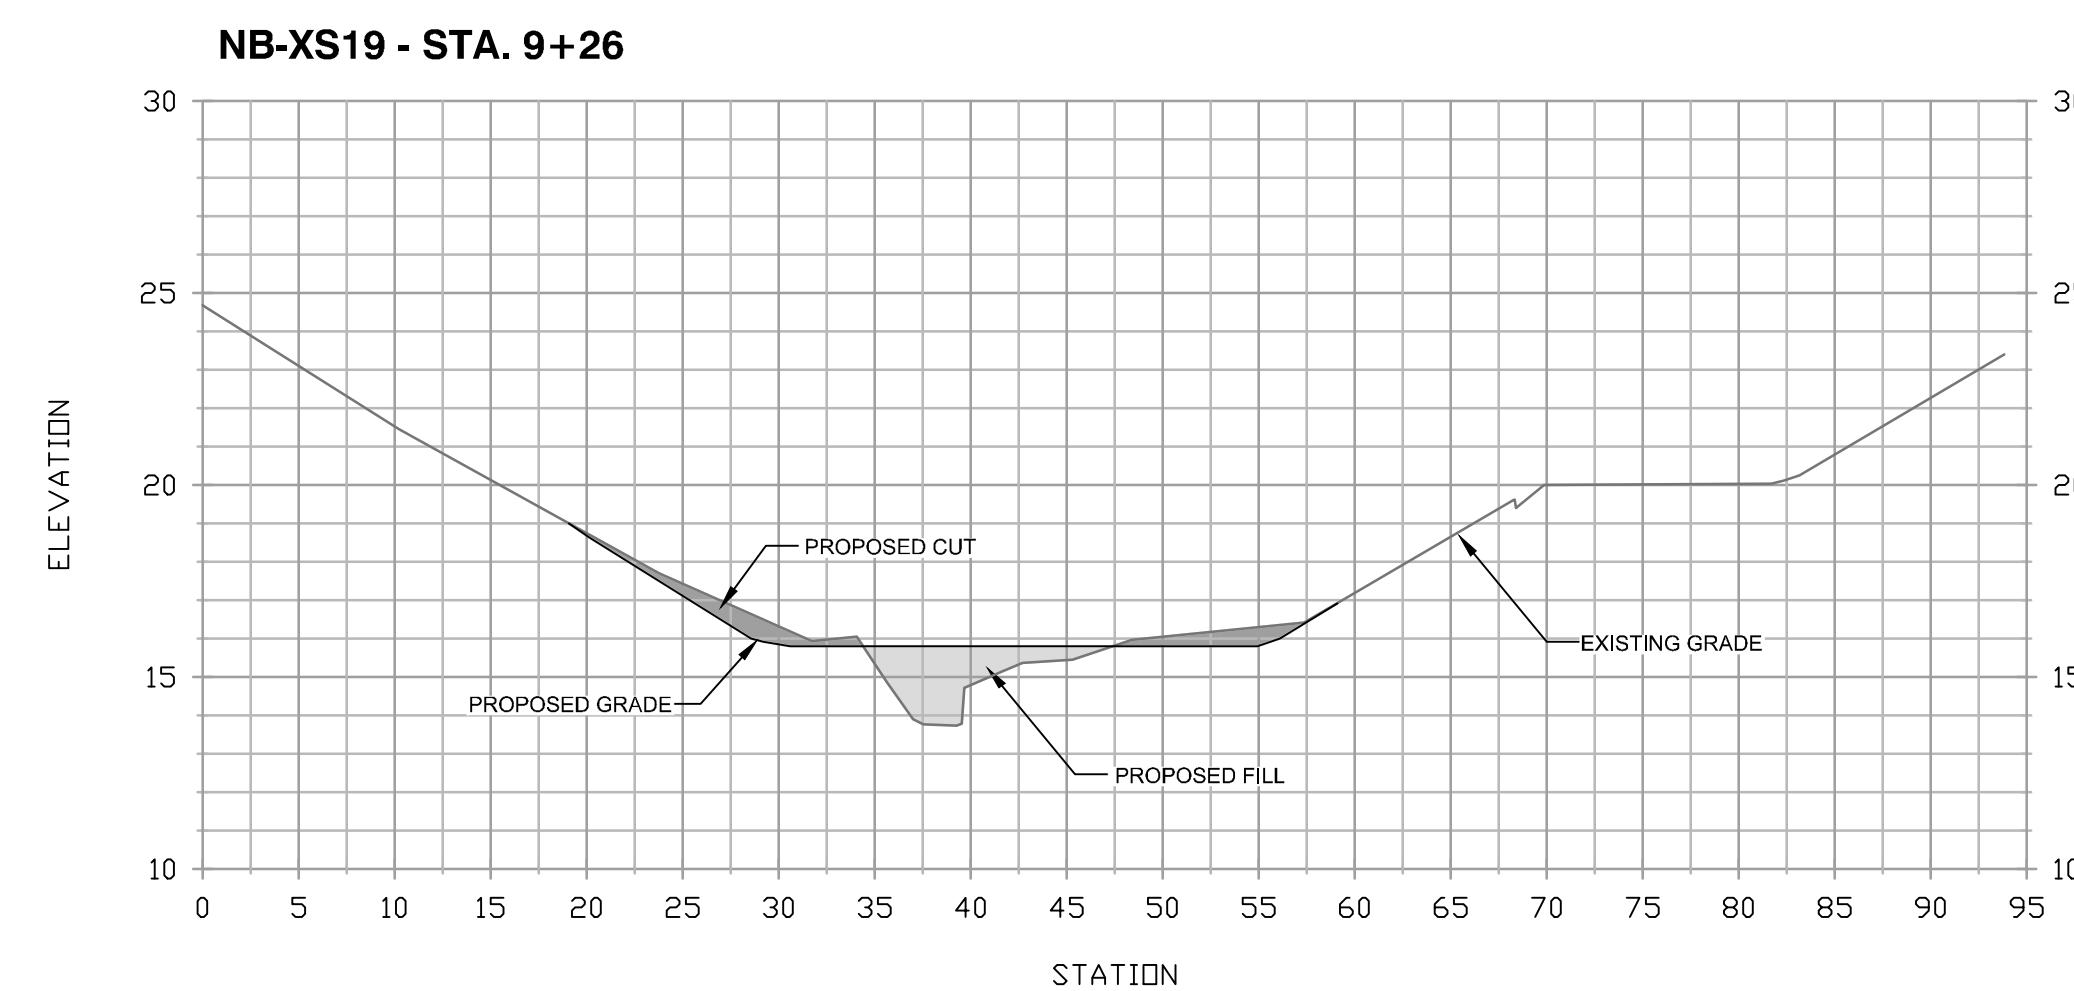


HORIZ: 1" = 10'
VERT: 1" = 5'

0' 10' 20'


10' 5'

OWNER/DEVELOPER/APPLICANT		CIVIL ENGINEER A.A. County ID #721		REVISIONS	
 717-627-4440 fax: 717-627-4660 landstudies.com land@landstudies.com 315 North Street Lititz, PA 17543		 Dewberry 2101 Gaither Road Suite #340 Rockville, MD 20850 Contact: Joanne M. Cheok, Senior Associate Phone: (301) 337-2856 Fax: (301) 258-7607		ANNE ARUNDEL COUNTY DEPARTMENT OF PUBLIC WORKS STREAM RESTORATION PLAN NORTH BRANCH CROSS SECTION 4 SLOOP COVE RETROFIT SITE 1 3rd District Tax Map 16 Grid 05 Anne Arundel County	
				Professional Certification: I hereby certify that these documents were prepared or approved by me, and that I am a duly licensed professional engineer under the laws of the State of Maryland, License No. 18095, Expiration Date: 12/21/2022. APPROVED DATE APPROVED DATE DRAWN BY: B.J. F. Anchors CHIEF ENGINEER PROJECT MANAGER CHECKED BY: J. Cheok APPROVED DATE APPROVED DATE SHEET NO: 18 OF 39 PROJECT NO: 5010963 PROPOSAL NO: ASSISTANT CHIEF ENGINEER CHEF, RIGHT OF WAY	

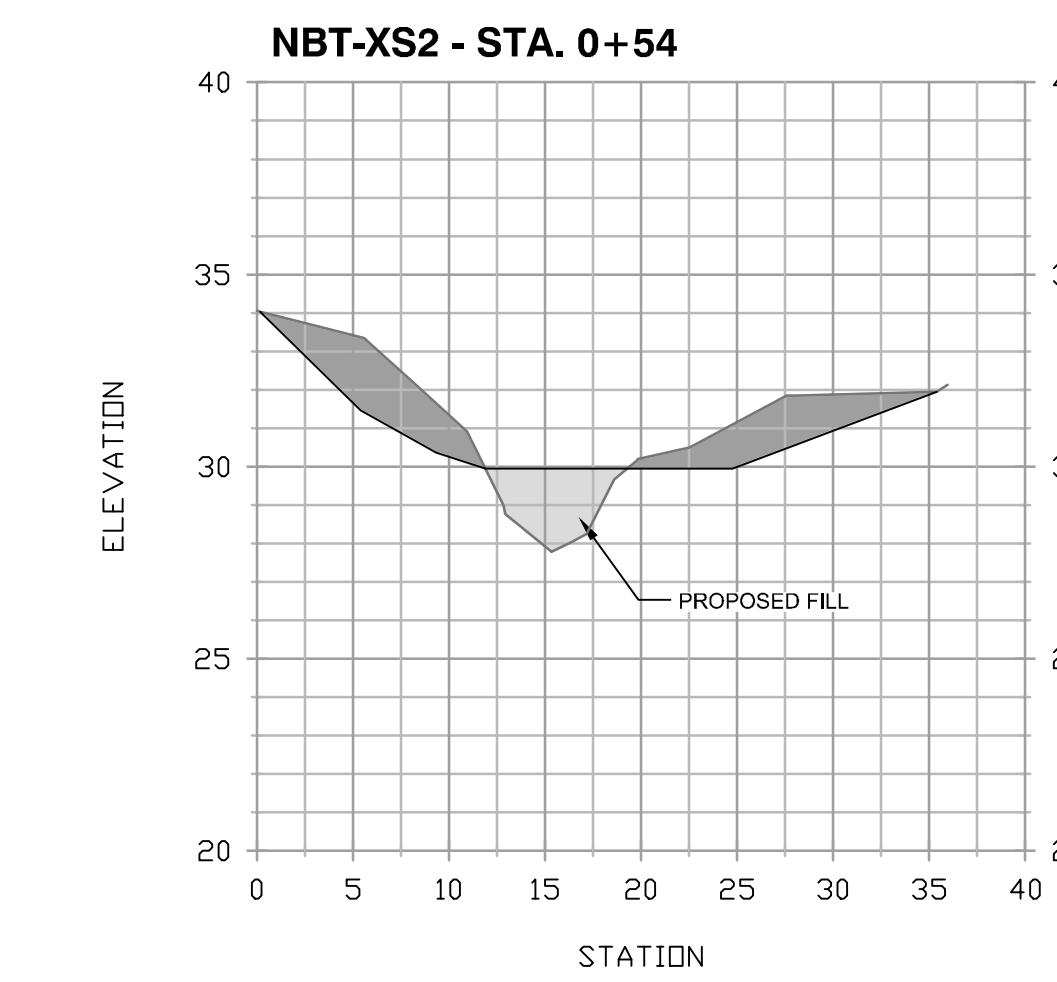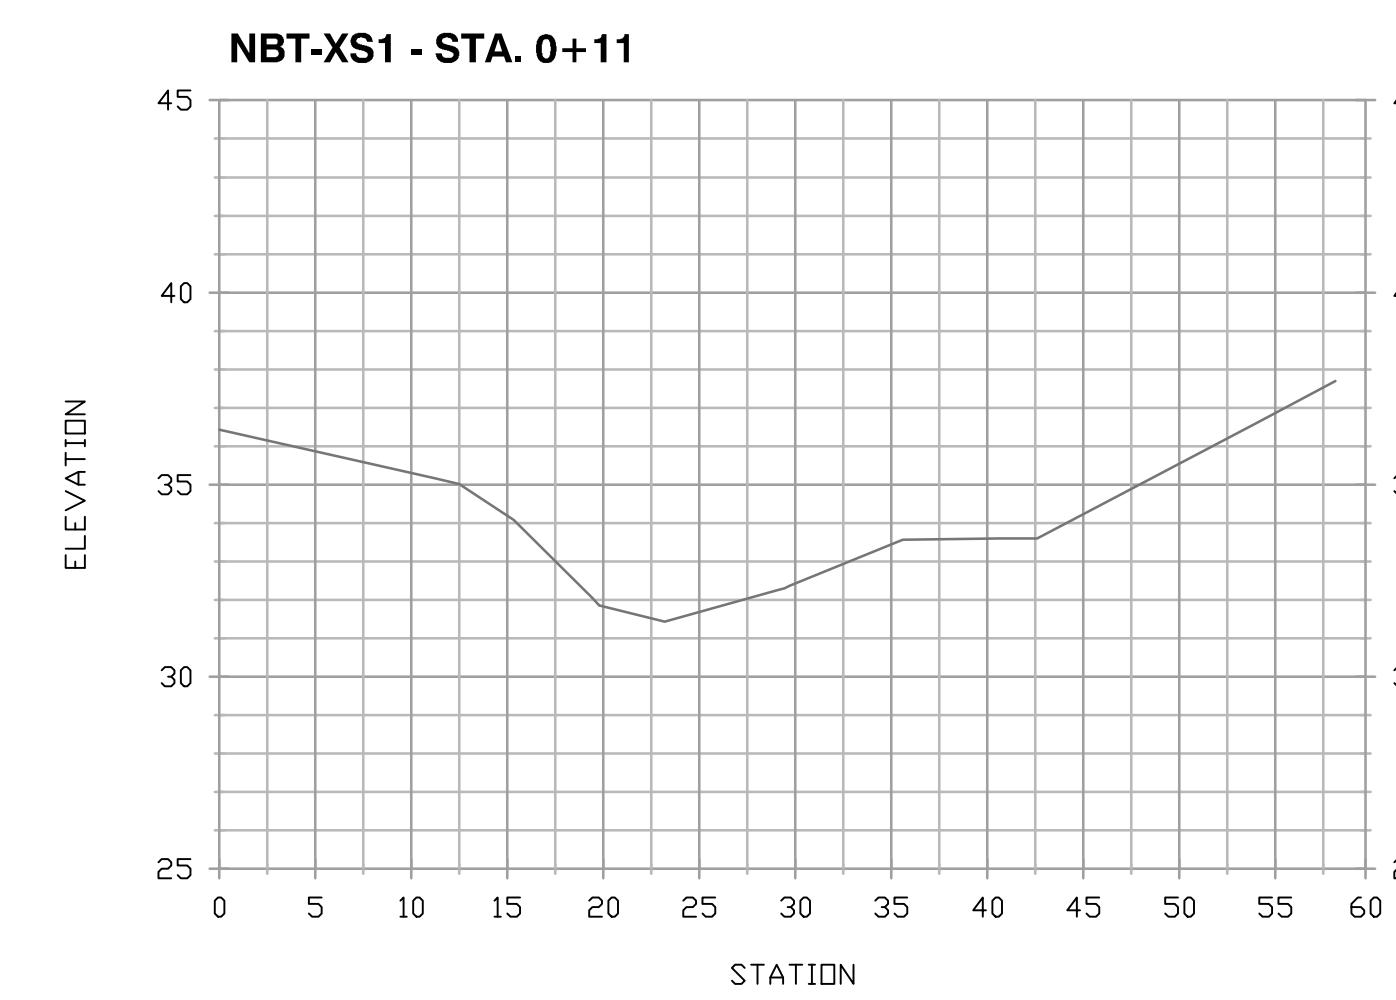



HORIZ: 1" = 10'
VERT: 1" = 5'
0' 10' 20'

OWNER/DEVELOPER/APPLICANT		CIVIL ENGINEER A.A. County ID #721		REVISIONS				ANNE ARUNDEL COUNTY DEPARTMENT OF PUBLIC WORKS STREAM RESTORATION PLAN					
	717-627-4440 fax: 717-627-4660 landstudies.com land@landstudies.com 315 North Street Lititz, PA 17543	 Dewberry 2101 Gaither Road Suite #340 Rockville, MD 20850 Contact: Joanne M. Cheek, Senior Associate Phone: (301) 337-2856 Fax: (301) 258-7607		Professional Certification: I hereby certify that these documents were prepared or approved by me, and that I am a duly licensed professional engineer under the laws of the State of Maryland, License No. 18095, Expiration Date: 12/21/2022.	NO	Description	BY	DATE	APPROVED	DATE	APPROVED	DATE	
									CHIEF ENGINEER	PROJECT MANAGER			
									APPROVED	DATE	APPROVED	DATE	
									ASSISTANT CHIEF ENGINEER	CHIEF, RIGHT OF WAY			
											SCALE: As Shown	DRAWN BY: Bill R. Anchors CHECKED BY: J. Cheek SHEET NO: 19 OF 39 PROJECT NO: 50017963 PROPOSAL NO: 3rd District	
												Tax Map 16 Grid 05 Anne Arundel County	

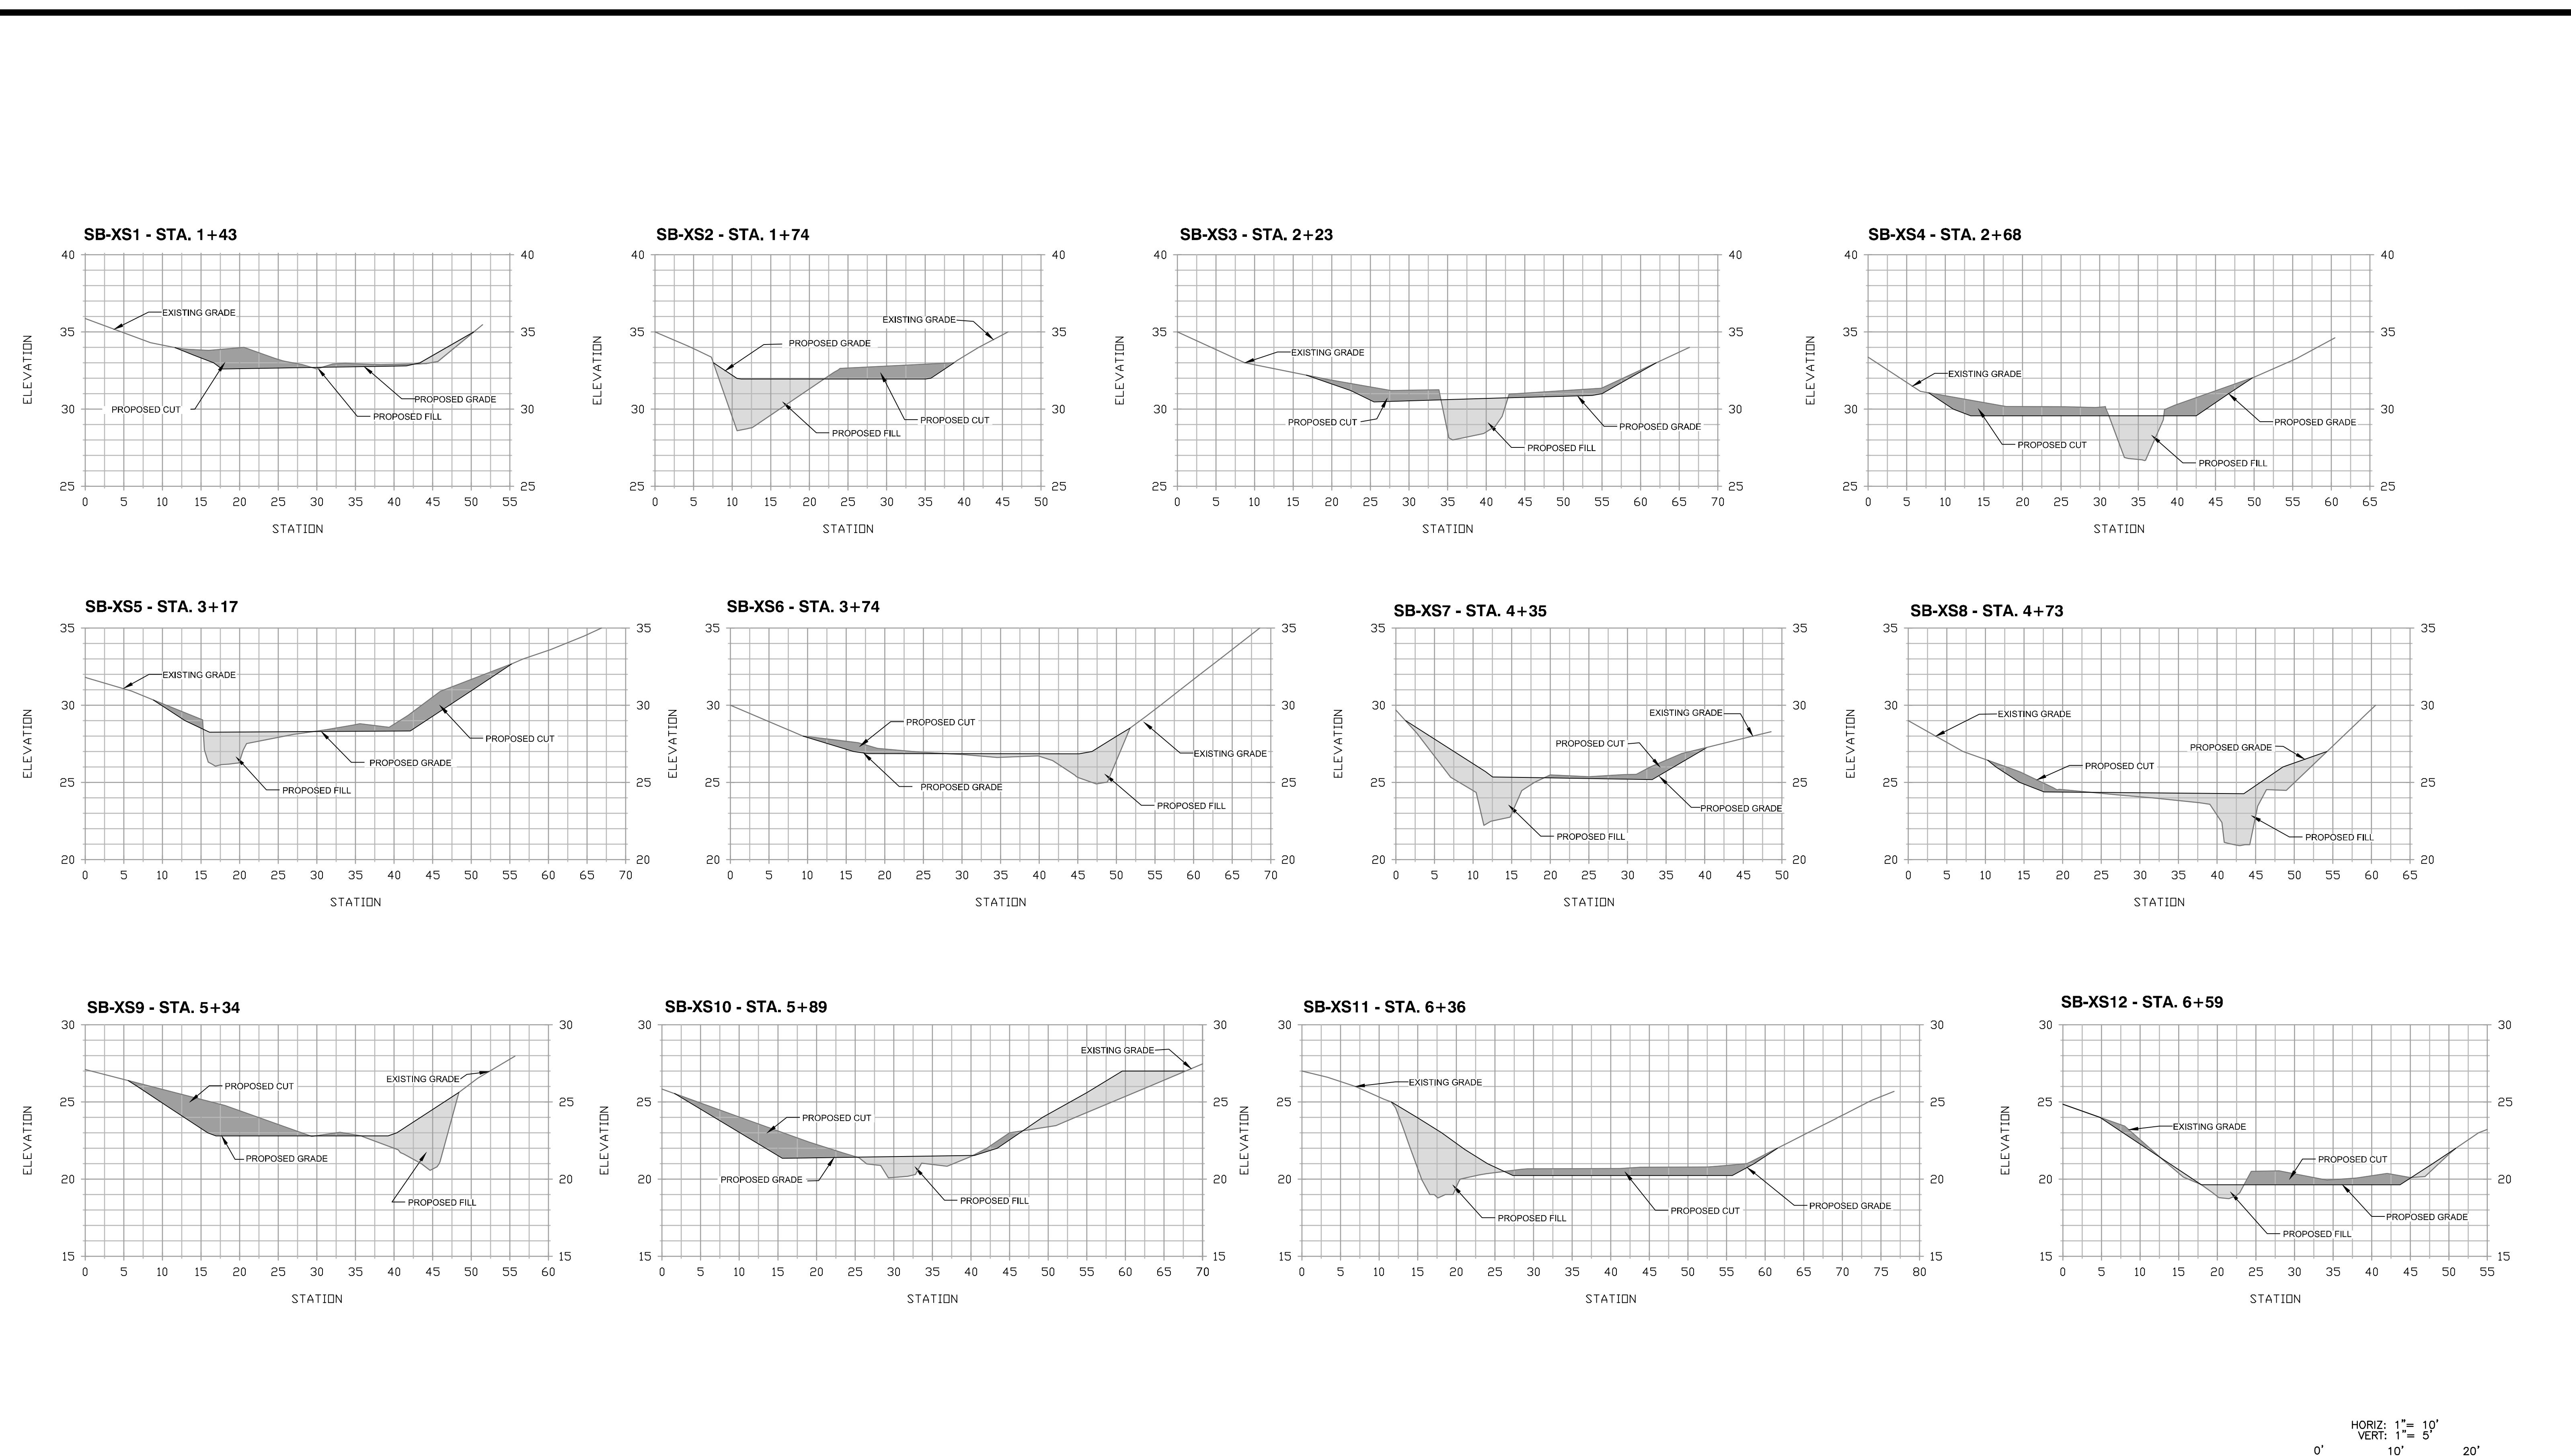



HORIZ: 1" = 10'
VERT: 1" = 5'
0' 10' 20'

OWNER/DEVELOPER/APPLICANT		CIVIL ENGINEER A.A. County ID #721		REVISIONS	ANNE ARUNDEL COUNTY					
Land Studies	717-627-4440 fax: 717-627-4660 landstudies.com 315 North Street Lititz, PA 17543	Dewberry	2101 Gaither Road Suite #340 Rockville, MD 20850 Contact: Joanne M. Cheek, Senior Associate Phone: (301) 337-2856 Fax: (301) 258-7607		NO	Description	BY	DATE	DEPARTMENT OF PUBLIC WORKS	STREAM RESTORATION PLAN
					APPROVED	DATE	APPROVED	DATE	CHIEF ENGINEER	PROJECT MANAGER
									CHEEK, J.	CHEEK, J.
					APPROVED	DATE	APPROVED	DATE	ASSISTANT CHIEF ENGINEER	CHIEF, RIGHT OF WAY
									PROPOSAL NO:	3rd District
									SHEET NO: 20 OF 39	PROJECT NO: 50017963
									PROPOSAL NO:	Anne Arundel County
										Tax Map 16 Grid 05

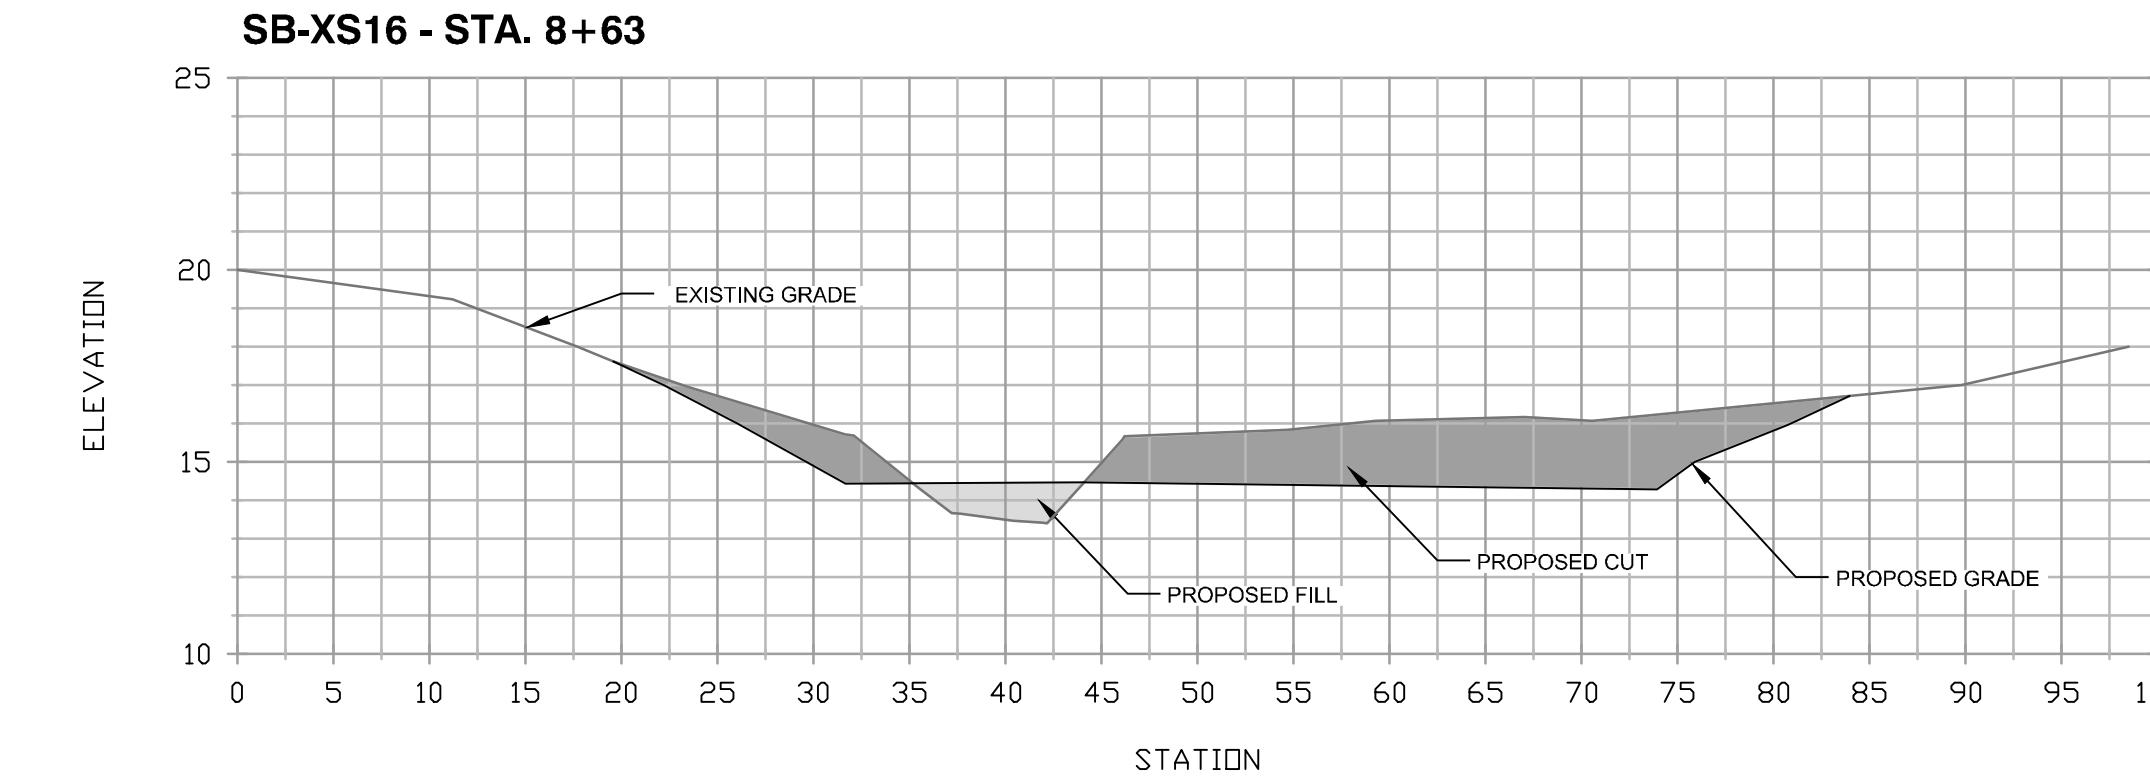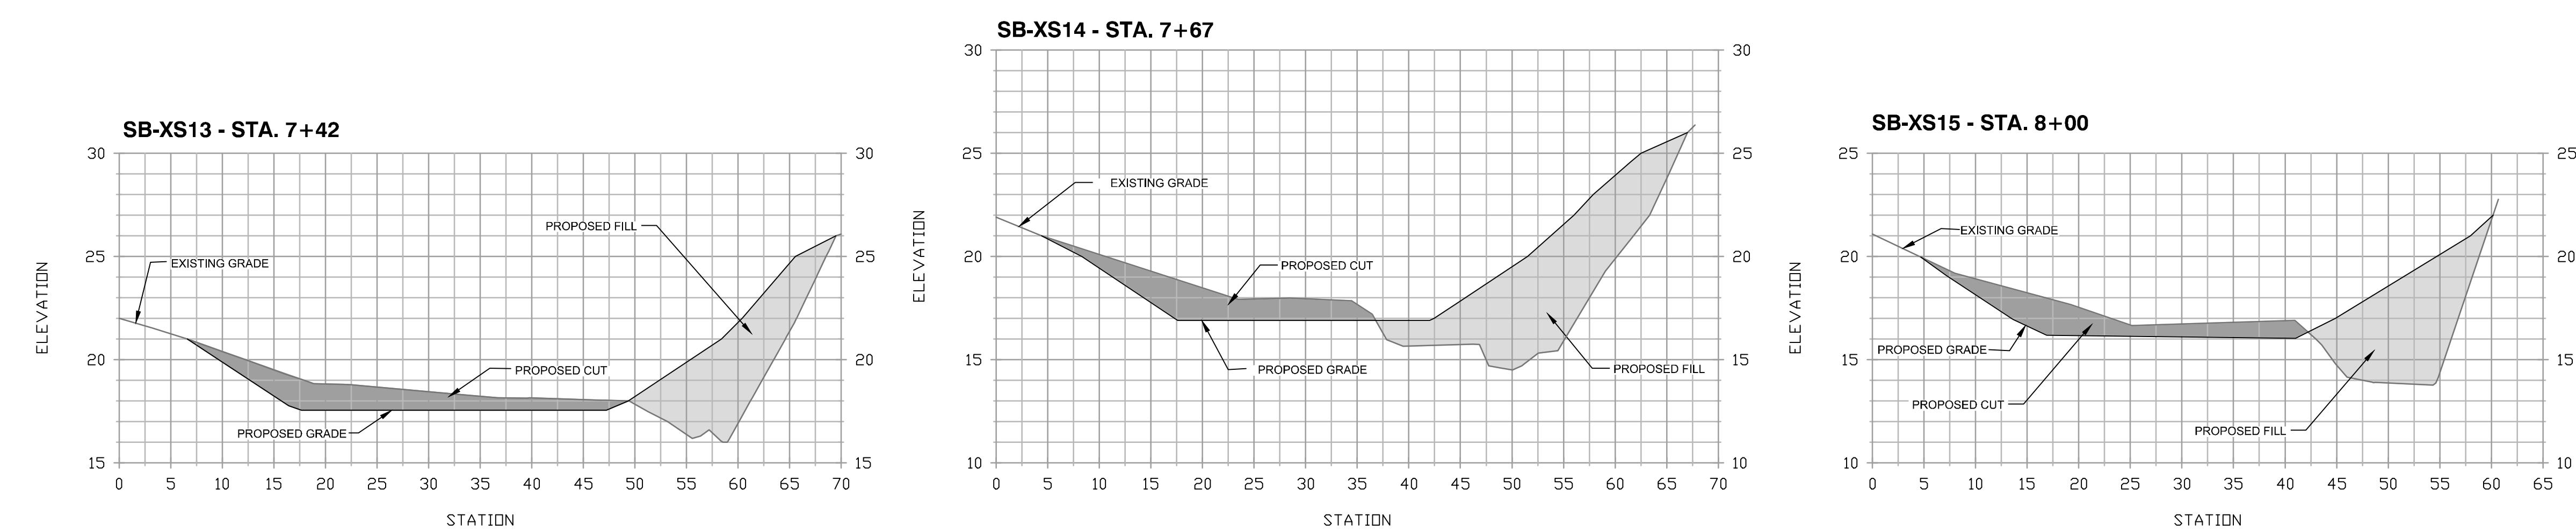


HORIZ: 1" = 10'
VERT: 1" = 5'
0' 10' 20'

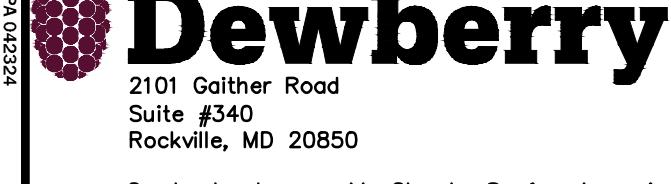
OWNER/DEVELOPER/APPLICANT		CIVIL ENGINEER A.A. County ID #721		REVISIONS		ANNE ARUNDEL COUNTY DEPARTMENT OF PUBLIC WORKS STREAM RESTORATION PLAN							
	717-627-4440 fax: 717-627-4660 landstudies.com land@landstudies.com 315 North Street Lititz, PA 17543	 CIVIL ENGINEER A.A. County ID #721 2101 Gaither Road Suite #340 Rockville, MD 20850 Contact: Joanne M. Cheek, Senior Associate Phone: (301) 337-2856 Fax: (301) 258-7607		Professional Certification: I hereby certify that these documents were prepared or approved by me, and that I am a duly licensed professional engineer under the laws of the State of Maryland, License No. 18095, Expiration Date: 12/21/2022.	NO	Description	BY	DATE	APPROVED	DATE	APPROVED	DATE	SCALE: As Shown
									CHIEF ENGINEER	PROJECT MANAGER			DRAWN BY: Bill R. Anchors
									APPROVED	DATE	APPROVED	DATE	CHECKED BY: J. Cheek
									ASSISTANT CHIEF ENGINEER	CHIEF, RIGHT OF WAY			SHEET NO: 21 OF 39 PROJECT NO: 50017963 PROPOSAL NO:
													3rd District
PROJECT 2008 File\Stop Cove_50017963\CAD\CIVIL\Site Plan - Construction\20-21 - SF-Cross Sections\South.dwg 2/10/2021 3:51:14 PM. rerepulu										SOUTH BRANCH CROSS SECTION 2 SLOOP COVE RETROFIT SITE 1 Tax Map 16 Grid 05		Anne Arundel County	

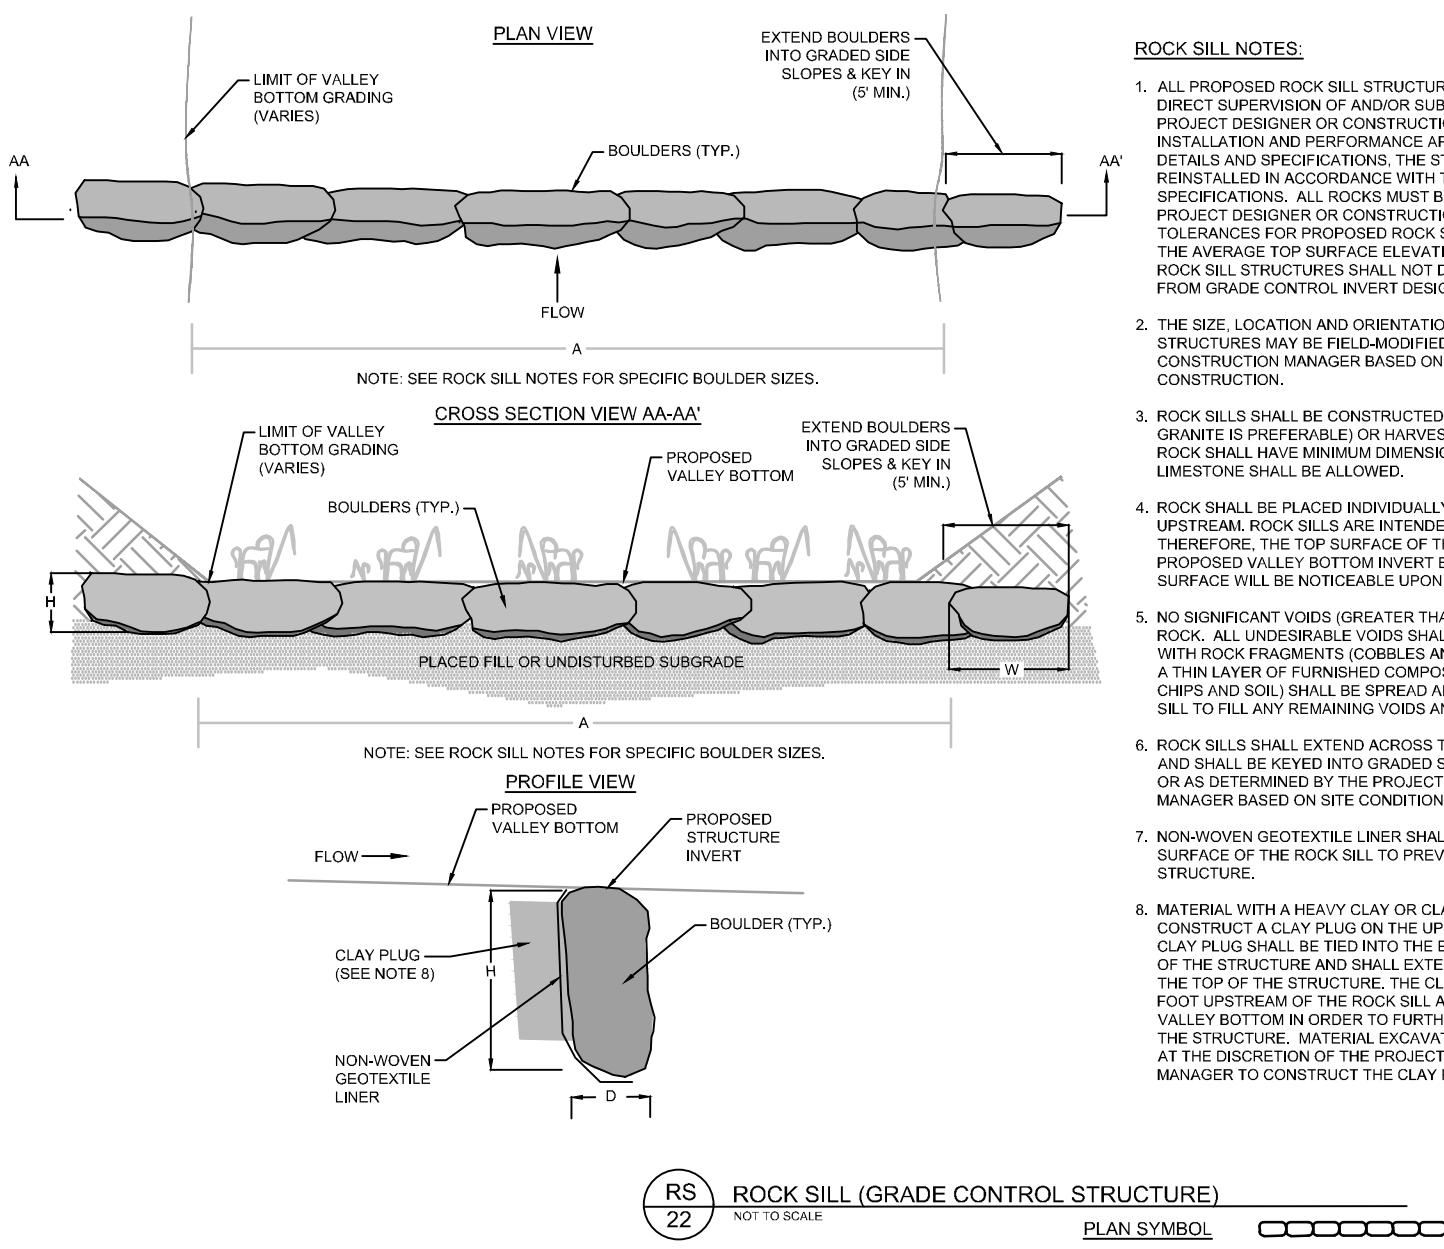


PROPOSED ROCK SILL GRADE CONTROL STRUCTURE SCHEDULE					
STRUCTURE ID	REACH	STATION	INVERT ELEVATION (FT)	WIDTH UP/DOWNSTREAM (FT)	LENGTH ACROSS FLOODPLAIN (FT)
RS-1	S. BRANCH	1+52	32.49	2-3'	34.0
RS-2	S. BRANCH	1+92	31.48	2-3'	34.0
RS-3	S. BRANCH	2+72	29.46	2-3'	39.0
RS-4	S. BRANCH	3+07	28.56	2-3'	34.0
RS-5	S. BRANCH	3+49	27.50	2-3'	34.0
RS-6	S. BRANCH	4+27	25.53	2-3'	29.0
RS-7	S. BRANCH	4+69	24.46	2-3'	34.0
RS-8	S. BRANCH	5+09	23.45	2-3'	34.0
RS-9	S. BRANCH	5+50	22.50	2-3'	34.0
RS-10	S. BRANCH	5+87	21.48	2-3'	39.0
RS-11	S. BRANCH	6+65	19.49	2-3'	39.0
RS-12	S. BRANCH	7+03	18.53	2-3'	39.0
RS-13	S. BRANCH	7+45	17.47	2-3'	44.0
RS-14	S. BRANCH	8+25	15.44	2-3'	39.0
RS-15	S. BRANCH	8+71	14.27	2-3'	63.0
RS-16	N. BRANCH	1+19	30.33	2-3'	34.0
RS-17	N. BRANCH	1+90	29.05	2-3'	44.0
RS-18	N. BRANCH	3+43	26.96	2-3'	44.0
RS-19	N. BRANCH	4+36	25.69	2-3'	58.0
RS-20	N. BRANCH	4+87	24.72	2-3'	53.0
RS-21	N. BRANCH	5+42	23.67	2-3'	44.0
RS-22	N. BRANCH	6+44	21.72	2-3'	44.0
RS-23	N. BRANCH	7+44	19.81	2-3'	34.0
RS-24	N. BRANCH	8+00	18.72	2-3'	44.0
RS-25	N. BRANCH	8+40	17.96	2-3'	40.0
RS-26	N. BRANCH	8+77	17.26	2-3'	53.0
RS-27	N. BRANCH	9+04	16.44	2-3'	39.0
RS-28	N. BRANCH	9+31	15.66	2-3'	68.0
RS-29	N. BRANCH	10+54	13.66	2-3'	68.0
RS-30	N. BRANCH	11+03	12.87	2-3'	58.0
RS-31	N. BRANCH	11+56	12.03	2-3'	56.0
RS-32	N. BRANCH TRIB	0+56	29.92	2-3'	10.0

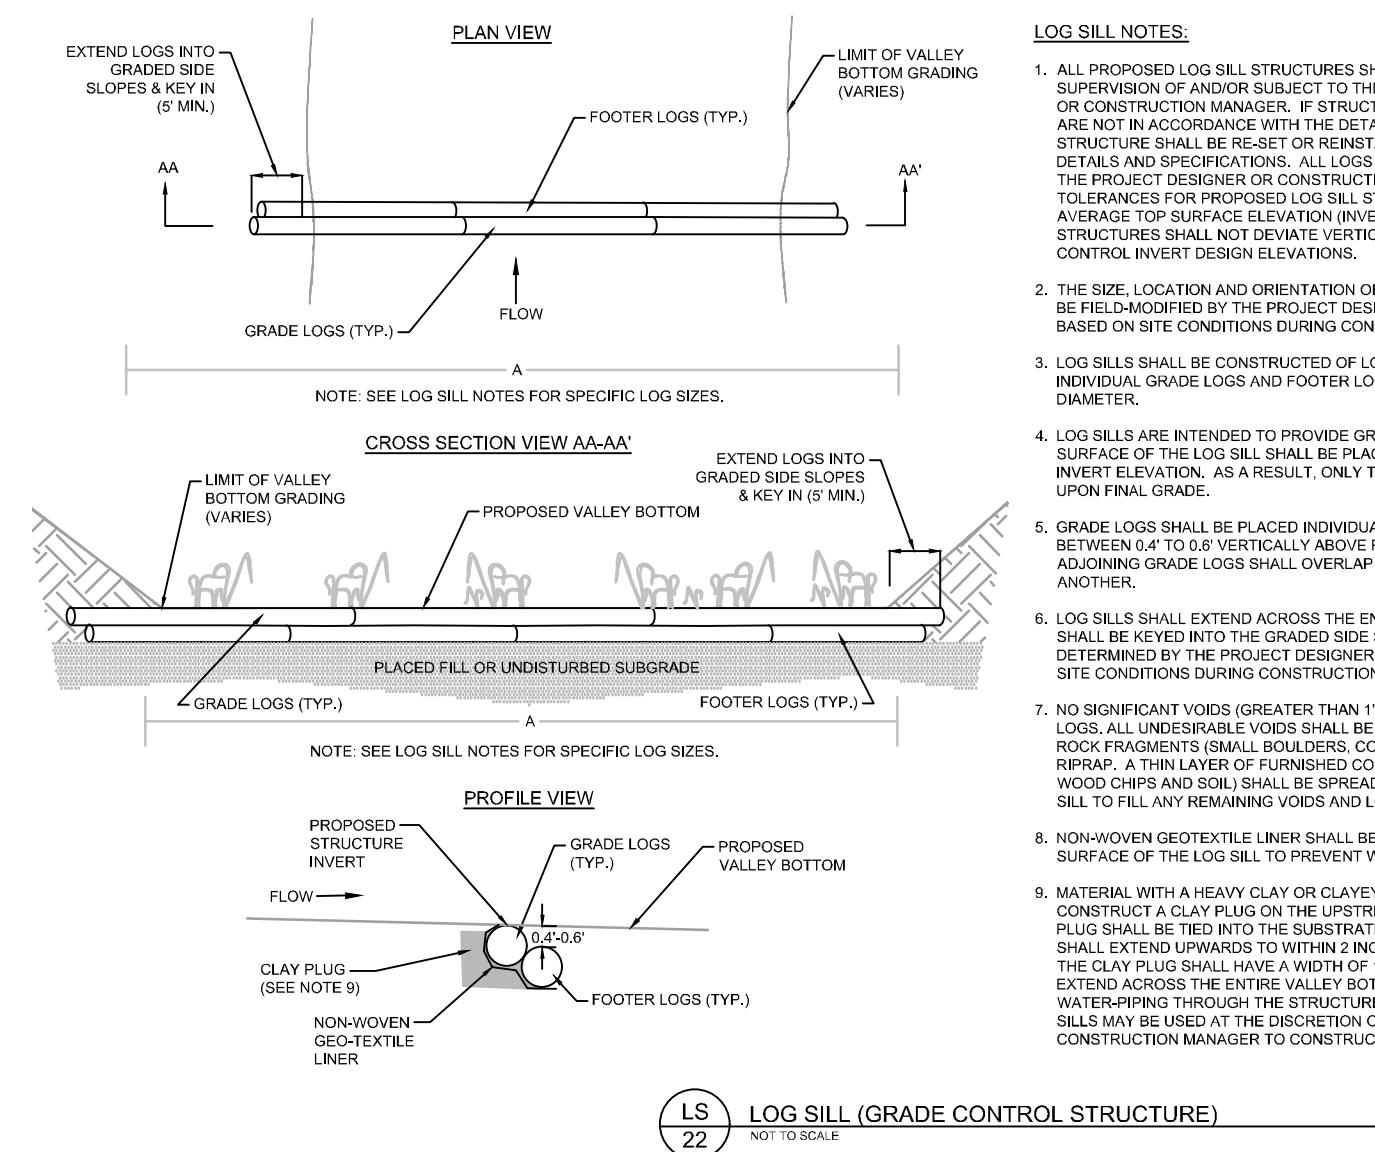


PROPOSED LOG SILL GRADE CONTROL STRUCTURE SCHEDULE					WIDTH	LENGTH
STRUCTURE ID	REACH	STATION	INVERT ELEVATION (FT)	UP/DOWNSTREAM* (FT)	ACROSS FLOODPLAIN (FT)	
LS-1	S. BRANCH	1+71	32.00	2-4'	34.7	
LS-2	S. BRANCH	2+13	30.95	2-4'	32.6	
LS-3	S. BRANCH	2+32	30.47	2-4'	35.1	
LS-4	S. BRANCH	2+53	29.93	2-4'	37.2	
LS-5	S. BRANCH	3+29	28.00	2-4'	34.3	
LS-6	S. BRANCH	3+74	26.86	2-4'	36.4	
LS-7	S. BRANCH	3+89	26.50	2-4'	31.9	
LS-8	S. BRANCH	4+08	26.00	2-4'	31.9	
LS-9	S. BRANCH	4+49	25.00	2-4'	30.5	
LS-10	S. BRANCH	4+90	23.92	2-4'	36.2	
LS-11	S. BRANCH	5+29	22.94	2-4'	33.6	
LS-12	S. BRANCH	5+69	21.91	2-4'	33.6	
LS-13	S. BRANCH	6+08	20.94	2-4'	42.8	
LS-14	S. BRANCH	6+25	20.51	2-4'	43.0	
LS-15	S. BRANCH	7+65	16.97	2-4'	36.5	
LS-16	S.BRANCH	7+83	16.50	2-4'	35.7	
LS-17	S.BRANCH	8+06	15.91	2-4'	37.1	
LS-18	S.BRANCH	8+48	14.86	2-4'	49.0	
LS-19	N. BRANCH	1+55	29.53	2-4'	61.9	
LS-20	N. BRANCH	2+63	28.05	2-4'	49.2	
LS-21	N. BRANCH	5+93	22.69	2-4'	45.5	
LS-22	N. BRANCH	6+93	20.77	2-4'	36.5	
LS-23	N. BRANCH	8+58	17.62	2-4'	53.1	
LS-24	N. BRANCH	8+91	16.83	2-4'	49.2	
LS-25	N. BRANCH	9+17	16.06	2-4'	43.1	
LS-26	N. BRANCH	9+93	14.65	2-4'	48.8	

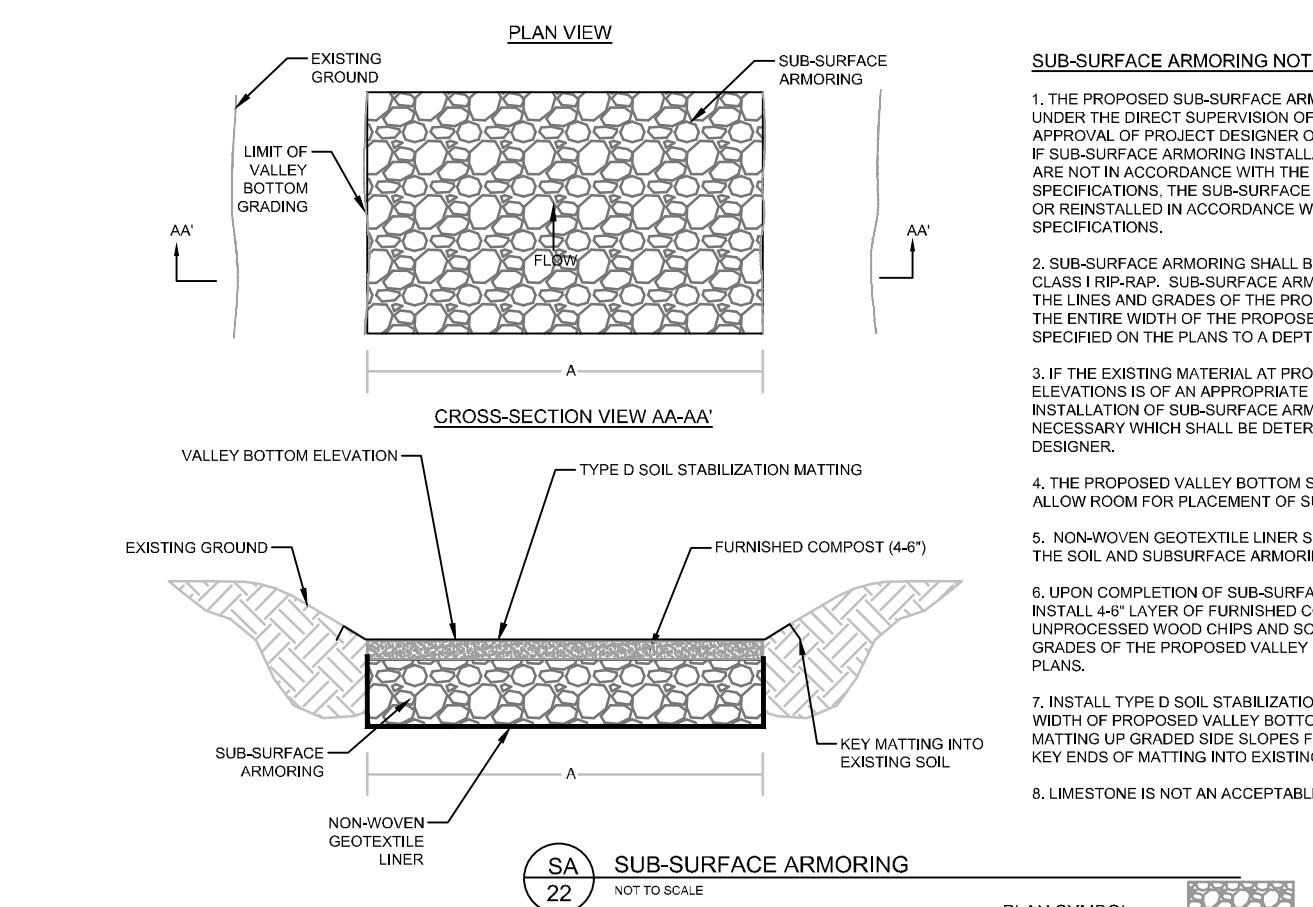

PROPOSED SUBSURFACE ARMORING SCHEDULE					
ID	REACH	STATION	D50 (IN)	THICKNESS (IN)	RIP-RAP SIZE
SA-1	N. BRANCH	8+78 TO 9+03	12"	19"	CLASS I
SA-2	N. BRANCH	9+05 TO 9+29	12"	19"	CLASS I
SA-3	N. BRANCH	11+45 TO 11+54	12"	19"	CLASS I

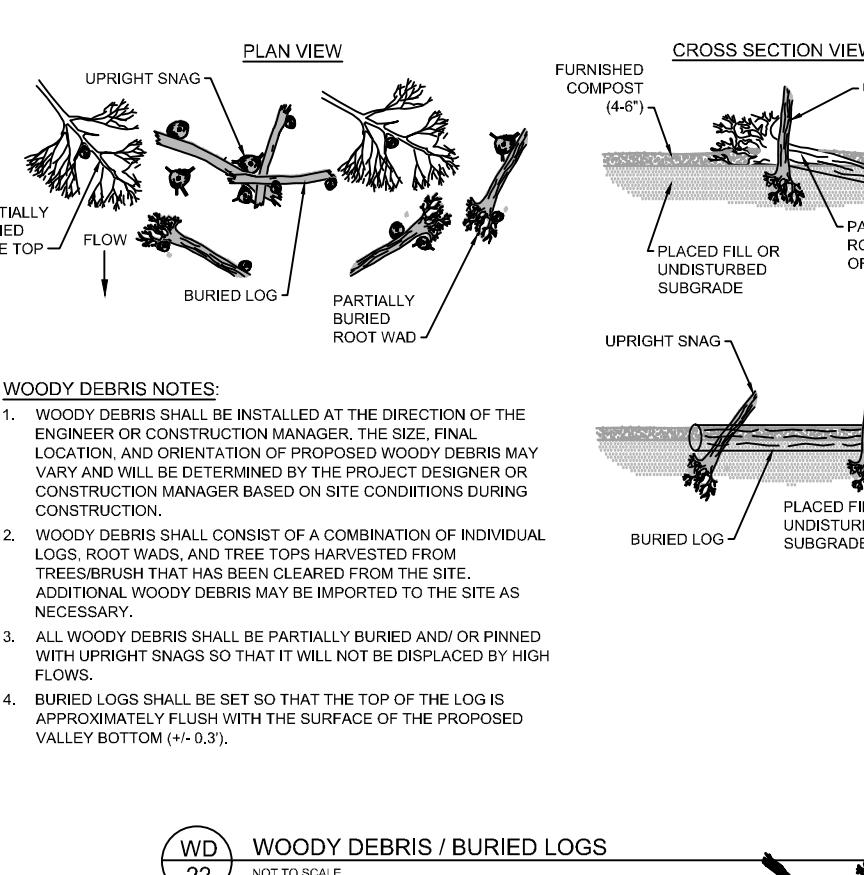

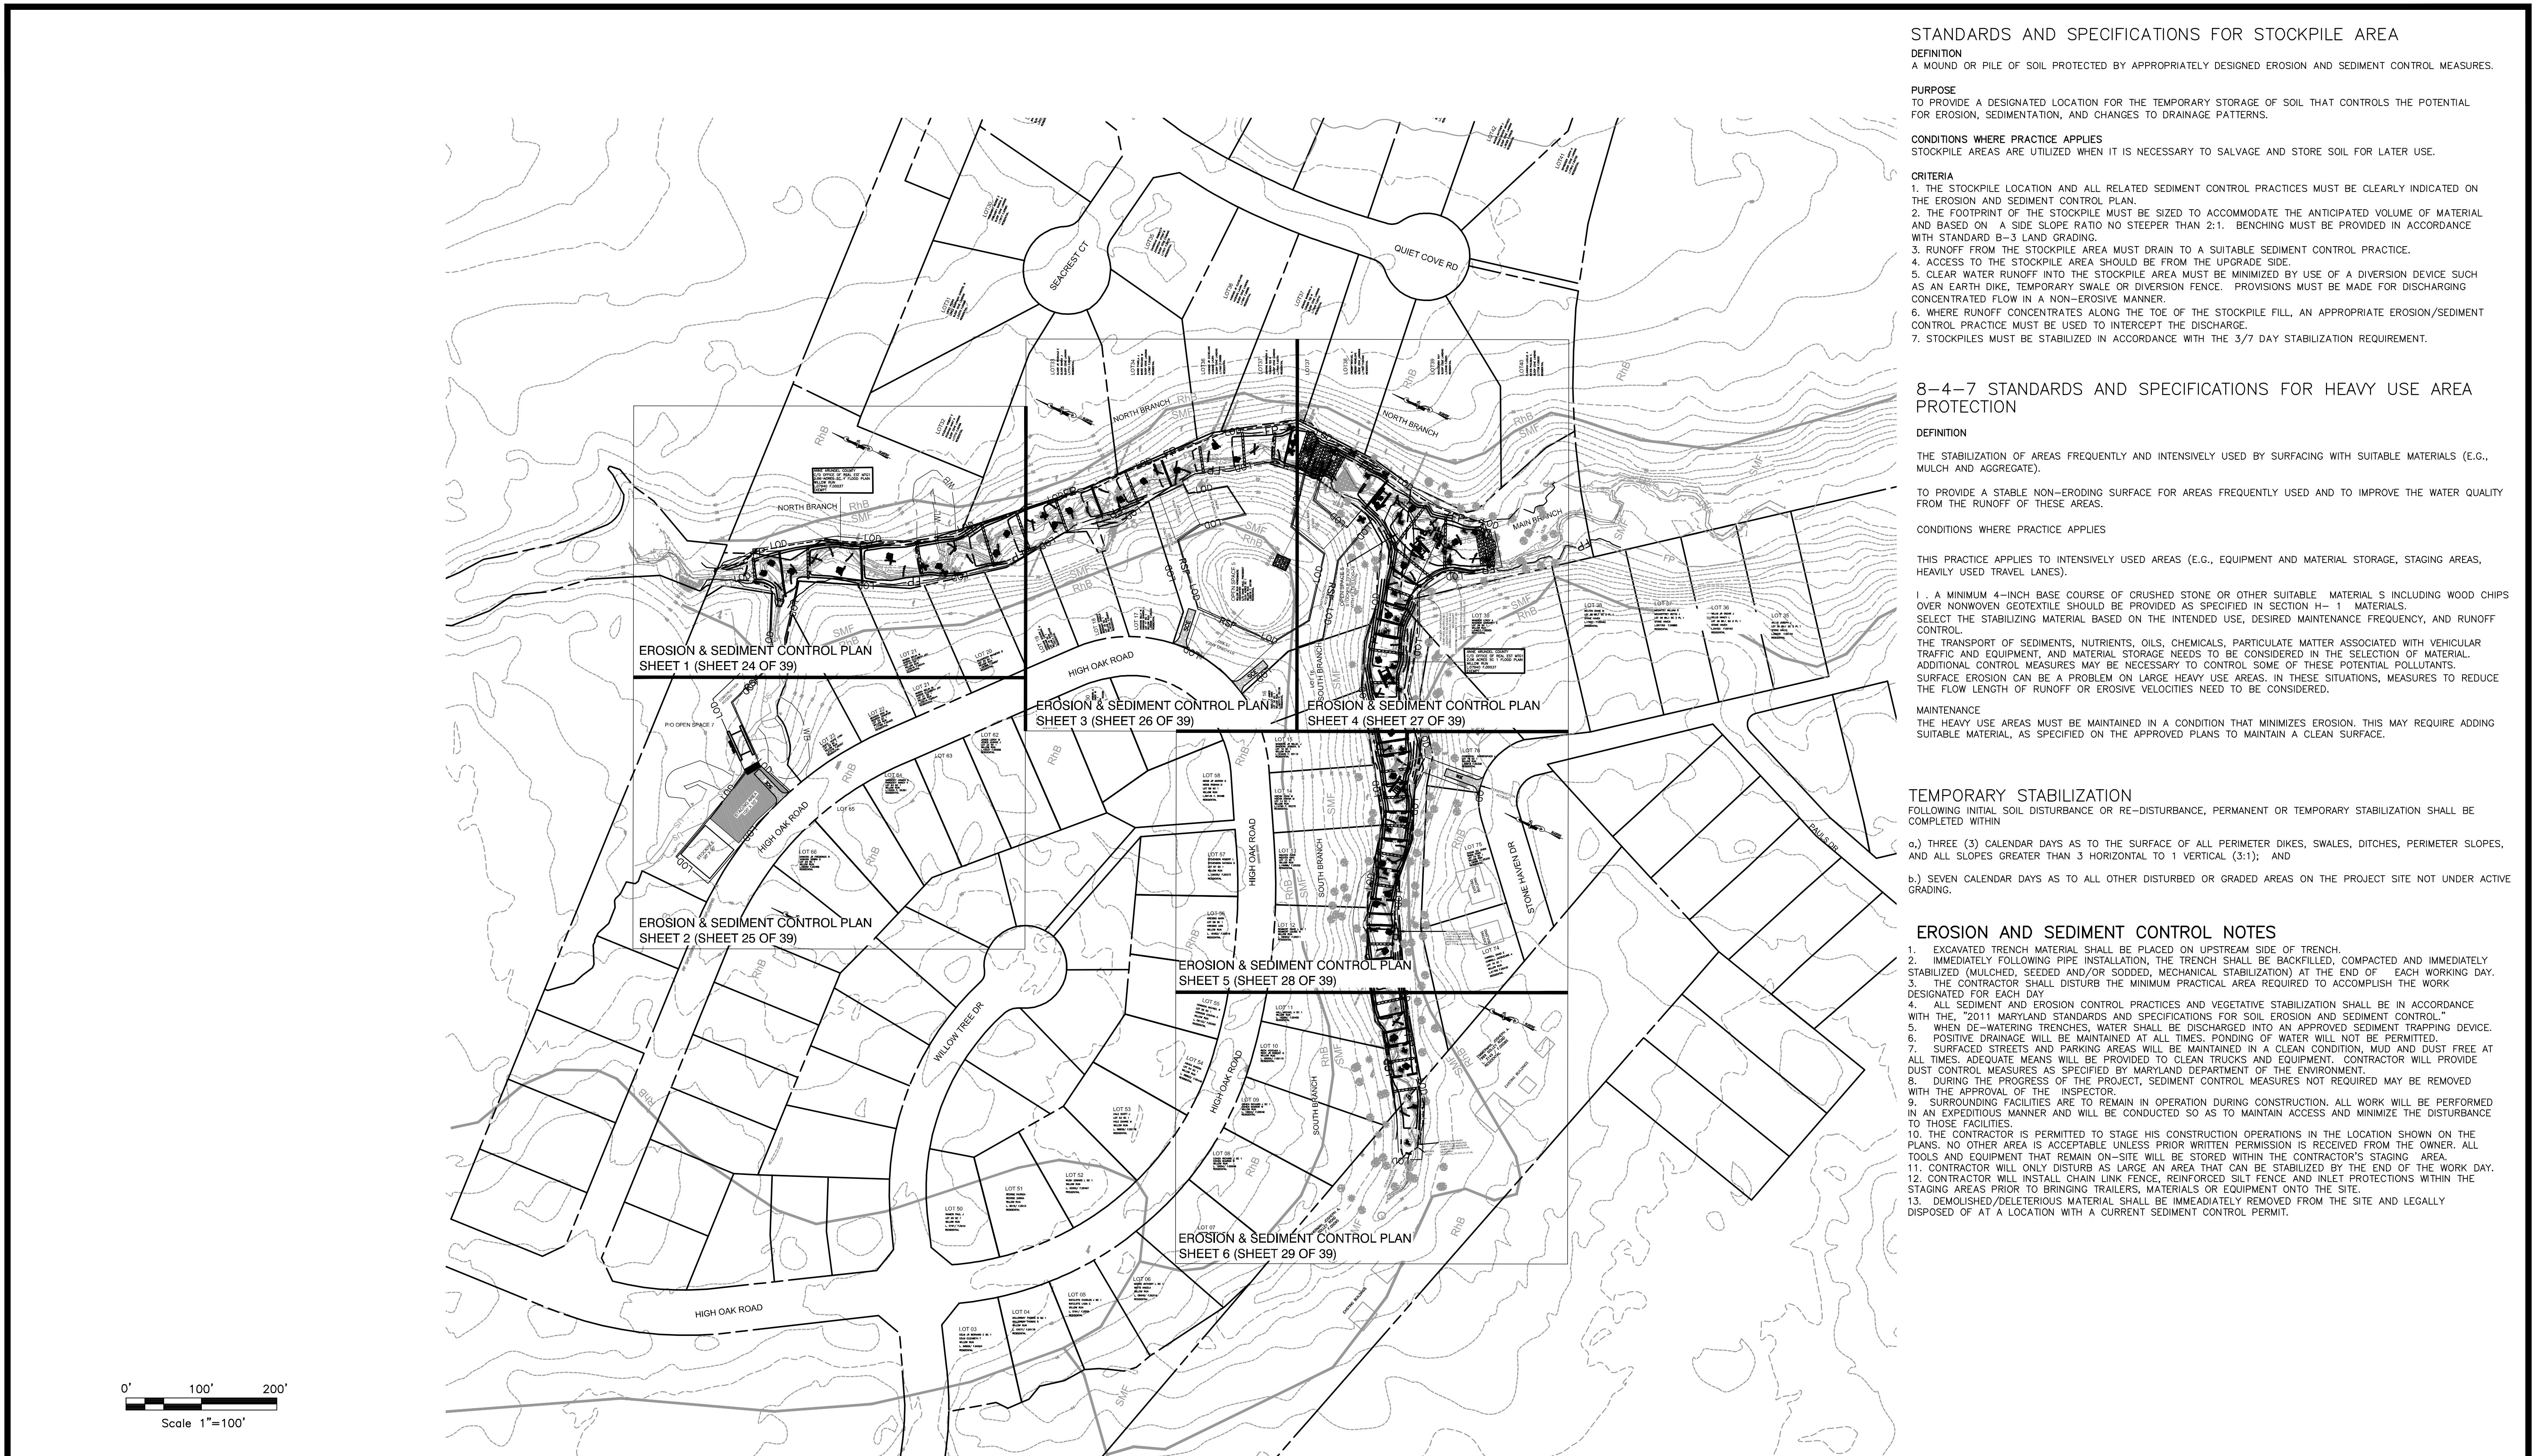

STANDARDS AND SPECIFICATIONS FOR STOCKPILE AREA

DEFINITION
A MOUND OR PILE OF SOIL PROTECTED BY APPROPRIATELY DESIGNED EROSION AND SEDIMENT CONTROL MEASURES.

PURPOSE
TO PROVIDE A DESIGNATED LOCATION FOR THE TEMPORARY STORAGE OF SOIL THAT CONTROLS THE POTENTIAL FOR EROSION, SEDIMENTATION, AND CHANGES TO DRAINAGE PATTERNS.

CONDITIONS WHERE PRACTICE APPLIES
STOCKPILE AREAS ARE UTILIZED WHEN IT IS NECESSARY TO SALVAGE AND STORE SOIL FOR LATER USE.

CRITERIA

1. THE STOCKPILE LOCATION AND ALL RELATED SEDIMENT CONTROL PRACTICES MUST BE CLEARLY INDICATED ON THE EROSION AND SEDIMENT CONTROL PLAN.
2. THE FOOTPRINT OF THE STOCKPILE MUST BE SIZED TO ACCOMMODATE THE ANTICIPATED VOLUME OF MATERIAL AND BASED ON A SIDE SLOPE RATIO NO STEEPER THAN 2:1. BENCHING MUST BE PROVIDED IN ACCORDANCE WITH STANDARD B-3 LAND GRADING.
3. RUNOFF FROM THE STOCKPILE AREA MUST DRAIN TO A SUITABLE SEDIMENT CONTROL PRACTICE.
4. ACCESS TO THE STOCKPILE AREA SHOULD BE FROM THE UPGRADE SIDE.
5. CLEAR WATER RUNOFF INTO THE STOCKPILE AREA MUST BE MINIMIZED BY USE OF A DIVERSION DEVICE SUCH AS AN EARTH DIKE, TEMPORARY SWALE OR DIVERSION FENCE. PROVISIONS MUST BE MADE FOR DISCHARGING CONCENTRATED FLOW IN A NON-EROSIVE MANNER.
6. WHERE RUNOFF CONCENTRATES ALONG THE TOE OF THE STOCKPILE FILL, AN APPROPRIATE EROSION/SEDIMENT CONTROL PRACTICE MUST BE USED TO INTERCEPT THE DISCHARGE.
7. STOCKPILES MUST BE STABILIZED IN ACCORDANCE WITH THE 3/7 DAY STABILIZATION REQUIREMENT.

8-4-7 STANDARDS AND SPECIFICATIONS FOR HEAVY USE AREA PROTECTION

DEFINITION
THE STABILIZATION OF AREAS FREQUENTLY AND INTENSIVELY USED BY SURFACING WITH SUITABLE MATERIALS (E.G., MULCH AND AGGREGATE).

TO PROVIDE A STABLE NON-ERODING SURFACE FOR AREAS FREQUENTLY USED AND TO IMPROVE THE WATER QUALITY FROM THE RUNOFF OF THESE AREAS.

CONDITIONS WHERE PRACTICE APPLIES

THIS PRACTICE APPLIES TO INTENSIVELY USED AREAS (E.G., EQUIPMENT AND MATERIAL STORAGE, STAGING AREAS, HEAVILY USED TRAVEL LANES).

1. A MINIMUM 4-INCH BASE COURSE OF CRUSHED STONE OR OTHER SUITABLE MATERIALS INCLUDING WOOD CHIPS OVER NON-WOVEN GEOTEXTILE SHOULD BE PROVIDED AS SPECIFIED IN SECTION H-1 MATERIALS.
SELECT THE STABILIZING MATERIAL BASED ON THE INTENDED USE, DESIRED MAINTENANCE FREQUENCY, AND RUNOFF CONTROL.
THE TRANSPORT OF SEDIMENTS, NUTRIENTS, OILS, CHEMICALS, PARTICULATE MATTER ASSOCIATED WITH VEHICULAR TRAFFIC AND EQUIPMENT, AND MATERIAL STORAGE NEEDS TO BE CONSIDERED IN THE SELECTION OF MATERIAL.
ADDITIONAL CONTROL MEASURES MAY BE NECESSARY TO CONTROL SOME OF THESE POTENTIAL POLLUTANTS.
SURFACE EROSION CAN BE A PROBLEM ON LARGE HEAVY USE AREAS. IN THESE SITUATIONS, MEASURES TO REDUCE THE FLOW LENGTH OF RUNOFF OR EROSION VELOCITIES NEED TO BE CONSIDERED.

Maintenance
THE HEAVY USE AREAS MUST BE MAINTAINED IN A CONDITION THAT MINIMIZES EROSION. THIS MAY REQUIRE ADDING SUITABLE MATERIAL, AS SPECIFIED ON THE APPROVED PLANS TO MAINTAIN A CLEAN SURFACE.

TEMPORARY STABILIZATION

FOLLOWING INITIAL SOIL DISTURBANCE OR RE-DISTURBANCE, PERMANENT OR TEMPORARY STABILIZATION SHALL BE COMPLETED WITHIN


- a.) THREE (3) CALENDAR DAYS AS TO THE SURFACE OF ALL PERIMETER DIKES, SWALES, DITCHES, PERIMETER SLOPES, AND ALL SLOPES GREATER THAN 3 HORIZONTAL TO 1 VERTICAL (3:1); AND
- b.) SEVEN CALENDAR DAYS AS TO ALL OTHER DISTURBED OR GRADED AREAS ON THE PROJECT SITE NOT UNDER ACTIVE GRADING.

EROSION AND SEDIMENT CONTROL NOTES

1. EXCAVATED TRENCH MATERIAL SHALL BE PLACED ON UPSTREAM SIDE OF TRENCH.
2. IMMEDIATELY FOLLOWING PIPE INSTALLATION, THE TRENCH SHALL BE BACKFILLED, COMPACTED AND IMMEDIATELY STABILIZED (MULCHED, SEEDED AND/OR SODDED, MECHANICAL STABILIZATION) AT THE END OF EACH WORKING DAY.
3. THE CONTRACTOR SHALL DISTURB THE MINIMUM PRACTICAL AREA REQUIRED TO ACCOMPLISH THE WORK DESIGNATED FOR EACH DAY.
4. ALL SEDIMENT AND EROSION CONTROL PRACTICES AND VEGETATIVE STABILIZATION SHALL BE IN ACCORDANCE WITH THE "2011 MARYLAND STANDARDS AND SPECIFICATIONS FOR SOIL EROSION AND SEDIMENT CONTROL."
5. WHEN CONSTRUCTION TRENCHES AND WATER SHALLOWS ARE PRESENT, APPROVED DIVERSION DEVICE.
6. POSITIVE DRAINAGE WILL BE MAINTAINED AT ALL TIMES. FLOODING OF WATER SHALL NOT BE PERMITTED.
7. SURFACED STREETS AND PARKING AREAS WILL BE MAINTAINED IN A CLEAN CONDITION, MUD AND DUST FREE AT ALL TIMES. ADEQUATE MEANS WILL BE PROVIDED TO CLEAN TRUCKS AND EQUIPMENT. CONTRACTOR WILL PROVIDE DUST CONTROL MEASURES AS SPECIFIED BY MARYLAND DEPARTMENT OF THE ENVIRONMENT.
8. DURING THE PROGRESS OF THE PROJECT, SEDIMENT CONTROL MEASURES NOT REQUIRED MAY BE REMOVED WITH THE APPROVAL OF THE INSPECTOR.
9. SURROUNDING FACILITIES ARE TO REMAIN IN OPERATION DURING CONSTRUCTION. ALL WORK WILL BE PERFORMED IN AN EXCERPTED MANNER AND WILL BE CONDUCTED SO AS TO MAINTAIN ACCESS AND MINIMIZE THE DISTURBANCE TO THOSE FACILITIES.
10. THE CONTRACTOR IS PERMITTED TO STAGE HIS CONSTRUCTION OPERATIONS IN THE LOCATION SHOWN ON THE PLANS. NO OTHER AREA IS ACCEPTABLE UNLESS PRIOR WRITTEN PERMISSION IS RECEIVED FROM THE OWNER. ALL TOOLS AND EQUIPMENT THAT REMAIN ON-SITE WILL BE STORED WITHIN THE CONTRACTOR'S STAGING AREA.
11. CONTRACTOR WILL ONLY DISTURB AS LARGE AN AREA THAT CAN BE STABILIZED BY THE END OF THE WORK DAY.
12. CONTRACTOR WILL INSTALL CHAIN LINK FENCE, REINFORCED SILT FENCE AND INLET PROTECTIONS WITHIN THE STAGING AREAS PRIOR TO BRINGING TRAILERS, MATERIALS OR EQUIPMENT ONTO THE SITE.
13. DEMOLISHED/DELETERIOUS MATERIAL SHALL BE IMMEDIATELY REMOVED FROM THE SITE AND LEGALLY DISPOSED OF AT A LOCATION WITH A CURRENT SEDIMENT CONTROL PERMIT.



OWNER/DEVELOPER/APPLICANT	CIVIL ENGINEER A.A. County ID #721	REVISIONS	ANNE ARUNDEL COUNTY			
717-627-4440 fax: 717-627-4660 landstudies.com 315 North Street Lititz, PA 17543	Dewberry 2101 Gaither Road Suite #340 Rockville, MD 20850 Contact: Joanne M. Cheek, Senior Associate Phone: (301) 337-2856 Fax: (301) 258-7607	NO Description BY DATE	DEPARTMENT OF PUBLIC WORKS	STREAM RESTORATION PLAN	EROSION & SEDIMENT CONTROL PLAN OVERVIEW	SLOOP COVE RETROFIT SITE 1
		APPROVED DATE APPROVED DATE	As Shown	DRAWN BY: Bill /R. Anchors		
		CHIEF ENGINEER PROJECT MANAGER		CHECKED BY: J. Cheek		
		APPROVED DATE APPROVED DATE		SHEET NO: 23 OF 39	PROJECT NO: 50017963	
		ASSISTANT CHIEF ENGINEER CHIEF, RIGHT OF WAY		PROPOSAL NO:		
					3rd District	Tax Map 16 Grid 05
						Anne Arundel County

MATCHLINE SHEET 3 (SHEET 26 OF 39)

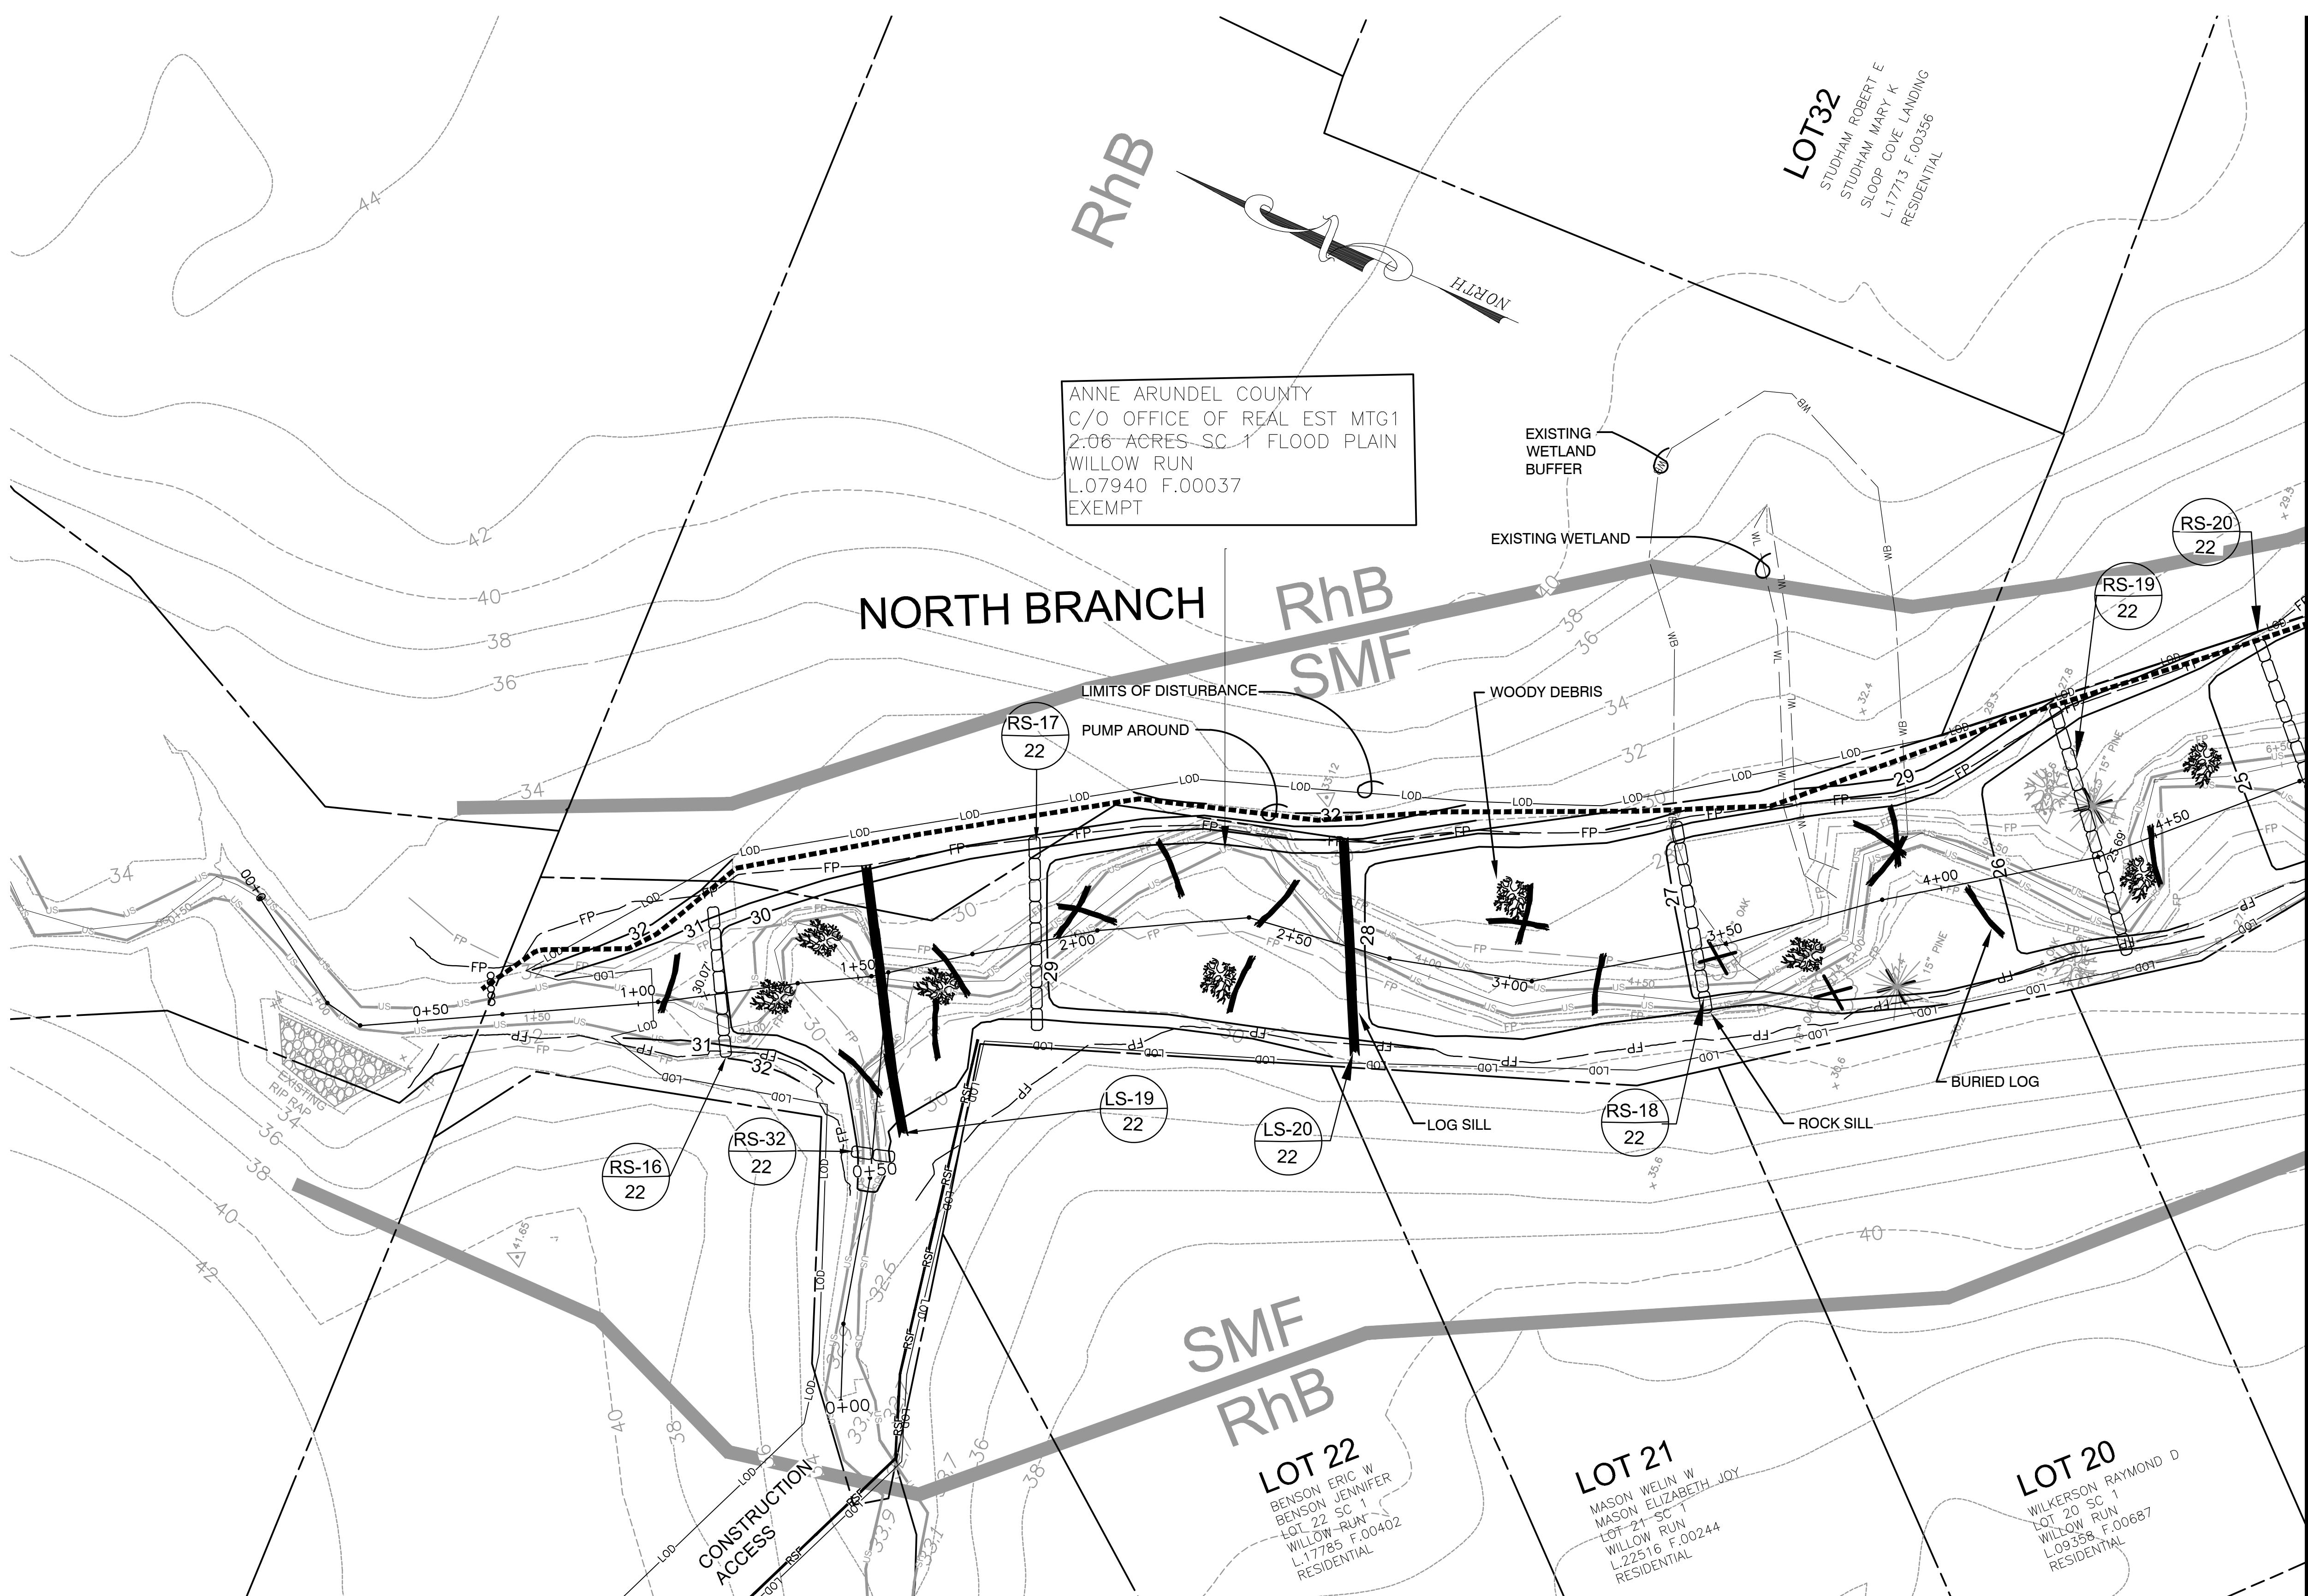


0' 20' 40'

SCALE 1"=20'

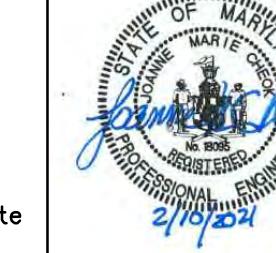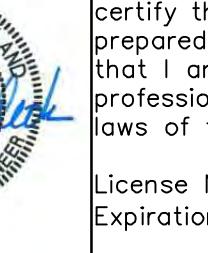OWNER/DEVELOPER/APPLICANT		CIVIL ENGINEER A.A. County ID #721		REVISIONS		ANNE ARUNDEL COUNTY							
				NO	Description	BY	DATE	DEPARTMENT OF PUBLIC WORKS				STREAM RESTORATION PLAN	
717-627-4440 fax: 717-627-4660 landstudies.com 315 North Street Lititz, PA 17543	 Dewberry 2101 Gaither Road Suite #340 Rockville, MD 20850 Contact: Joanne M. Cheek, Senior Associate Phone: (301) 337-2856 Fax: (301) 258-7607			2/29/2024	Professional Certification: I hereby certify that these documents were prepared or approved by me, and that I am a duly licensed professional engineer under the laws of the State of Maryland, License No. 18095, Expiration Date: 12/21/2022.			APPROVED	DATE	APPROVED	DATE	SCALE: As Shown	EROSION & SEDIMENT CONTROL PLAN 1
								CHIEF ENGINEER		PROJECT MANAGER		DRAWN BY: Buff/R. Anchors	SLOOP COVE RETROFIT SITE 1
								APPROVED	DATE	APPROVED	DATE	CHECKED BY: J. Cheek	Tax Map 16 Grid 05
								ASSISTANT CHIEF ENGINEER		CHIEF, RIGHT OF WAY		PROPOSAL NO: 50017963	Anne Arundel County
												3rd District	

MATCHLINE SHEET 1 (SHEET 24 OF 39)


MATCHLINE SHEET 3 (SHEET 26 OF 39)

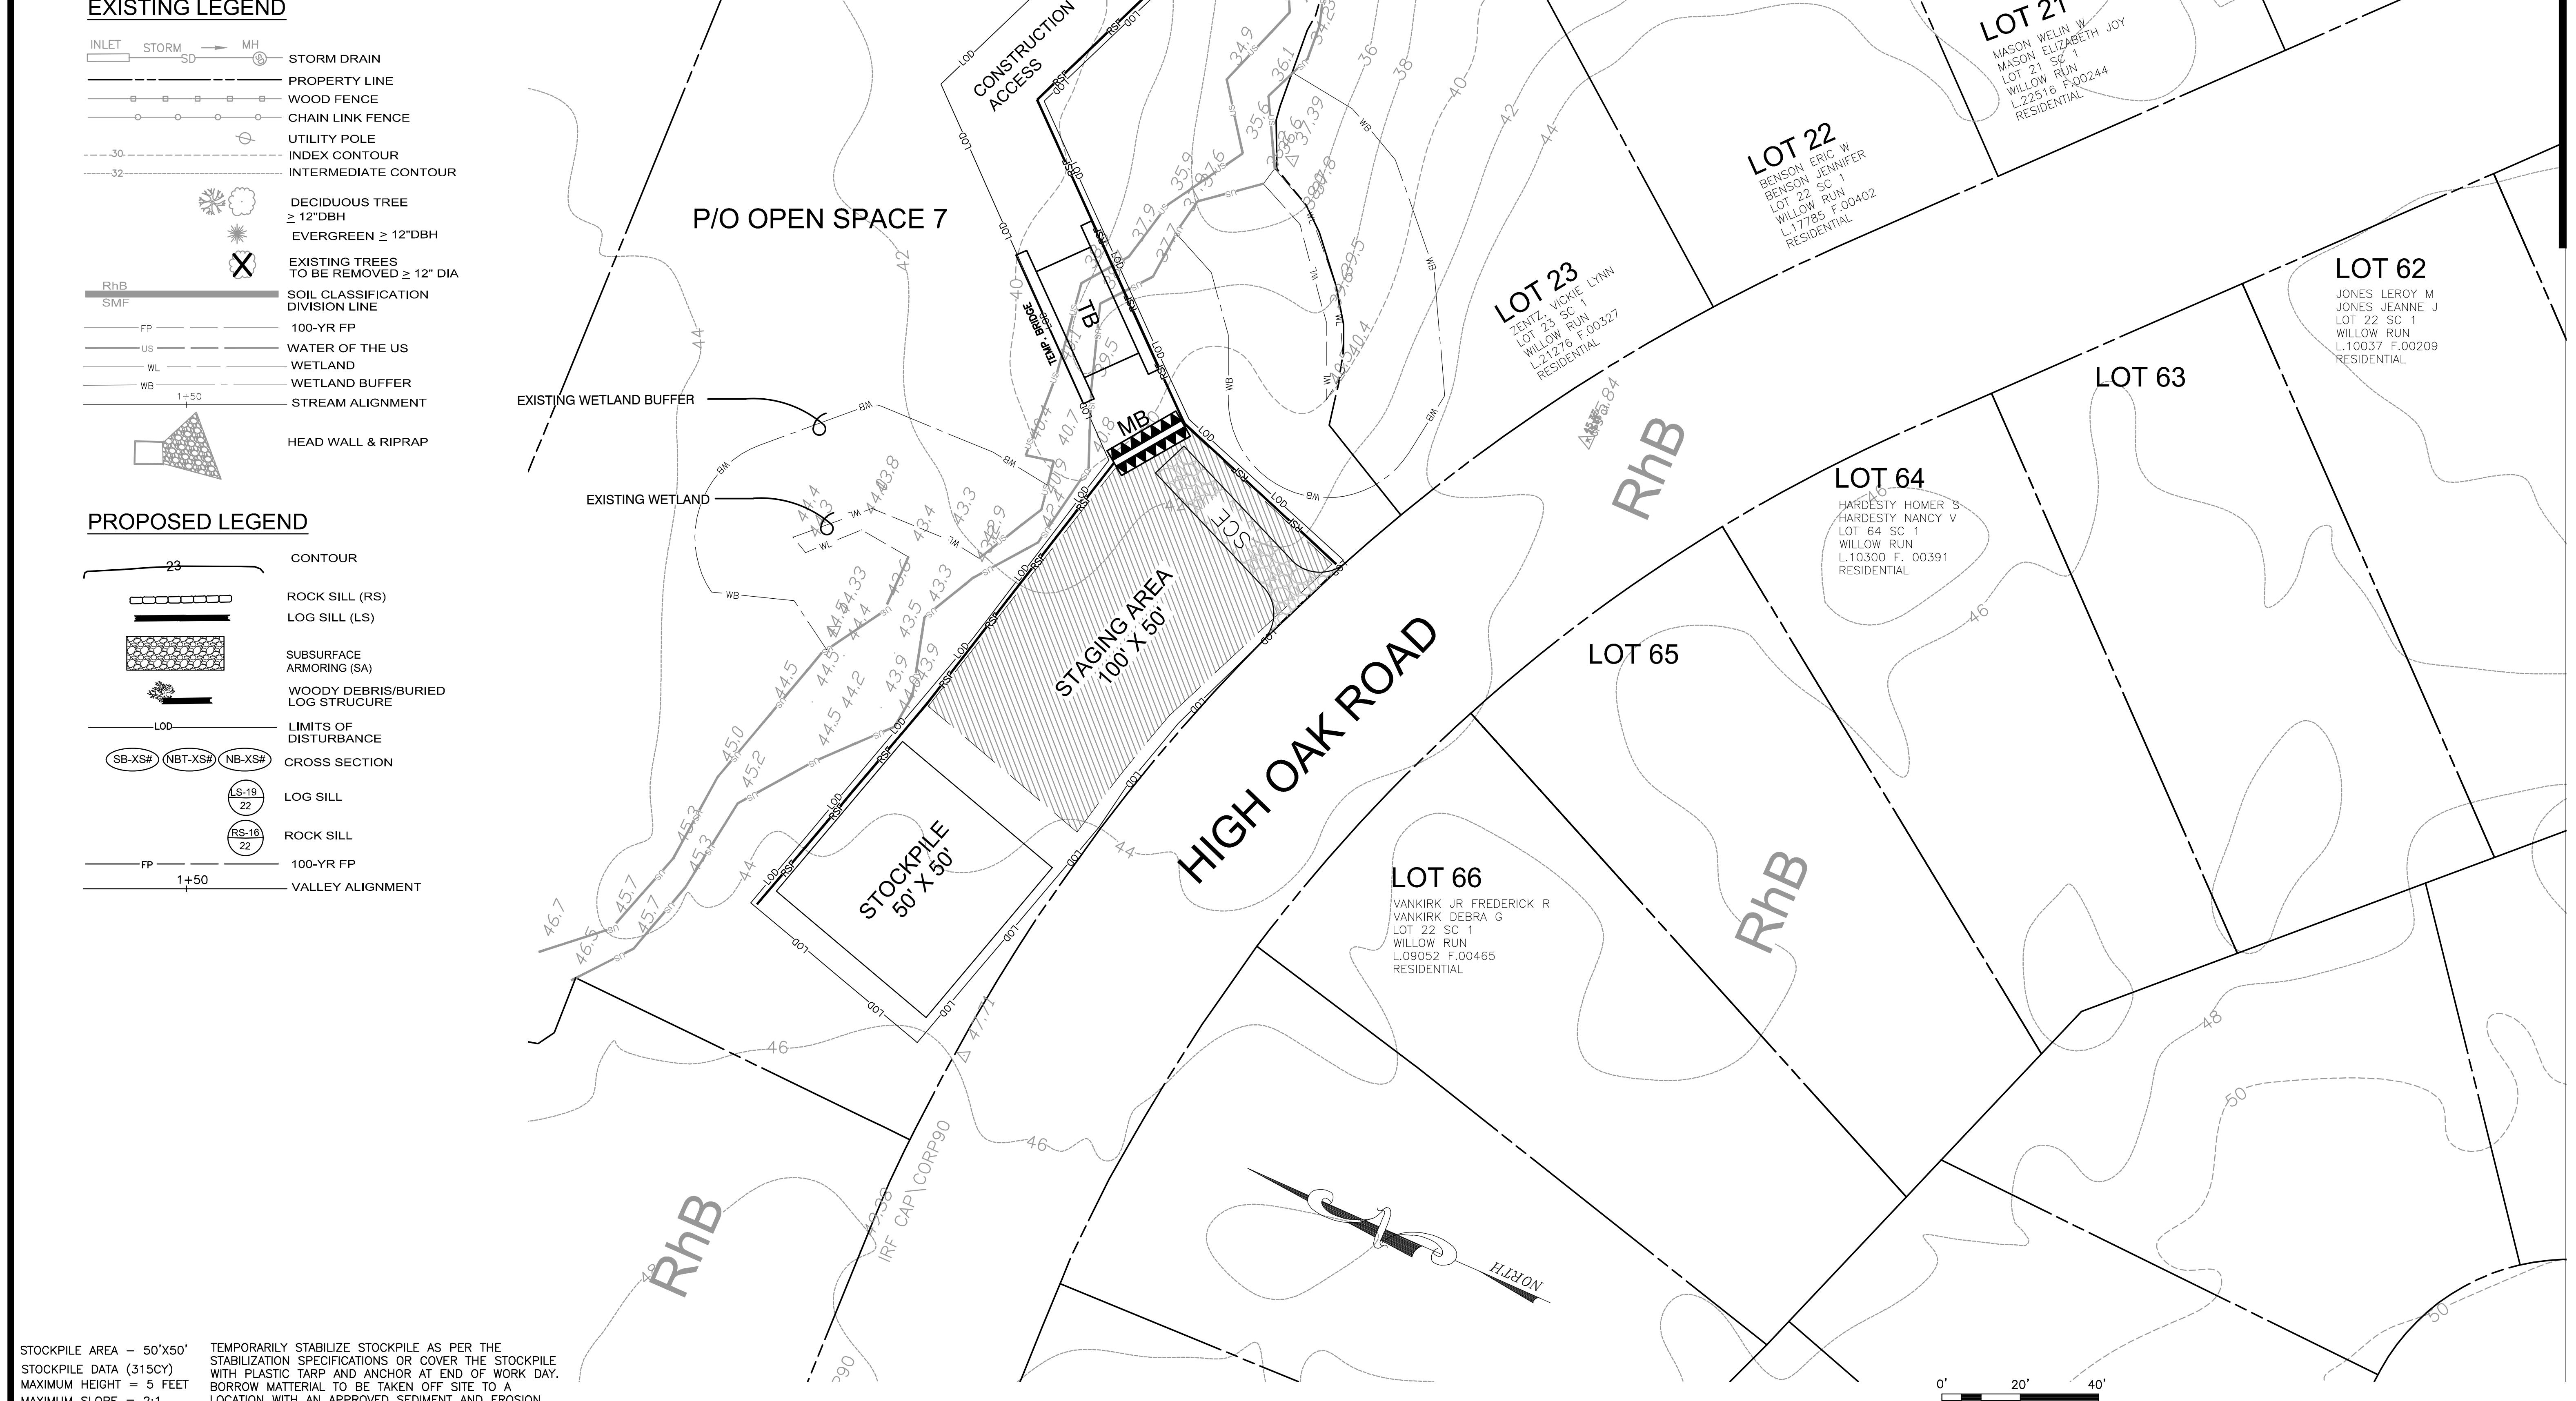


OWNER/DEVELOPER/APPLICANT		CIVIL ENGINEER A.A. County ID #721		REVISIONS				ANNE ARUNDEL COUNTY					
717-627-4440 fax: 717-627-4660 landstudies.com 315 North Street Lititz, PA 17543		2101 Gaither Road Suite #340 Rockville, MD 20850		Professional Certification: I hereby certify that these documents were prepared or approved by me, and that I am a duly licensed professional engineer under the laws of the State of Maryland, License No. 18095, Expiration Date: 12/21/2022.	NO	Description	BY	DATE	DEPARTMENT OF PUBLIC WORKS				
					APPROVED	DATE	APPROVED	DATE	STREAM RESTORATION PLAN				
EROSION & SEDIMENT CONTROL PLAN 2										SLOOP COVE RETROFIT SITE 1			
3rd District										Tax Map 16 Grid 05			
Anne Arundel County													

MATCHLINE SHEET 1 (SHEET 24 OF 39)

EXISTING LEGEND

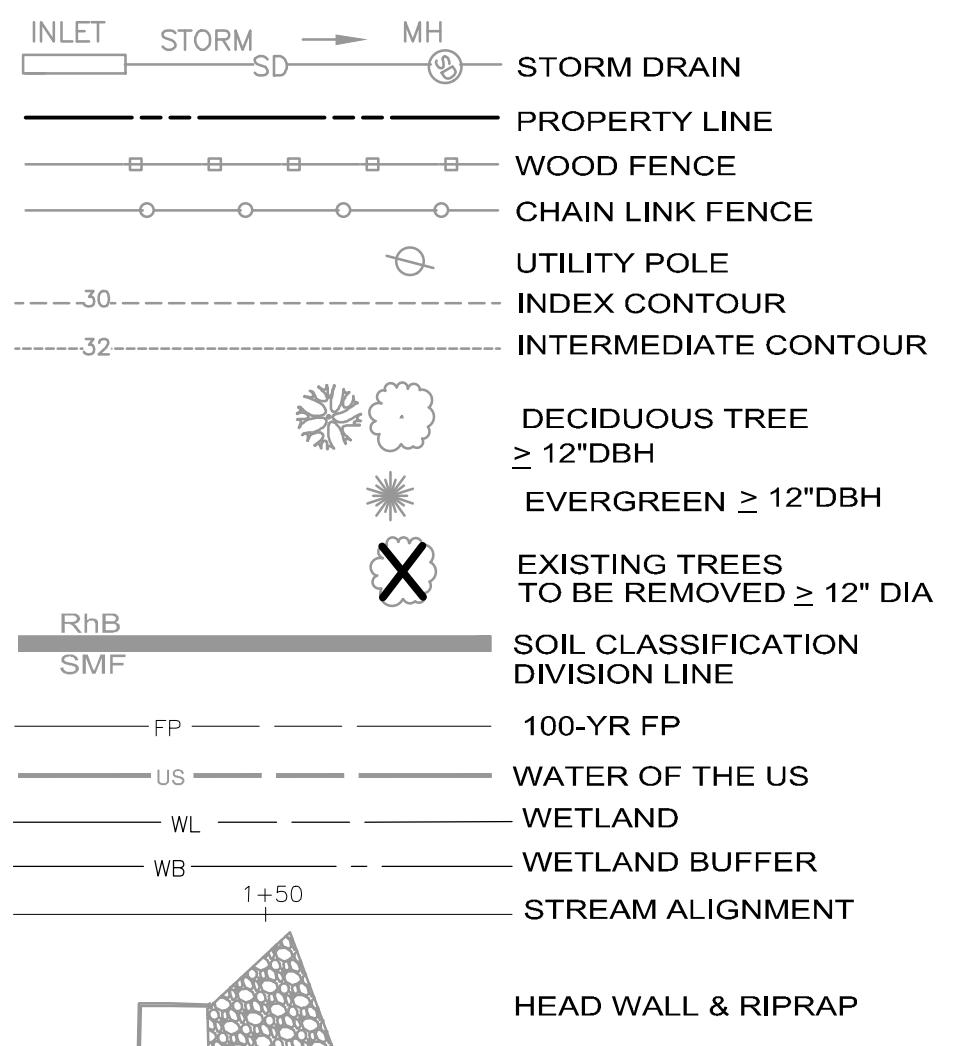


PROPOSED LEGEND

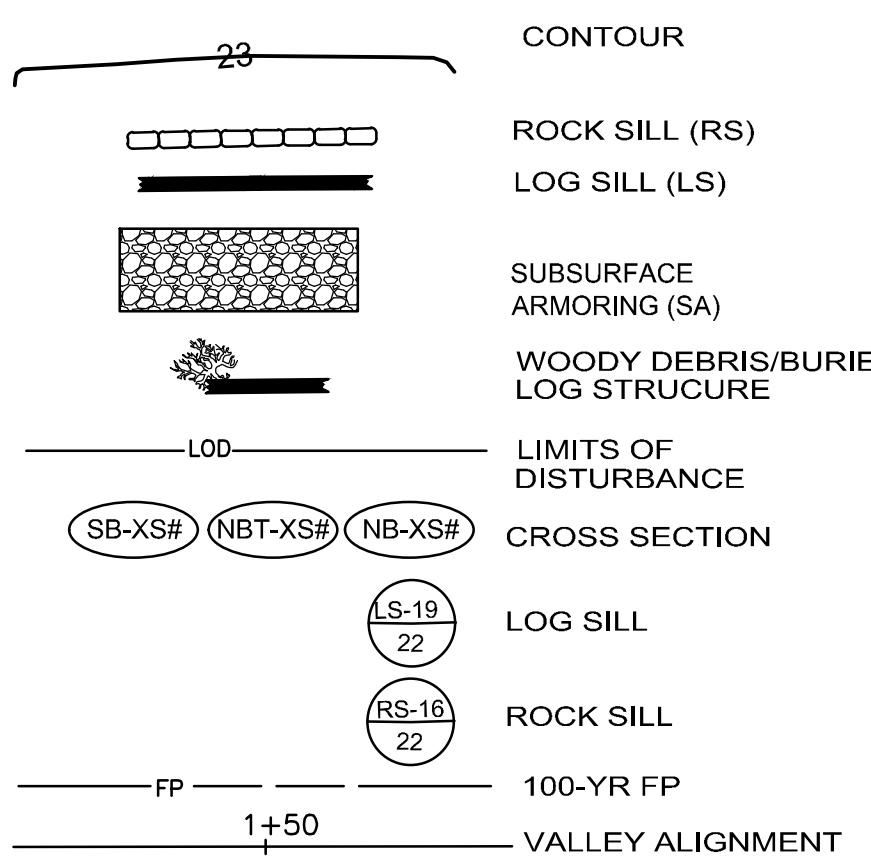

MATCHLINE SHEET 5 (SHEET 28 OF 39)

TEMPORARILY STABILIZE STOCKPILE AS PER THE STABILIZATION SPECIFICATIONS OR COVER THE STOCKPILE WITH PLASTIC TARP AND ANCHOR AT END OF WORK DAY. BORROW MATERIAL TO BE TAKEN OFF SITE TO A LOCATION WITH AN APPROVED SEDIMENT AND EROSION CONTROL PLAN.


STOCKPILE AREA - 60'x40'
STOCKPILE DATA (200CY)
MAXIMUM HEIGHT = 5 FEET
MAXIMUM SLOPE = 2:1

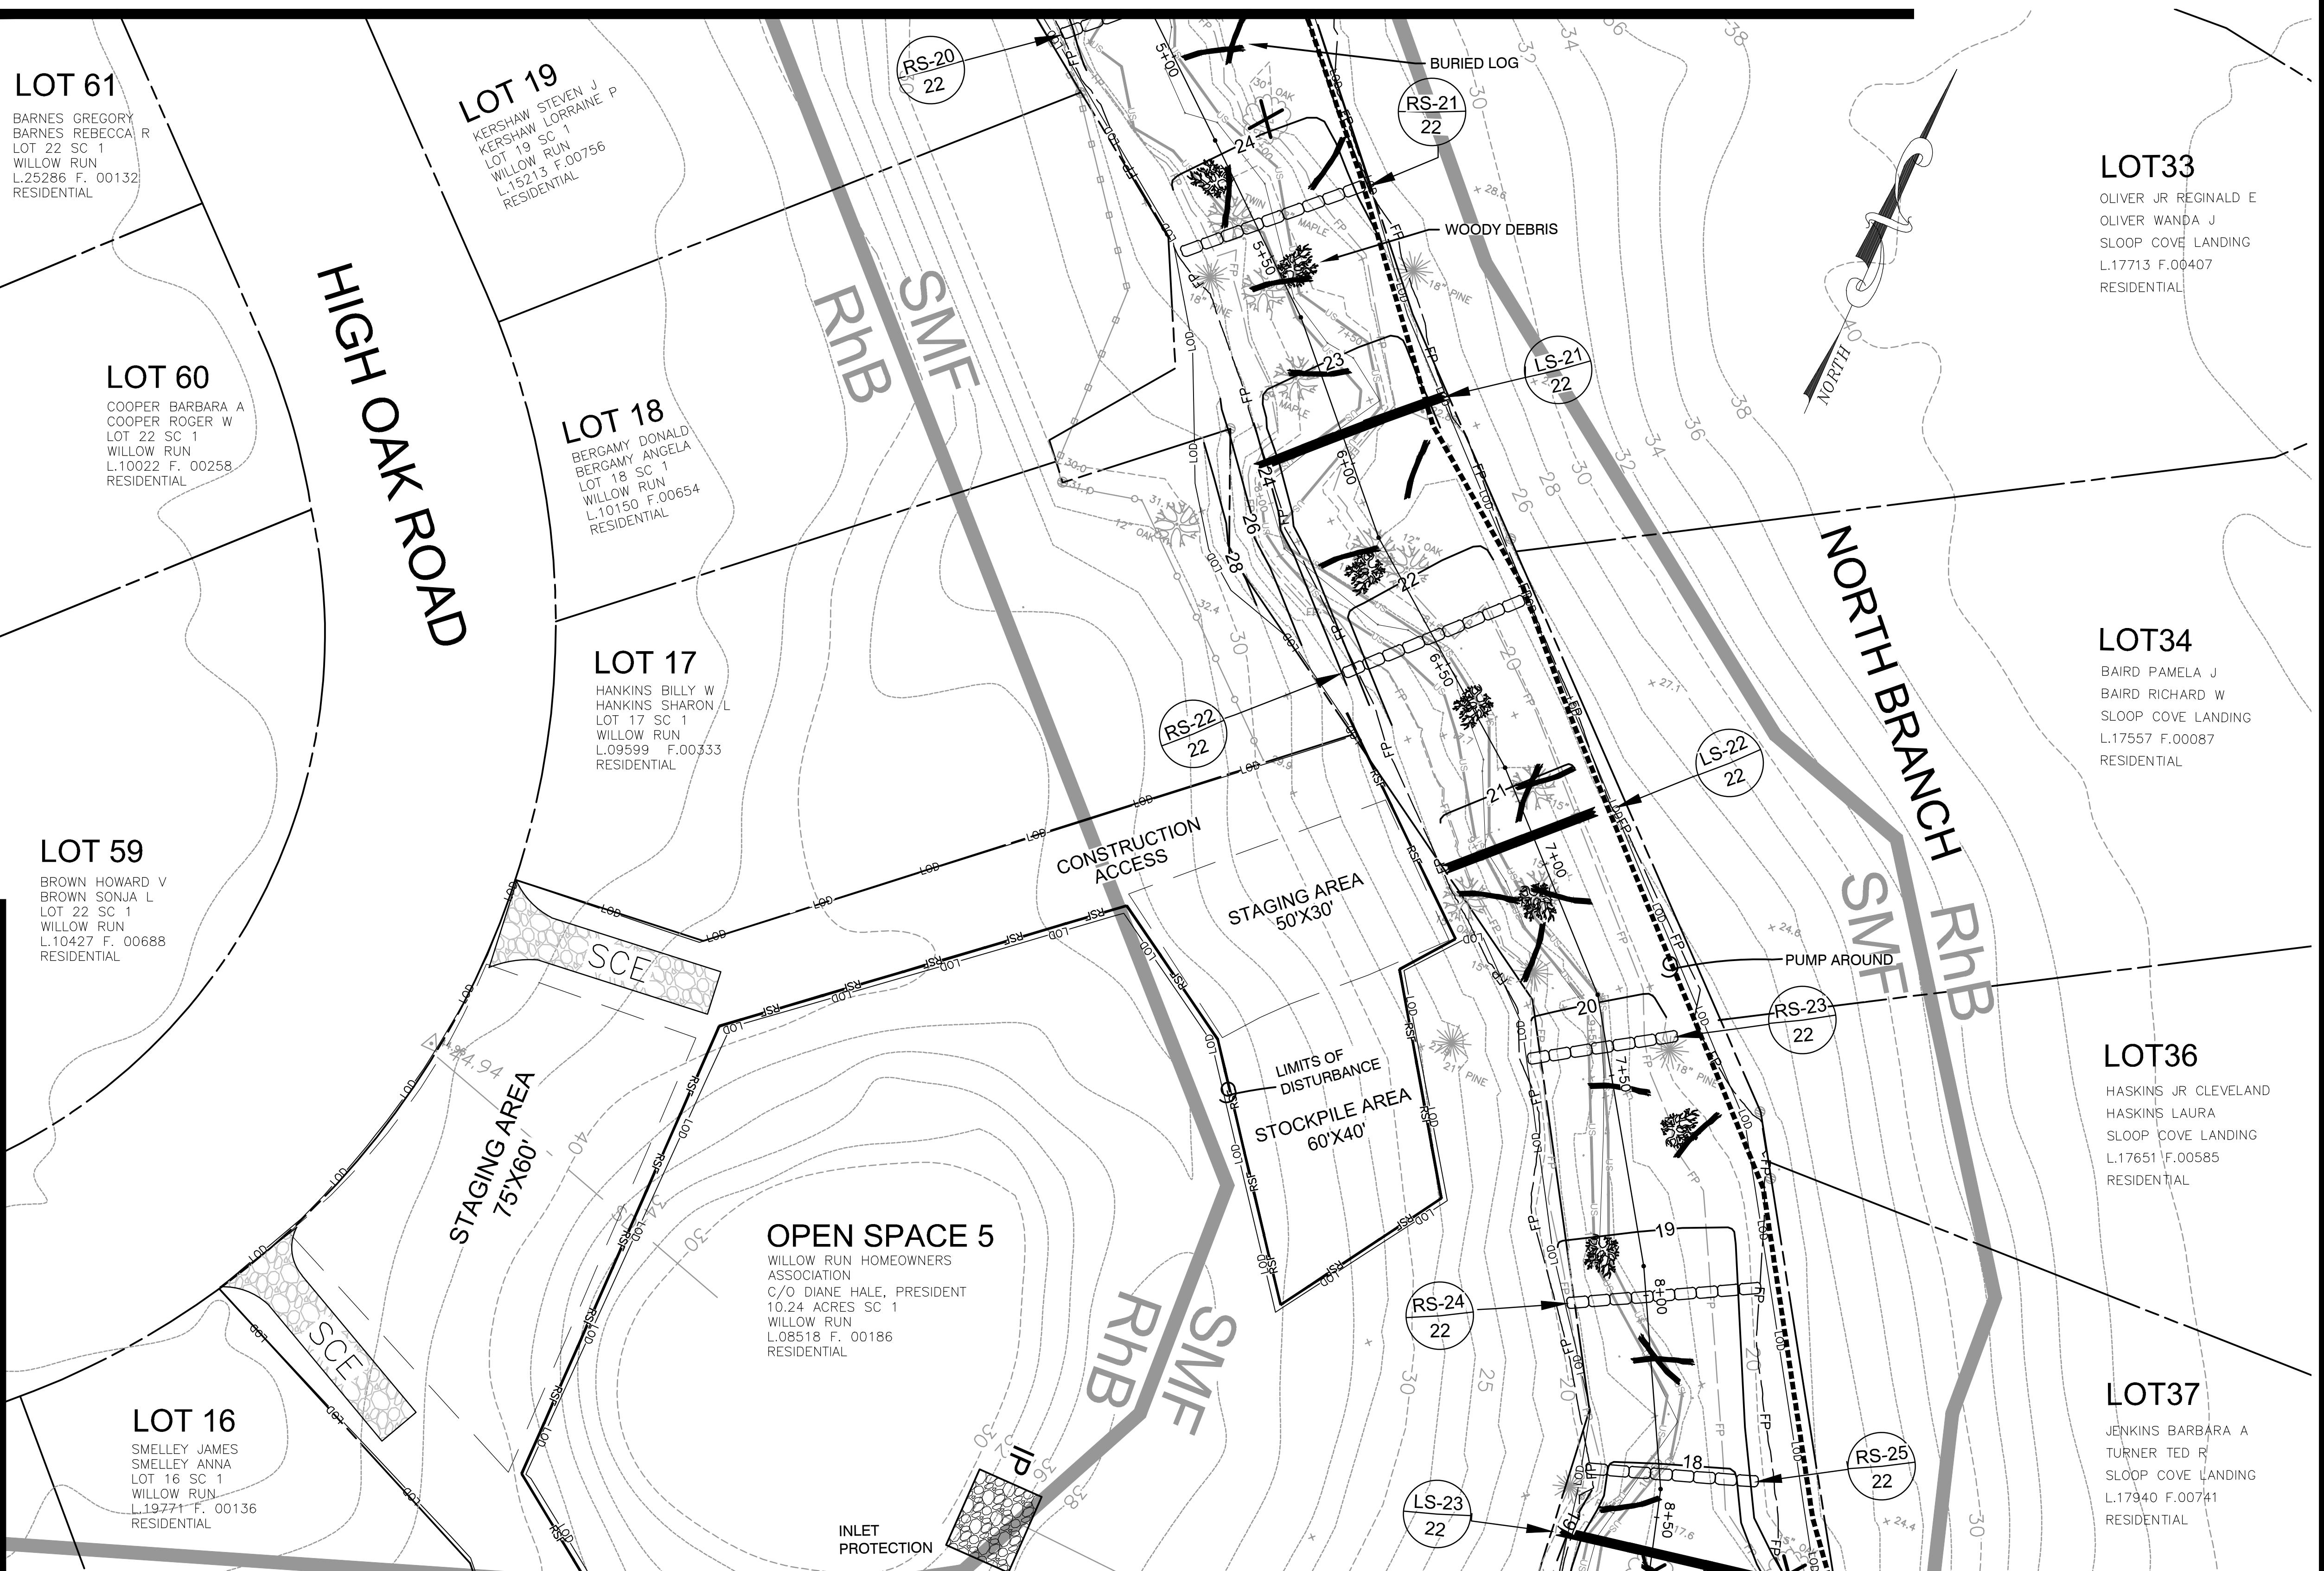

MATCHLINE SHEET 4 (SHEET 27 OF 39)

OWNER/DEVELOPER/APPLICANT	CIVIL ENGINEER
717-627-4440 fax: 717-627-4660 landstudies.com 315 North Street Lititz, PA 17543	A.A. County ID #721

Dewberry
2101 Gaither Road Suite #340 Rockville, MD 20850 Contact: Joanne M. Cheek, Senior Associate Phone: (301) 337-2856 Fax: (301) 258-7607

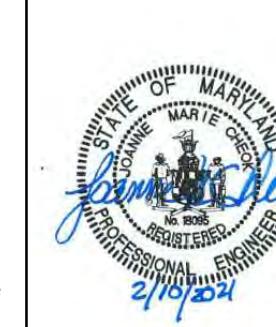

Professional Certification: I hereby certify that these documents were prepared or approved by me, and that I am a duly licensed professional engineer under the laws of the State of Maryland, License No. 18095, Expiration Date: 12/21/2022.

REVISIONS			
NO	Description	BY	DATE
	APPROVED	DATE	APPROVED DATE
	CHIEF ENGINEER		
	APPROVED	DATE	APPROVED DATE
	PROJECT MANAGER		
	ASSISTANT CHIEF ENGINEER		
	CHIEF, RIGHT OF WAY		

ANNE ARUNDEL COUNTY			
DEPARTMENT OF PUBLIC WORKS			
STREAM RESTORATION PLAN			

EROSION & SEDIMENT CONTROL PLAN 3
SLOOP COVE RETROFIT SITE 1
3rd District
Tax Map 16 Grid 05
Anne Arundel County


EXISTING LEGEND

INLET	STORM	SD	MH
STORM DRAIN			
PROPERTY LINE			
WOOD FENCE			
CHAIN LINK FENCE			
UTILITY POLE			
INDEX CONTOUR			
INTERMEDIATE CONTOUR			
DECIDUOUS TREE ≥ 12" DBH			
EVERGREEN ≥ 12" DBH			
X			
EXISTING TREES TO BE REMOVED ≥ 12" DIA			
SOIL CLASSIFICATION DIVISION LINE			
100-YR FP			
WATER OF THE US			
WETLAND			
WETLAND BUFFER			
STREAM ALIGNMENT			
HEAD WALL & RIPRAP			


PROPOSED LEGEND

CONTOUR	
ROCK SILL (RS)	
LOG SILL (LS)	
SUBSURFACE ARMORING (SA)	
WOODY DEBRIS/BURIED LOG STRUCTURE	
LOD	
LIMITS OF DISTURBANCE	
(SB-XS#) (NBT-XS#) (NB-XS#)	CROSS SECTION
LS-19 22	LOG SILL
RS-16 22	ROCK SILL
FP 1+50	100-YR FP
	VALLEY ALIGNMENT

MATCHLINE SHEET 3 (SHEET 26 OF 39)

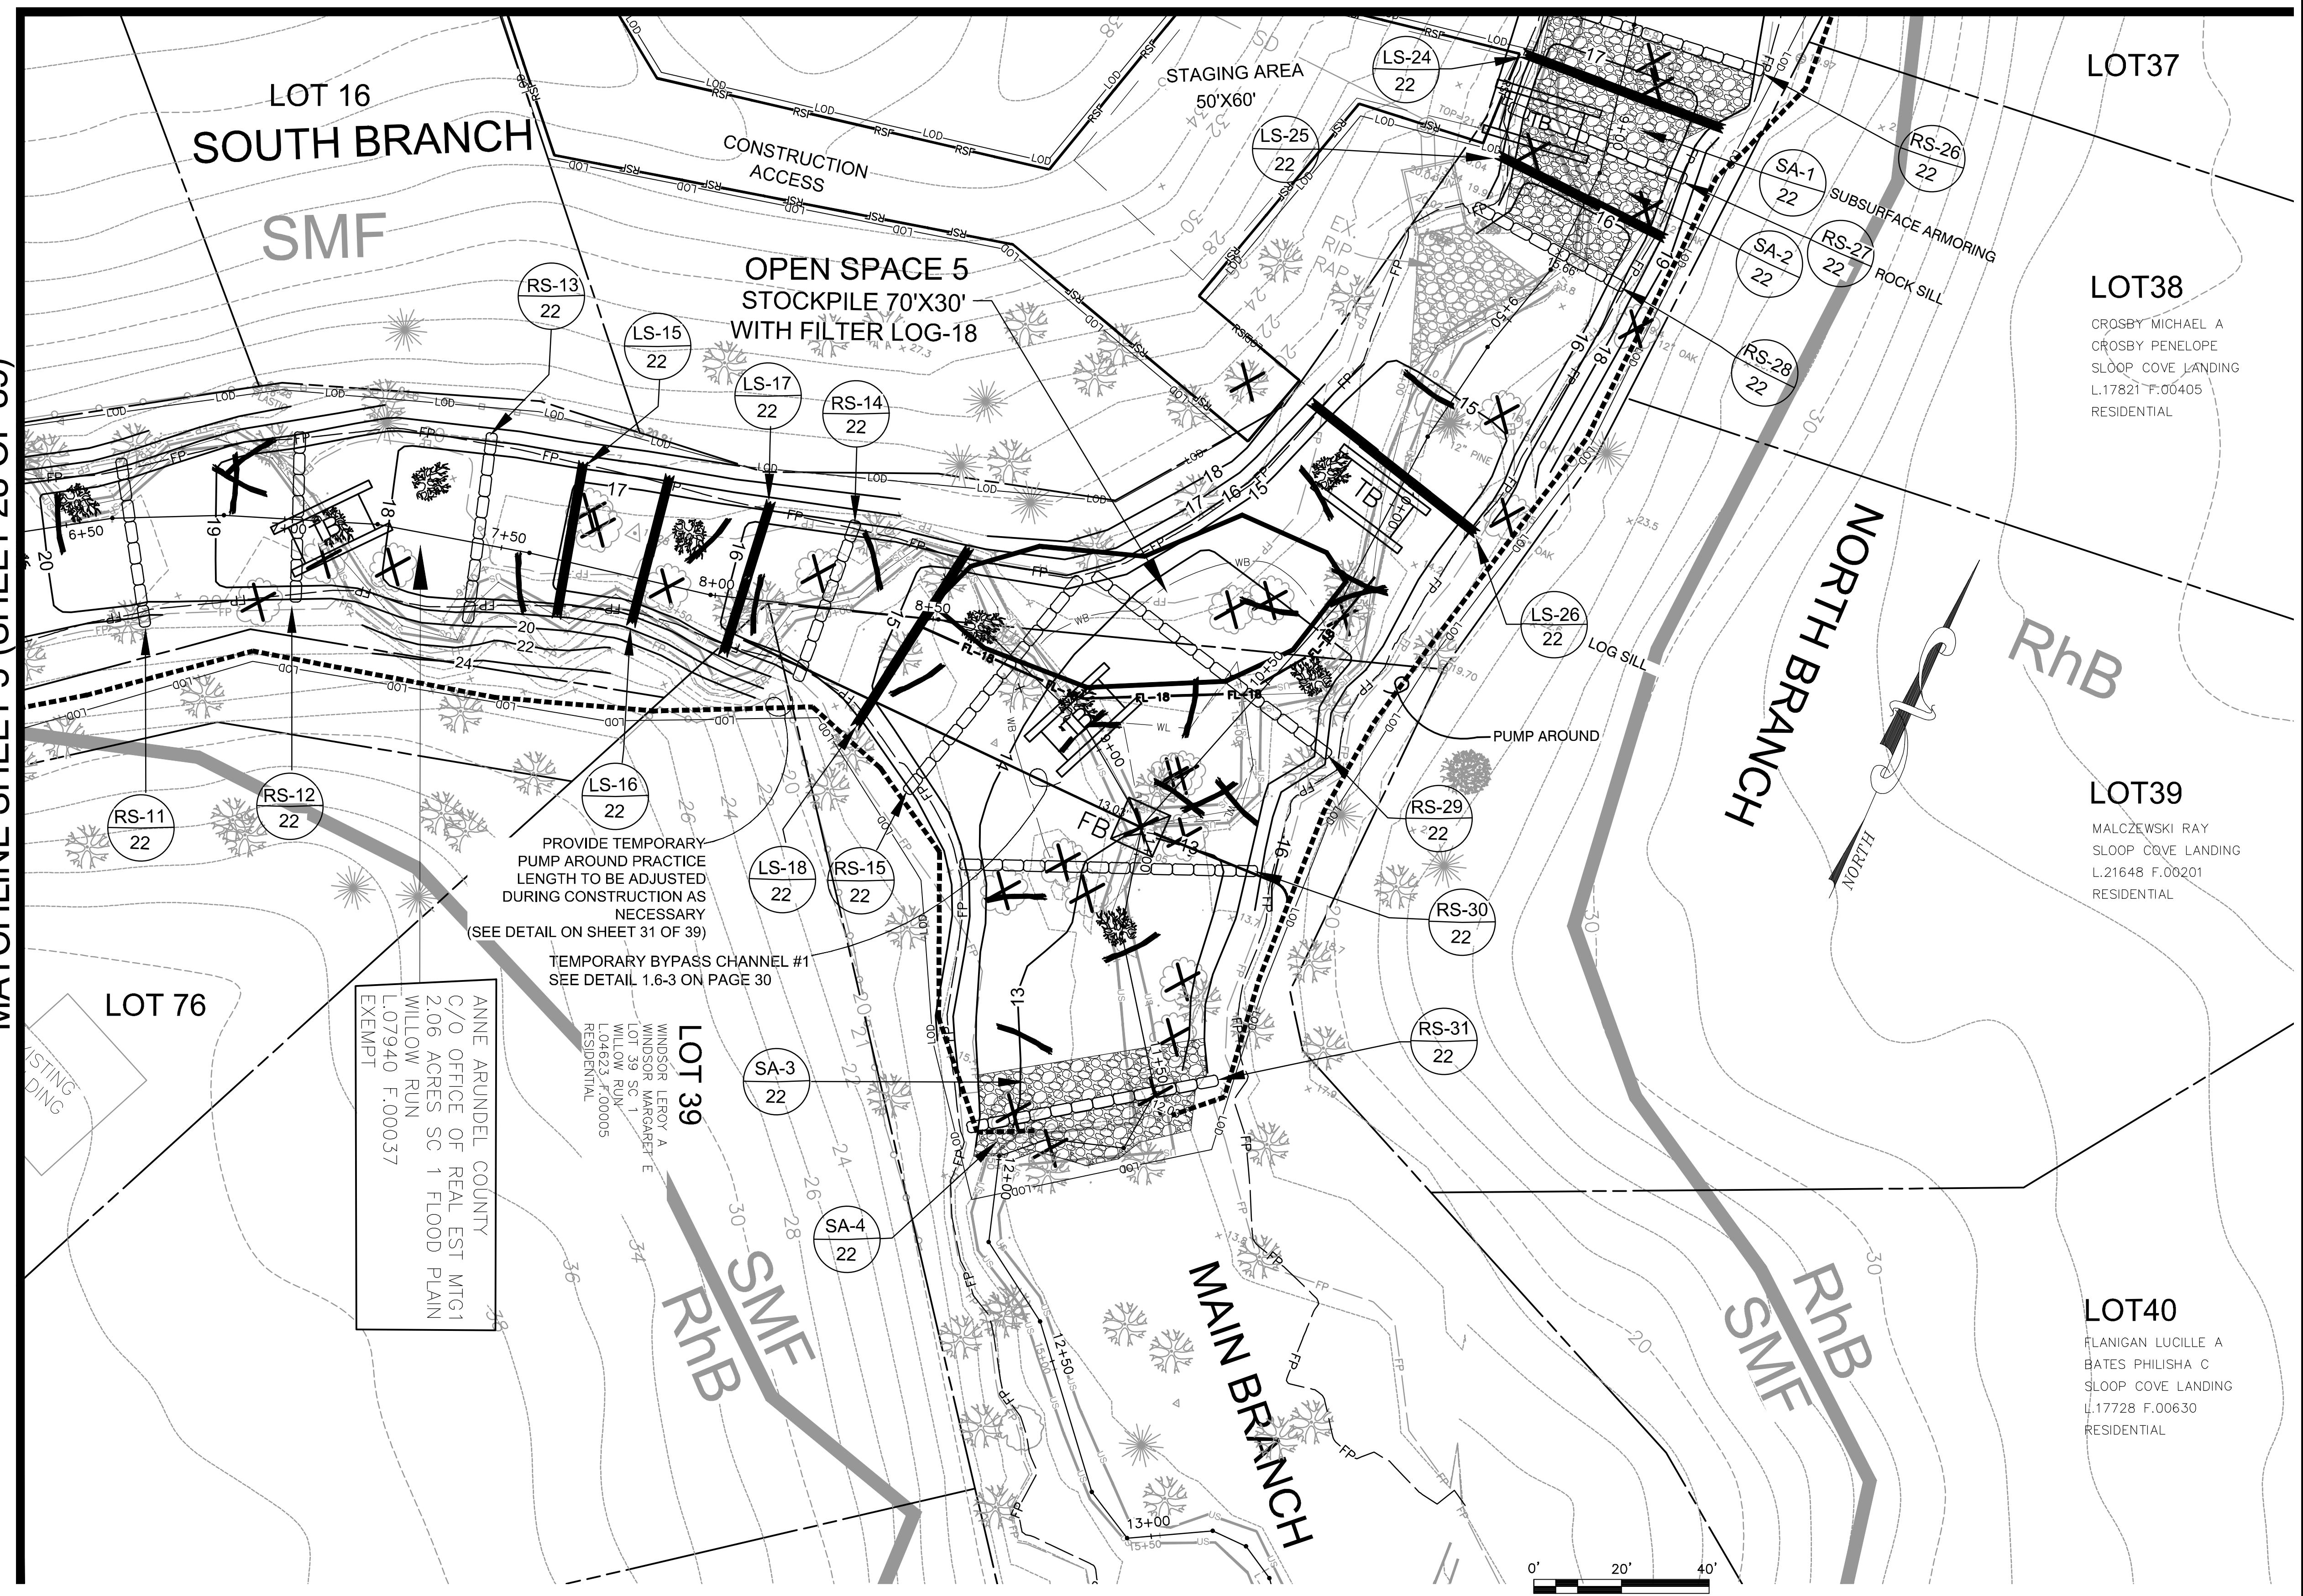

MATCHLINE SHEET 5 (SHEET 28 OF 39)

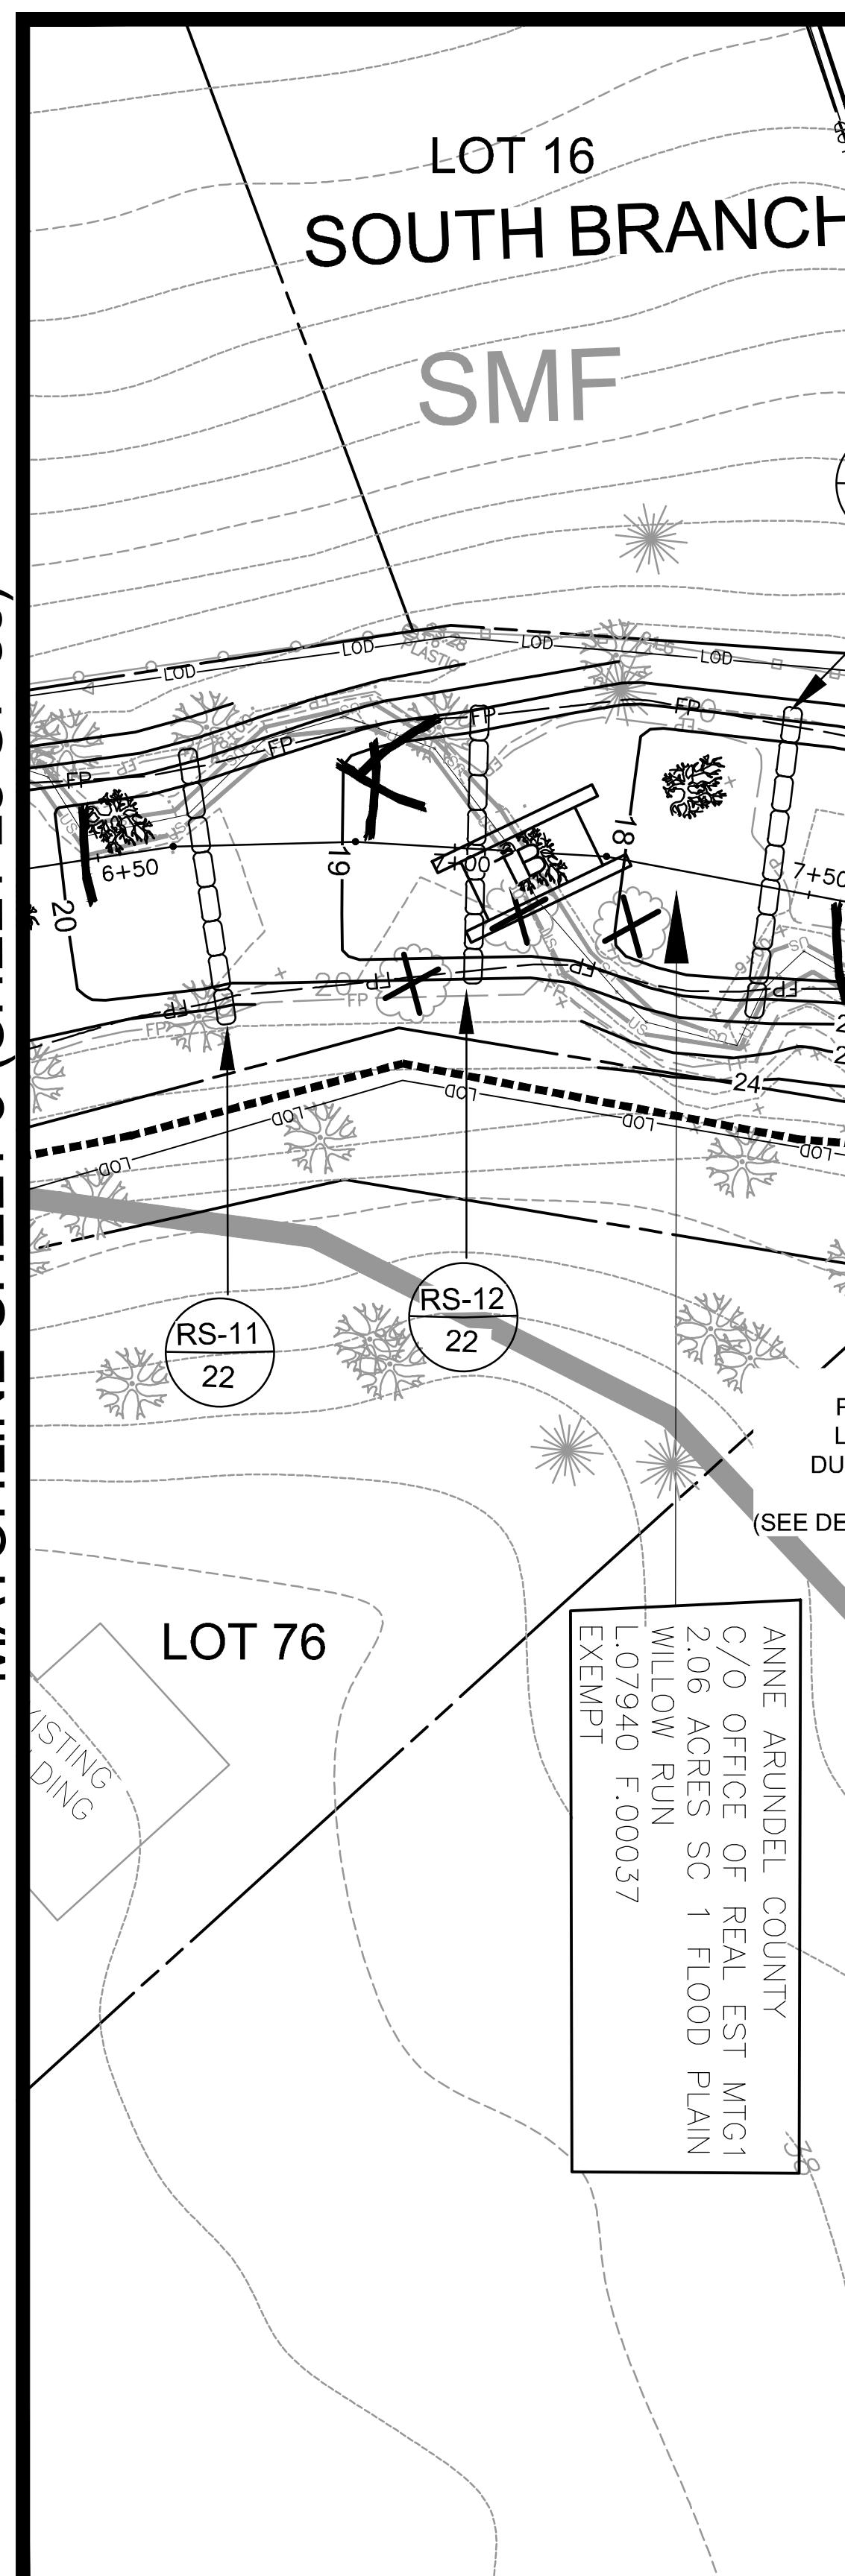

OWNER/DEVELOPER/APPLICANT	CIVIL ENGINEER A.A. County ID #721	Land Studies
717-627-4440 fax: 717-627-4660 landstudies.com tandl@landstudies.com 315 North Street Lititz, PA 17543	Dewberry 2101 Gaither Road Suite #340 Rockville, MD 20850 Contact: Joanne M. Cheek, Senior Associate Phone: (301) 337-2856 Fax: (301) 258-7607	 2/19/2022


REVISIONS			
NO	Description	BY	DATE
		APPROVED	DATE
		APPROVED	DATE
		CHIEF ENGINEER	PROJECT MANAGER
		APPROVED	APPROVED
		ASSISTANT CHIEF ENGINEER	CHIEF, RIGHT OF WAY

Professional Certification: I hereby certify that these documents were prepared or approved by me, and that I am a duly licensed professional engineer under the laws of the State of Maryland, License No. 18095, Expiration Date: 12/21/2022.


ANNE ARUNDEL COUNTY
DEPARTMENT OF PUBLIC WORKS
STREAM RESTORATION PLAN
EROSION & SEDIMENT CONTROL PLAN 4
SLOOP COVE RETROFIT SITE 1
3rd District
Tax Map 16 Grid 05
Anne Arundel County

MATCHLINE SHEET 4 (SHEET 27 OF 39)


EXISTING LEGEND

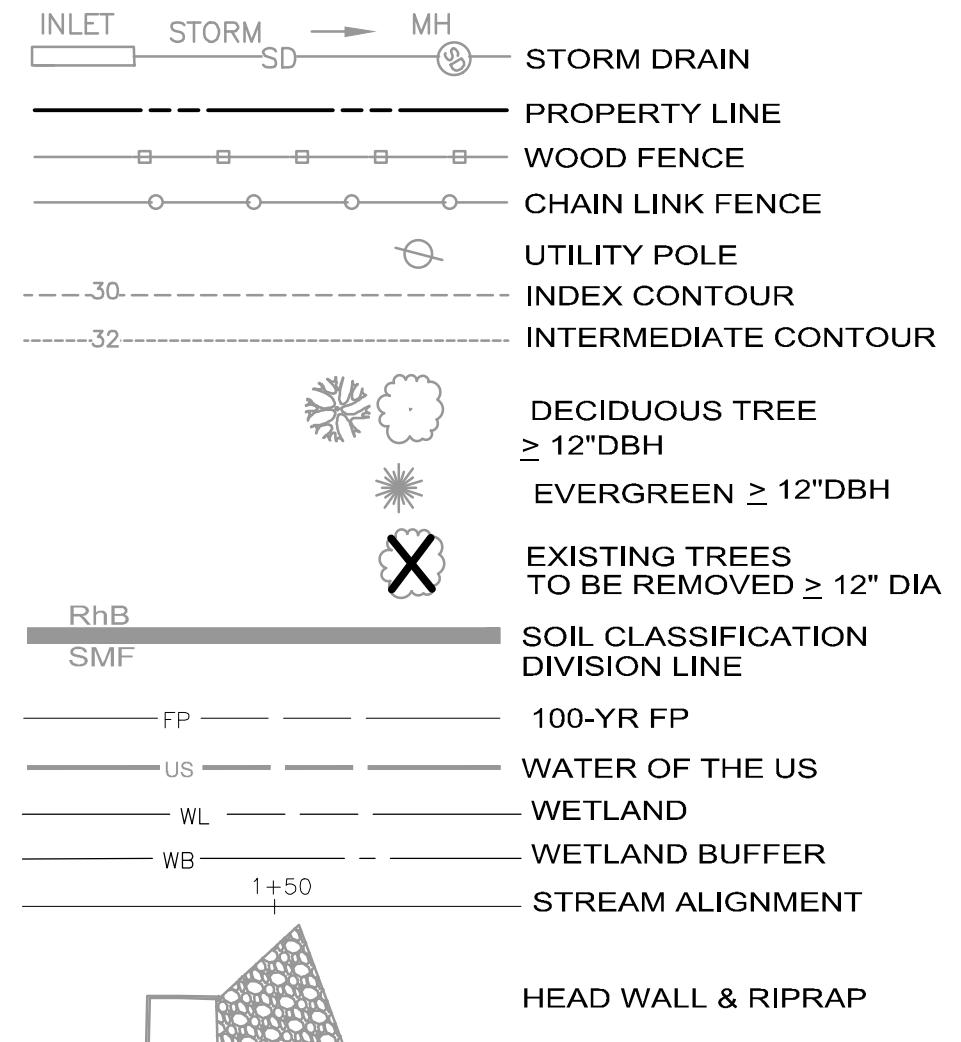

PROPOSED LEGEND

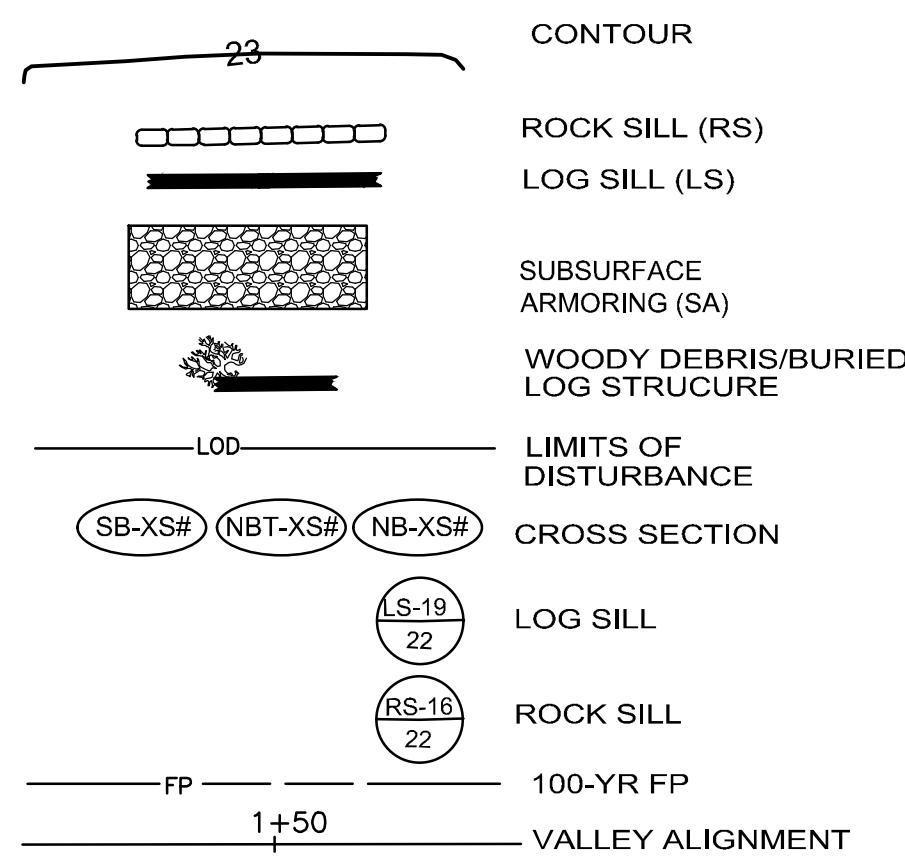

HIGH OAK ROAD

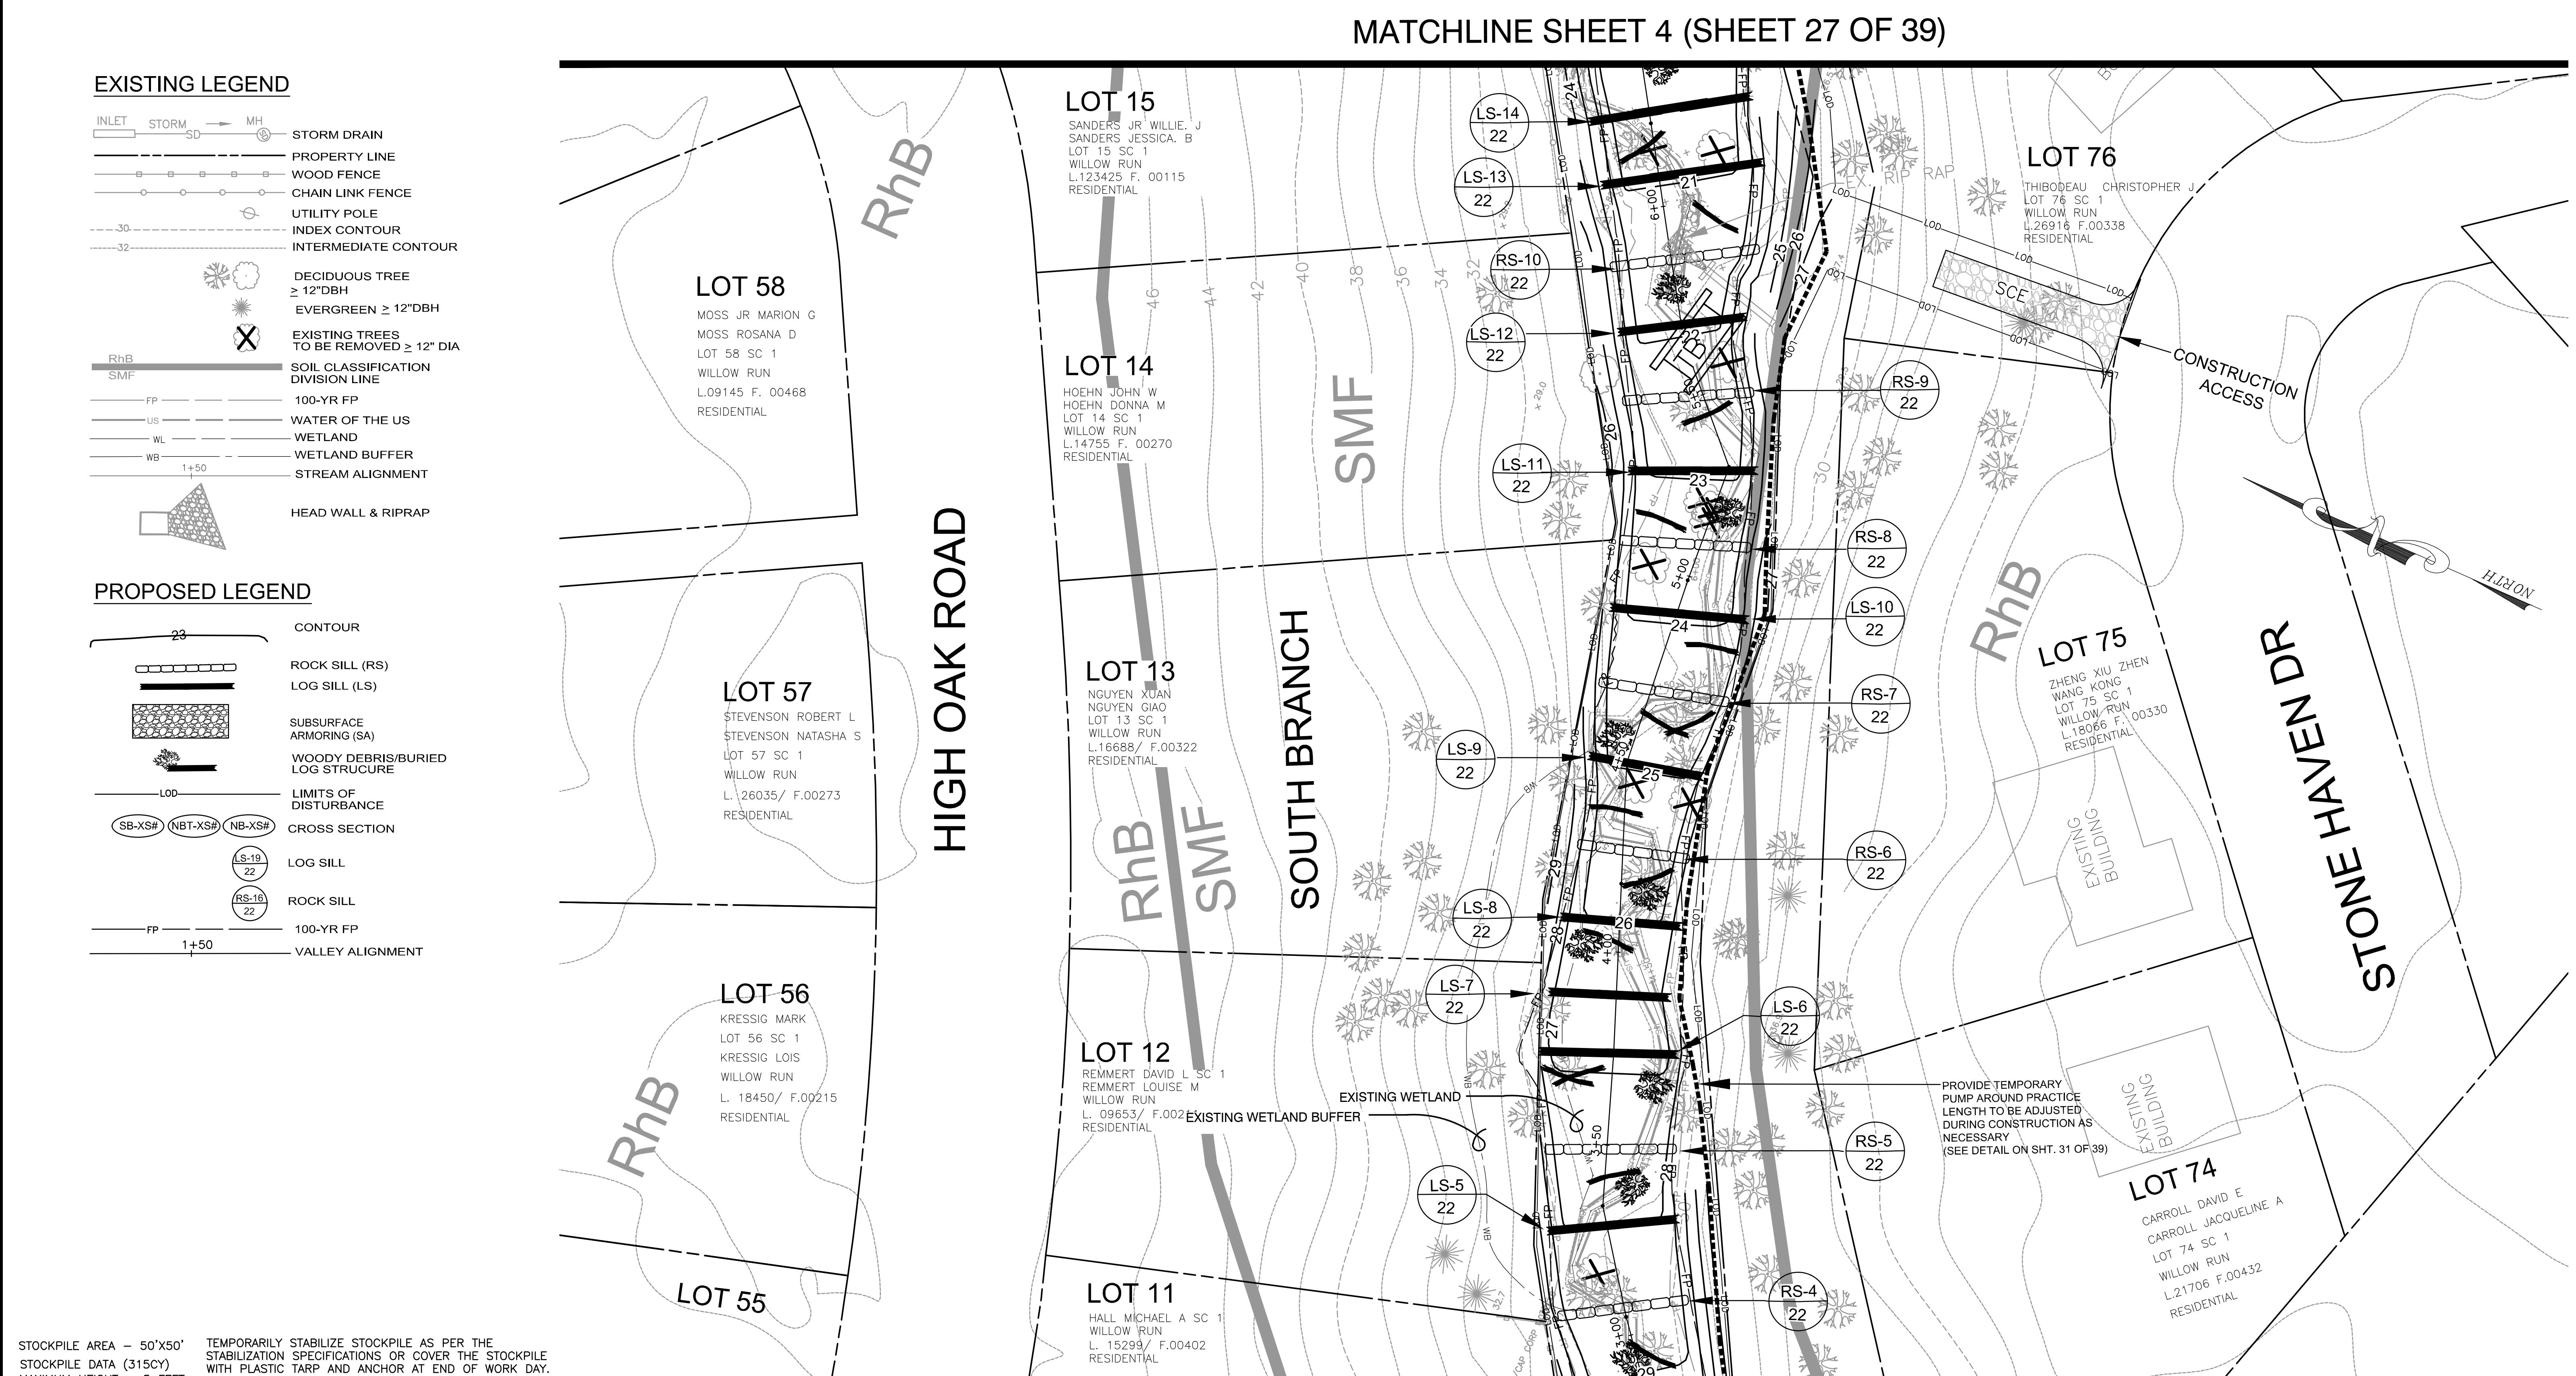


MATCHLINE SHEET 6 (SHEET 29 OF 39)



OWNER/DEVELOPER/APPLICANT		CIVIL ENGINEER A.A. County ID #721		REVISIONS		ANNE ARUNDEL COUNTY DEPARTMENT OF PUBLIC WORKS STREAM RESTORATION PLAN							
717-627-4440 fax: 717-627-4660 landstudies.com 315 North Street Lititz, PA 17543	 Dewberry 2101 Gaither Road Suite #340 Rockville, MD 20850 Contact: Joanne M. Cheek, Senior Associate Phone: (301) 337-2856 Fax: (301) 258-7607		Professional Certification: I hereby certify that these documents were prepared or approved by me, and that I am a duly licensed professional engineer under the laws of the State of Maryland, License No. 18095, Expiration Date: 12/21/2022.	NO	Description	BY	DATE	APPROVED	DATE	APPROVED	DATE	SCALE: As Shown	
								CHIEF ENGINEER	PROJECT MANAGER	CHECKED BY: J. Cheek		DRAWN BY: Buff/R. Anchors	
								APPROVED	DATE	APPROVED	DATE	SHEET NO: 28 OF 39	
								ASSISTANT CHIEF ENGINEER	CHIEF, RIGHT OF WAY	PROJECT NO: 50017963	PROPOSAL NO:	3rd District	
												Tax Map 16 Grid 05	

MATCHLINE SHEET 5 (SHEET 28 OF 39)


EXISTING LEGEND

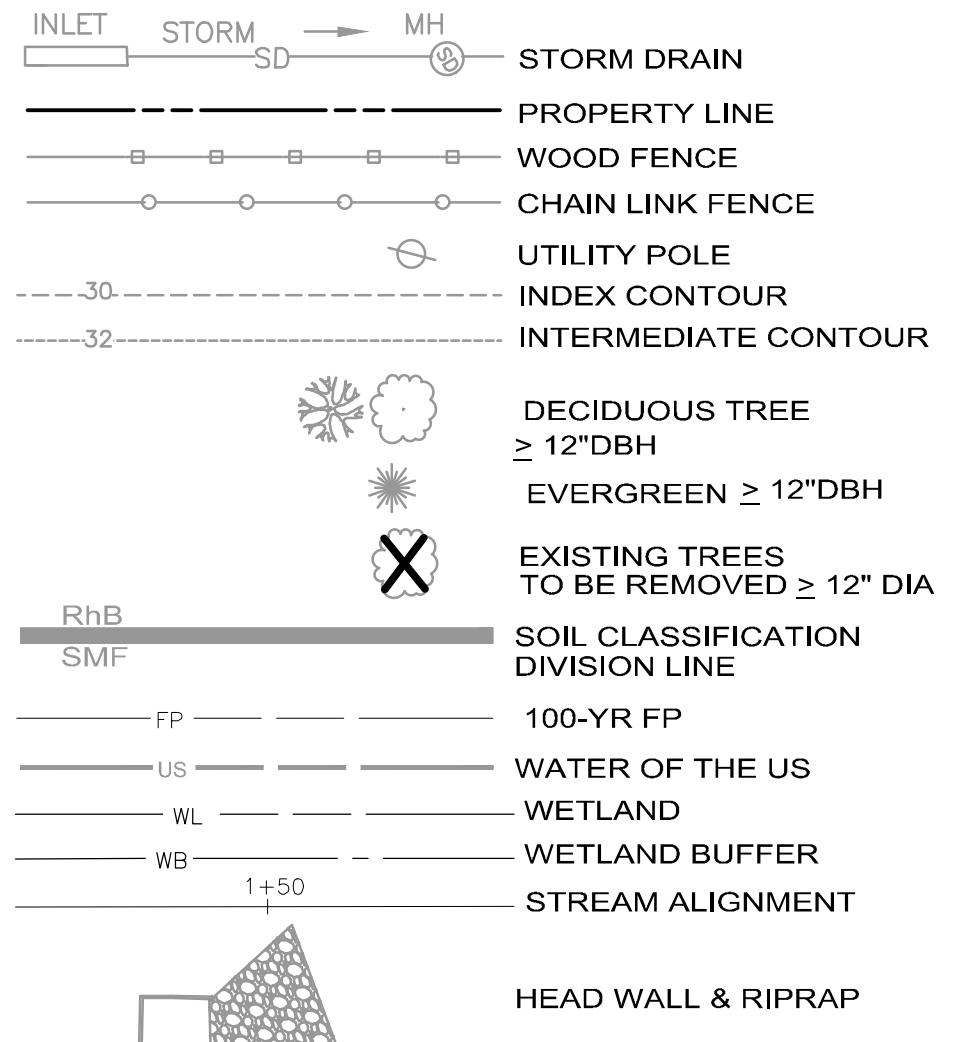

PROPOSED LEGEND

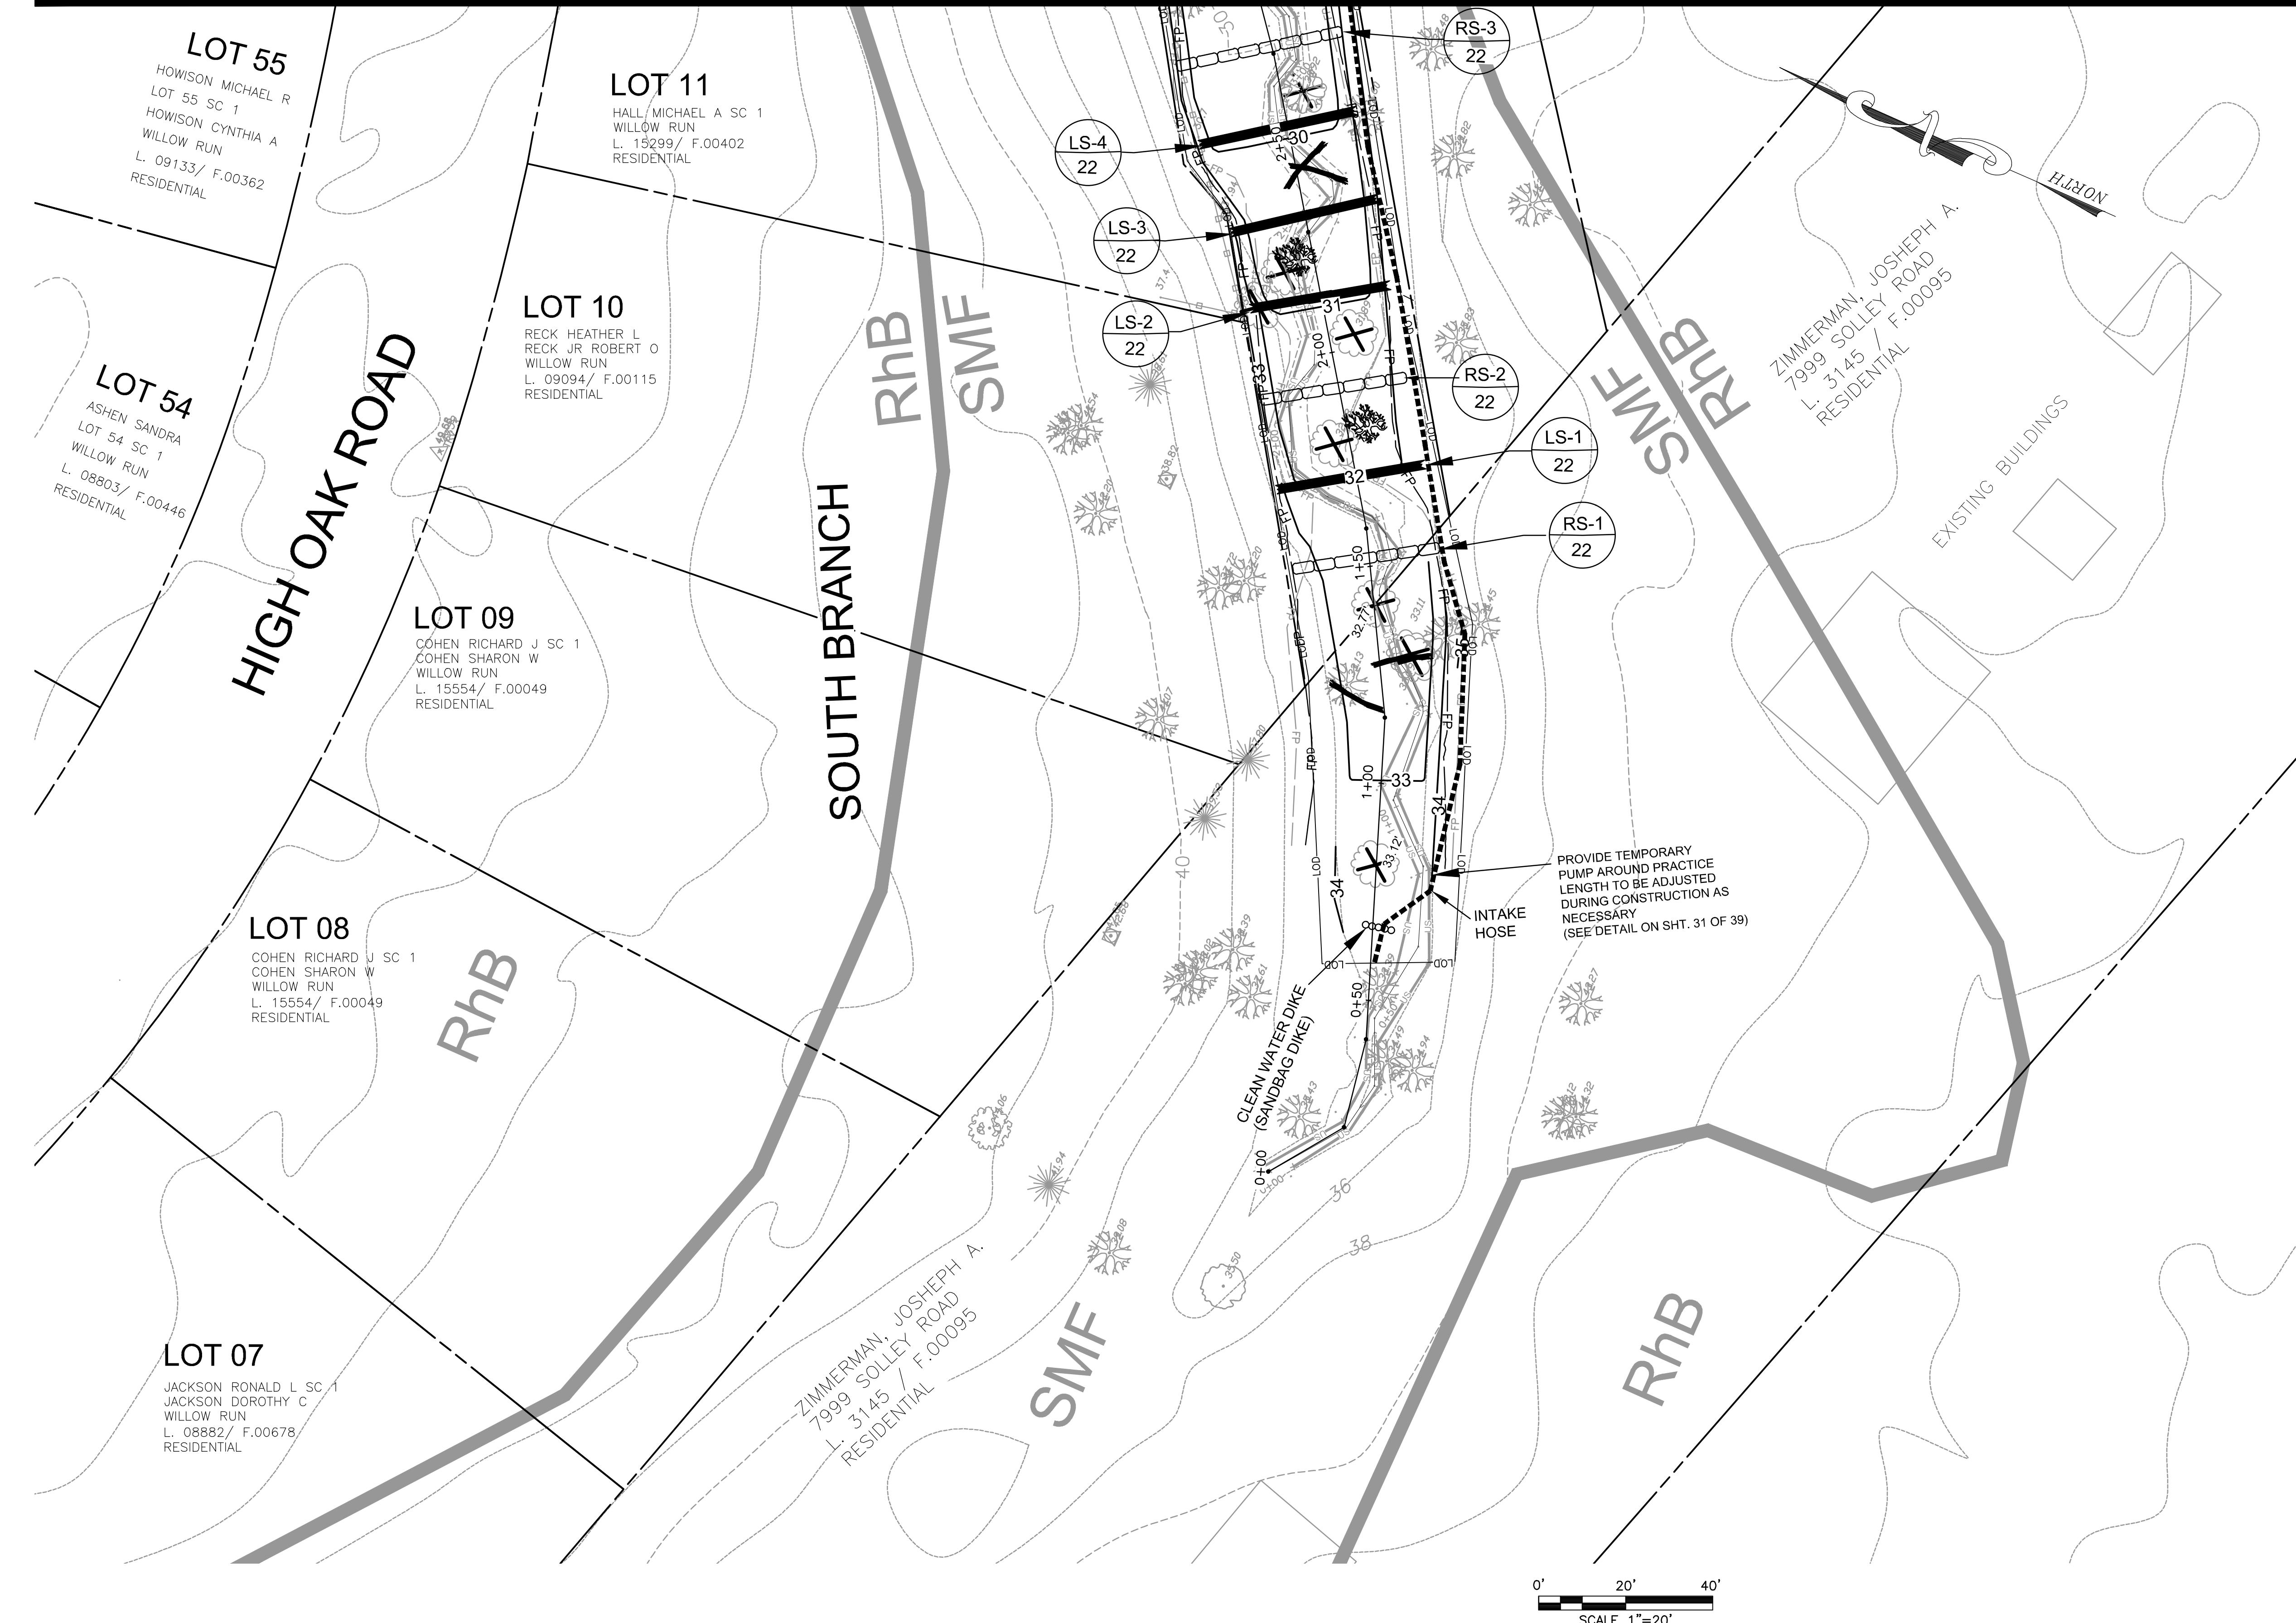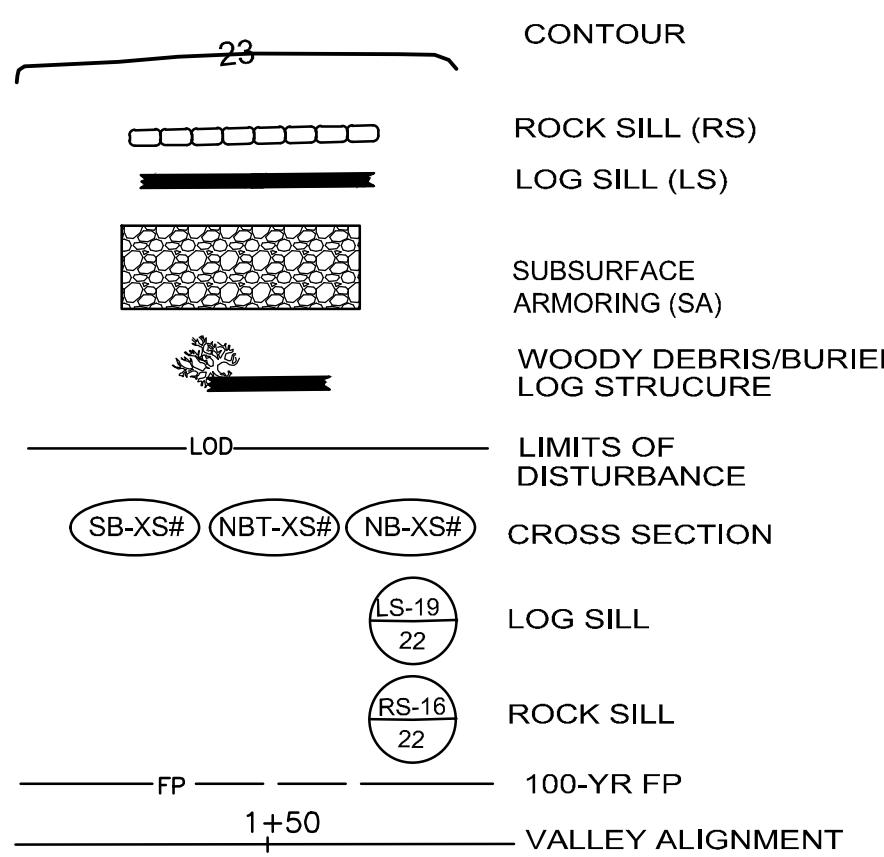

OWNER/DEVELOPER/APPLICANT

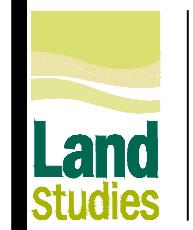

717-627-4440
fax: 717-627-4660
landstudies.com
315 North Street | Lititz, PA 17543

Dewberry
2101 Gaither Road
Suite #340
Rockville, MD 20850

Contact: Joanne M. Cheek, Senior Associate
Phone: (301) 337-2856
Fax: (301) 258-7607



Professional Certification: I hereby certify that these documents were prepared or approved by me, and that I am a duly licensed professional engineer under the laws of the State of Maryland, License No. 18095, Expiration Date: 12/21/2022.

CIVIL ENGINEER
A.A. County ID #721

REVISIONS

NO	Description	BY	DATE

ANNE ARUNDEL COUNTY

DEPARTMENT OF PUBLIC WORKS

STREAM RESTORATION PLAN

EROSION & SEDIMENT CONTROL PLAN 6
SLOOP COVE RETROFIT SITE 1

3rd District

Tax Map 16 Grid 05

Anne Arundel County

VEGETATIVE ESTABLISHMENT

Following initial soil disturbances or redistribution, permanent or temporary stabilization shall be completed within three calendar days for the surface of all perimeter controls, dikes, swales, ditches, perimeter slopes, and all slopes greater than 3 horizontal to 1 vertical (3:1) and seven days for all other disturbed or graded areas on the project site.

1. Permanent Seeding:

A. Soil Tests: Lime and fertilizer will be applied per soil tests results for sites greater than 5 acres. Soil tests will be done at completion of initial rough grading or as recommended by the sediment control inspector. Rates and analyses will be provided to the grading inspector as well as the contractor.

Occurrence of acid sulfate soils (grayish black color) will require covering with a minimum of 12 inches of clean soil with 6 inches minimum capping of top soil. No stockpiling of material is allowed. If needed, tests should be done before and after a 6-week incubation period to allow oxidation of sulfates.

The minimum soil conditions required for permanent vegetative establishment are:

- a. Soil pH shall be between 6.0 and 7.0.
- b. Soluble salts shall be less than 500 parts per million (ppm).
- c. The soil shall contain less than 40% clay but enough fine grained material (> 30% silt plus clay) to provide the capacity to hold a moderate amount of moisture. An exception is if lowgrass or seceria lespediza is to be planted, then a sandy soil (< 30% silt plus clay) would be acceptable.
- d. Soil shall contain 1.5% minimum organic matter by weight.
- e. Soil must contain sufficient pore space to permit adequate root penetration.
- f. If these conditions cannot be met by soils on site, adding topsoil is required in accordance with the Standard and Specification for Soil Preparation, Topsoiling and Soil Amendments from the 2011 Maryland Standards and Specifications for Soil Erosion and Sediment Control or amendments made as recommended by a certified agronomist.

B. Seeded Preparation: Area to be seeded shall be loose and friable to a depth of at least 3-5 inches. The top layer shall be loosened by raking, disking or other acceptable means before seeding occurs. For sites less than 3 acres, apply 100 pounds dolomitic limestone and 21 pounds of 10-10-10 fertilizer per 1,000 square feet. Harrow or disk lime and fertilizer into the soil to a depth of at least 3-5 inches on slopes flatter than 3:1.

C. Seeding: Apply 5-6 pounds per 1,000 square feet of tall fescue between February 1 and April 30 or between August 15 and October 31. Apply seed uniformly on a moist firm seedbed with a cyclone seeder, cultipacker seeder or hydroseeder (slurry includes seeds and fertilizer, recommended on steep slopes only). Maximum seed depth should be 1/4 inch in clayey soils and 1/2 inch in sandy soils when using other than the hydroseeder method. Irrigate where necessary to support adequate growth until vegetation is firmly established. If other seed mixes are to be used, select from Table B3 and B5 of the 2011 Maryland Standards and Specifications for Soil Erosion and Sediment Control.

D. Mulching: Mulch shall be applied to all seeded areas immediately after seeding. During the time periods when seeding is not permitted, mulch shall be applied immediately after grading. Mulch shall be unrolled, unchopped, small grain straw applied at a rate of 2 tons per acre or 90 pounds per 1,000 square feet (2 bales). If a mulch-anchoring tool is used, apply 2.5 tons per acre. Mulch materials shall be relatively free of all kinds of weeds and shall be completely free of prohibited noxious weeds. Spread mulch uniformly, mechanically or by hand, to a depth of 1-2 inches.

E. Securing Straw Mulch: Straw mulch shall be secured immediately following mulch application to minimize movement by wind or water. The following methods are permitted:

- i. Use a mulch-anchoring tool which is designed to punch and anchor mulch into the soil surface to a minimum depth of 2 inches. This is the most effective method for securing mulch, however, it is limited to relatively flat areas where equipment can operate safely.
- ii. Wood cellulose fiber may be used for anchoring straw. Apply the fiber binder at a net dry weight of 750 pounds per acre. If mixed with water, use 50 pounds of wood cellulose fiber per 100 gallons of water.
- iii. Liquid binders may be used. Apply at higher rates at the edges where wind catches mulch, such as in valleys and on crests of slopes. The remainder of the area should appear uniform after binder application. Binders listed in the 2011 Maryland Standards and Specifications for Soil Erosion and Sediment Control or approved equal shall be applied at rates recommended by the manufacturers.
- iv. Lightweight plastic netting may be used to secure mulch. The netting will be stapled to the ground according to manufacturer's recommendations.

2. Temporary Seeding:

Lime: 100 pounds of dolomitic limestone per 1,000 square feet.
Fertilizer: 15 pounds of 10-10-10 per 1,000 square feet.
Seed: Perennial rye - 0.02 pounds per 1,000 square feet (February 1 through April 30 or August 15 through October 31).
Millet - 0.92 pounds per 1,000 square feet (May 1 through August 15).

Mulch: Same as 1 D and E above.

3. No fills may be placed on frozen ground. All fill is to be placed in approximately horizontal layers, each layer having a loose thickness of not more than 5 inches. All compaction requirements are in accordance to Anne Arundel County Standard Specifications for Construction as well as the AACO Design Manual and Standard Details. Fills for pond embankments shall be compacted as per MD-378 Construction Specifications. All other fills shall be compacted sufficiently so as to be stable and prevent erosion and slippage.

4. Permanent Soil:

Installation of sod should follow permanent seeding dates. Seeded preparation for sod shall be as noted in section (B) above. Permanent sod is to be tall fescue, state approved soil, lime and fertilizer per permanent seeding specifications and lightly irrigate soil prior to laying sod. Sod is to be laid on the contour with all ends tightly abutting. Joints are to be staggered between rows. Water and roll or tamp sod to insure positive root contact with the soil. All slopes steeper than 3:1, as shown, are to be permanently sodded or protected with an approved erosion control netting. Additional watering for establishment is required. Sod is not to be installed on frozen ground. Sod shall not be transplanted when moisture content (dry or wet) and/or extreme temperature may adversely affect its survival. In the absence of adequate rainfall, irrigation should be performed to ensure establishment of sod.

5. Mining Operations:

Sediment control plans for mining operations must include the following seeding dates and mixtures:

For seeding dates of February 1 through April 30 and August 15 through October 31, use seed mixture of tall fescue at the rate of 2 pounds per 1,000 square feet and seceria lespediza at the minimum rate of 0.5 pounds per 1,000 square feet.

6. Topsoil shall be applied as per the Standard and Specifications for Soil Preparation, Topsoiling, and Soil Amendments from the 2011 Maryland Standards and Specifications for Soil Erosion and Sediment Control.

STANDARDS AND SPECIFICATIONS FOR SOIL PREPARATION, TOPSOILING, AND SOIL AMENDMENTS**Definition**

The process of preparing the soils to sustain adequate vegetative stabilization.

Purpose

To provide a suitable soil medium for vegetative growth.

Conditions Where Practice Applies

Where vegetative stabilization is to be established.

Criteria**A. Soil Preparation****1. Temporary Stabilization**

a. Seeded preparation consists of loosening soil to a depth of 3 to 5 inches by suitable agricultural or construction equipment, such as disc harrows or chisel plows or rippers mounted on construction equipment. After the soil is loosened, it must not be rolled or dragged smooth but left in the roughened condition. Slopes 3:1 or flatter are to be tracked with ridges running parallel to the contour of the slope.

b. Apply fertilizer and lime as prescribed on the plans.

c. Incorporate lime and fertilizer into the top 3 to 5 inches of soil by disking or other suitable means.

2. Permanent Stabilization

a. A soil test is required for any earth disturbance of 5 acres or more. The minimum soil conditions required for permanent vegetative establishment are:

i. Soil pH between 6.0 and 7.0.

ii. Soluble salts less than 500 parts per million (ppm).

iii. Soil contains less than 40 percent clay but enough fine grained material (greater than 30 percent silt plus clay) to provide the capacity to hold a moderate amount of moisture. An exception: if lowgrass will be planted, then a sandy soil (< 30 percent silt plus clay) would be acceptable.

iv. Soil contains 1.5 percent minimum organic matter by weight. v. Soil contains sufficient pore space to permit adequate root penetration.

b. Application of amendments or topsoil is required if on-site soils do not meet the above conditions.

c. Seeded areas must be maintained in a true and even grade as specified on the approved plan, then scoriaf or otherwise loosened to a depth of 3 to 5 inches.

d. Apply soil amendments as specified on the approved plan or as indicated by the results of a soil test.

e. Mix soil amendments into the top 3 to 5 inches of soil by disking or other suitable means. Do not use large objects like stones and branches, and ready the area for seed application. Loosen surface soil by dragging with a heavy chain or other equipment to roughen the surface where site conditions will not permit normal seedbed preparation. Track slopes 3:1 or flatter with tracked equipment leaving the soil in an irregular condition with ridges running parallel to the contour of the slope. Leave the top 1 to 3 inches of soil loose and friable. Seeded loosening may be unnecessary on newly disturbed areas.

B. Topsoiling

1. Topsoil is placed over prepared subsoil prior to establishment of permanent vegetation. The purpose is to provide a suitable soil medium for vegetative growth. Soils of concern have low moisture content, low nutrient levels, low pH, materials toxic to plants, and/or unacceptable soil gradation.

2. Topsoil salvaged from an existing site may be used provided it meets the standards as set forth in these specifications. Typically, the depth of topsoil to be salvaged for a given soil type can be found in the representative soil profile section in the Soil Survey published by USDA-NRCS.

3. Topsoiling is limited to areas having 2:1 or flatter slopes where:

a. The texture of the exposed subsoil/parent material is not adequate to produce vegetative growth. The soil material is so shallow that the rooting zone is not deep enough to support plants or furnish continuing supplies of moisture and plant nutrients.

b. The original soil to be vegetated contains material toxic to plant growth.

c. The soil is so acidic that treatment with limestone is not feasible.

4. Areas having slopes steeper than 2:1 require special consideration and design.

5. Topsoil Specifications: Soil to be used as topsoil must meet the following criteria:

a. Topsoil must be a loamy sand, loamy, loamy clay, loamy silt, loamy sandy, clay loam, or loamy sand. Other soils may be used if recommended by an approved soil scientist and approved by the appropriate approval authority. Topsoil must not be a mixture of contrasting textured subsoils and must contain less than 5 percent by volume of cinders, stones, slag, coarse fragments, gravel, sticks, roots, trash, or other materials larger than 1/2 inches in diameter.

b. Topsoil must be free of noxious plants or plant parts such as Bermuda grass, quack grass, Johnson grass, nut sedge, poison ivy, thistle, or others as specified.

c. Topsoil substitutes or amendments, as recommended by a qualified agronomist or soil scientist and approved by the appropriate approval authority, may be used in lieu of natural topsoil.

6. Topsoil Application

a. Erosion and sediment control practices must be maintained when applying topsoil. Uniformly distribute topsoil in a 5 to 8 inch layer and lightly compacted to a minimum thickness of 4 inches. Spreading is to be performed in such a manner that sodding or seeding can proceed with a minimum of additional soil preparation and tillage. Any irregularities in the surface resulting from topsoiling or other operations must be corrected in order to prevent the formation of depressions or water pockets.

c. Topsoil must not be placed if the topsoil or subsoil is in a frozen or muddy condition, when the subsoil is excessively wet or in a condition that may otherwise be detrimental to proper grading.

C. Soil Amendments (Fertilizer and Lime Specifications)

1. Soil tests must be performed to determine the exact ratios and application rates for both lime and fertilizer on sites having disturbed areas of 5 acres or more. Soil analysis may be performed by a recognized private or commercial laboratory. Soil samples taken for engineering purposes may also be used for chemical analyses.

2. Fertilizers must be uniform in composition, free flowing and suitable for accurate application by appropriate equipment. Manure may be substituted for fertilizer with prior approval from the appropriate approval authority. Fertilizers must all be delivered to the site fully labeled according to the applicable laws and must bear the name, trade name or trademark and warranty of the producer.

3. Lime materials must be ground limestone (hydrated or burnt lime may be substituted except when hydroseeding) which contains at least 50 percent total oxides (calcium oxide plus magnesium oxide). Limestone must be ground to such fineness that at least 50 percent will pass through a #100 mesh sieve and 98 to 100 percent will pass through a #20 mesh sieve.

4. Lime and fertilizer are to be evenly distributed and incorporated into the top 3 to 5 inches of soil by disking or other suitable means.

5. Where the subsoil is either highly acidic or composed of heavy clays, ground limestone should be spread at the rate of 4 to 8 tons/acre (200-400 pounds per 1,000 square feet) prior to the placement of topsoil.

MAINTENANCE NOTE
CONTRACTOR WILL INSPECT EROSION AND SEDIMENT CONTROL DEVICES ON A DAILY BASIS AND MAINTAIN DEVICES IN ACCORDANCE WITH THEIR DESIGN SPECIFICATIONS.

STANDARDS AND SPECIFICATIONS FOR STOCKPILE AREA**Definition**

A mound or pile of soil protected by appropriately designed erosion and sediment control measures.

Purpose

To provide a designated location for the temporary storage of soil that controls the potential for erosion, sedimentation, and changes to drainage patterns.

Conditions Where Practice Applies

Stockpile areas are utilized when it is necessary to salvage and store soil for later use.

Criteria**1. The stockpile location and all related sediment control practices must be clearly indicated on the erosion and sediment control plan.**

2. The footprint of the stockpile must be sized to accommodate the anticipated volume of material and based on a side slope ratio no steeper than 2:1. Benching must be provided in the upper portion of the stockpile.

3. Runoff from the stockpile area must drain to a suitable sediment control practice.

4. Access to the stockpile area should be from the upgrade side.

5. Clear water runoff into the stockpile area must be minimized by use of a diversion channel or swale.


6. Where runoff concentrates along the toe of the stockpile fill, an appropriate erosion/sediment control practice must be used to intercept the discharge.

7. Stockpiles must be stabilized in accordance with the 3/7 day stabilization requirement.

DETAIL H-4-1 TEMPORARY ACCESS BRIDGE

STANDARD SYMBOL

TB

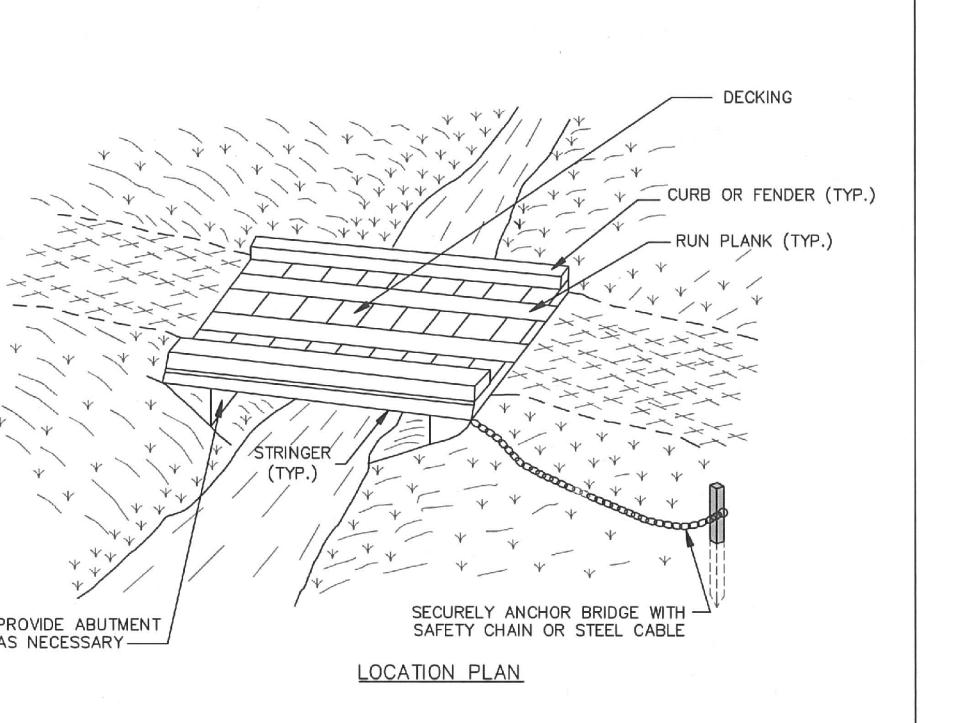

NOTE: TIME OF YEAR RESTRICTIONS DO NOT APPLY TO THE CONSTRUCTION OR REMOVAL OF A TEMPORARY ACCESS BRIDGE UNLESS THERE IS DISTURBANCE TO THE STREAM CHANNEL.

1 of 2

MARYLAND STANDARDS AND SPECIFICATIONS FOR SOIL EROSION AND SEDIMENT CONTROL

U.S. DEPARTMENT OF AGRICULTURE, NATURAL RESOURCES CONSERVATION SERVICE 2011 MARYLAND DEPARTMENT OF ENVIRONMENT, WATER MANAGEMENT ADMINISTRATION

DETAIL H-4-1 TEMPORARY ACCESS BRIDGE

STANDARD SYMBOL

TB




CONSTRUCTION SPECIFICATIONS


1. CONSTRUCT TEMPORARY BRIDGE STRUCTURE AT OR ABOVE THE BANK ELEVATION TO PREVENT IMPACTS FROM FLOATING MATERIALS AND DEBRIS.
2. PLACE ABUTMENTS PARALLEL TO, AND ON, STABLE BANKS.
3. CONSTRUCT BRIDGE TO SPAN ENTIRE CHANNEL UNLESS OTHERWISE INDICATED ON APPROVED PLAN.
4. USE STRINGERS CONSISTENT OF LOGS, SAWN TIMBER, PRESTRESSED CONCRETE BEAMS, METAL BEAMS, OR OTHER EQUIVALENT MATERIALS.
5. SELECT DECKING MEMBERS TO PROVIDE SUFFICIENT STRENGTH TO SUPPORT THE ANTICIPATED LOAD. PLACE ALL DECKING MEMBERS PERPENDICULAR TO THE STRINGERS, BUTT TIGHTLY, AND SECURELY ON THE STRINGERS.
6. SECURELY FASTEN OPTIONAL RUN PLANKING FOR THE LENGTH OF THE SPAN. PROVIDE A RUN PLANK FOR EACH TRACK OF THE EQUIPMENT WHEELS. ALTHOUGH RUN PLANKS ARE OPTIONAL, THEY MAY BE NECESSARY TO SUPPORT EQUIPMENT LOADS.
7. INSTALL CURBS THE ENTIRE LENGTH OF THE OUTSIDE OF THE DECK TO PREVENT SEDIMENT FROM ENTERING THE STREAM CHANNEL.
8. ANCHOR BRIDGE SECURELY AT ONLY ONE END USING STEEL CABLE OR CHAIN. ANCHORING AT ONLY ONE END WILL PREVENT CHANNEL OBSTRUCTION IN THE EVENT THAT FLOWDOWNS FLOAT THE BRIDGE. ANCHOR CABLES MUST BE SECURED TO A STABLE, DURABLE, AND LONG-LASTING MATERIAL, SUCH AS A LOG POST. ANCHOR MUST BE SUFFICIENT TO PREVENT THE BRIDGE FROM FLOATING DOWNSTREAM.
9. AREAS DISTURBED DURING BRIDGE INSTALLATION AND/OR REMOVAL MUST NOT BE LEFT UNSTABILIZED OVERNIGHT UNLESS STABILIZED BY AN APPROVED SEDIMENT CONTROL DEVICE.
10. STABILIZE APPROACH TO BRIDGE AND KEEP FREE OF EROSION, CLEAN SEDIMENT FROM DECKING AND CURBS DAILY. SCRAPING, SWEEPING, AND/OR VACUUMING, INSURE DECKING AND CURBS REMAIN DRY AND VIBRANT WITHIN 24 HOURS. REMOVE ALL REMOVED MATERIALS FROM THE APPROVED STAGING AREA.
11. AFTER THE TEMPORARY CROSSING IS NO LONGER NEEDED, REMOVE IT WITHIN 14 CALENDAR DAYS. IF SUBJECT TO THE USE DESIGNATION CLOSURE, REMOVE AT THE END OF CLOSURE PERIOD. PROTECT STREAM BANKS DURING BRIDGE REMOVAL AND STABILIZE ANY DISTURBED AREAS WITH EROSION CONTROL MEASURES. DO NOT ALLOW EROSION, SEDIMENTATION, AND OTHER POLLUTION FROM BRIDGE REMOVAL TO ENTER THE WATERWAY CHANNEL. STORE ALL REMOVED MATERIALS IN AN APPROVED STAGING AREA.

2 of 2

MARYLAND STANDARDS AND SPECIFICATIONS FOR SOIL EROSION AND SEDIMENT CONTROL

U.S. DEPARTMENT OF AGRICULTURE, NATURAL RESOURCES CONSERV

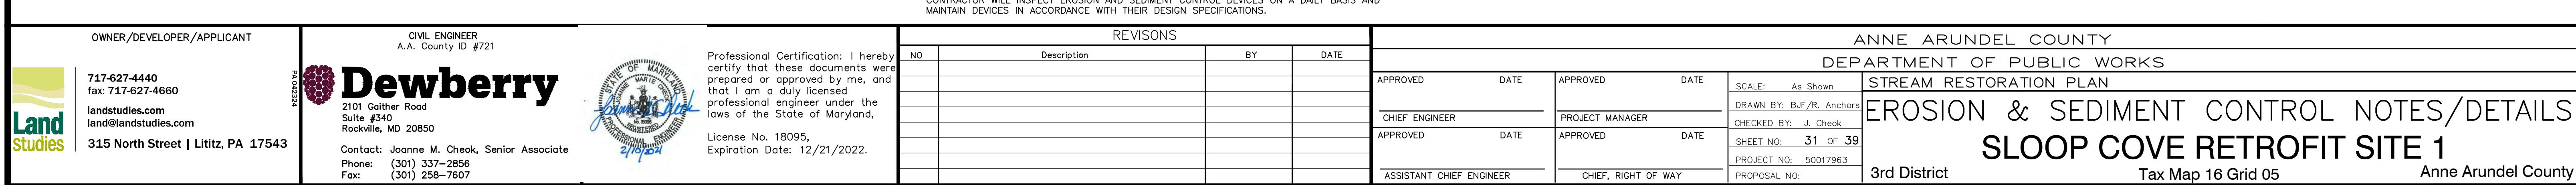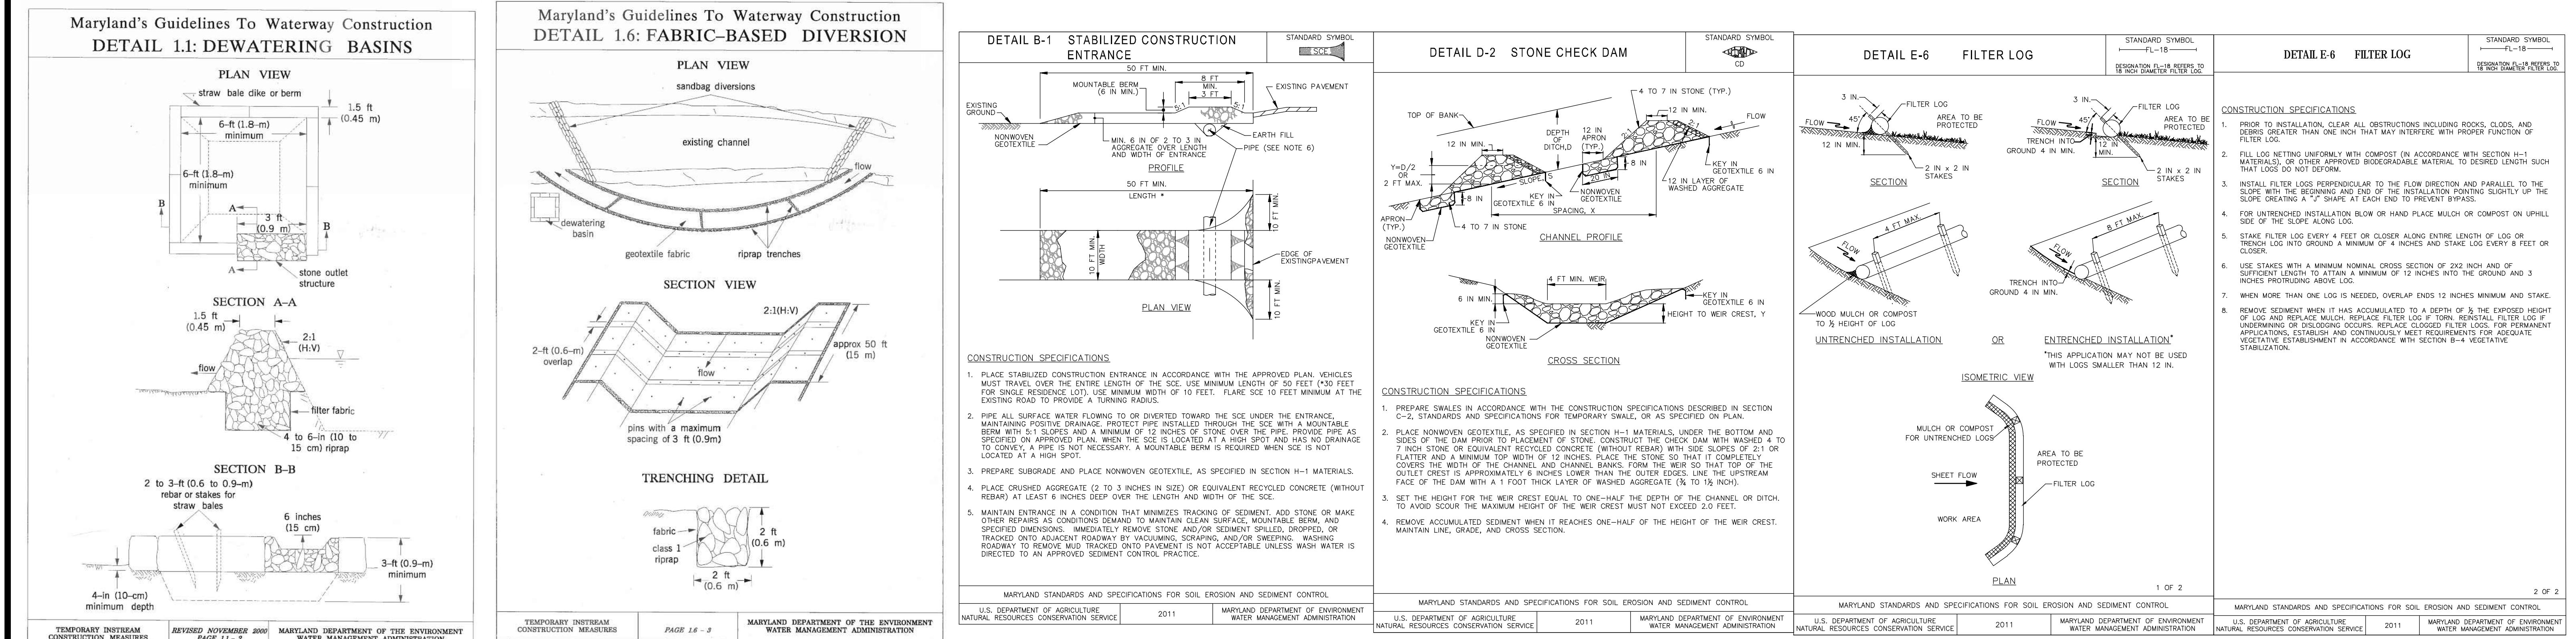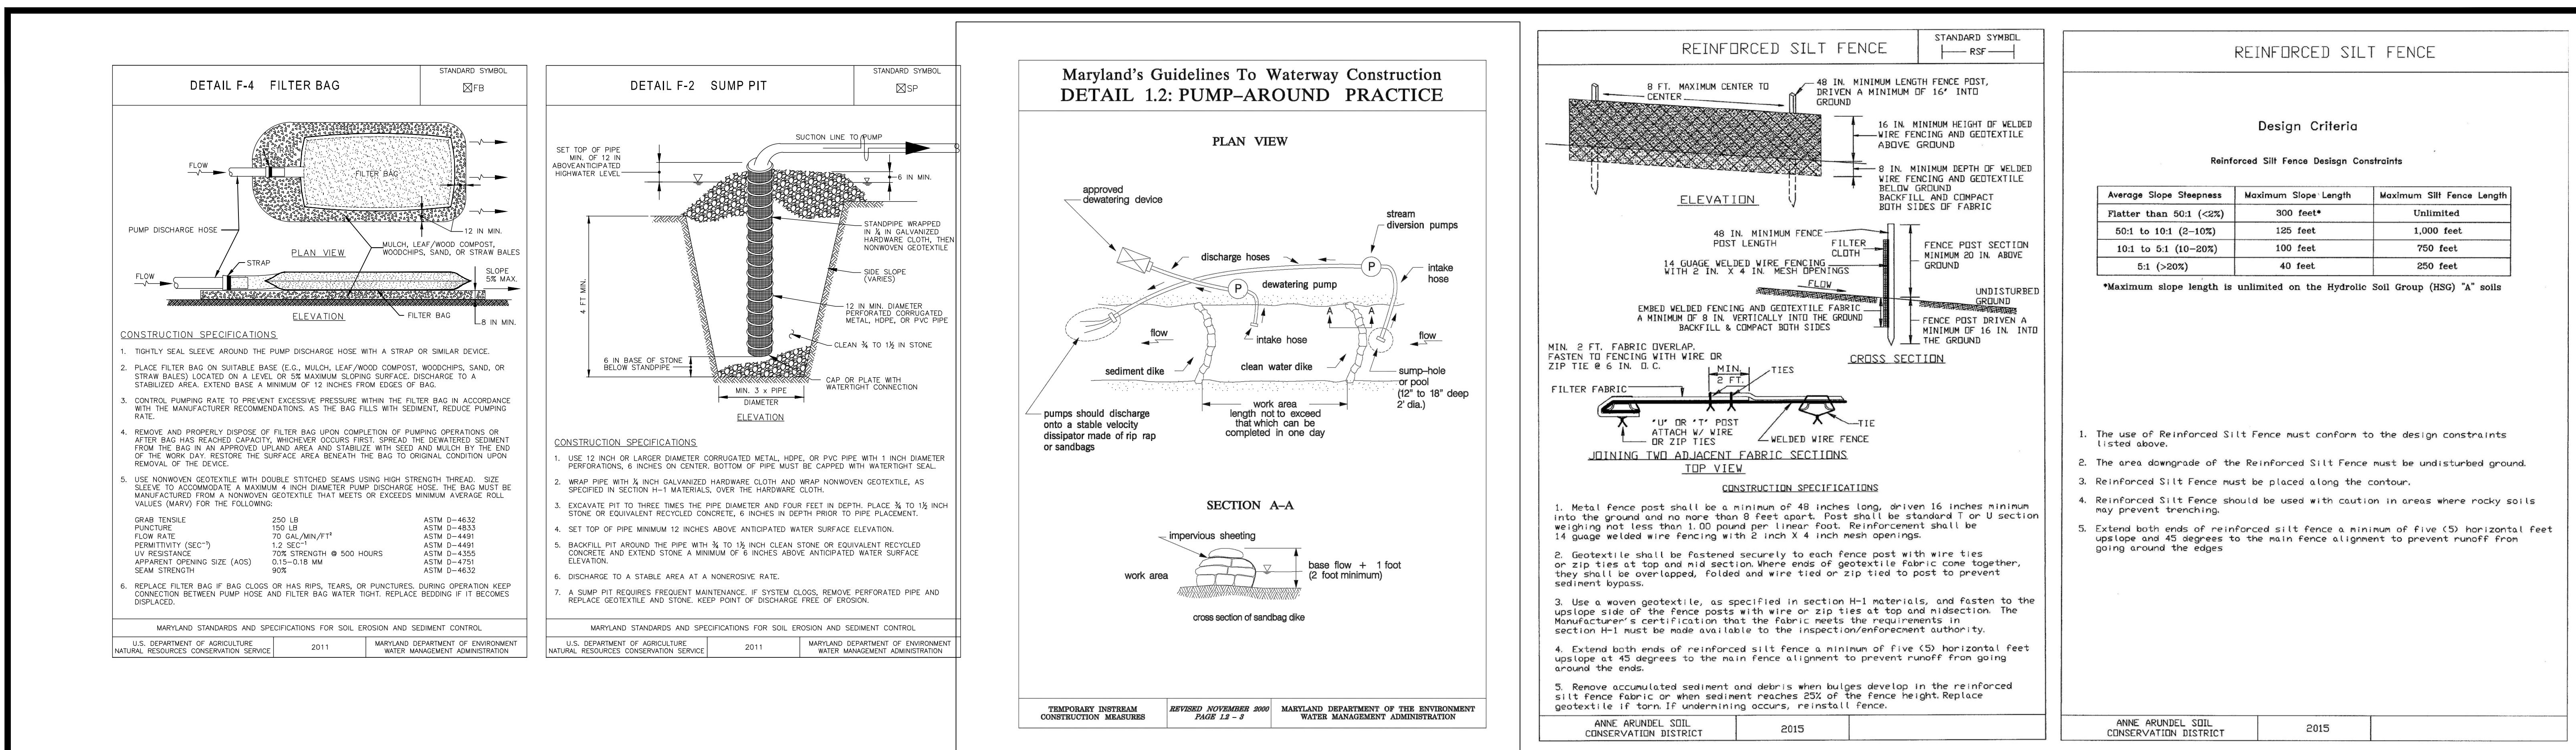

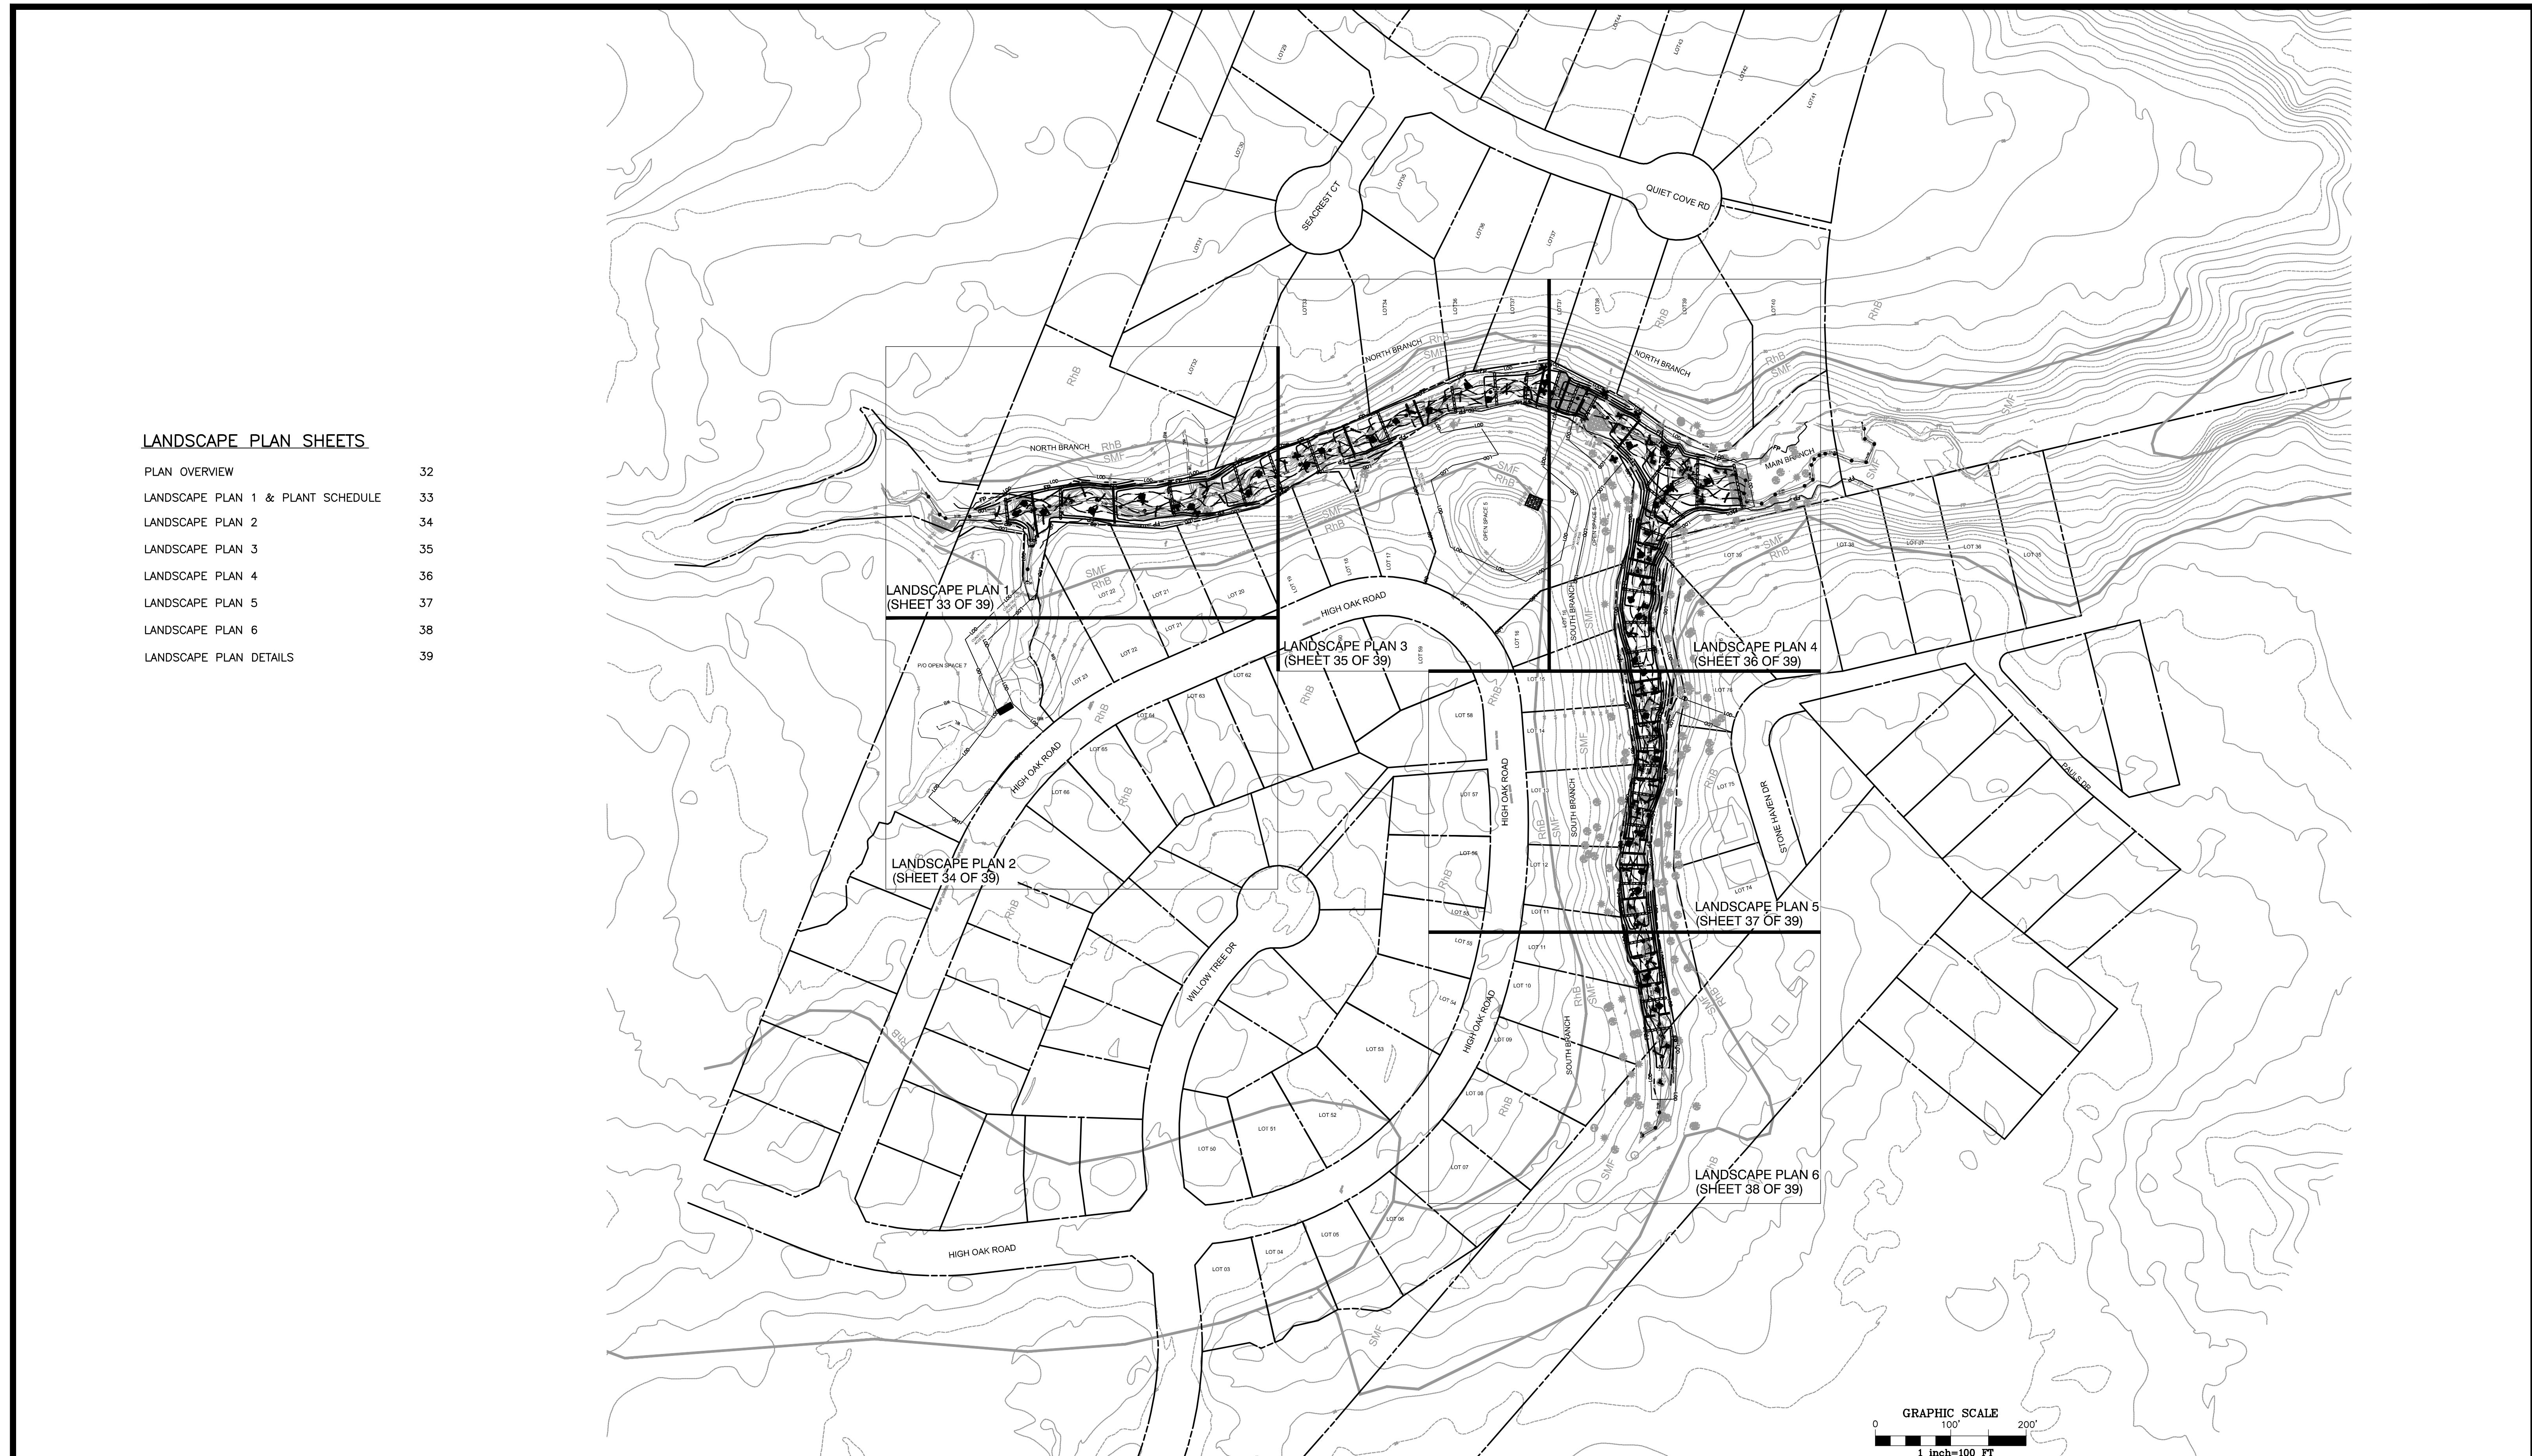

OWNER/DEVELOPER/APPLICANT		CIVIL ENGINEER A.A. County ID #721		REVISIONS		ANNE ARUNDEL COUNTY DEPARTMENT OF PUBLIC WORKS STREAM RESTORATION PLAN						
	717-627-4440 fax: 717-627-4660 landstudies.com 315 North Street Lititz, PA 17543		2101 Gaither Road Suite #340 Rockville, MD 20850 Contact: Joanne M. Cheek, Senior Associate Phone: (301) 337-2856 Fax: (301) 258-7607	2/22/24	Professional Certification: I hereby certify that these documents were prepared or approved by me, and that I am a duly licensed professional engineer under the laws of the State of Maryland, License No. 18095, Expiration Date: 12/21/2022.	NO	Description	BY	DATE	APPROVED DATE	APPROVED DATE	SCALE: As Shown
										DRAWN BY: Bill R. Anchors		
										checked by: J. Cheek		
										sheet no: 32 of 39		
										Project No: 50017963		
										Proposal No:		
										3rd District		
LANDSCAPE PLAN OVERVIEW SLOOP COVE RETROFIT SITE 1										Tax Map 16 Grid 05		
Anne Arundel County												

EXISTING LEGEND

Legend:

- INLET:** Represented by a rectangle.
- STORM:** Represented by a rectangle labeled "SD".
- MH:** Represented by a circle with a stylized "M".
- STORM DRAIN:** Represented by a circle with a diagonal line.
- PROPERTY LINE:** Represented by a dashed line.
- WOOD FENCE:** Represented by a line with square markers.
- CHAIN LINK FENCE:** Represented by a line with circle markers.
- UTILITY POLE:** Represented by a circle with a cross.
- INDEX CONTOUR:** Represented by a dashed line at 30 feet.
- INTERMEDIATE CONTOUR:** Represented by a dashed line at 32 feet.
- DECIDUOUS TREE $\geq 12''$ DBH:** Represented by a tree icon.
- EVERGREEN $\geq 12''$ DBH:** Represented by a sunburst icon.
- EXISTING TREES TO BE REMOVED $\geq 12''$ DIA:** Represented by a crossed-out tree icon.
- RhB:** Represented by a thick grey line.
- SMF:** Represented by a thick grey line.
- SOIL CLASSIFICATION DIVISION LINE:** Represented by a thick grey line.
- FP:** Represented by a line with a vertical tick mark.
- 100-YR FP:** Represented by a line with a vertical tick mark.
- US:** Represented by a line with a vertical tick mark.
- WATER OF THE US:** Represented by a line with a vertical tick mark.
- WL:** Represented by a line with a vertical tick mark.
- WETLAND:** Represented by a line with a vertical tick mark.
- WB:** Represented by a line with a vertical tick mark.
- WETLAND BUFFER:** Represented by a line with a vertical tick mark.
- 1+50:** Represented by a vertical tick mark.
- STREAM ALIGNMENT:** Represented by a line with a vertical tick mark.
- HEAD WALL & RIPRAP:** Represented by a triangle with a stippled pattern.

PROPOSED LEGEND

23

ROCK SILL (RS)

LOG SILL (LS)

SUBSURFACE ARMORING (SA)

WOODY DEBRIS/BUR LOG STRUCURE

LOD

SB-XS# NBT-XS# NB-XS#

LIMITS OF DISTURBANCE

CROSS SECTION

LS-19
22

LOG SILL

RS-16
22

ROCK SILL

FP

1+50

100-YR FP

VALLEY ALIGNMENT

*The theoretical channel system is conceptual. The multiple threads will not be constructed as shown, but represent the individual flow paths that may develop and evolve over time.

LANDSCAPE LEGEND

RSF — REINFORCED SILT FENCE

FL-18 — FILTER LOG

MB — FLOODPLAIN REFORESTATION MOUNTABLE BERM

UPLAND REFORESTATION

WETLAND IMPACT

FLOODPLAIN SEED MIX

STABILIZATION SEED MIX

LANDSCAPE LEGEND

A cross-section diagram of a soil profile. The top layer is a dotted pattern labeled 'FLOODPLAIN SEED'. The bottom layer is a hexagonal pattern labeled 'STABILIZATION SEED'.

NORTH BRANCH

ANNE ARUNDEL COUNTY
C/O OFFICE OF REAL EST MTG1
2.06 ACRES SC 1 FLOOD PLAIN
WILLOW RUN
L.07940 F.00037
EXEMPT

UPLAND REFORESTATION AREA 8

CONSTRUCTION ACCESS

LOT 32
STUDHAM, ROBERT E
STUDHAM, MARY K
L.17713 F.00356
RESIDENTIAL

LOT 22
BENSON, ERIC W
BENSON, JENNIFER
LOT 22 SC 1
WILLOW RUN
L.17785 F.00402
RESIDENTIAL

LOT 21
MASON, WELIN W
MASON, ELIZABETH JOY
LOT 21 SC 1
WILLOW RUN
L.22516 F.00244
RESIDENTIAL

LOT 20
WILKERSON, RAYMOND D
LOT 20 SC 1
WILLOW RUN
L.09358 F.00687
RESIDENTIAL

MATCHLINE LANDSCAPE PLAN 2 (SHEET 34 OF 39)

A graphic scale consisting of a horizontal line with two thick black segments. The first segment is labeled '20'' above it. The second segment is labeled '40'' above it. The line is divided into smaller, unlabeled segments by thin vertical lines.

OWNER/DEVELOPER/APPLICANT

A business card for Dewberry. The card features a purple circular logo on the left. To the right of the logo, the company name 'Dewberry' is written in a large, bold, black, sans-serif font. Below the name, the address '2101 Gaither Road' is followed by 'Suite #340' and 'Rockville, MD 20850'. To the right of the address, the text 'CIVIL ENGINEER' and 'A.A. County ID #721' is printed. At the bottom, the contact information 'Contact: Joanne M. Cheok, Senior Associate' and 'Phone: (301) 777-2856' is provided. The card is bordered by a thick black line.


Professional Certification
certify that these documents
prepared or approved by
that I am a duly licensed
professional engineer under
laws of the State of Maine.

n: I hereby
ments were
y me, and
ed
nder the
aryland,

ANNE ARUNDEL COUNTY
DEPARTMENT OF PUBLIC WORKS

LANDSCAPE PLAN 1 & PLANT SCHEDULE


SLOOP COVE RETROFIT SITE 1

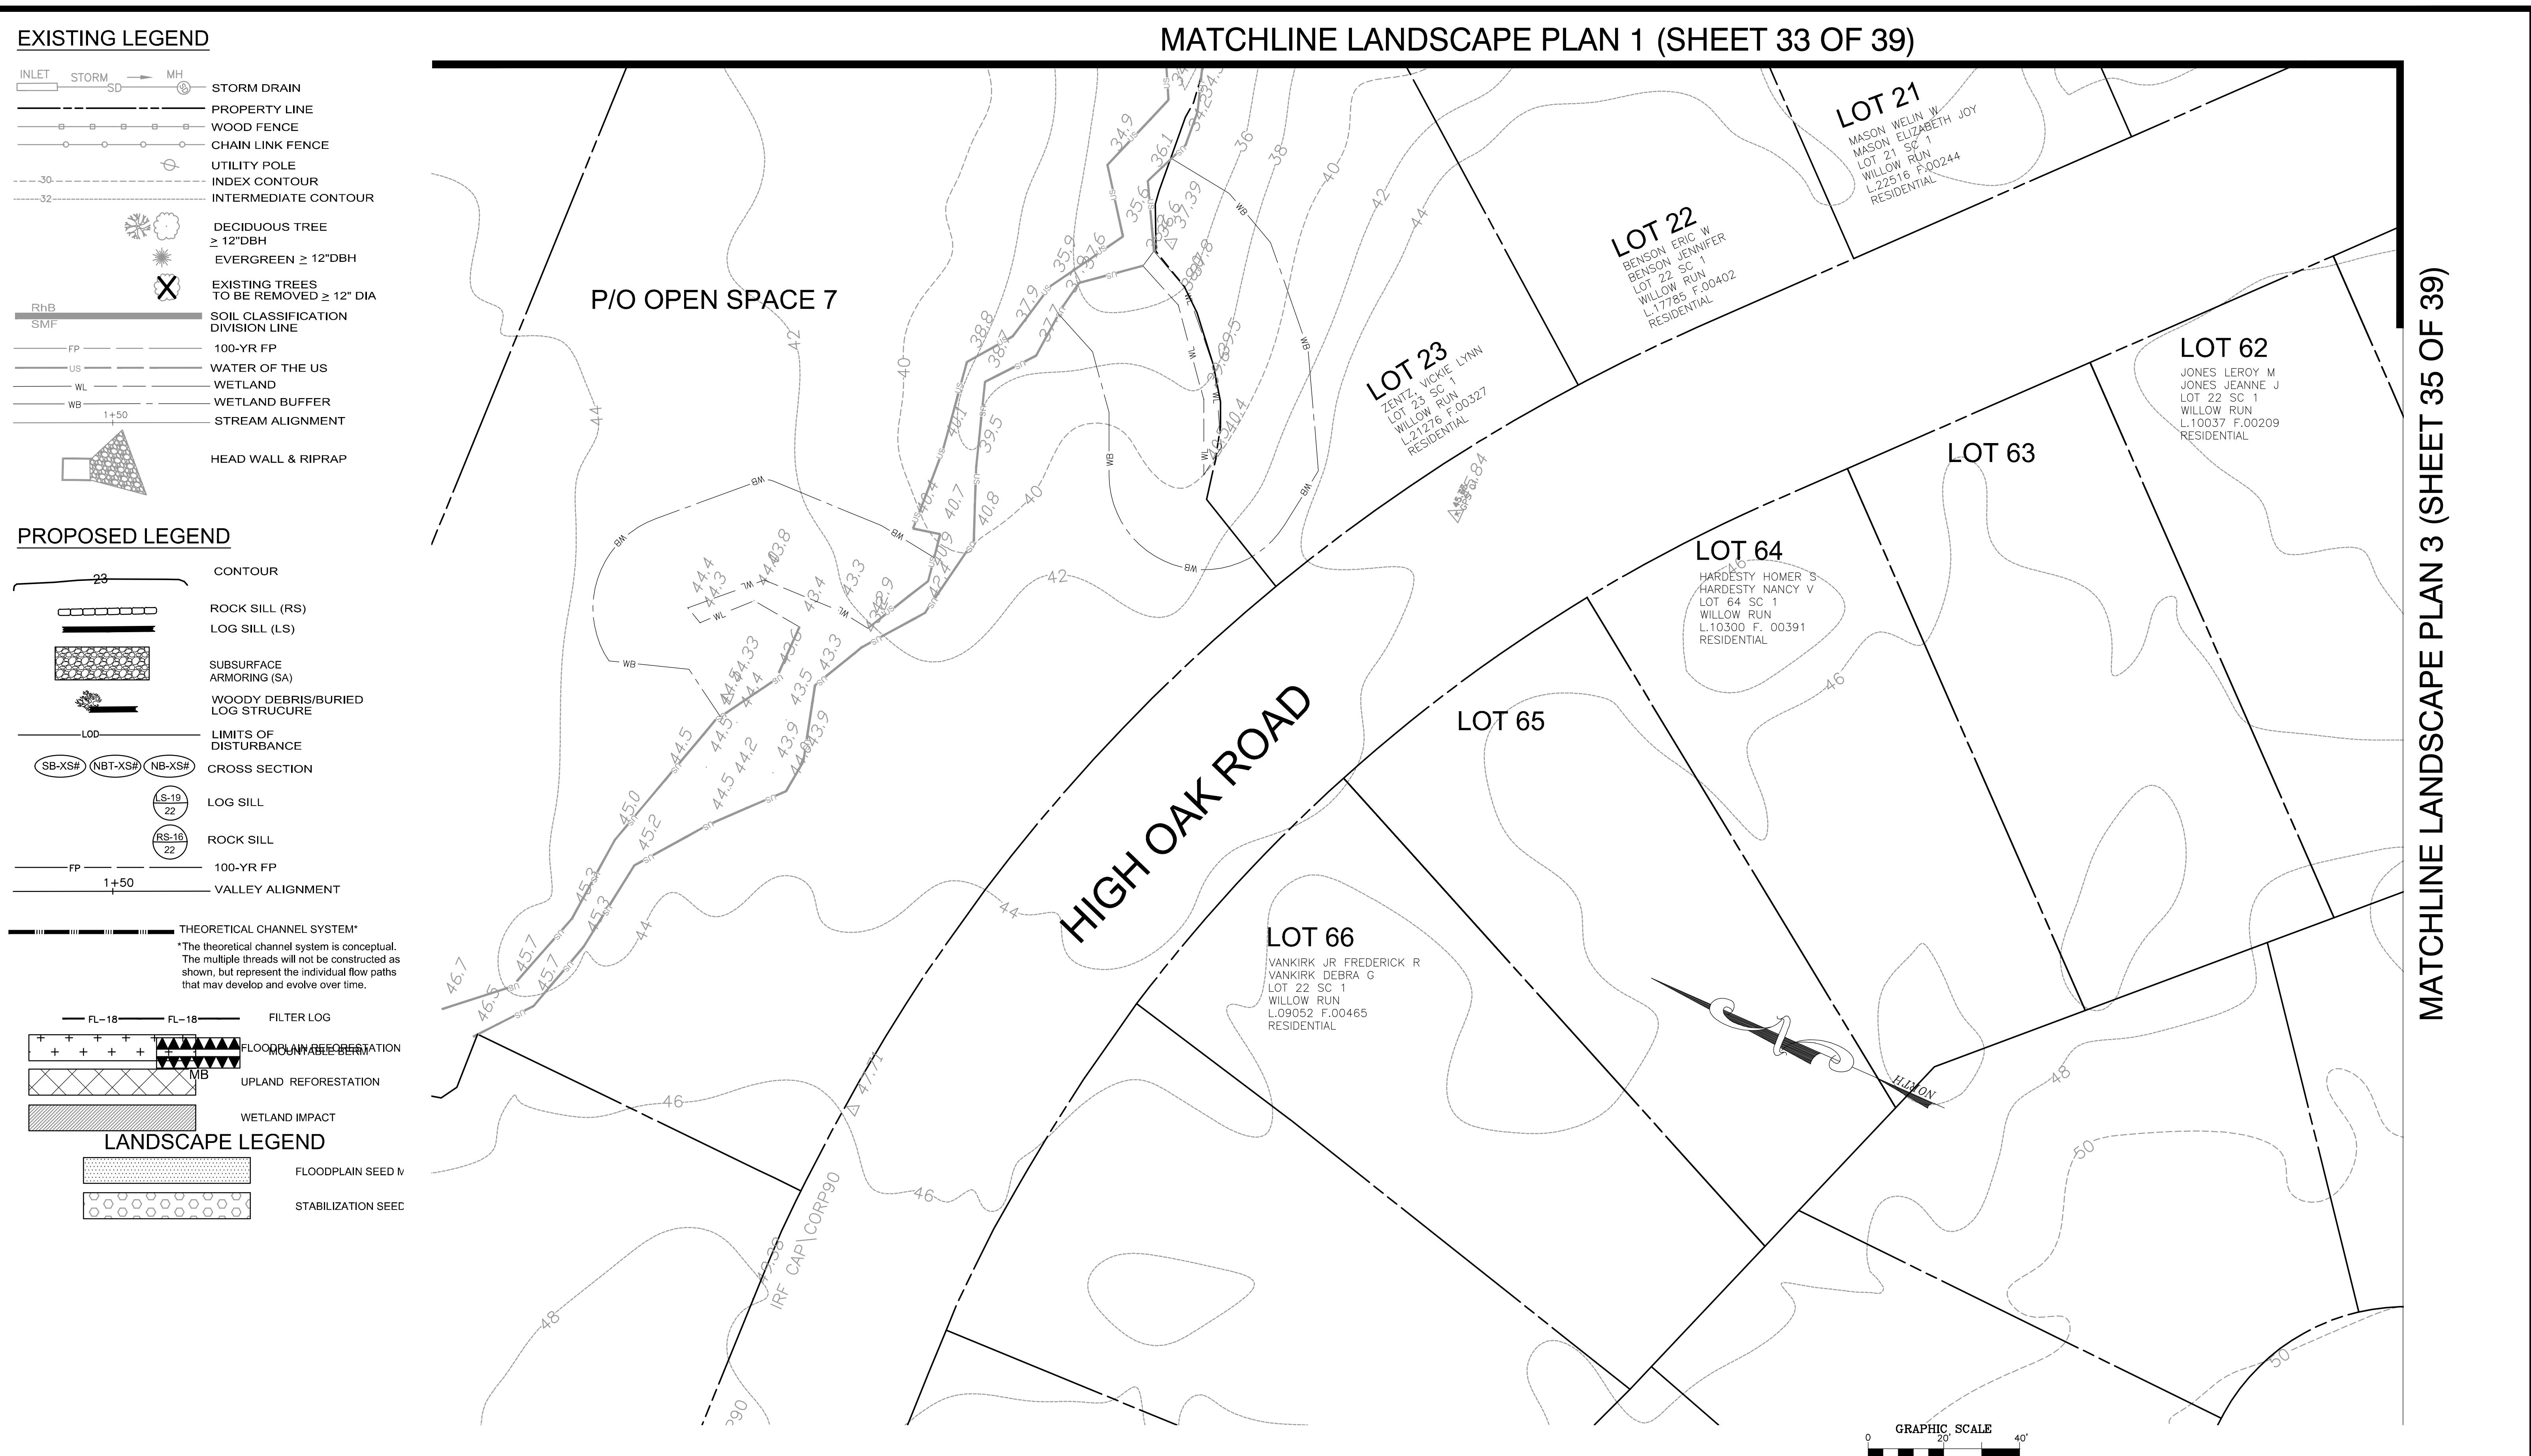


OWNER/DEVELOPER/APPLICANT		CIVIL ENGINEER A.A. County ID #721		REVISIONS	ANNE ARUNDEL COUNTY						
OWNER/DEVELOPER/APPLICANT	CIVIL ENGINEER	NO.	Description	BY	DATE	DEPARTMENT OF PUBLIC WORKS					
Land Studies 717-627-4440 fax: 717-627-4660 landstudies.com 315 North Street Lititz, PA 17543	Dewberry 2101 Gaither Road Suite #340 Rockville, MD 20850 Contact: Joanne M. Cheek, Senior Associate Phone: (301) 337-2856 Fax: (301) 258-7607	2/27/24	Professional Certification: I hereby certify that these documents were prepared or approved by me, and that I am a duly licensed professional engineer under the laws of the State of Maryland, License No. 18095, Expiration Date: 12/21/2022.	APPROVED	DATE	APPROVED	DATE	STREAM RESTORATION PLAN			
				CHIEF ENGINEER		PROJECT MANAGER					
				APPROVED	DATE	APPROVED	DATE	SHEET NO. 34	OF 39		
				ASSISTANT CHIEF ENGINEER		CHIEF, RIGHT OF WAY		PROJECT NO. 50017963		PROPOSAL NO:	
								3rd District			
LANDSCAPE PLAN 2						SLOOP COVE RETROFIT SITE 1				Anne Arundel County	
Tax Map 16 Grid 05											

MATCHLINE LANDSCAPE PLAN 1 (SHEET 33 OF 39)


EXISTING LEGEND

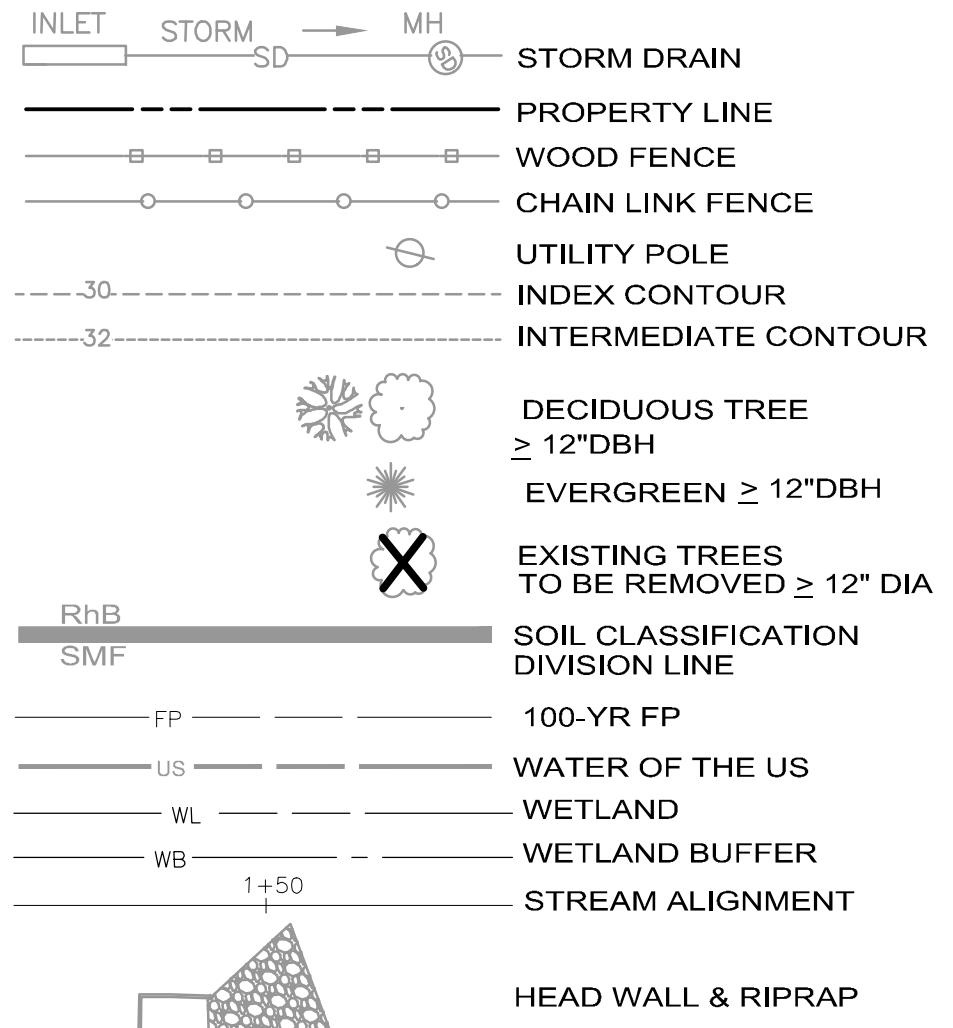


PROPOSED LEGEND

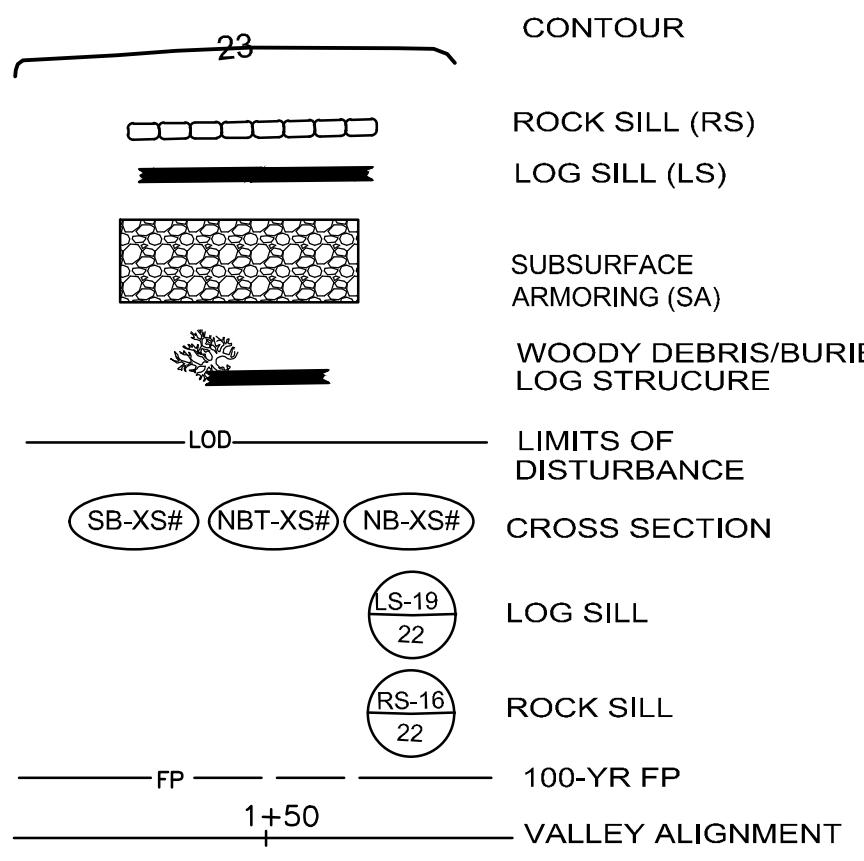

*The theoretical channel system is conceptual. The multiple threads will not be constructed as shown, but represent the individual flow paths that may develop and evolve over time.

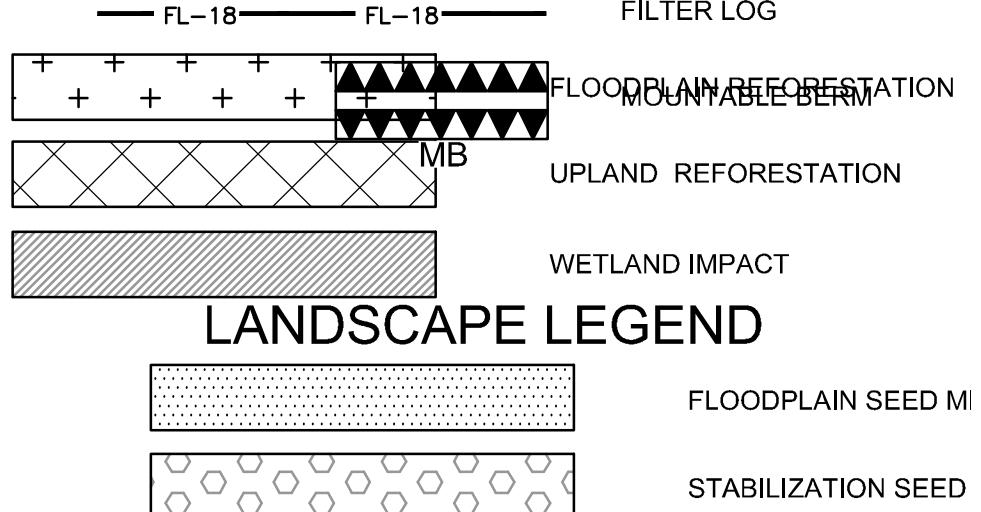

MATCHLINE LANDSCAPE PLAN 5 (SHEET 37 OF 39)

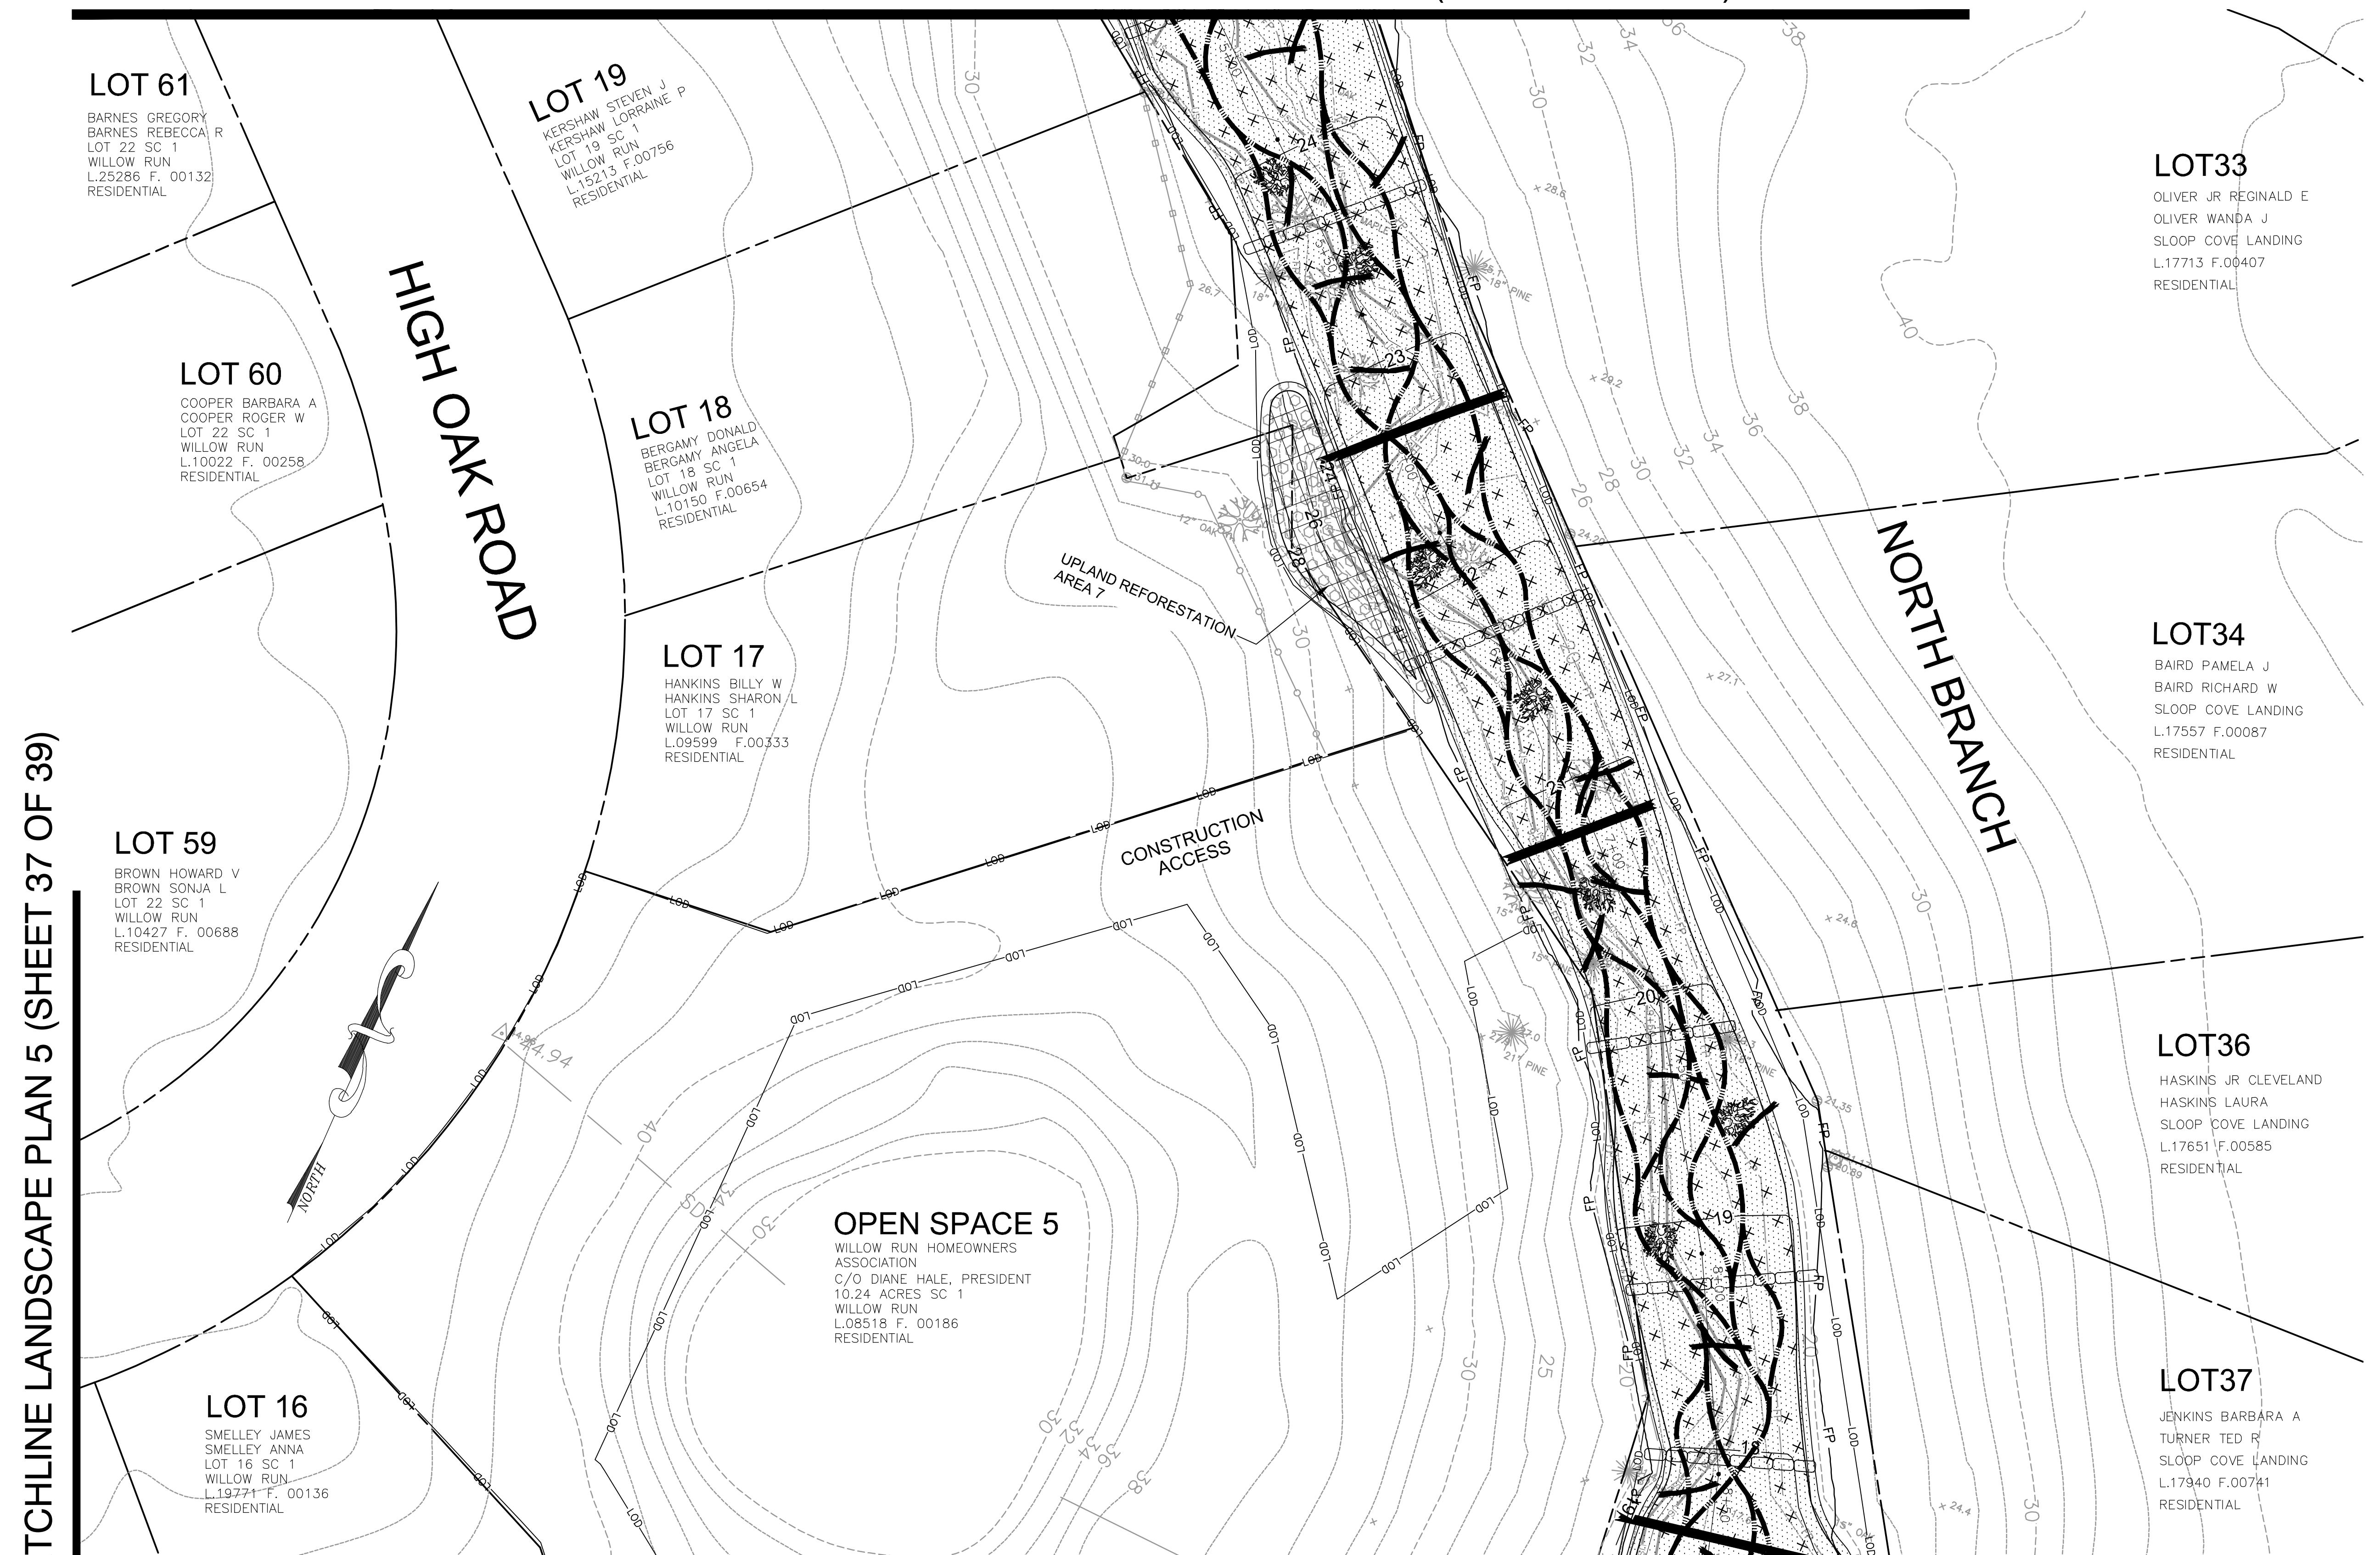


MATCHLINE LANDSCAPE PLAN 4 (SHEET 36 OF 39)


OWNER/DEVELOPER/APPLICANT		CIVIL ENGINEER A.A. County ID #721		REVISIONS				ANNE ARUNDEL COUNTY															
717-627-4440 fax: 717-627-4660 landstudies.com 315 North Street Lititz, PA 17543	 Dewberry 2101 Gaither Road Suite #340 Rockville, MD 20850 Contact: Joanne M. Cheek, Senior Associate Phone: (301) 337-2856 Fax: (301) 258-7607		Professional Certification: I hereby certify that these documents were prepared or approved by me, and that I am a duly licensed professional engineer under the laws of the State of Maryland, License No. 18095, Expiration Date: 12/21/2022.	NO	Description	BY	DATE	DEPARTMENT OF PUBLIC WORKS															
				APPROVED	DATE	APPROVED	DATE	STREAM RESTORATION PLAN															
<table border="1"> <tr> <td>CHIEF ENGINEER</td> <td>PROJECT MANAGER</td> <td>CHECKED BY: J. Cheek</td> <td>SHEET NO.: 35 OF 39</td> </tr> <tr> <td>APPROVED</td><td>DATE</td><td>APPROVED</td><td>PROPOSAL NO.: 50017963</td> </tr> <tr> <td>ASSISTANT CHIEF ENGINEER</td><td>CHIEF, RIGHT OF WAY</td><td>3rd District</td><td>Tax Map 16 Grid 05</td> </tr> </table>										CHIEF ENGINEER	PROJECT MANAGER	CHECKED BY: J. Cheek	SHEET NO.: 35 OF 39	APPROVED	DATE	APPROVED	PROPOSAL NO.: 50017963	ASSISTANT CHIEF ENGINEER	CHIEF, RIGHT OF WAY	3rd District	Tax Map 16 Grid 05	LANDSCAPE PLAN 3 SLOOP COVE RETROFIT SITE 1	
CHIEF ENGINEER	PROJECT MANAGER	CHECKED BY: J. Cheek	SHEET NO.: 35 OF 39																				
APPROVED	DATE	APPROVED	PROPOSAL NO.: 50017963																				
ASSISTANT CHIEF ENGINEER	CHIEF, RIGHT OF WAY	3rd District	Tax Map 16 Grid 05																				
Anne Arundel County										Anne Arundel County													

MATCHLINE LANDSCAPE PLAN 3 (SHEET 35 OF 39)


EXISTING LEGEND

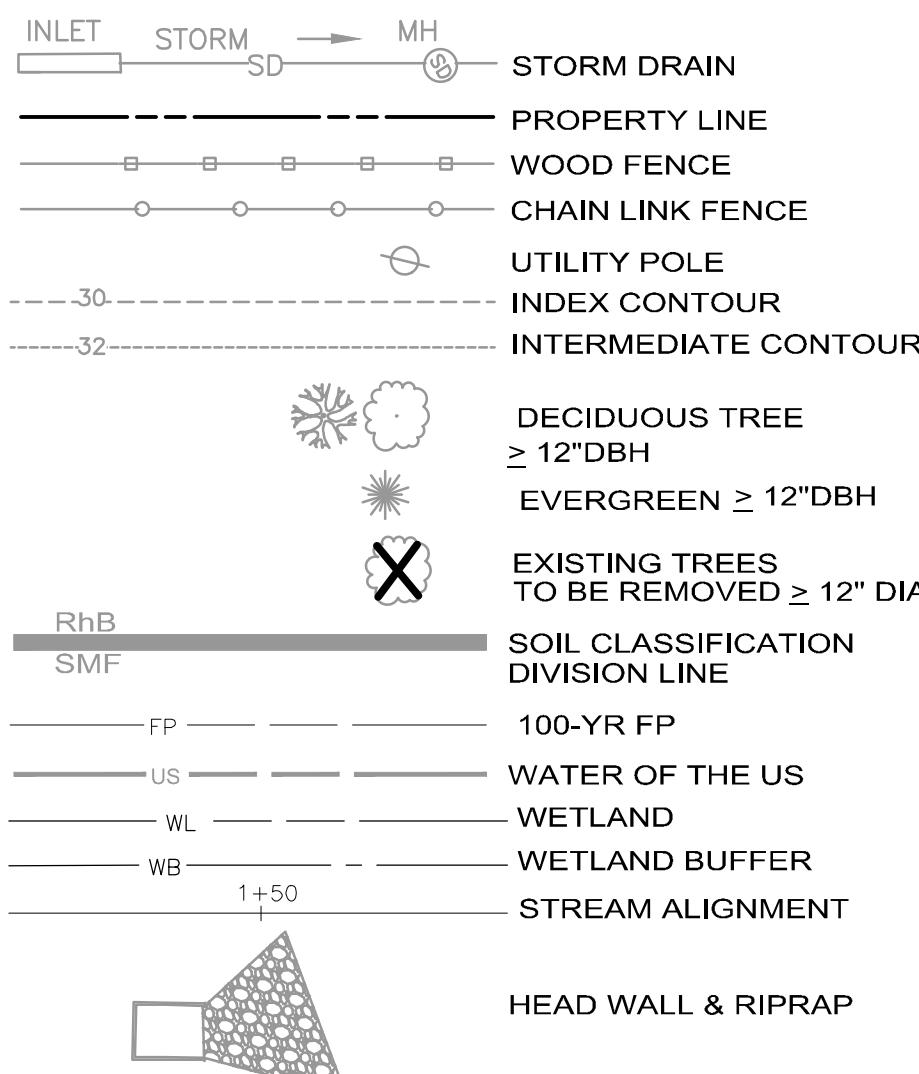


PROPOSED LEGEND

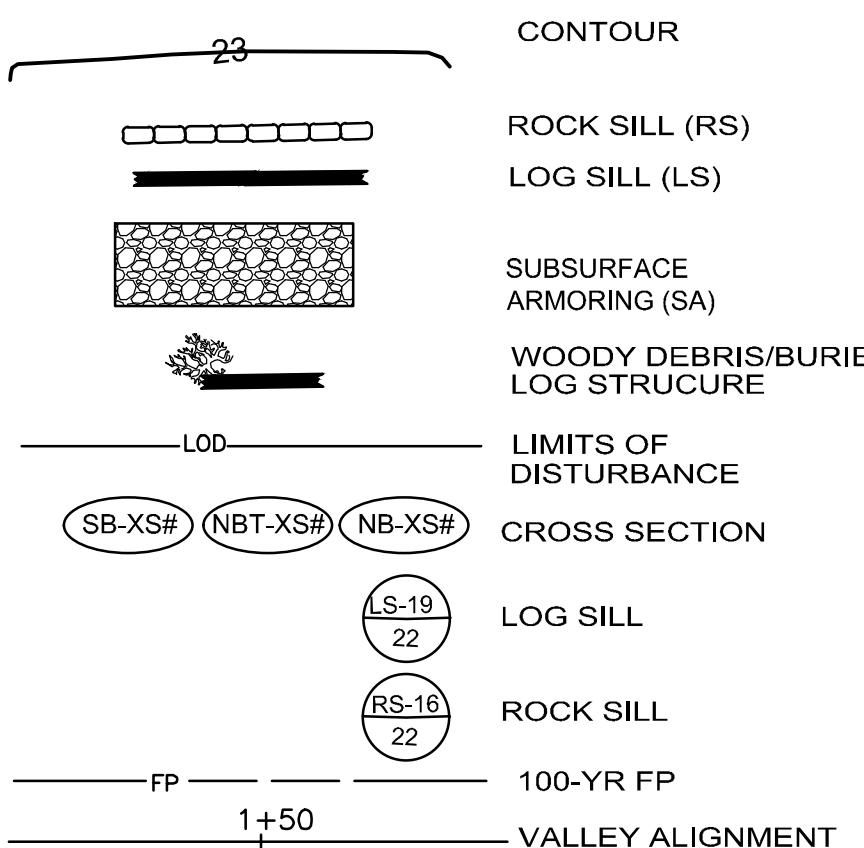


LANDSCAPE LEGEND

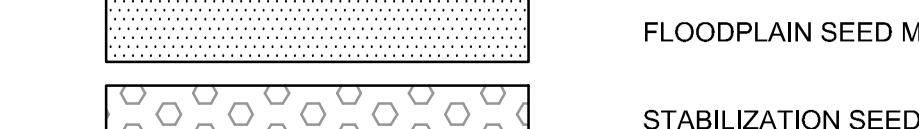

MATCHLINE LANDSCAPE PLAN 5 (SHEET 37 OF 39)

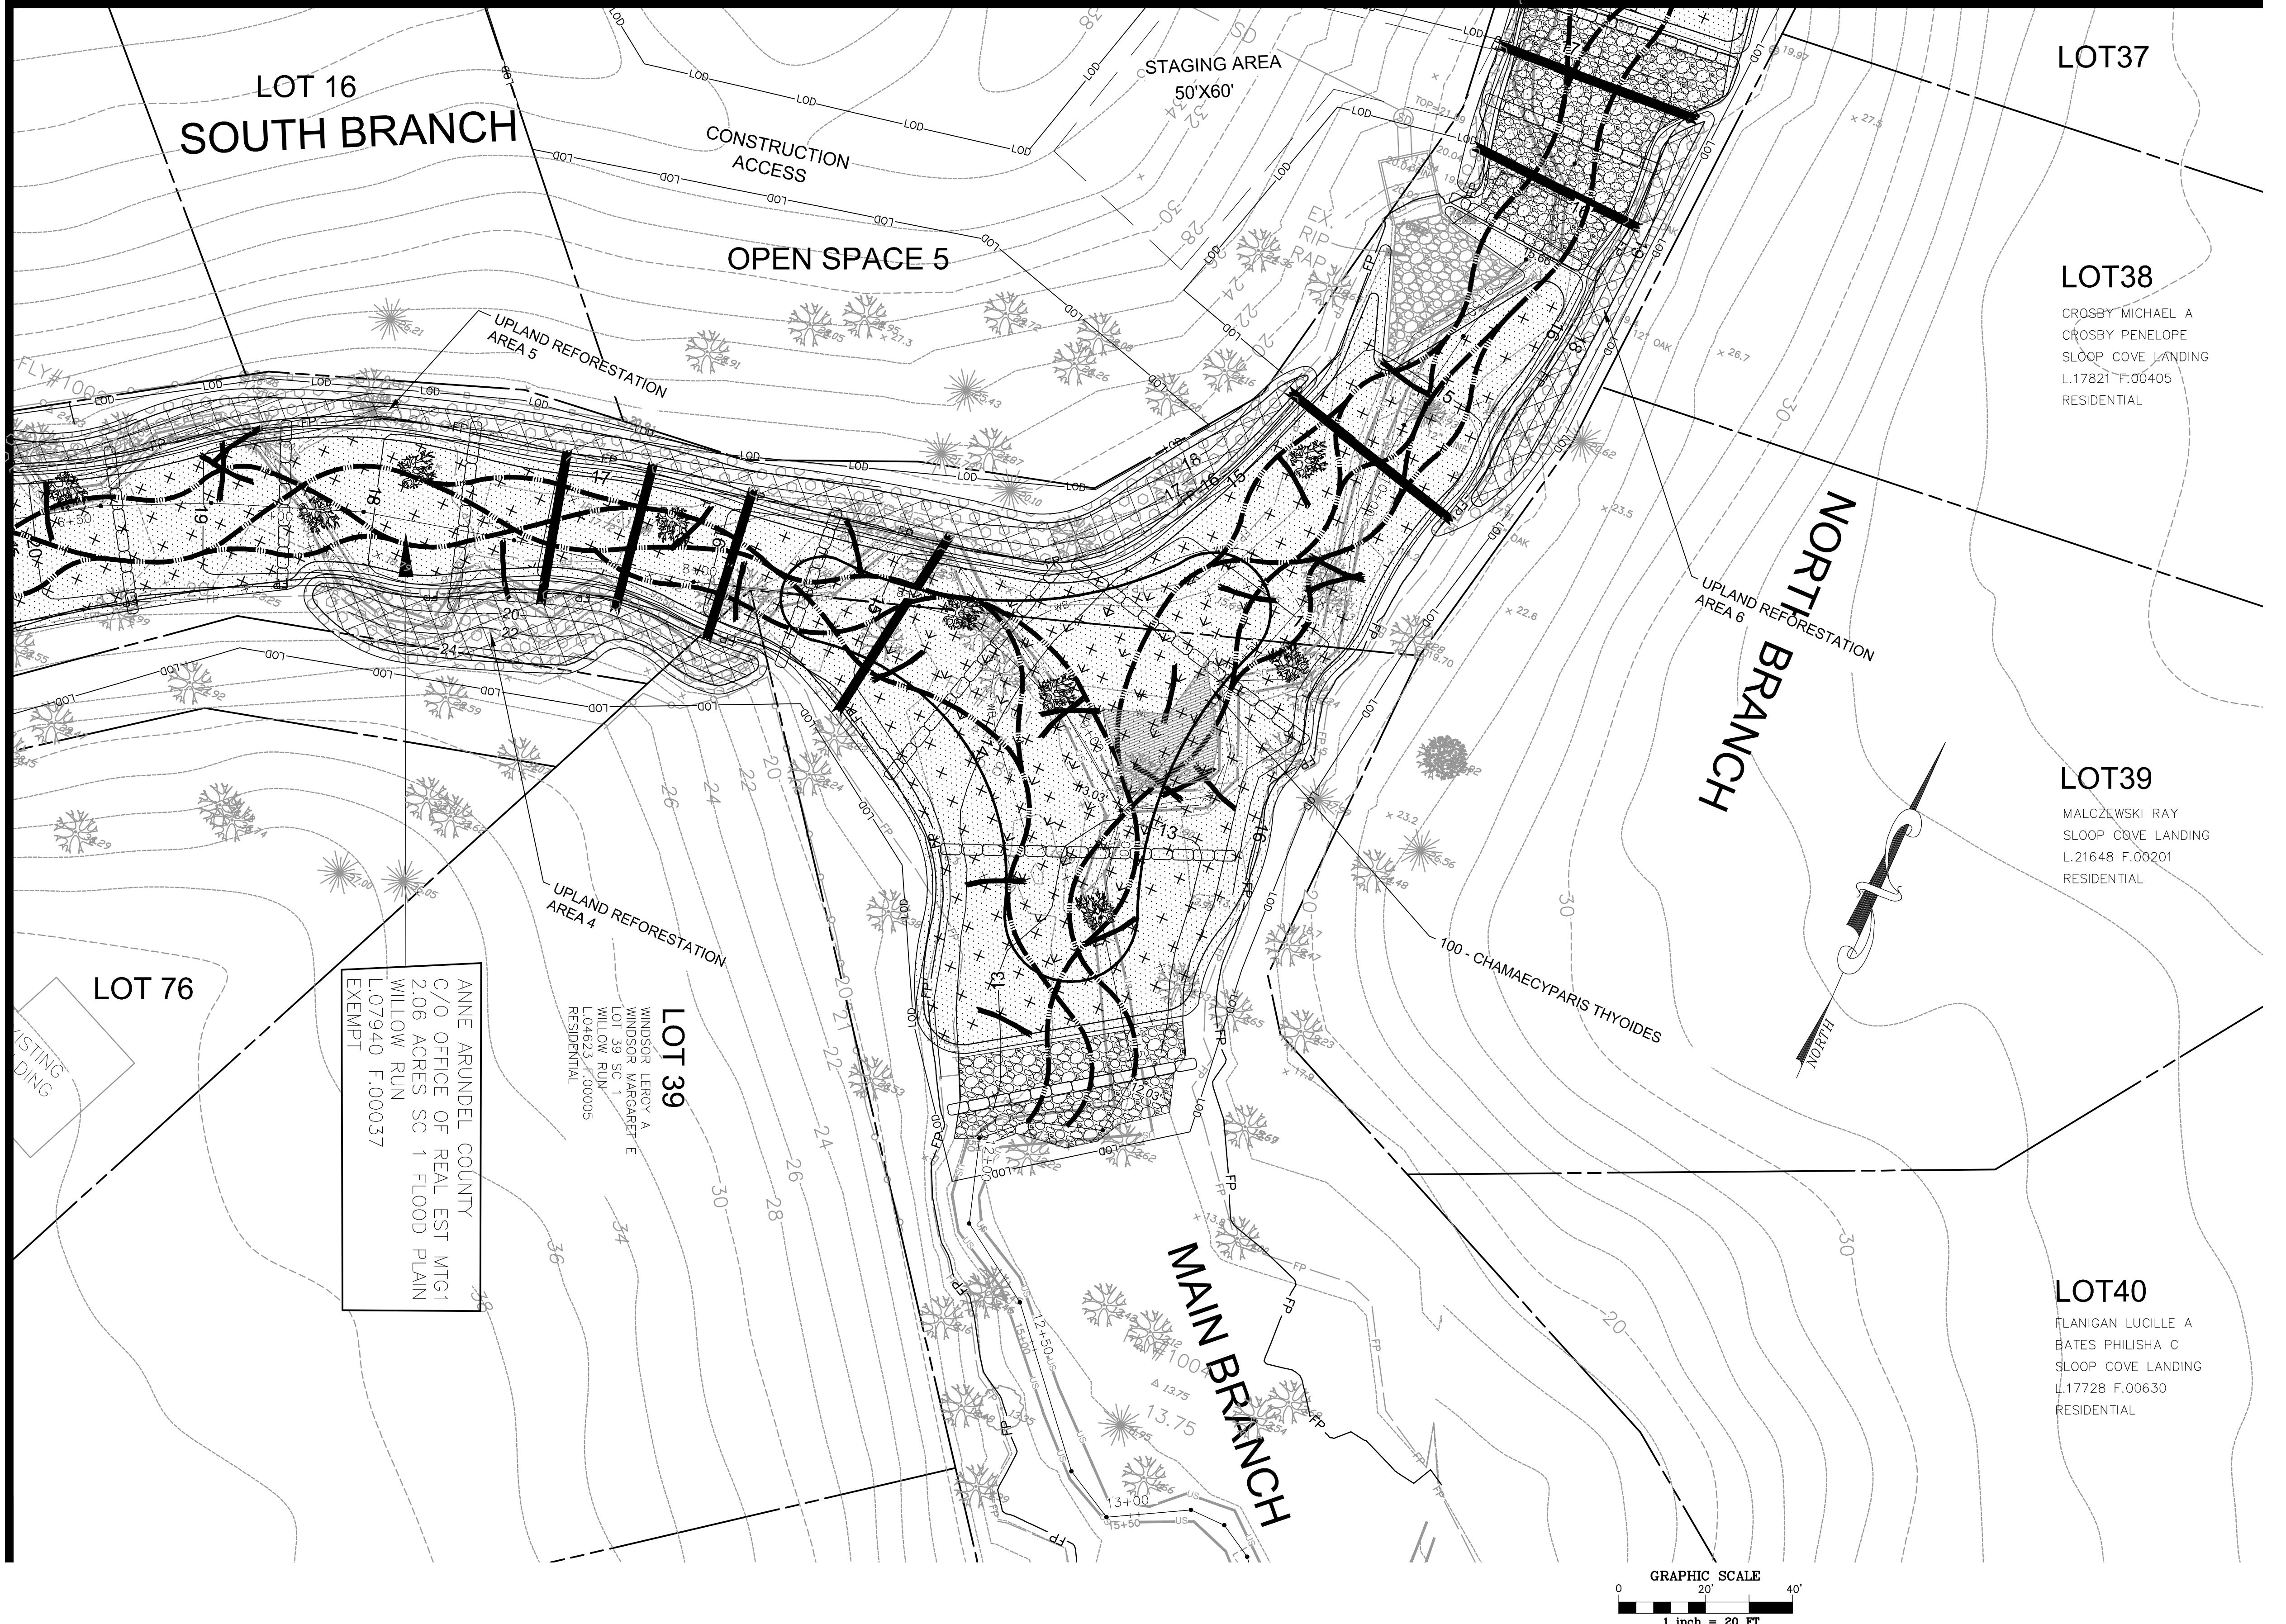


OWNER/DEVELOPER/APPLICANT

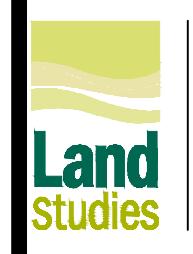

717-627-4440
fax: 717-627-4660
landstudies.com
315 North Street | Lititz, PA 17543

Dewberry
2101 Gaither Road
Suite #340
Rockville, MD 20850
Contact: Joanne M. Cheek, Senior Associate
Phone: (301) 337-2856
Fax: (301) 258-7607

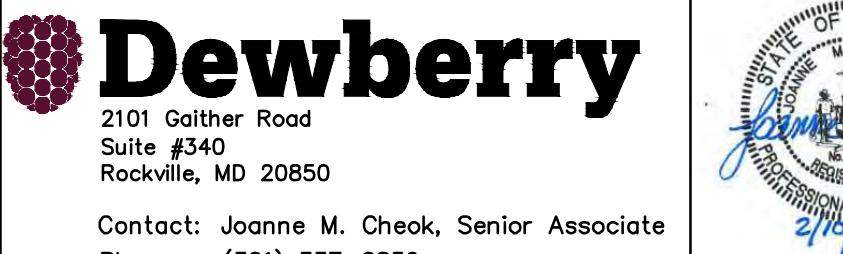

CIVIL ENGINEER

A.A. County ID #721

Professional Certification: I hereby certify that these documents were prepared or approved by me, and that I am a duly licensed professional engineer under the laws of the State of Maryland, License No. 18095, Expiration Date: 12/21/2022.

REVISIONS

NO	Description	BY	DATE
		APPROVED	DATE
		APPROVED	DATE
		CHIEF ENGINEER	PROJECT MANAGER
		APPROVED	APPROVED
		ASSISTANT CHIEF ENGINEER	CHIEF, RIGHT OF WAY



ANNE ARUNDEL COUNTY

DEPARTMENT OF PUBLIC WORKS



STREAM RESTORATION PLAN

LANDSCAPE PLAN 4
SLOOP COVE RETROFIT SITE 1
3rd District
Tax Map 16 Grid 05

Anne Arundel County

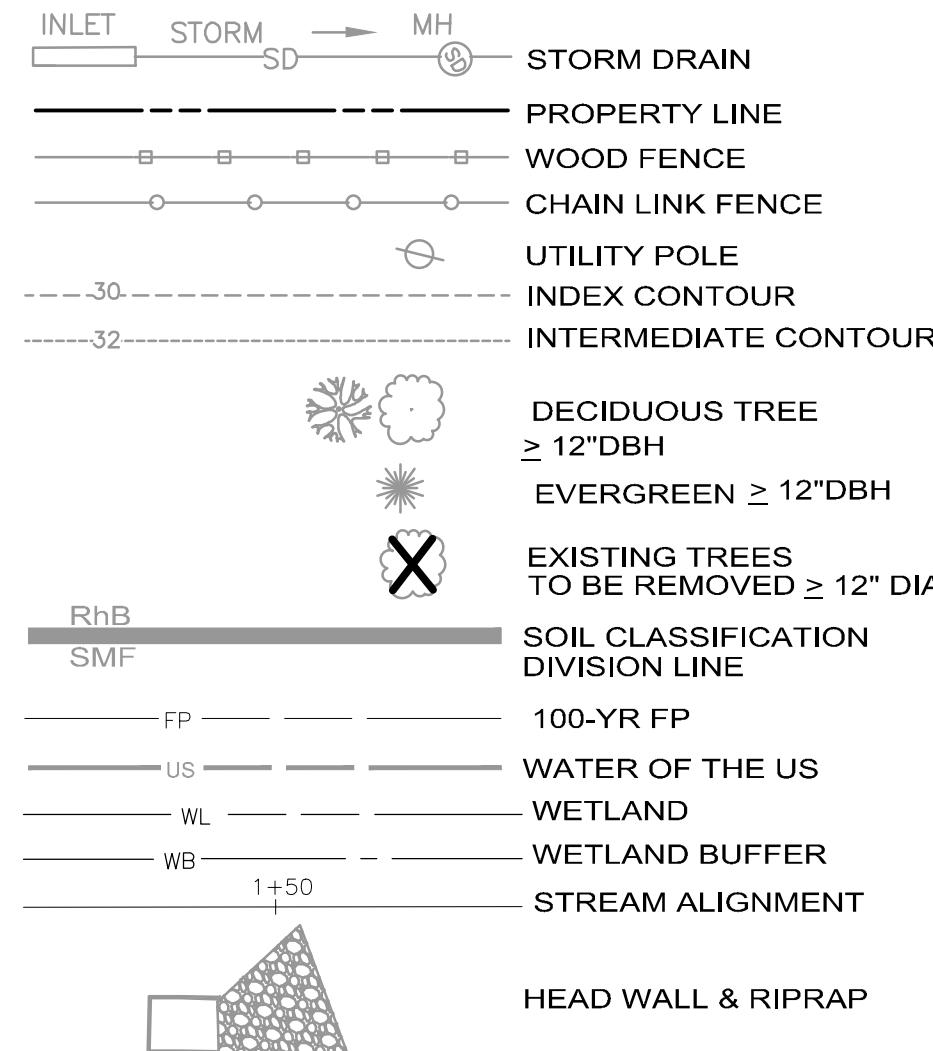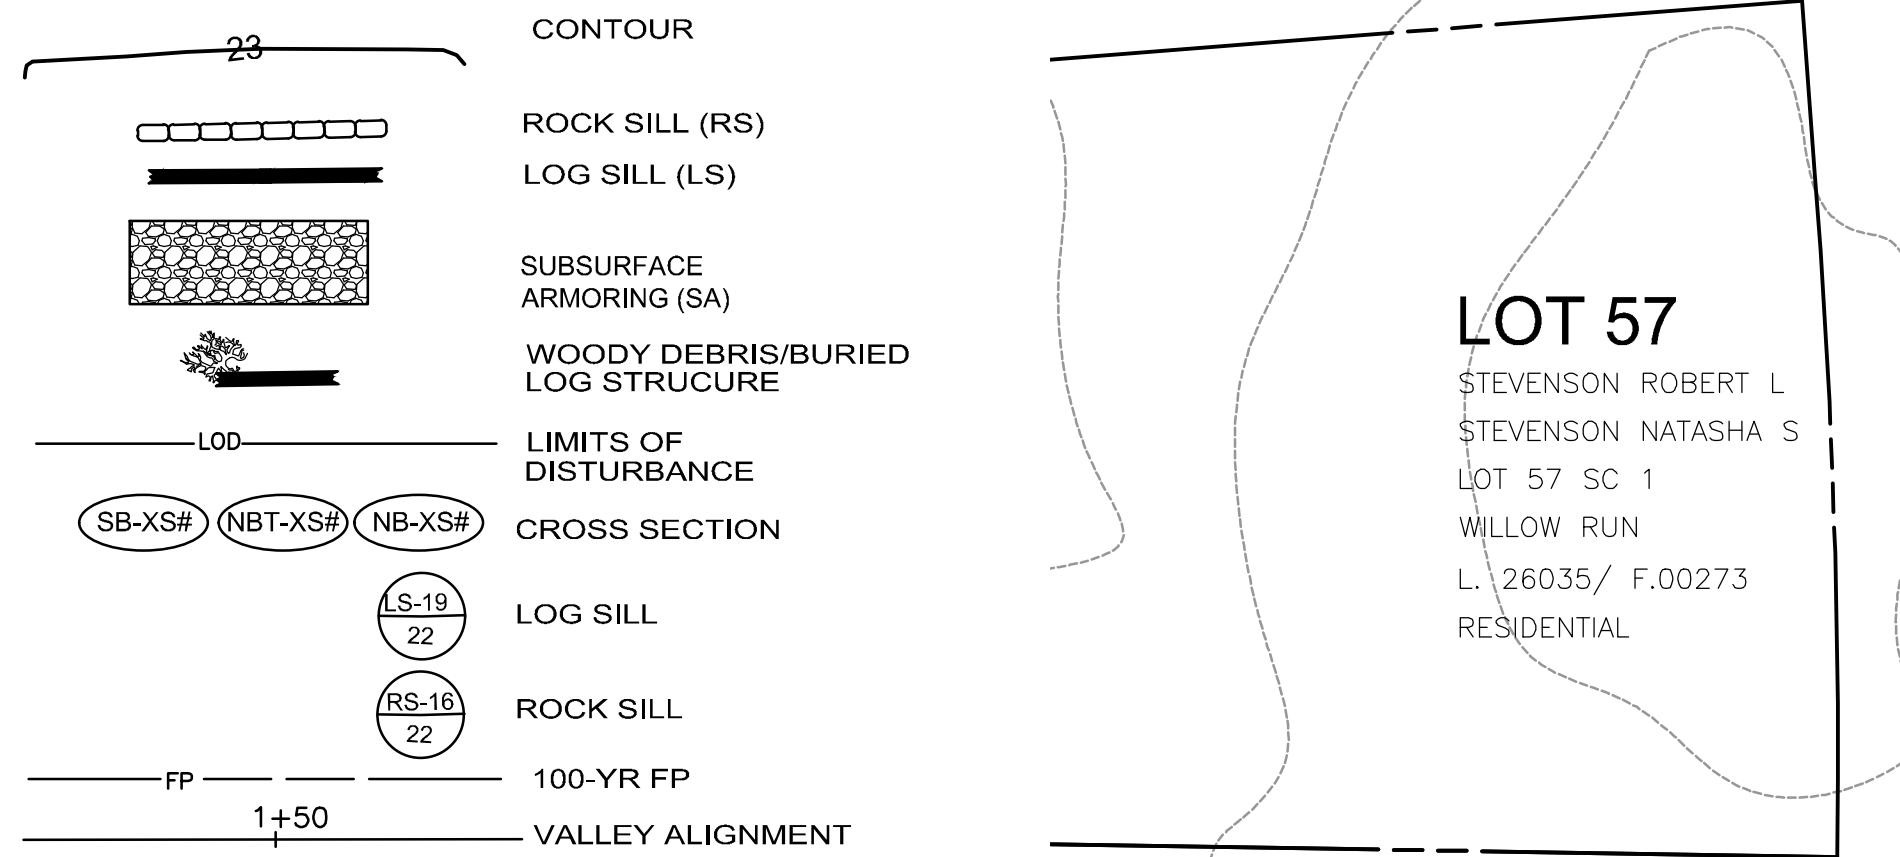EXISTING LEGEND

PROPOSED LEGEND

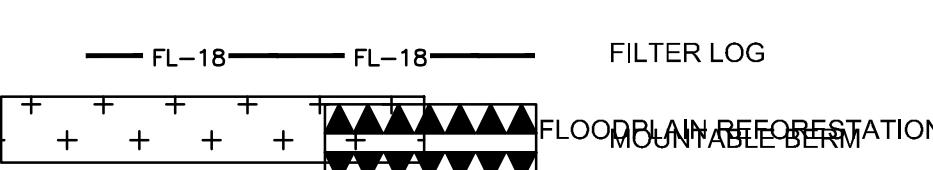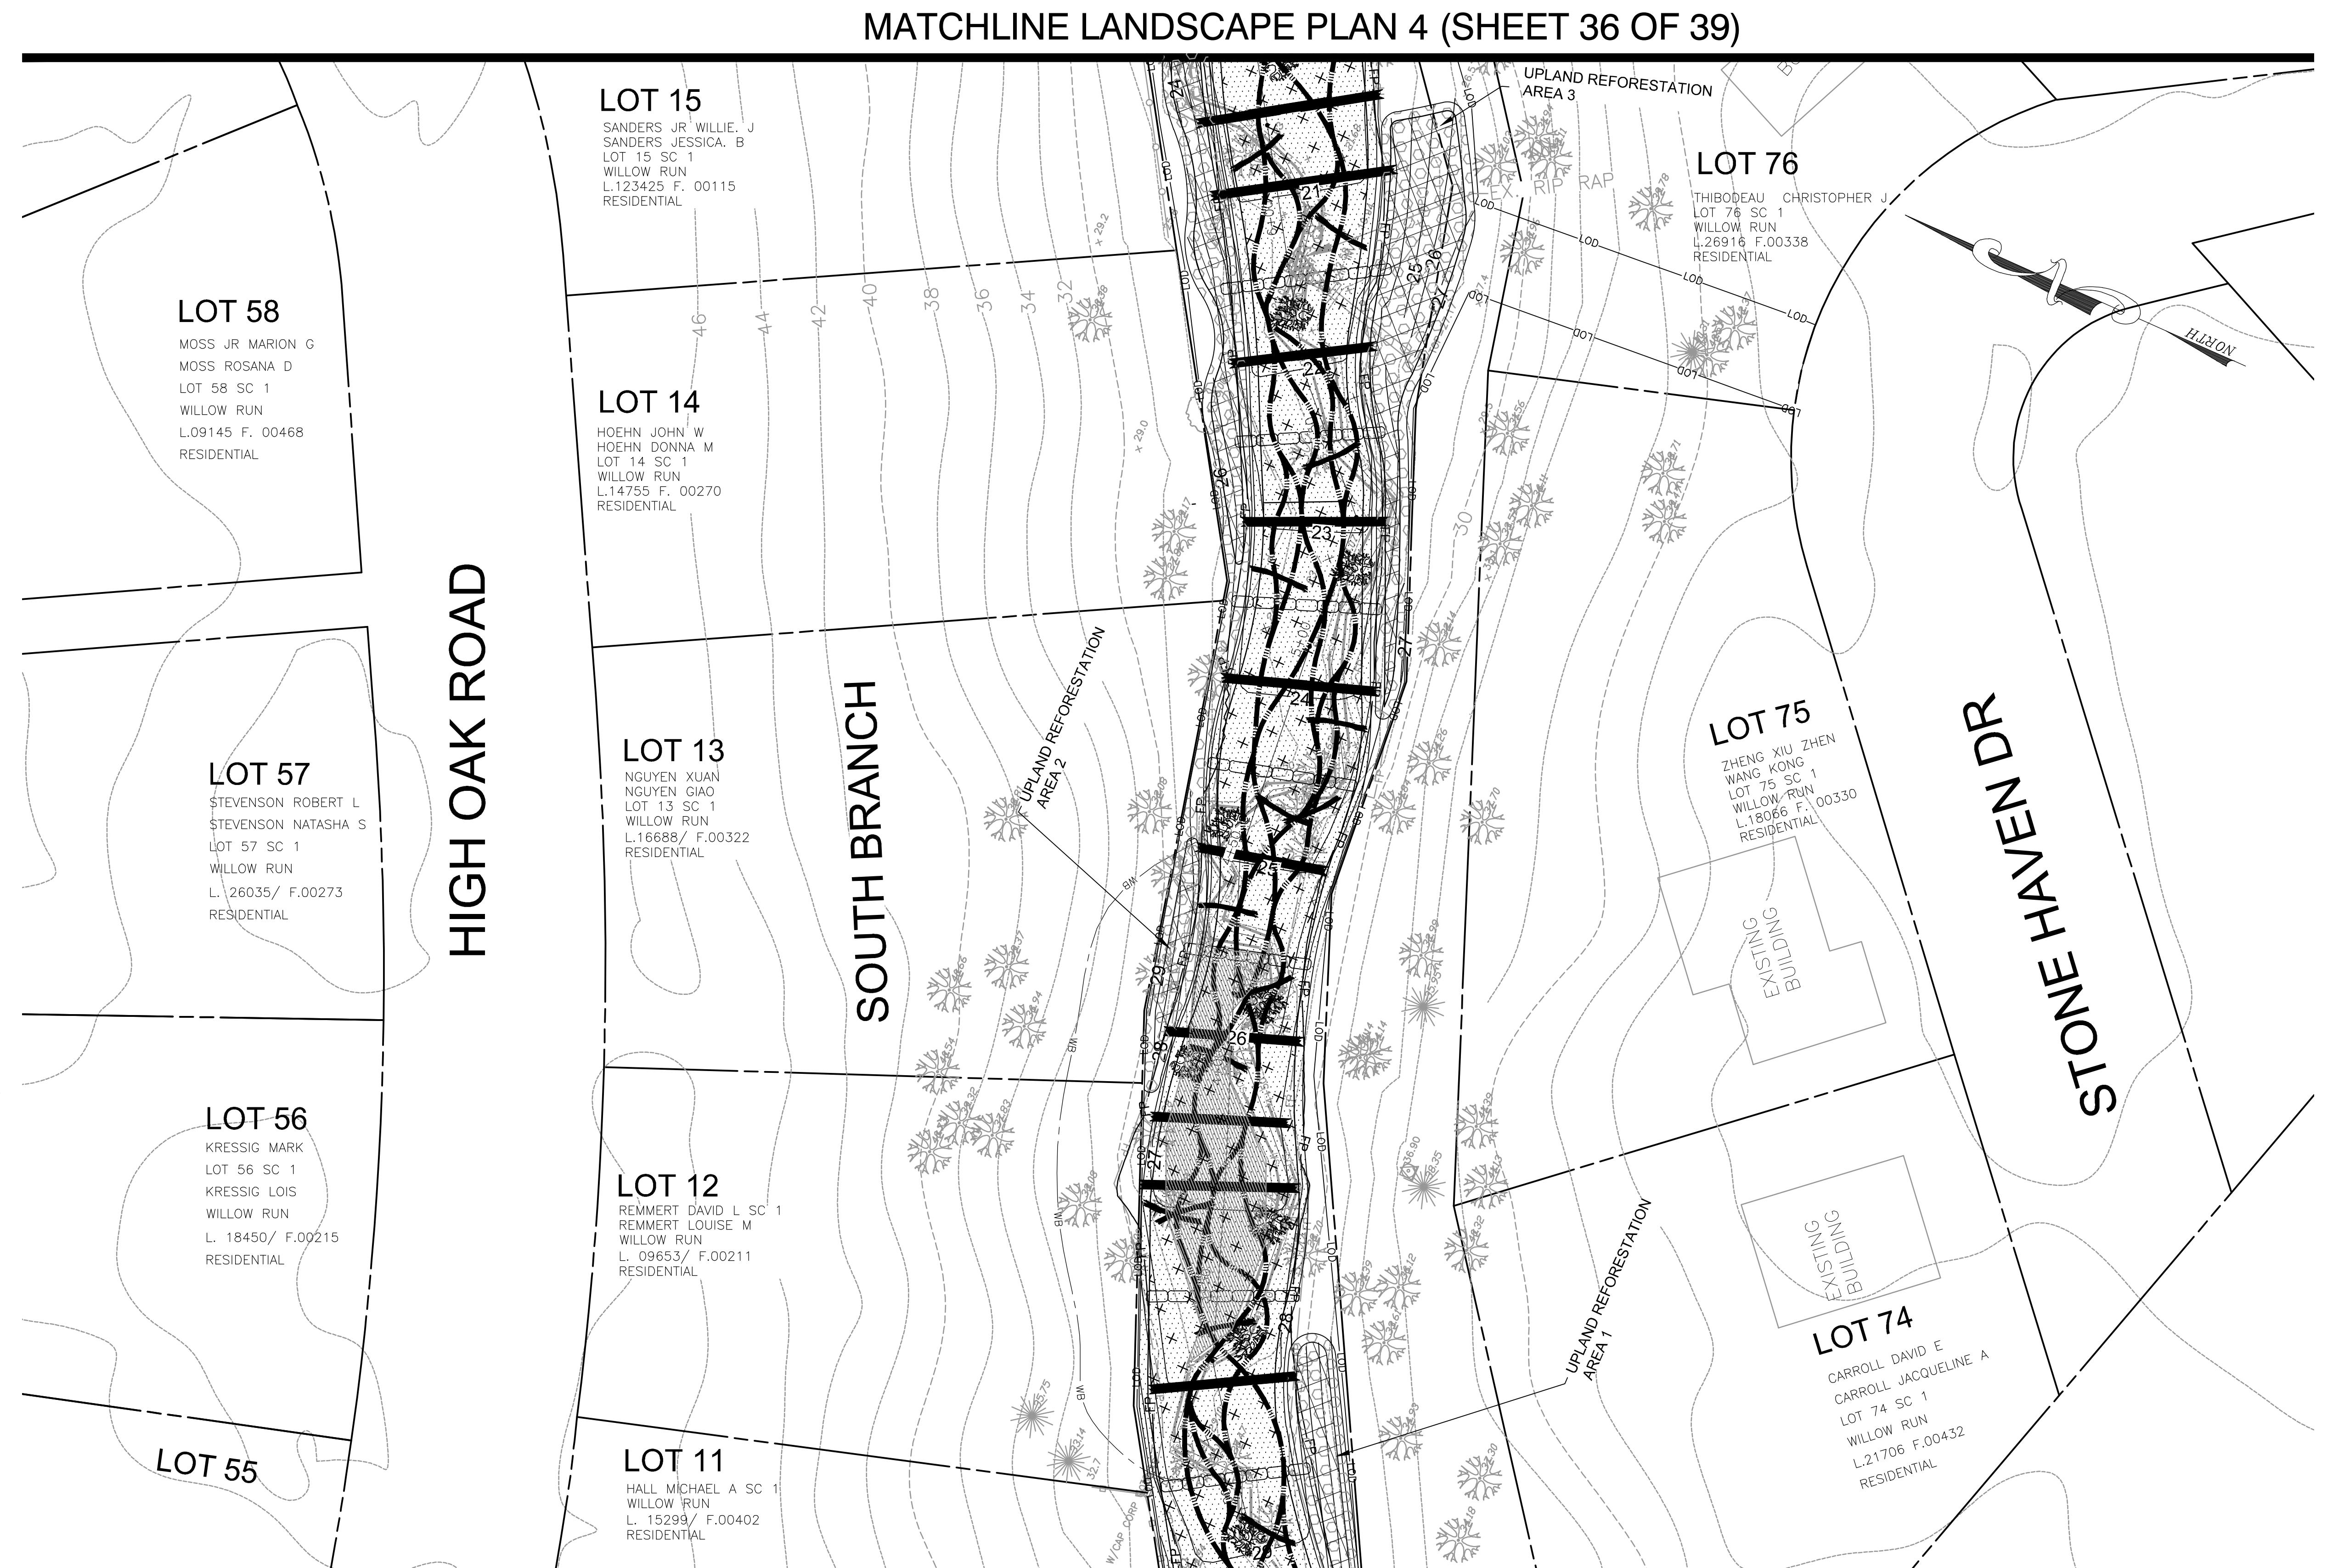
THEORETICAL CHANNEL SYSTEM*
*The theoretical channel system is conceptual. The multiple threads will not be constructed as shown, but represent the individual flow paths that may develop and evolve over time.


LANDSCAPE LEGEND


GRAPHIC SCALE


0 20' 40'

1 inch = 20 FT


OWNER/DEVELOPER/APPLICANT		CIVIL ENGINEER A.A. County ID #721		REVISIONS		ANNE ARUNDEL COUNTY DEPARTMENT OF PUBLIC WORKS STREAM RESTORATION PLAN							
717-627-4440 fax: 717-627-4660 landstudies.com 315 North Street Lititz, PA 17543	222744 Dewberry 2101 Gaither Road Suite #340 Rockville, MD 20850 Contact: Joanne M. Cheek, Senior Associate Phone: (301) 337-2856 Fax: (301) 258-7607			NO	Description	BY	DATE	APPROVED	DATE	APPROVED	DATE	SCALE: As Shown	STREAM RESTORATION PLAN
								CHIEF ENGINEER	PROJECT MANAGER	CHECKED BY: J. Cheek		DRAWN BY: Buff/R. Anchors	
								APPROVED	DATE	APPROVED	DATE	SHEET NO: 37 OF 39	
								ASSISTANT CHIEF ENGINEER	CHIEF, RIGHT OF WAY	PROPOSAL NO:		PROJECT NO: 50017963	
												3rd District	
LANDSCAPE PLAN 5 SLOOP COVE RETROFIT SITE 1												Tax Map 16 Grid 05	Anne Arundel County

MATCHLINE LANDSCAPE PLAN 4 (SHEET 36 OF 39)


EXISTING LEGEND

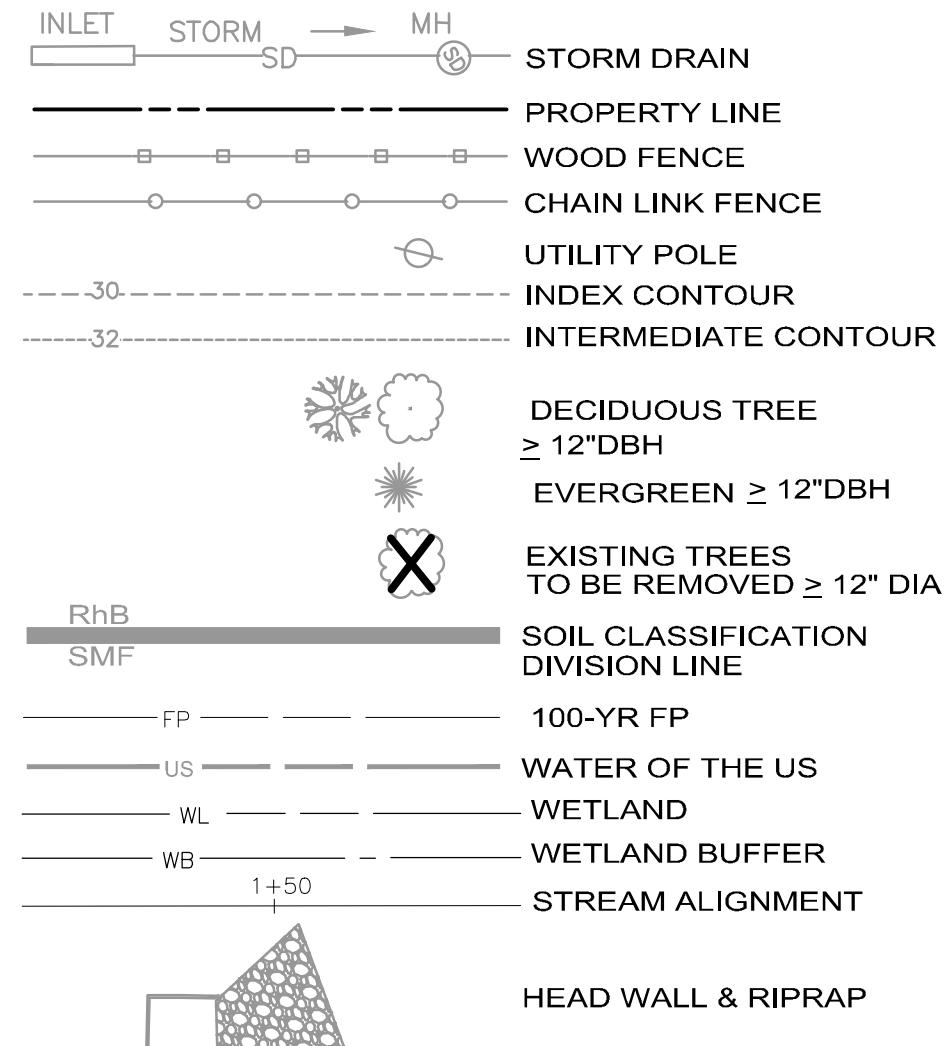




PROPOSED LEGEND

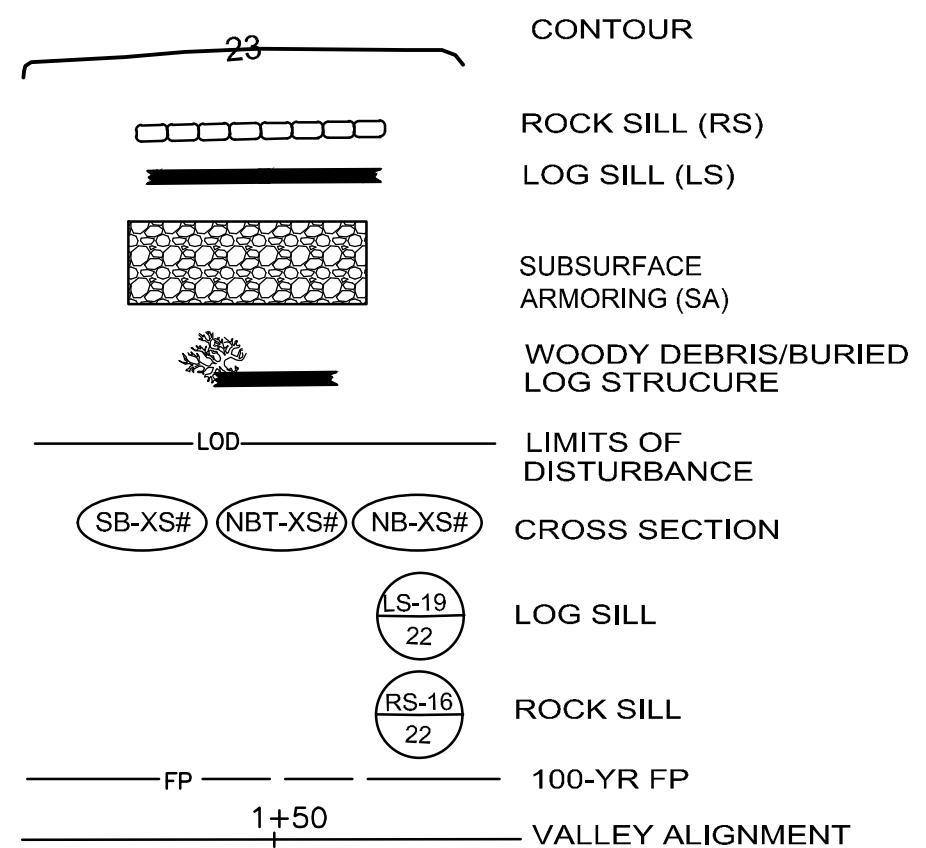

*The theoretical channel system is conceptual. The multiple threads will not be constructed as shown, but represent the individual flow paths that may develop and evolve over time.

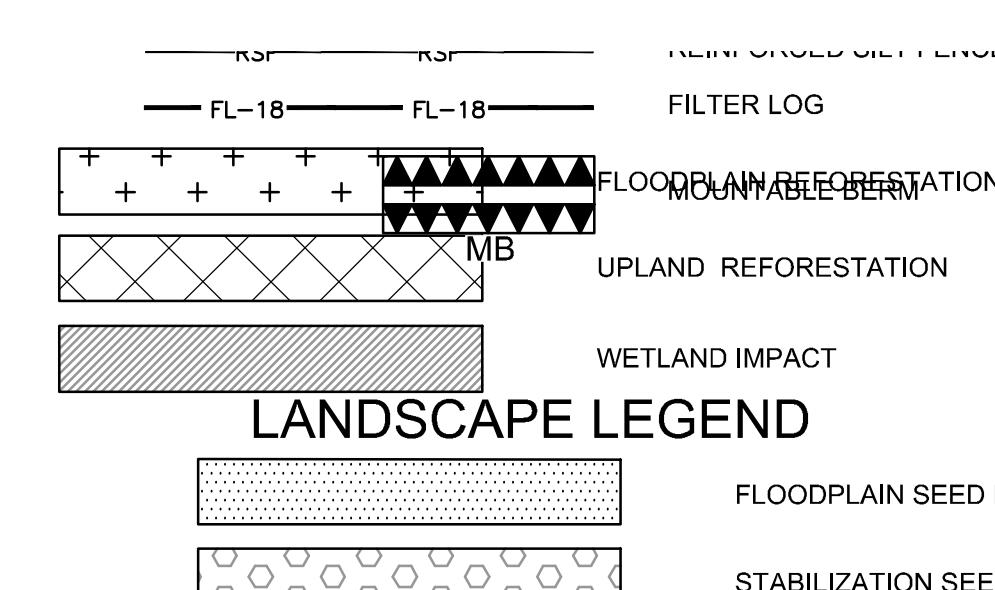

LANDSCAPE LEGEND

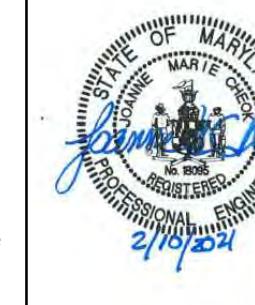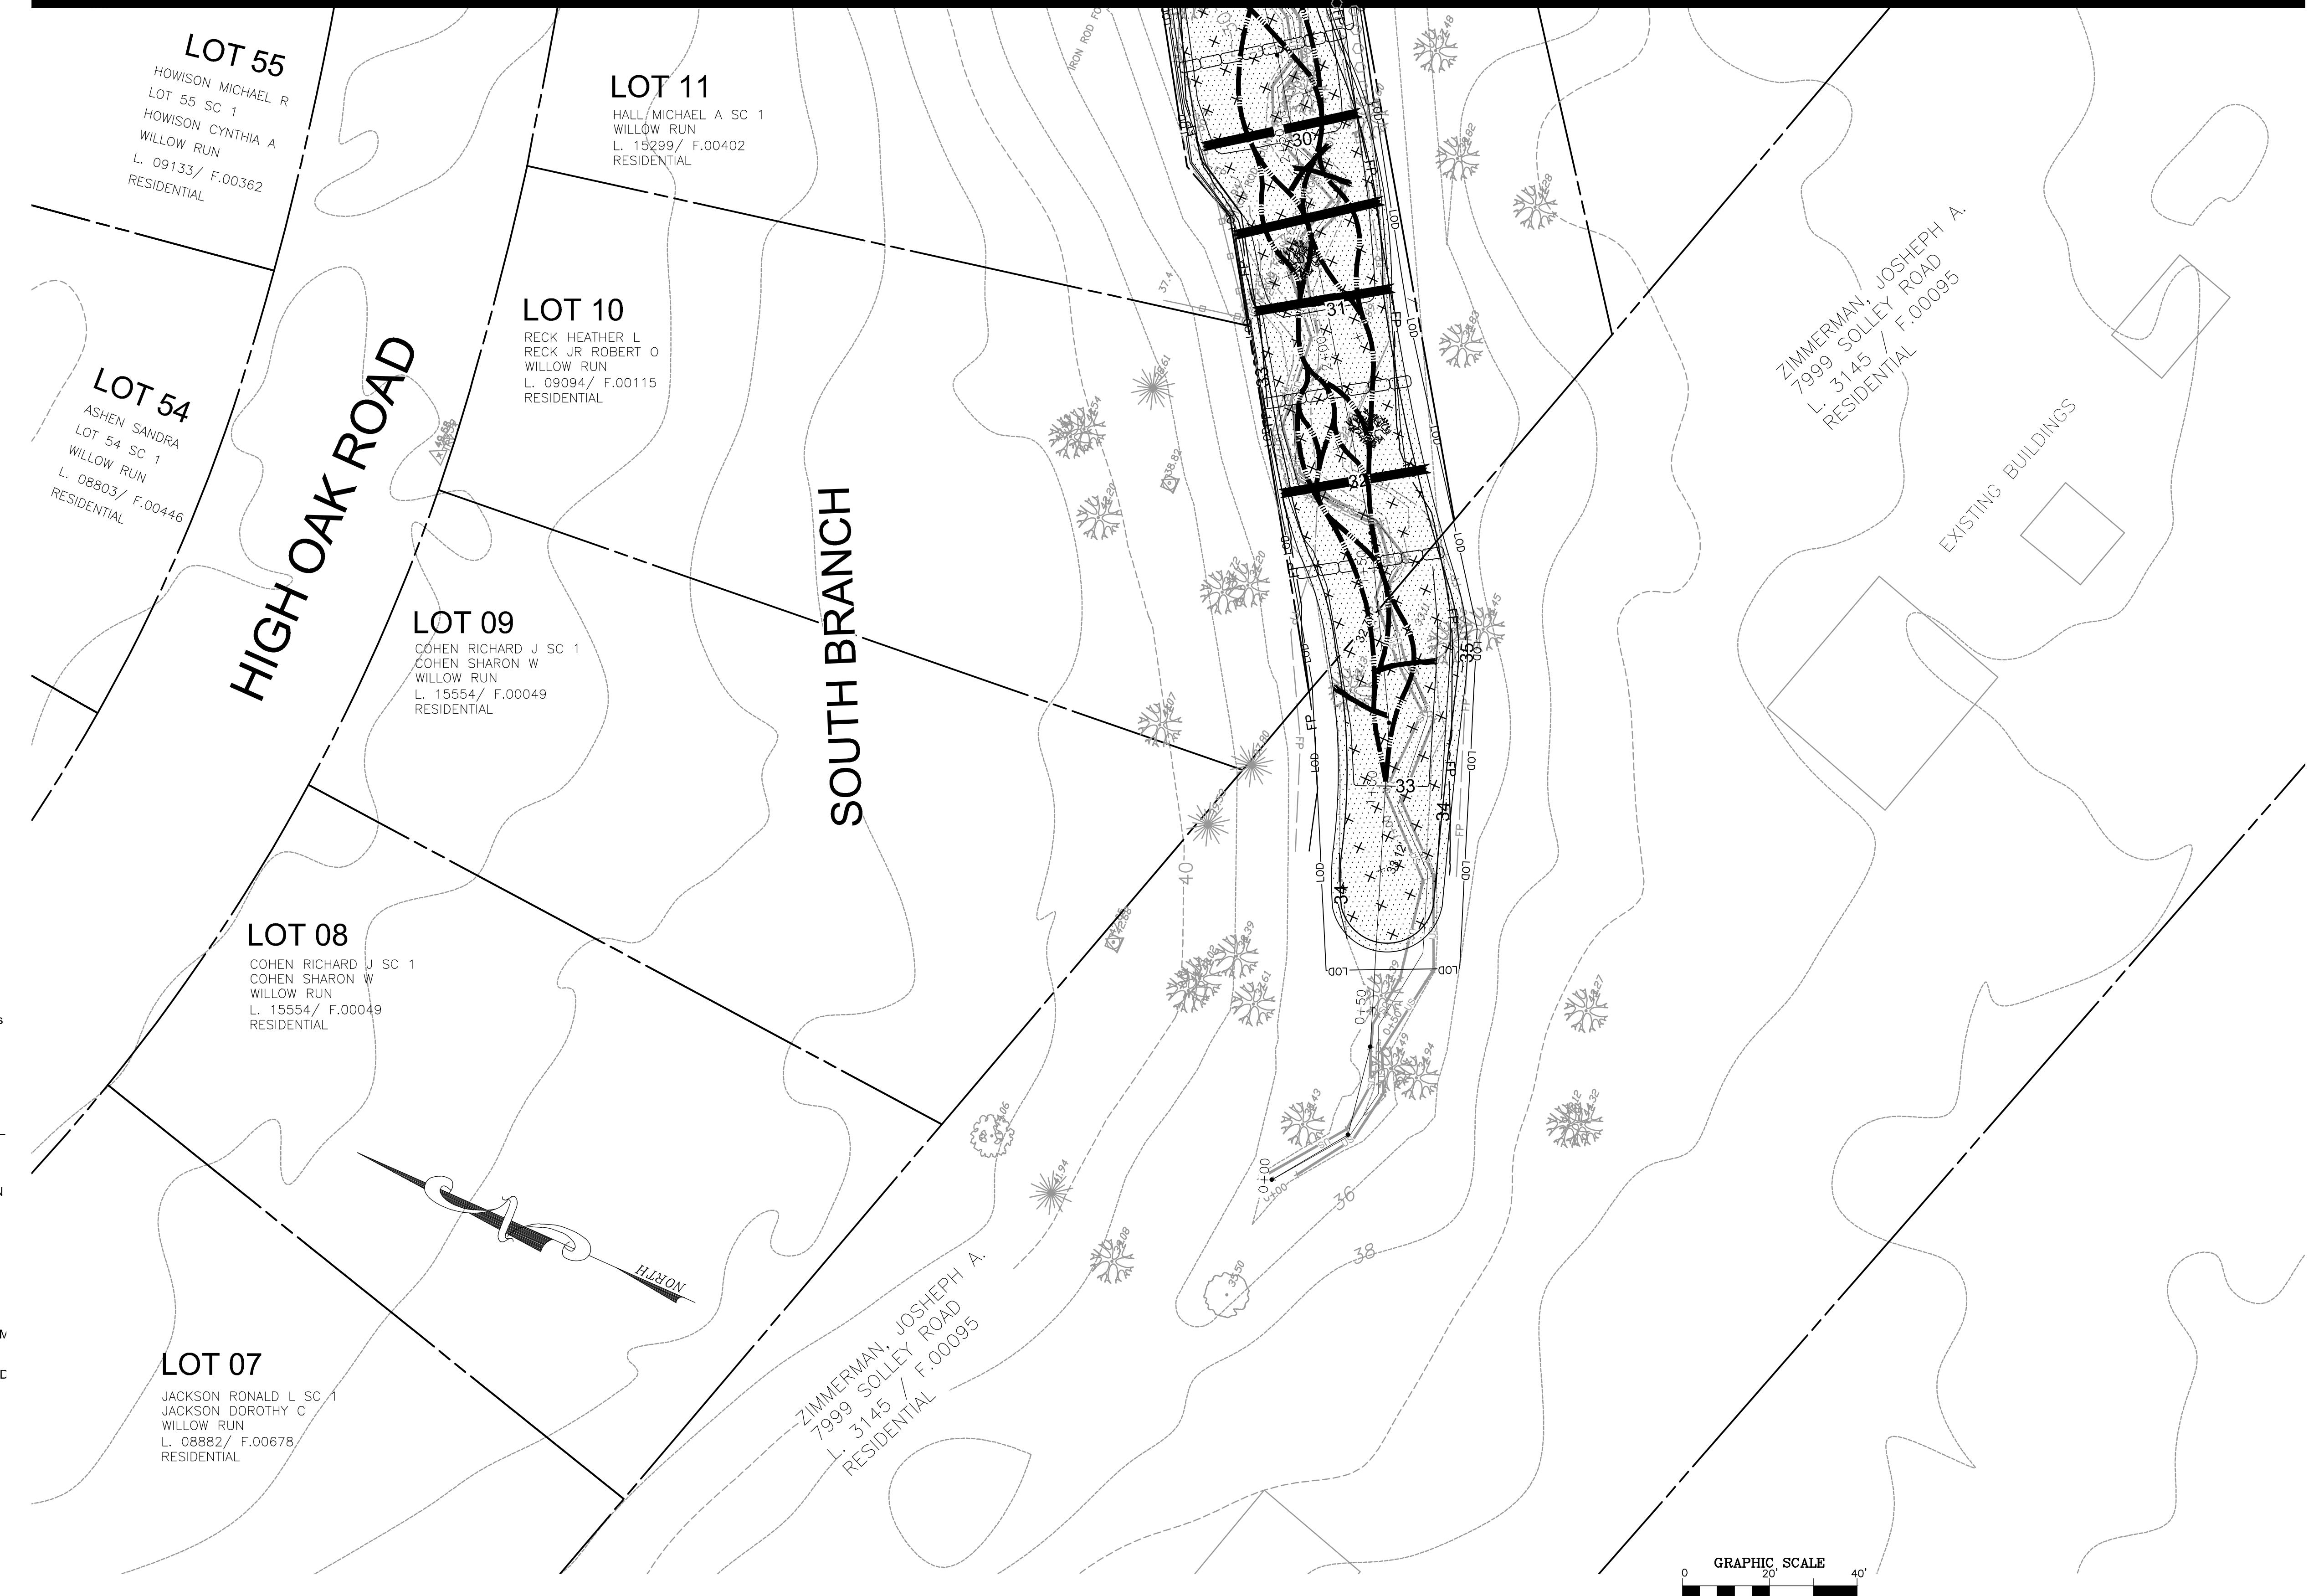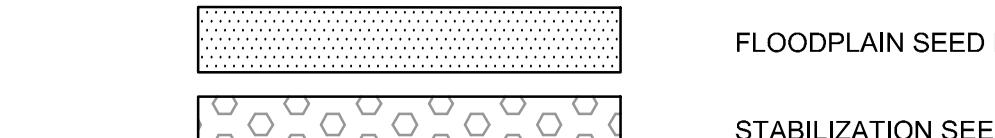

Professional Certification
I certify that these documents
were prepared or approved by
me, that I am a duly licensed
professional engineer under the
laws of the State of Maine.

		ANNE ARUNDEL COUNTY DEPARTMENT OF PUBLIC WORKS APPROVED DATE APPROVED DATE CHIEF ENGINEER PROJECT MANAGER DRAWN BY: BJF/R. Anchors CHECKED BY: J. Cheok SHEET NO: 38 OF 39 PROJECT NO: 50017963 PROPOSAL NO: 3rd District				STREAM RESTORATION PLAN LANDSCAPE PLAN 6 SLOOP COVE RETROFIT SITE 1 Tax Map 16 Grid 05 Anne Arundel County	
DATE							

NORTH BRANCH PLANT SCHEDULES					
FLOODPLAIN TREES					
BOTANICAL NAME	COMMON NAME	SIZE	CONDITION	QTY	SPACING
ACER RUBRUM	RED MAPLE	#2	CONTAINER	19	10'
CHAMAECYPARIS THYOIDES	ATLANTIC WHITE CEDAR	#5	CONTAINER	109	10'
JUNIPERUS VIRGINIANA	EASTERN RED CEDAR	#2	CONTAINER	41	10'
LIQUIDAMBAR STYRACIFLUA	SWEET GUM	#2	CONTAINER	28	10'
LIRIODENDRON TULIPIFERA	TULIP POPLAR	#2	CONTAINER	19	10'
MAGNOLIA VIRGINIANA	SWEETBAY MAGNOLIA	#2	CONTAINER	67	10'
NYSSA SYLVATICA	BLACK GUM	#2	CONTAINER	41	10'
TOTAL = 324					

FLOODPLAIN SHRUBS					
BOTANICAL NAME	COMMON NAME	SIZE	CONDITION	QTY	SPACING
ALNUS MARITIMA	SEASIDE ALDER	#2	CONTAINER	7	15'
CEPHALANTHUS OCCIDENTALIS	BUTTONBUSH	#2	CONTAINER	9	15'
CLETHRA ALNIFOLIA	SWEET PEPPERBUSH	#2	CONTAINER	11	15'
RHODODENDRON VISCOSUM	SWAMP AZALEA	#2	CONTAINER	15	15'
ROSA PALUSTRIS	SWAMP ROSE	#2	CONTAINER	13	15'
VACCINIUM CORYMBOSUM	HIGHBUSH BLUEBERRY	#2	CONTAINER	17	15'
TOTAL = 72					

UPLAND REFORESTATION					
BOTANICAL NAME	COMMON NAME	SIZE	CONDITION	QTY (BY AREA)	SPACING
CHAMAECYPARIS THYOIDES	ATLANTIC WHITE CEDAR	#5	CONTAINER	6	6 10'
ILEX OPACA	AMERICAN HOLLY	#5	CONTAINER	3	5 10'
QUERCUS PALUSTRIS	PIN OAK	#2	CONTAINER	7	10'
TOTAL = 27					

SOUTH BRANCH PLANT SCHEDULES					
FLOODPLAIN TREES					
BOTANICAL NAME	COMMON NAME	SIZE	CONDITION	QTY	SPACING
ACER RUBRUM	RED MAPLE	#2	CONTAINER	41	10'
CHAMAECYPARIS THYOIDES*	ATLANTIC WHITE CEDAR	#5	CONTAINER	148	10'
JUNIPERUS VIRGINIANA	EASTERN RED CEDAR	#2	CONTAINER	55	10'
LIQUIDAMBAR STYRACIFLUA	SWEET GUM	#2	CONTAINER	29	10'
LIRIODENDRON TULIPIFERA	TULIP POPLAR	#2	CONTAINER	19	10'
MAGNOLIA VIRGINIANA	SWEETBAY MAGNOLIA	#2	CONTAINER	75	10'
NYSSA SYLVATICA	BLACK GUM	#2	CONTAINER	29	10'
TOTAL = 396					



FLOODPLAIN SHRUBS					
BOTANICAL NAME	COMMON NAME	SIZE	CONDITION	QTY	SPACING
ALNUS MARITIMA	SEASIDE ALDER	#2	CONTAINER	13	15'
CEPHALANTHUS OCCIDENTALIS	BUTTONBUSH	#2	CONTAINER	5	15'
CLETHRA ALNIFOLIA	SWEET PEPPERBUSH	#2	CONTAINER	15	15'
RHODODENDRON VISCOSUM	SWAMP AZALEA	#2	CONTAINER	15	15'
ROSA PALUSTRIS	SWAMP ROSE	#2	CONTAINER	9	15'
VACCINIUM CORYMBOSUM	HIGHBUSH BLUEBERRY	#2	CONTAINER	9	15'
VIBURNUM DENTATUM	SOUTHERN ARROWWOOD	#2	CONTAINER	17	15'
TOTAL = 83					

UPLAND REFORESTATION					
BOTANICAL NAME	COMMON NAME	SIZE	CONDITION	QTY (BY AREA)	SPACING
CHAMAECYPARIS THYOIDES	ATLANTIC WHITE CEDAR	#5	CONTAINER	3	3 9 10'
ILEX OPACA	AMERICAN HOLLY	#5	CONTAINER	5	6 5 5 10'
MAGNOLIA VIRGINIANA	SWEETBAY MAGNOLIA	#2	CONTAINER	3	6 3 10'
NYSSA SYLVATICA	BLACK GUM	#2	CONTAINER	3	6 3 10'
QUERCUS PALUSTRIS	PIN OAK	#2	CONTAINER	3	5 10'
TOTAL = 63					


FLOODPLAIN SEED MIX		
%	BOTANICAL NAME	COMMON NAME
19.80	AGROSTIS PERENNANS	AUTUMN BENTGRASS
17.00	PANICUM RIDIGULUM	REDTOP PANICGRASS
11.90	SPARGANIUM EURYCARPUM	GIANT BUR REED
9.90	CAREX LURIDA	LURID SEDGE
5.95	CAREX SCOPARIA	BLUNT BROOM SEDGE
5.95	SCIRPUS ATROVIRENS	GREEN BULRUSH
5.67	PANICUM VIRGATUM	SWITCHGRASS
4.25	CAREX SQUARROSA	SQUARROSE SEDGE
4.75	CAREX COMOSA	COSMOS SEDGE
2.83	VERBENA HASTATA	BLUE Vervain
2.55	JUNCUS EFFUSUS	SOFT RUSH
1.70	EUPATORIUM PERfoliatum	BONESET
1.70	HELENIUM AUTUMNALE	COMMON SNEEZEWEEED
1.13	BIDENS FRONDOSA	BEGGARS-TICK
0.85	SCIRPUS CYPERINUS	WOOLGRASS
0.85	SCIRPUS PUNGENS	THREESQUARE BULRUSH
0.85	CAREX CRINITA	FRINGED SEDGE
0.85	ASCLEPIAS INCARNATA	SWAMP MILKWEED
0.57	MIMULUS RINGENS	SQUARE STEM MONKEY FLOWER
0.42	IRIS VERSICOLOR	BLUEFLAG
0.42	PELTANDRA VIRGINICA	ARROW ARUM
0.42	ASTER PRENANTHOIDES	ZIGZAG ASTER

STABILIZATION SEED MIX		
%	BOTANICAL NAME	COMMON NAME
20.00	AGROSTIS PERENNANS	AUTUMN BENTGRASS
16.70	SCHIZACHYRIUM SCOPARIUM	LITTLE BLUESTEM
16.70	ELYMUS VIRGINICUS	VIRGINIA WILDRYE
16.70	ANDROPOGON GERARDII	BIG BLUESTEM
10.00	PANICUM RIDIGULUM	REDTOP PANICGRASS
6.70	PANICUM VIRGATUM	SWITCHGRASS
4.00	EUPATORIUM PERfoliatum	BONESET
3.20	EUPATORIUM COELESTINUM	MISTFLOWER
2.00	HELENIUM AUTUMNALE	COMMON SNEEZEWEEED
2.00	SOLIDAGO RIGIDA	STIFF GOLDENROD
1.00	ASTER OBlongifolius	AROMATIC ASTER
1.00	ASCLEPIAS INCARNATA	SWAMP MILKWEED

APPLICATION RATE: 15.00 LBS/ACRE

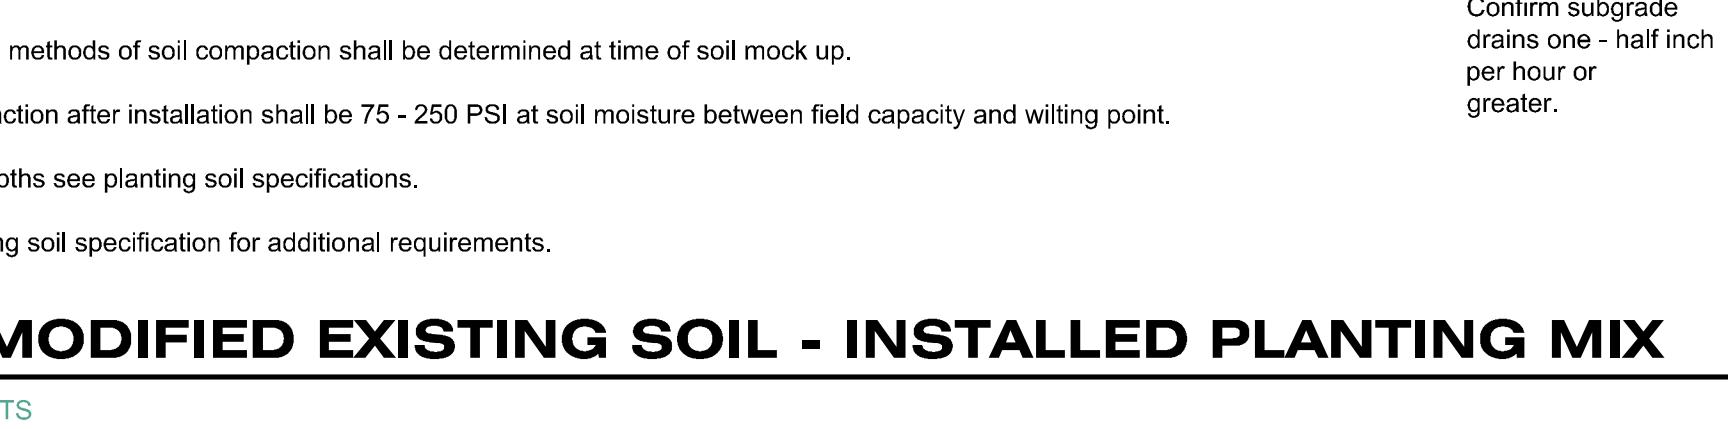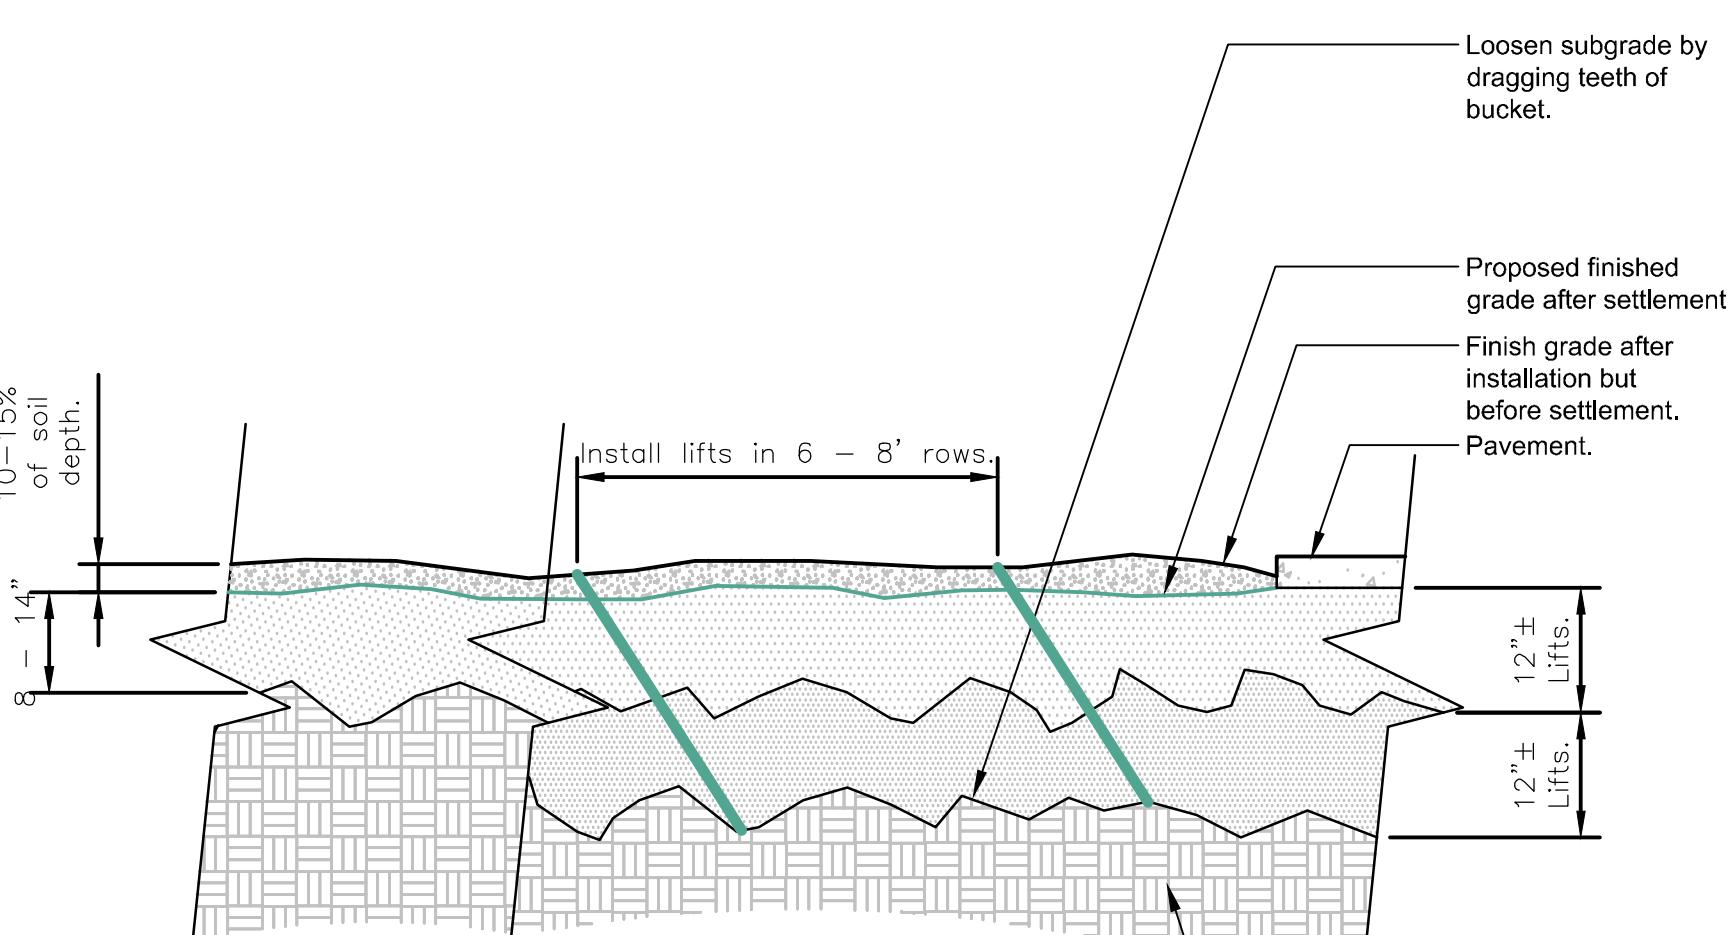


1 MODIFIED EXISTING SOIL - INSTALLED PLANTING MIX

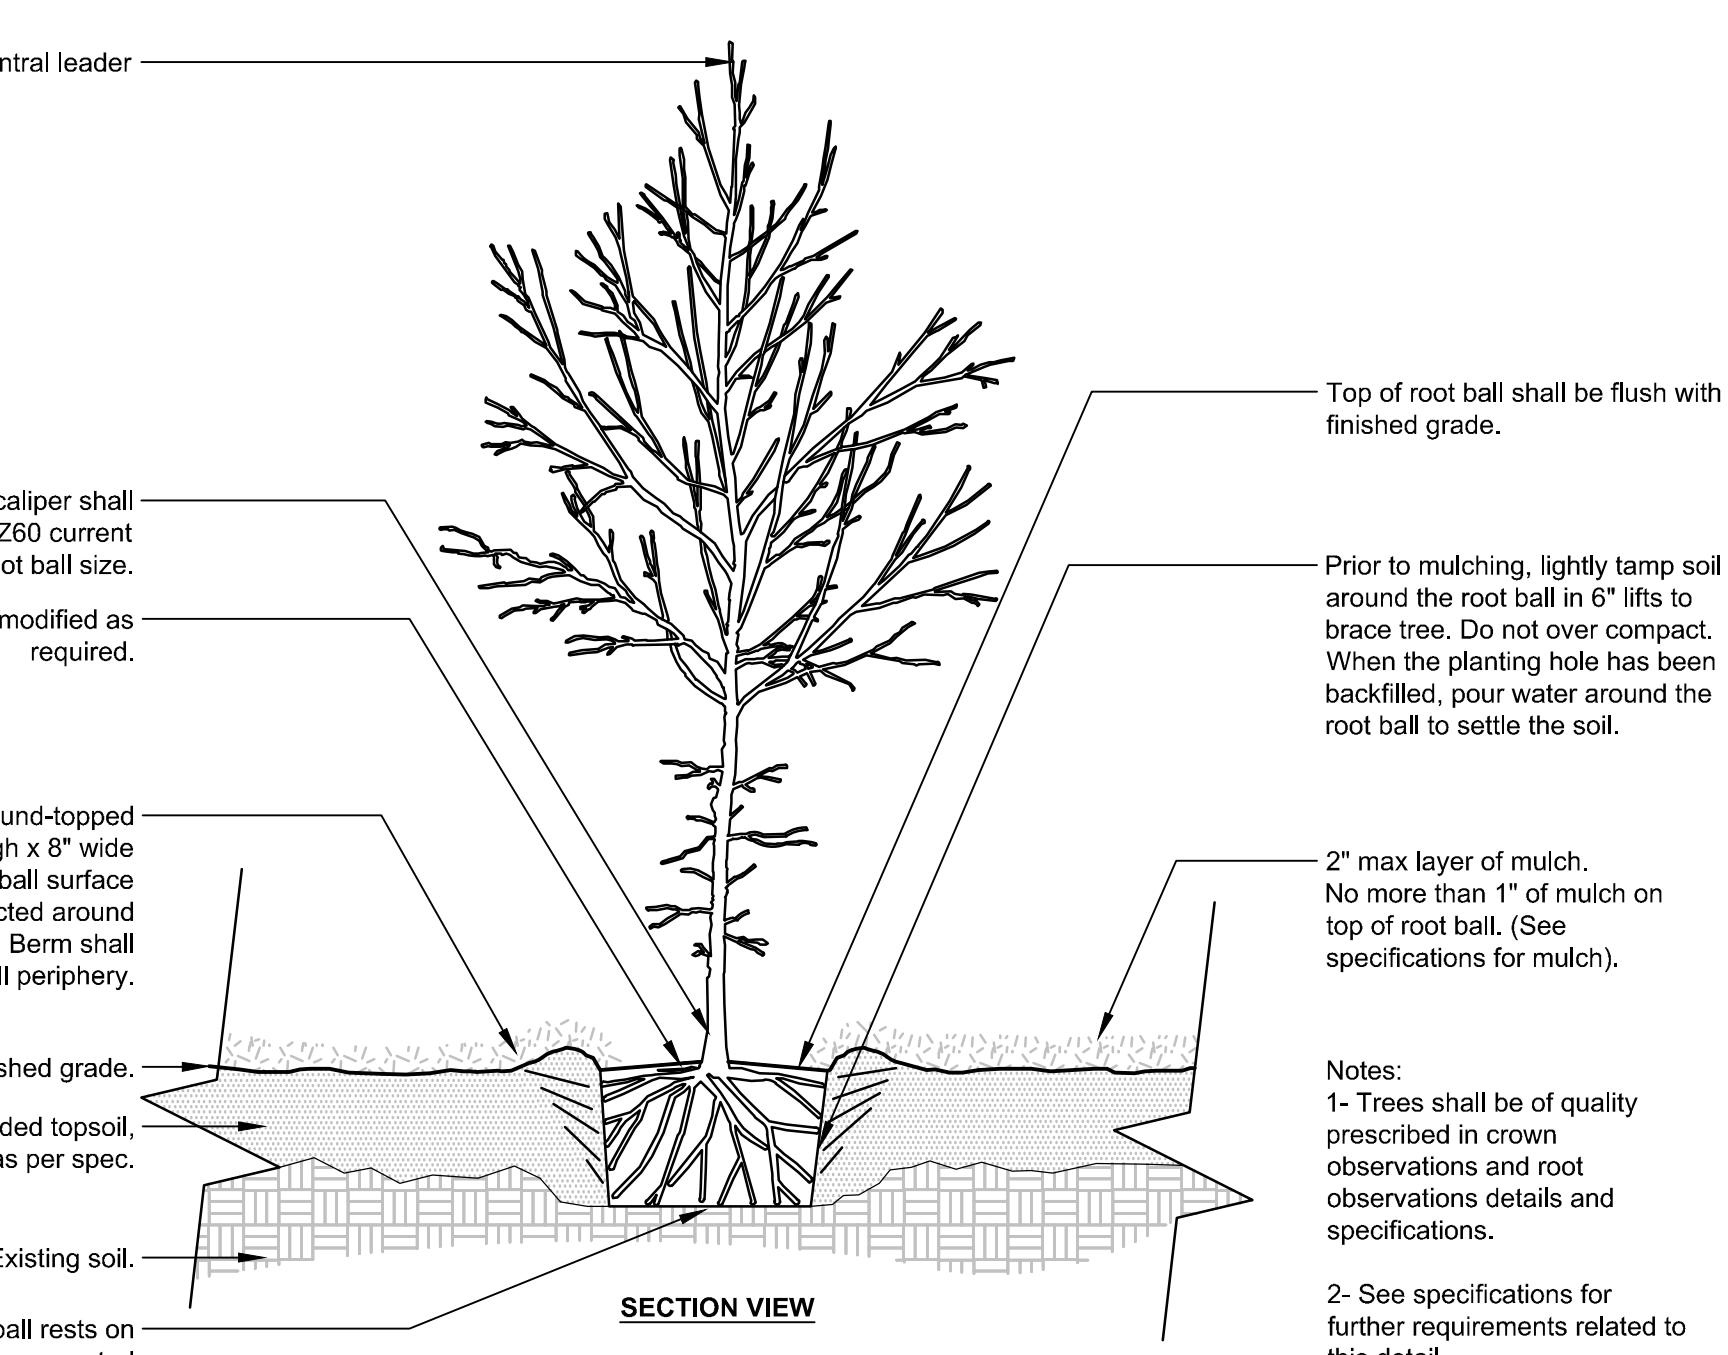

Notes:

- 1- Trees shall be of quality prescribed in crown observations and root observations details and specifications.
- 2- See specifications for further requirements related to this detail.

2 TREE w/ BERM (EXISTING SOIL MODIFIED)

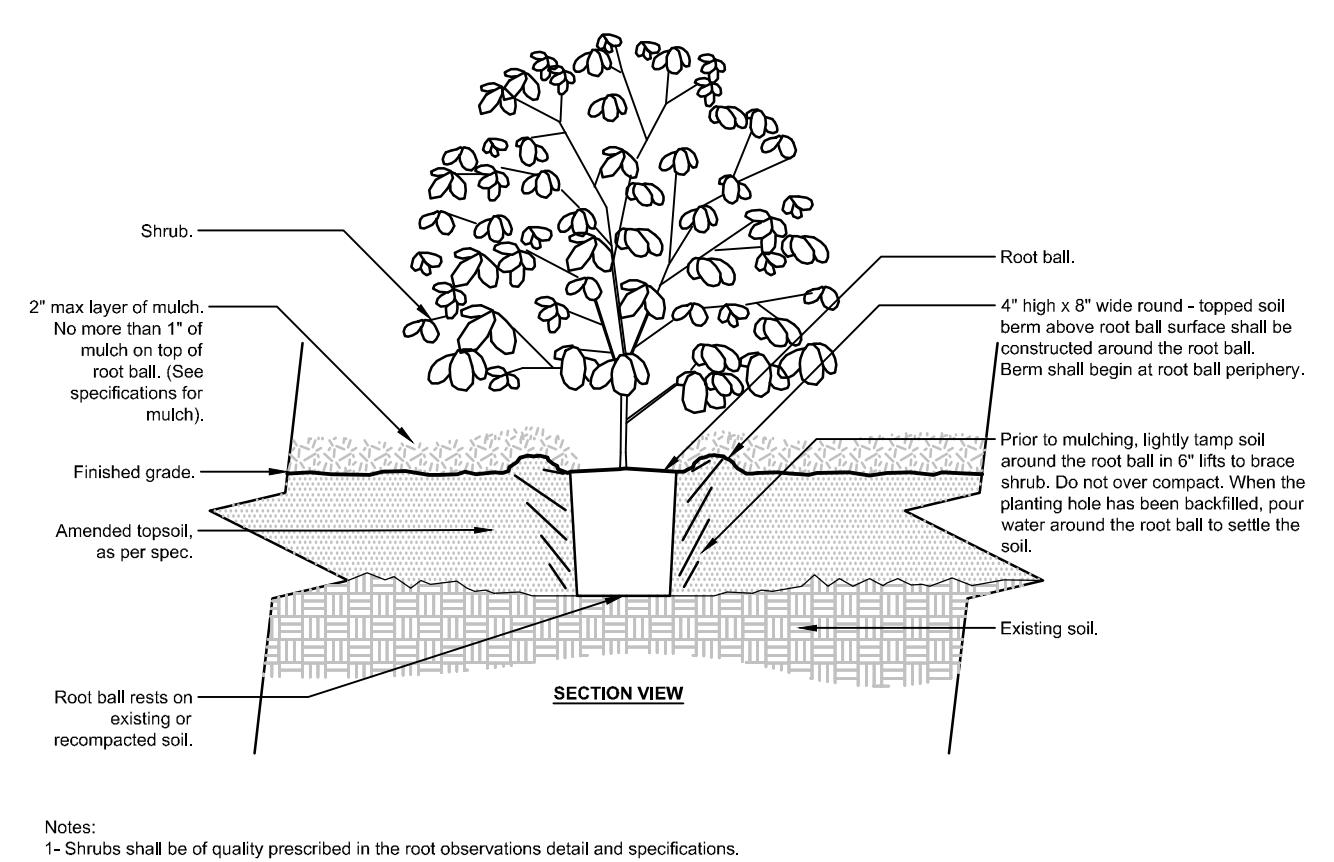

Notes:


STATE OF MARYLAND
DEPARTMENT OF THE ENVIRONMENT
WATER AND SCIENCE ADMINISTRATION
LETTER OF AUTHORIZATION

AUTHORIZATION NUMBER: 16-NT-0193/201660858

EFFECTIVE DATE: October 25, 2021

EXPIRATION DATE: October 25, 2026

AUTHORIZED PERSON: Anne Arundel County Department of Public Works
2662 Riva Road
Annapolis, MD 21401

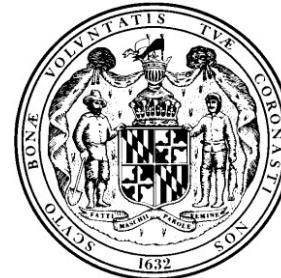

IN ACCORDANCE WITH ENVIRONMENT ARTICLE §5-503(a) AND §5-906(b), ANNOTATED CODE OF MARYLAND, COMAR 26.17.04 AND 26.23.01, AND 26.08.02 AND THE ATTACHED CONDITIONS OF AUTHORIZATIONS, **Anne Arundel County Department of Public Works** ("AUTHORIZED PERSON"), IS HEREBY AUTHORIZED BY THE WATER AND SCIENCE ADMINISTRATION ("ADMINISTRATION") TO CONDUCT A REGULATED ACTIVITY IN A NONTIDAL WETLAND, BUFFER, OR EXPANDED BUFFER, AND/OR TO CHANGE THE COURSE, CURRENT OR CROSS-SECTION OF WATERS OF THE STATE, IN ACCORDANCE WITH THE ATTACHED PLANS APPROVED BY THE ADMINISTRATION ON **October 25, 2021** ("APPROVED PLAN") AND PREPARED BY **Landstudies/Dewberry** AND INCORPORATED HEREIN, AS DESCRIBED BELOW:

The project will restore approximately 2,400 linear feet of Unnamed Tributary to Sloop Cove. The proposed project involves a valley bottom restoration design, which includes filling existing channel and installing rock sills, log sills, and subsurface armoring across the valley bottom to provide grade control and prevent vertical degradation. Also, woody material will be partially buried in various locations across the valley bottom to provide additional roughness. The proposed restoration will temporarily impact approximately 2,400 linear feet (10,434 square feet) of stream, and 60,995 square feet of floodplain. The project will permanently impact 2,310 square feet of nontidal forested wetlands and 8,213 square feet of nontidal wetlands buffer. The proposed project has a potential wetland creation area that is approximately 2,700 square feet at the downstream end of the project. The project is located at 8042 High Oak Road, Glen Burnie, Anne Arundel County.

MD Grid Coordinates 164624 X 437829

A handwritten signature of Heather L. Nelson.

Heather L. Nelson
Program Manager
Wetlands and Waterways Program

Attachments: Conditions of Authorization

cc: MDE Compliance Program/ Anne Arundel County

THE FOLLOWING CONDITIONS OF AUTHORIZATION APPLY TO ALL ACTIVITIES AUTHORIZED BY

AUTHORIZATION NUMBER 16-NT-0193/201660858

PAGE 2 of 6

1. **Validity:** Authorization is valid only for use by Authorized Person. Authorization may be transferred only with prior written approval of the Administration. In the event of transfer, transferee agrees to comply with all terms and conditions of Authorization.
2. **Initiation of Work, Modifications and Extension of Term:** Authorized Person shall initiate authorized activities in waterways, including streams and the 100-year floodplain, within two (2) years of the Effective Date of this Authorization or the Authorization shall expire. [Annotated Code of Maryland, Environment Article 5-510(a)-(b) and Code of Maryland Regulations 26.17.04.12]. Authorized Person may submit written requests to the Administration for (a) extension of the period for initiation of work, (b) modification of Authorization, including the Approved Plan, or, (c) not later than 45 days prior to Expiration Date, an extension of term. Requests for modification shall be in accordance with applicable regulations and shall state reasons for changes, and shall indicate the impacts on nontidal wetlands, streams, and the floodplain, as applicable. The Administration may grant a request at its sole discretion. (Annotated Code of Maryland, Environment Article 5-510(c), and Code of Maryland Regulations 26.17.04.12, and Annotated Code of Maryland, Environment Article 5-907 and Code of Maryland Regulations 26.23.02.07).
3. **Responsibility and Compliance:** Authorized Person is fully responsible for all work performed and activities authorized by this Authorization shall be performed in compliance with this Authorization and Approved Plan. Authorized Person agrees that a copy of the Authorization and Approved Plan shall be kept at the construction site and provided to its employees, agents and contractors. A person (including Authorized Person, its employees, agents or contractors) who violates or fails to comply with the terms and conditions of this Authorization, Approved Plan or an administrative order may be subject to penalties in accordance with §5-514 and §5-911, Department of the Environment Article, Annotated Code of Maryland (2007 Replacement Volume).
4. **Failure to Comply:** If Authorized Person, its employees, agents or contractors fail to comply with this Authorization or Approved Plan, the Administration may, in its discretion, issue an administrative order requiring Authorized Person, its employees, agents and contractors to cease and desist any activities which violate this Authorization, or the Administration may take any other enforcement action available to it by law, including filing civil or criminal charges.
5. **Suspension or Revocation:** Authorization may be suspended or revoked by the Administration, after notice of opportunity for a hearing, if Authorized Person: (a) submits false or inaccurate information in Permit application or subsequently required submittals; (b) deviates from the Approved Plan, specifications, terms and conditions; (c) violates, or is about to violate terms and conditions of this Authorization; (d) violates, or is about to violate, any regulation promulgated pursuant to Title 5, Department of the Environment Article, Annotated Code of Maryland as amended; (e) fails to allow authorized representatives of the Administration to enter the site of authorized activities at any reasonable time to conduct inspections and evaluations; (f) fails to comply with the requirements of an administrative action or order issued by the Administration; or (g) does not have vested rights under this Authorization and new information, changes in site conditions, or amended regulatory requirements necessitate revocation or suspension.
6. **Other Approvals:** Authorization does not authorize any injury to private property, any invasion of rights, or any infringement of federal, State or local laws or regulations, nor does it obviate the need to obtain required authorizations or approvals from other State, federal or local agencies as required by law.
7. **Site Access:** Authorized Person shall allow authorized representatives of the Administration access to the site of authorized activities during normal business hours to conduct inspections and evaluations necessary to assure compliance with this Authorization. Authorized Person shall provide necessary assistance to effectively and safely conduct such inspections and evaluations.
8. **Inspection Notification:** Authorized Person shall notify the Administration's Compliance Program at least five (5) days before starting authorized activities and five (5) days after completion. For Allegany, Garrett, and Washington Counties, Authorized Person shall call 301-689-1480. For Carroll, Frederick, Howard, Montgomery and Prince George's Counties, Authorized Person shall call 301-665-2850. For Baltimore City, Anne Arundel, Baltimore, Calvert, Charles, Harford and St. Mary's Counties, Authorized Person shall call 410-537-3510. For Caroline, Cecil, Dorchester, Kent, Queen Anne's, Somerset, Talbot, Wicomico and Worcester Counties, Authorized Person shall call 410-901-4020. If Authorization is for a project that is part of a mining site, please contact the Land and Materials Administration's Mining Program at 410-537-3557 at least five (5) days before starting authorized activities and five (5) days after completion.
9. **Sediment Control:** Authorized Person shall obtain approval from the **Anne Arundel County Soil Conservation** District for a grading and sediment control plan specifying soil erosion control measures. The approved grading and sediment control plan shall be included in the Approved Plan, and shall be available at the construction site.
10. **Best Management Practices During Construction:** Authorized Person, its employees, agents and contractors shall conduct authorized activities in a manner consistent with the Best Management Practices specified by the Administration.
11. **Disposal of Excess:** Unless otherwise shown on the Approved Plan, all excess fill, spoil material, debris, and construction material shall be disposed of outside of nontidal wetlands, nontidal wetlands buffers, and the 100-year floodplain, and in a location and manner which does not adversely impact surface or subsurface water flow into or out of nontidal wetlands.
12. **Temporary Staging Areas:** Temporary construction trailers or structures, staging areas and stockpiles shall not be located within nontidal wetlands, nontidal wetlands buffers, or the 100-year floodplain unless specifically included on the Approved Plan.

13. **Temporary Stream Access Crossings:** Temporary stream access crossings shall not be constructed or utilized unless shown on the Approved Plan. If temporary stream access crossings are determined necessary prior to initiation of work or at any time during construction, Authorized Person, its employees, agents or contractors shall submit a written request to the Administration and secure the necessary permits or approvals for such crossings before installation of the crossings. Temporary stream access crossings shall be removed and the disturbance stabilized prior to completion of authorized activity or within one (1) year of installation.
14. **Discharge:** Runoff or accumulated water containing sediment or other suspended materials shall not be discharged into waters of the State unless treated by an approved sediment control device or structure.
15. **Instream Construction Prohibition:** To protect important aquatic species, motor driven construction equipment shall not be allowed within stream channels unless on authorized ford crossings. Activities within stream channels are prohibited as determined by the classification of the stream (COMAR 26.08.02.08): Unnamed Tributary to Sloop Cove is a Use I waterway; in-stream work may not be conducted from March 1 through June 15, inclusive, of any year.
16. **Instream Blasting:** Authorized Person shall obtain prior written approval from the Administration before blasting or using explosives in the stream channel.
17. **Minimum Disturbance:** Any disturbance of stream banks, channel bottom, wetlands, and wetlands buffer authorized by this Authorization or Approved Plan shall be the minimum necessary to conduct permitted activities. All disturbed areas shall be stabilized vegetatively no later than seven (7) days after construction is completed or in accordance with the approved grading or sediment and erosion control plan.
18. **Restoration of Construction Site:** Authorized Person shall restore the construction site upon completion of authorized activities. Undercutting, meandering or degradation of the stream banks or channel bottom, any deposition of sediment or other materials, and any alteration of wetland vegetation, soils, or hydrology, resulting directly or indirectly from construction or authorized activities, shall be corrected by Authorized Person as directed by the Administration.
19. **Stream Monitoring:** Authorized Person shall monitor the stream restoration project for three (3) out of five (5) years; on years one, three, and five following the completion of construction of the project. The monitoring shall identify and evaluate changes in 1) channel cross-section, pattern and profile; 2) bed materials; 3) channel stability; 4) structure stability and condition; and 5) vegetation viability. The monitoring effort may include topographic surveys of monumented cross-sections within the realigned channel segment, visual field observations, photographic documentation, vegetation viability measurements, and identify any necessary corrective measures. The Authorized Person shall submit annual reports on the results of the monitoring efforts for the stream restoration project to the Department by the end of each year. The Authorized Person shall coordinate with the regulatory agencies concerning applicable remedial measures for any identified project failures and shall correct any project failures within one year of their identification. If the project is determined to be stable at the end of year 3, the Authorized Person may request an exemption from the year 5 stream monitoring requirement.

FEDERALLY MANDATED STATE AUTHORIZATIONS

The State of Maryland issued a Water Quality Certification to the U.S. Army Corps of Engineers for projects receiving federal authorization under the Maryland State Programmatic General Permit, Regional General Permit for Chesapeake Bay Total Maximum Daily Load (TMDL) Activities and non-suspended Nationwide Permits. In addition, as applicable, this Authorization constitutes the State's concurrence with the Applicant's certification that the activities authorized herein are consistent with the Maryland Coastal Zone Management Program, as required by Section 307 of the Coastal Zone Management Act of 1972, as amended. Activities in the following counties are not subject to the Maryland Coastal Zone Management requirement: Allegany, Carroll, Frederick, Garrett, Howard, Montgomery, and Washington.

U.S. ARMY CORPS OF ENGINEERS AUTHORIZATION

The U.S. Army Corps of Engineers is reviewing the project as a Category B activity. The federal authorization will be sent separately by the Corps and should be followed when performing the authorized.

**BEST MANAGEMENT PRACTICES FOR WORKING IN
NONTIDAL WETLANDS, WETLAND BUFFERS,
WATERWAYS AND 100-YEAR FLOODPLAINS**

- 1) No excess fill, construction material, or debris shall be stockpiled or stored in nontidal wetlands, nontidal wetland buffers, waterways, or the 100-year floodplain.
- 2) Place materials in a location and manner which does not adversely impact surface or subsurface water flow into or out of nontidal wetlands, nontidal wetland buffers, waterways, or the 100-year floodplain.
- 3) Do not use the excavated material as backfill if it contains waste metal products, unsightly debris, toxic material, or any other deleterious substance. If additional backfill is required, use clean material free of waste metal products, unsightly debris, toxic material, or any other deleterious substance.
- 4) Place heavy equipment on mats or suitably operate the equipment to prevent damage to nontidal wetlands, nontidal wetland buffers, waterways, or the 100-year floodplain.
- 5) Repair and maintain any serviceable structure or fill so there is no permanent loss of nontidal wetlands, nontidal wetland buffers, or waterways, or permanent modification of the 100-year floodplain in excess of that lost under the originally authorized structure or fill.
- 6) Rectify any nontidal wetlands, wetland buffers, waterways, or 100-year floodplain temporarily impacted by any construction.
- 7) All stabilization in the nontidal wetland and nontidal wetland buffer shall consist of the following species: Annual Ryegrass (Lolium multiflorum), Millet (Setaria italica), Barley (Hordeum sp.), Oats (Uniola sp.), and/or Rye (Secale cereale). These species will allow for the stabilization of the site while also allowing for the voluntary revegetation of natural wetland species. Other non-persistent vegetation may be acceptable, but must be approved by the Nontidal Wetlands and Waterways Division. **Kentucky 31 fescue shall not be utilized in wetland or buffer areas.** The area should be seeded and mulched to reduce erosion after construction activities have been completed.
- 8) After installation has been completed, make post-construction grades and elevations the same as the original grades and elevations in temporarily impacted areas.
- 9) To protect aquatic species, in-stream work is prohibited as determined by the classification of the stream:

Use I waters: In-stream work shall not be conducted during the period March 1 through June 15, inclusive, during any year.

Use III waters: In-stream work shall not be conducted during the period October 1 through April 30, inclusive, during any year.

Use IV waters: In-stream work shall not be conducted during the period March 1 through May 31, inclusive, during any year.

- 10) Stormwater runoff from impervious surfaces shall be controlled to prevent the washing of debris into the waterway.
- 11) Culverts shall be constructed and any riprap placed so as not to obstruct the movement of aquatic species, unless the purpose of the activity is to impound water.

**MODIFICATIONS TO STATE AUTHORIZATIONS
FOR ECOLOGICAL RESTORATION PROJECTS IN NONTIDAL WETLANDS AND WATERWAYS**

The Maryland Department of the Environment, Wetlands and Waterways Program (WWP), has instituted guidance for modifications to State-issued Authorizations for Ecological Restoration Projects.

Modifications to permitted Tidal Wetlands projects are not subject to these procedures. The guidance (below) reflects a three-tiered approach to the various activities for which modifications are typically sought:

Level one activities would be those for which no Wetlands and Waterways Program notification and review is necessary. These minor changes may be made with no prior notice to MDE.

Examples include:

1. Additional plantings / substitutions of plantings or soil mixture / re-planting provided that all locally native vegetation is used and appropriate bio diversity is addressed.
2. Modifications of work occurring outside of regulated resources (i.e. access changes, adjustments to LOD).
3. Changes to the Sequence of Construction that do not affect erosion/sediment control implementation or maintenance.
4. Bank stabilization measures that are limited to the placement of fiber matting and fiber bio logs excluding the use of stone riprap.
5. In-kind repair of permitted projects within the term of the Authorization.

Level two activities would be those for which the WWP would need to be contacted beforehand. The appropriate Division Chief and assigned reviewer should be contacted via Email with details including a work description, site sketch and photos (if appropriate). The Department commits to a 3-business-day turn around for these requests. The applicant should not proceed with the proposed changes until 3-business days have passed. If MDE does not respond to the notification of the proposed modification within 3-business days, the permittee may assume approval and proceed. In the event MDE requests further information, the work may not proceed until MDE is satisfied that a formal modification is not necessary. MDE will make every attempt to expedite the review of the supplemental information submitted to make a determination on next steps (i.e. proceed or submit a formal modification).

Examples include:

1. Installation of non-structural woody debris (toe wood, root wads).
2. Alteration of grade control structures, within original structure LOD and do not affect flood elevations.
3. Expansion of LOD in regulated areas for temporary construction access only (no additional permanent impacts or tree removal within jurisdictional resources). Timber matting should be used for access through wetlands or buffers to minimize impacts.
4. Relocation of created nontidal wetlands within LOD.
5. Changes in pump around / diversion type and location, excluding new channel diversion construction.
6. Changes to in-stream structures or configurations, including changes to stone sizes/materials.

Level three activities are more substantial changes that would require a formal modification approval to the permitted activity from the WWP through submission of a permit modification request before proceeding with these changes in the field.

Examples include:

1. Changes in the stream plan, profile or cross-section.
2. Additional grade control structures (different from as permitted plans) including the raising, lowering and relocation; including addition of coarse woody debris which functions like a dam.
3. Expansion of LOD with permanent impacts to regulated areas.
4. Change in location of temporary access crossing/s.
5. Additional floodplain grading / fill
6. Any additional permanent wetlands and wetland buffers impacts.
7. Projects in sensitive areas (e.g. Critical Area).
8. Any change or waiver to in-stream closure period.

This Process for Modifications to Authorizations for Ecological Restoration Projects is applicable only to Nontidal Wetlands and Waterways authorizations issued by the Wetlands and Waterways Program at MDE. Any other local, state or federal authorizations necessary to implement the field modifications contained in this document will be necessary before proceeding with the work. (2/2021)

APPENDIX C

As-Built Plans

CONSTRUCTION SEQUENCE
CONTRACTOR WILL CONTACT A.A. COUNTY DEPARTMENT OF INSPECTIONS AND PERMITS, 48 HOURS PRIOR TO ANY CONSTRUCTION ACTIVITIES TO CONDUCT AN ON-SITE PRE-CONSTRUCTION MEETING (410-222-7780). WORK MAY NOT COMMENCE UNTIL THE PERMITTEE OR THE RESPONSIBLE PERSONNEL HAVE MET ON SITE WITH THE SEDIMENT AND EROSION CONTROL INSPECTOR TO REVIEW THE APPROVED PLANS.

EXISTING TOPOGRAPHY MUST BE FIELD VERIFIED FOR THE SEDIMENT CONTROL INSPECTOR PRIOR TO COMMENCING WORK.

PHASE I: ESTABLISHMENT OF ACCESS AND PROJECT LIMITS 5 DAYS

1. INSTALL REINFORCED SIL FENCE, STABILIZED CONSTRUCTION ENTRANCE(S) AND TEMPORARY STAGING AREAS. (1 DAY)
2. INSTALL TEMPORARY ORANGE CONSTRUCTION FENCE ALONG THE ENTIRE LENGTH OF THE PROPOSED LIMIT OF DISTURBANCE (LOD) PRIOR TO BEGINNING CONSTRUCTION ACTIVITIES. (3 DAYS)
3. INSTALL FILTER LOGS TO ACT AS PERIMETER CONTROLS AROUND THE PROPOSED TEMPORARY STOCKPILE AREA LOCATED AT THE CONFLUENCE OF THE NORTH BRANCH AND SOUTH BRANCH. (1 DAY)
4. INSTALL TEMPORARY ACCESS BRIDGE NEAR EXISTING SB 10+85. (0 DAYS)

PHASE II: TIE-IN GRADING ZONE (NB 11+00 TO NB 12+00) - 6 DAYS

5. BEGIN TEMPORARY PUMP-AROUND BYPASS (TPB) WITH INTAKE AT THE NB/SB CONFLUENCE AND THE DISCHARGE NEAR NB 12+05, WHICH IS JUST DOWNSTREAM OF THE PROPOSED TIE-IN LOCATION. (0 DAYS)
6. PERFORM CLEARING AND GRUBBING AS NECESSARY. SALVAGE REMOVED TREES AND ALREADY FALLEN TREES AND STOCKPILE WHERE APPROPRIATE WITHIN LOD. (1 DAY)
7. GRADE VALLEY BOTTOM AND SIDE SLOPES TO PROPOSED SUBGRADE (4-6" BELOW FINAL GRADE) BETWEEN NB 11+00 AND NB 11+70. STOCKPILE EXCESS CUT FROM THE TIE-IN GRADING ZONE AT TEMPORARY STOCKPILE LOCATION #1 TO BE USED AS FILL IN NORTH BRANCH GRADING ZONE. (1 DAY)
8. INSTALL SUB-SURFACE ARMORING (SA-3 AND SA-4), ROCK SILLS (RS-30 AND RS-31), AND WOODY DEBRIS / BURIED LOG STRUCTURES AT PROPOSED ELEVATIONS AND LOCATIONS WHILE GRADING VALLEY BOTTOM. (2 DAYS)
9. INSTALL FURNISHED COMPOST PER DETAILS TO MATCH PROPOSED FINAL GRADE FROM NB 11+00 TO NB 11+45. (0.5 DAYS)
10. SEED VALLEY BOTTOM WITH PROPOSED FLOODPLAIN SEED MIX UPON FINAL GRADE FROM NB 11+00 TO NB 11+45. INSTALL TYPE D SOIL STABILIZATION MATTING ALONG VALLEY BOTTOM ACCORDING TO DETAILS FROM NB 11+00 TO NB 11+45. (0.5 DAYS)
11. SEED SIDE SLOPES WITH PROPOSED STABILIZATION SEED MIX. INSTALL TYPE A SOIL STABILIZATION MATTING ON SIDE SLOPES. (0.5 DAYS)
12. END (TPB) TEMPORARY PUMP-AROUND BYPASS (0 DAYS)

PHASE III: SOUTH BRANCH GRADING ZONE (SB 0+70 TO SB 8+25) - 33 DAYS

14. ESTABLISH TEMPORARY ACCESS PATHS USING WOOD CHIP MULCH AS A BASE AND TEMPORARY ACCESS BRIDGES (TB) ACROSS THE EXISTING CHANNEL AS NECESSARY TO ACCESS THE SOUTH BRANCH WITHIN THE LOD. (2 DAYS)
15. INSTALL TEMPORARY BYPASS CHANNEL #1, IF NECESSARY, PUMP ACTIVE FLOW AROUND WORK AREA WHILE CONNECTING THE TEMPORARY BYPASS CHANNEL TO THE EXISTING CHANNEL AS NECESSARY, PUMP SEDIMENT-LADEN WATER THAT COLLECTS IN THE UNFILLED EXISTING CHANNEL NEAR THE CONFLUENCE THROUGH A FILTER BAG AT AN UNDISTURBED AREA OF PREVIOUSLY COMPLETED (AND STABILIZED) AREA WITHIN THE LOD (1 DAY).
16. PERFORM CLEARING AND GRUBBING AS NECESSARY. SALVAGE REMOVED TREES AND ALREADY FALLEN TREES AND STOCKPILE WHERE APPROPRIATE WITHIN LOD. (5 DAYS)
17. BEGIN TPB WITH INTAKE AT THE SB 0+60 AND THE DISCHARGE JUST DOWNSTREAM OF PROJECT REACH NEAR NB 12+05. (0 DAYS)
18. IN AN UPSTREAM TO DOWNSTREAM DIRECTION, GRADE VALLEY BOTTOM AND SIDE SLOPES TO PROPOSED SUBGRADE (4-6" BELOW FINAL GRADE) BETWEEN SB 0+70 AND SB 8+25. STOCKPILE EXCESS CUT FROM THE SOUTH BRANCH GRADING ZONE AT TEMPORARY STOCKPILE LOCATION #1 TO BE USED AS FILL IN NORTH BRANCH GRADING ZONE. (7 DAYS)
19. INSTALL ROCK SILLS (RS-1 THROUGH RS-14), LOG SILLS (LS-1 THROUGH LS-17), AND WOODY DEBRIS / BURIED LOG STRUCTURES AT PROPOSED ELEVATIONS AND LOCATIONS WHILE GRADING VALLEY BOTTOM. (8 DAYS)
20. INSTALL FURNISHED COMPOST PER DETAILS TO MATCH PROPOSED FINAL GRADE FROM SB 0+70 TO SB 8+25. (4 DAYS)
21. SEED VALLEY BOTTOM WITH PROPOSED FLOODPLAIN SEED MIX UPON FINAL GRADE. INSTALL TYPE D SOIL STABILIZATION MATTING ALONG VALLEY BOTTOM ACCORDING TO DETAILS. (3 DAYS)
22. SEED SIDE SLOPES WITH PROPOSED STABILIZATION SEED MIX. INSTALL TYPE A SOIL STABILIZATION MATTING ON SIDE SLOPES. (2 DAYS)
23. REMOVE TEMPORARY ACCESS BRIDGES AS NECESSARY TO COMPLETE GRADING OPERATIONS. (1 DAY)
24. END TPB. (0 DAYS)
25. REPEAT STEPS 17 THROUGH 24 ON A DAILY BASIS UNTIL SOUTH BRANCH GRADING ZONE IS COMPLETED AND STABILIZED ACCORDINGLY. (0 DAYS)

PHASE IV: NORTH BRANCH GRADING ZONE (NB 0+90 TO NB 11+00 AND SB 8+25 TO 9+20) - 39 DAYS


26. ESTABLISH TEMPORARY ACCESS PATHS USING WOOD CHIP MULCH AS A BASE AND TEMPORARY ACCESS BRIDGES (TB) ACROSS THE EXISTING CHANNEL AS NECESSARY TO ACCESS THE NORTH BRANCH WITHIN THE LOD. (2 DAYS)
27. PERFORM CLEARING AND GRUBBING AS NECESSARY. SALVAGE REMOVED TREES AND STOCKPILE WHERE APPROPRIATE WITHIN LOD. (5 DAYS)
28. BEGIN TPB WITH INTAKE AT THE NB 0+70 AND SB 0+60 AND THE DISCHARGE JUST DOWNSTREAM OF PROJECT REACH NEAR NB 12+05. (0 DAYS)
29. IN DOWNSTREAM TO UPSTREAM DIRECTION, GRADE VALLEY BOTTOM AND SIDE SLOPES TO PROPOSED SUBGRADE (4-6" BELOW FINAL GRADE) FROM NB 0+90 TO NB 11+00 AND SB 8+25 TO SB 9+20 USING EXCESS CUT AND STOCKPILED SOIL NEAR THE NB/SB CONFLUENCE TO FILL THE NORTH BRANCH VALLEY BOTTOM. (9 DAYS)
30. INSTALL SUB-SURFACE ARMORING (SA-1 AND SA-2), ROCK SILLS (RS-15 THROUGH RS-29), LOG SILLS (LS-18 THROUGH LS-26), AND WOODY DEBRIS / BURIED LOG STRUCTURES AT PROPOSED ELEVATIONS AND LOCATIONS AND REMOVE TEMPORARY BY-PASS CHANNEL #1 WHILE GRADE VALLEY BOTTOM. (10 DAYS)
31. INSTALL FURNISHED COMPOST PER DETAILS TO MATCH PROPOSED FINAL GRADE FROM NB 0+90 TO NB 11+00 AND SB 8+25 TO SB 9+20+90 TO SB 8+25. (5 DAYS)
32. SEED VALLEY BOTTOM WITH PROPOSED FLOODPLAIN SEED MIX UPON FINAL GRADE. INSTALL TYPE D SOIL STABILIZATION MATTING ALONG VALLEY BOTTOM ACCORDING TO DETAILS. (4 DAYS)
33. SEED SIDE SLOPES WITH PROPOSED STABILIZATION SEED MIX. INSTALL TYPE A SOIL STABILIZATION MATTING ON SIDE SLOPES. (3 DAYS)
34. REMOVE TEMPORARY ACCESS BRIDGES AS NECESSARY TO COMPLETE GRADING OPERATIONS. (1 DAY)
35. END TPB. (0 DAYS)
36. REPEAT STEPS 28 THROUGH 35 ON A DAILY BASIS UNTIL NORTH BRANCH GRADING ZONE IS COMPLETED AND STABILIZED ACCORDINGLY. (0 DAYS)

PHASE V: FINAL STABILIZATION & PLANTING - 6 DAYS

37. UPON PERMANENT STABILIZATION OF THE WORK AREA AND WITH WRITTEN APPROVAL FROM THE ANNE ARUNDEL COUNTY INSPECTOR, THE CONTRACTOR SHALL REMOVE EROSION AND SEDIMENT CONTROLS. ANY AREAS DISTURBED BY THE REMOVAL OF THE EROSION AND SEDIMENT CONTROLS SHALL BE STABILIZED IMMEDIATELY. (1 DAY)
38. INSTALL PROPOSED TREES AND SHRUBS ACCORDING TO PROPOSED LANDSCAPE PLAN. (5 DAYS)

ANNE ARUNDEL COUNTY MARYLAND DEPARTMENT OF PUBLIC WORKS

SLOOP COVE RETROFIT SITE 1- RESTORATION OF THE NORTH BRANCH AND SOUTH BRANCH TRIBUTARIES AA CO. CONTRACT #Q514103/AA CO. PROJECT #Q514100

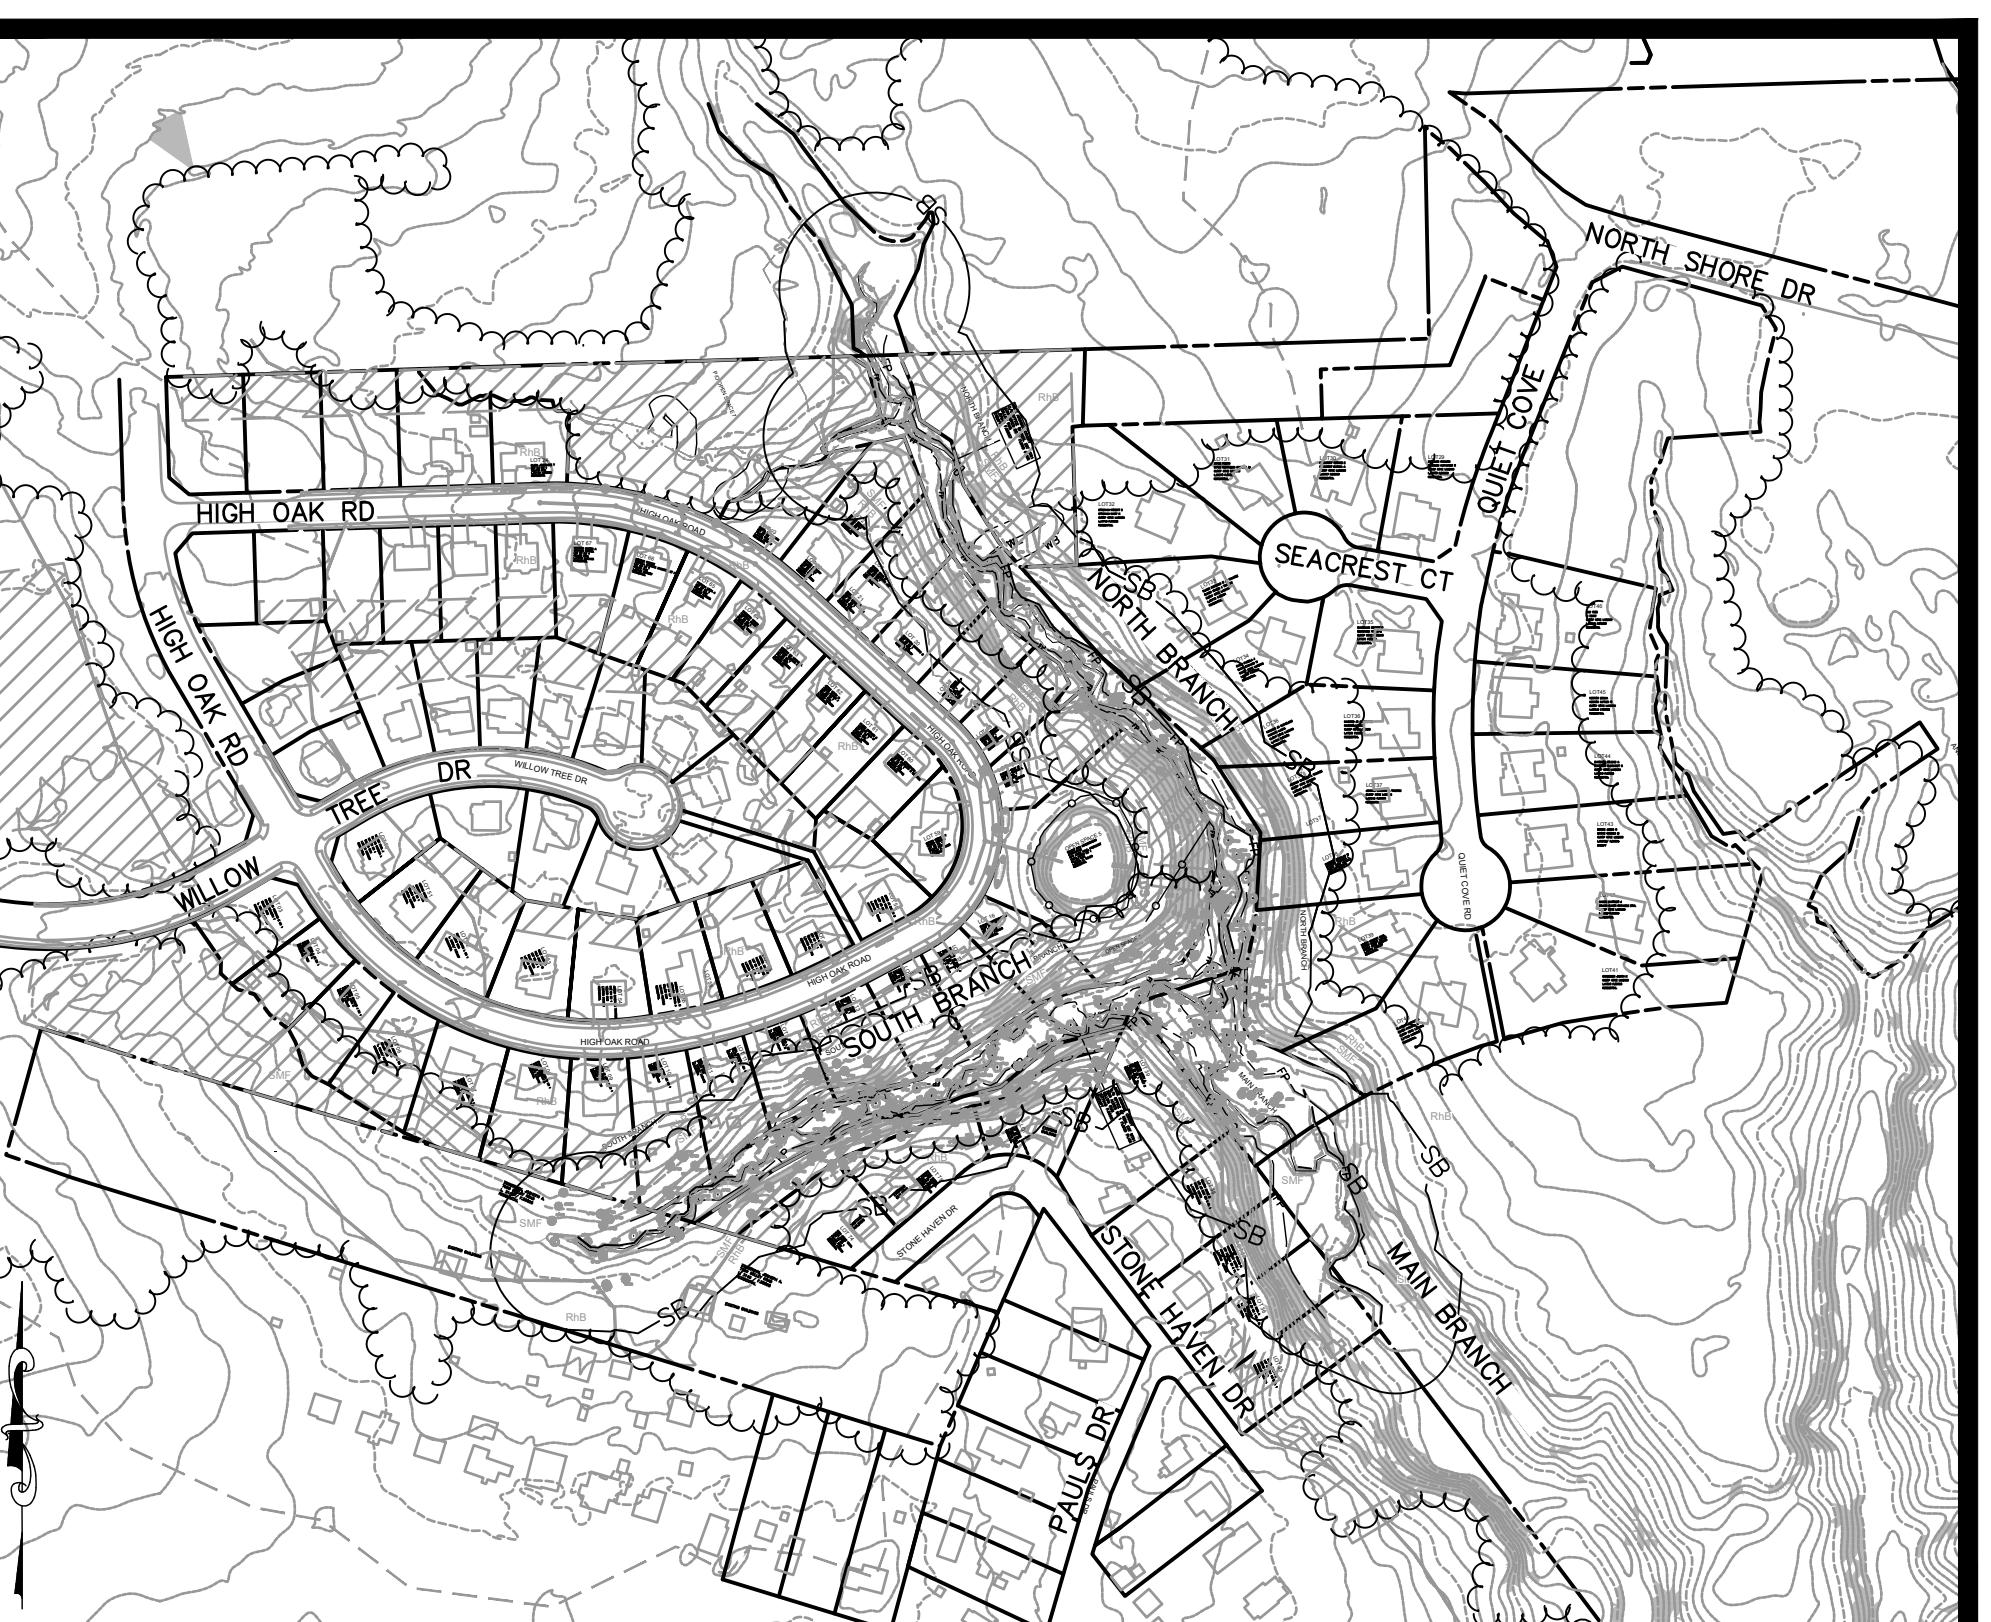

PATAPSCO TIDAL WATERSHED
02-13-09-03

LOCATION MAP

SCALE: 1"=250'
GRAPHIC SCALE
0 250' 500'
1 inch=250 FT



CONSULTANT'S CERTIFICATION

"The Developer's plan to control silt and erosion is adequate to contain the silt and erosion on the property covered by the plan. I certify that this plan of erosion and sediment control represents a practical and workable plan based on my personal knowledge of this site, and was prepared in accordance with the requirements of the Anne Arundel Soil Conservation District Plan Submittal Guidelines and the current Maryland Standards and Specifications for Sediment and erosion Control. I have reviewed this erosion and sediment control plan with the owner/developer.

Printed Name: Joanne M. Cheek, P.E., Senior Associate
MD P.E. License #18095 Expiration: 12/21/2024

Firm Name: Dewberry Consultants, LLC
Street Address: 2101 Gaither Road
Suite 340
Rockville MD 20850
Phone: 301.337.2856
Email: jcheek@Dewberry.com

UTILITY NOTE

INFORMATION CONCERNING UNDERGROUND UTILITIES WAS OBTAINED FROM AVAILABLE RECORDS BUT THE CONTRACTOR MUST DETERMINE THE EXACT LOCATION AND ELEVATION BY DIGGING TEST PITS BY HAND AT ALL UTILITY CROSSINGS WELL IN ADVANCE OF THE START OF EXCAVATION.
IF CLEARANCES ARE LESS THAN SHOWN ON THIS PLAN OR TWELVE (12) INCHES, WHICHEVER IS LESS, CONTACT THE ENGINEER AND THE APPROPRIATE UTILITY COMPANY BEFORE PROCEEDING WITH CONSTRUCTION.

"MISS UTILITY" NOTE


CALL "MISS UTILITY" AT 8-1-1 OR 1-800-257-7777, 48 HOURS PRIOR TO THE START OF GROUND DISTURBING ACTIVITIES OR LOG ON TO: WWW.CALL811.COM OR WWW.MISSUTILITY.NET. THE EXCAVATOR MUST NOTIFY ALL PUBLIC UTILITY COMPANIES WITH UNDERGROUND FACILITIES IN THE AREA OF PROPOSED EXCAVATION AND HAVE THOSE FACILITIES LOCATED BY THE UTILITY COMPANIES PRIOR TO COMMENCING EXCAVATION.

Signature:

Name: Beth O'Connell
Title: Chief Engineer
Affiliation: Anne Arundel County Department of Public Works
Address: 2662 Riva Road, Annapolis, MD 21401
Telephone Number: 410-222-7540
Email Address: BRIGHT@AACOUNTY.ORG

AS-BUILT SHEET INDEX

- 1 OF 13 COVER
- 2 OF 13 STREAM RESTORATION OVERVIEW
- 3 OF 13 STREAM RESTORATION SITE PLAN 1
- 4 OF 13 STREAM RESTORATION SITE PLAN 2
- 5 OF 13 STREAM RESTORATION SITE PLAN 3
- 6 OF 13 STREAM RESTORATION SITE PLAN 4
- 7 OF 13 STREAM RESTORATION SITE PLAN 5
- 8 OF 13 STREAM RESTORATION SITE PLAN 6
- 9 OF 13 CROSS SECTIONS 1-2
- 10 OF 13 CROSS SECTIONS 3-5
- 11 OF 13 CROSS SECTIONS 6-8
- 12 OF 13 CROSS SECTIONS 9-11
- 13 OF 13 CROSS SECTIONS 12-13
- 14 OF 13 CROSS SECTIONS 14-16

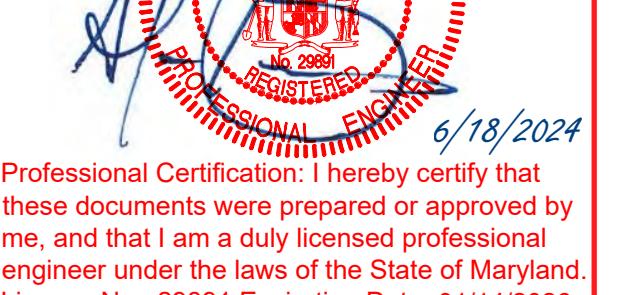

Professional Certification: I hereby certify that these documents were prepared or approved by me, and that I am a duly licensed professional engineer under the laws of the State of Maryland. License No.: 29891 Expiration Date: 01/14/2026


JUNE 2024 AS-BUILT AB-1

COVER SHEET

SLOOP COVE RETROFIT SITE 1

Tax Map 16 Grid 05

Anne Arundel County

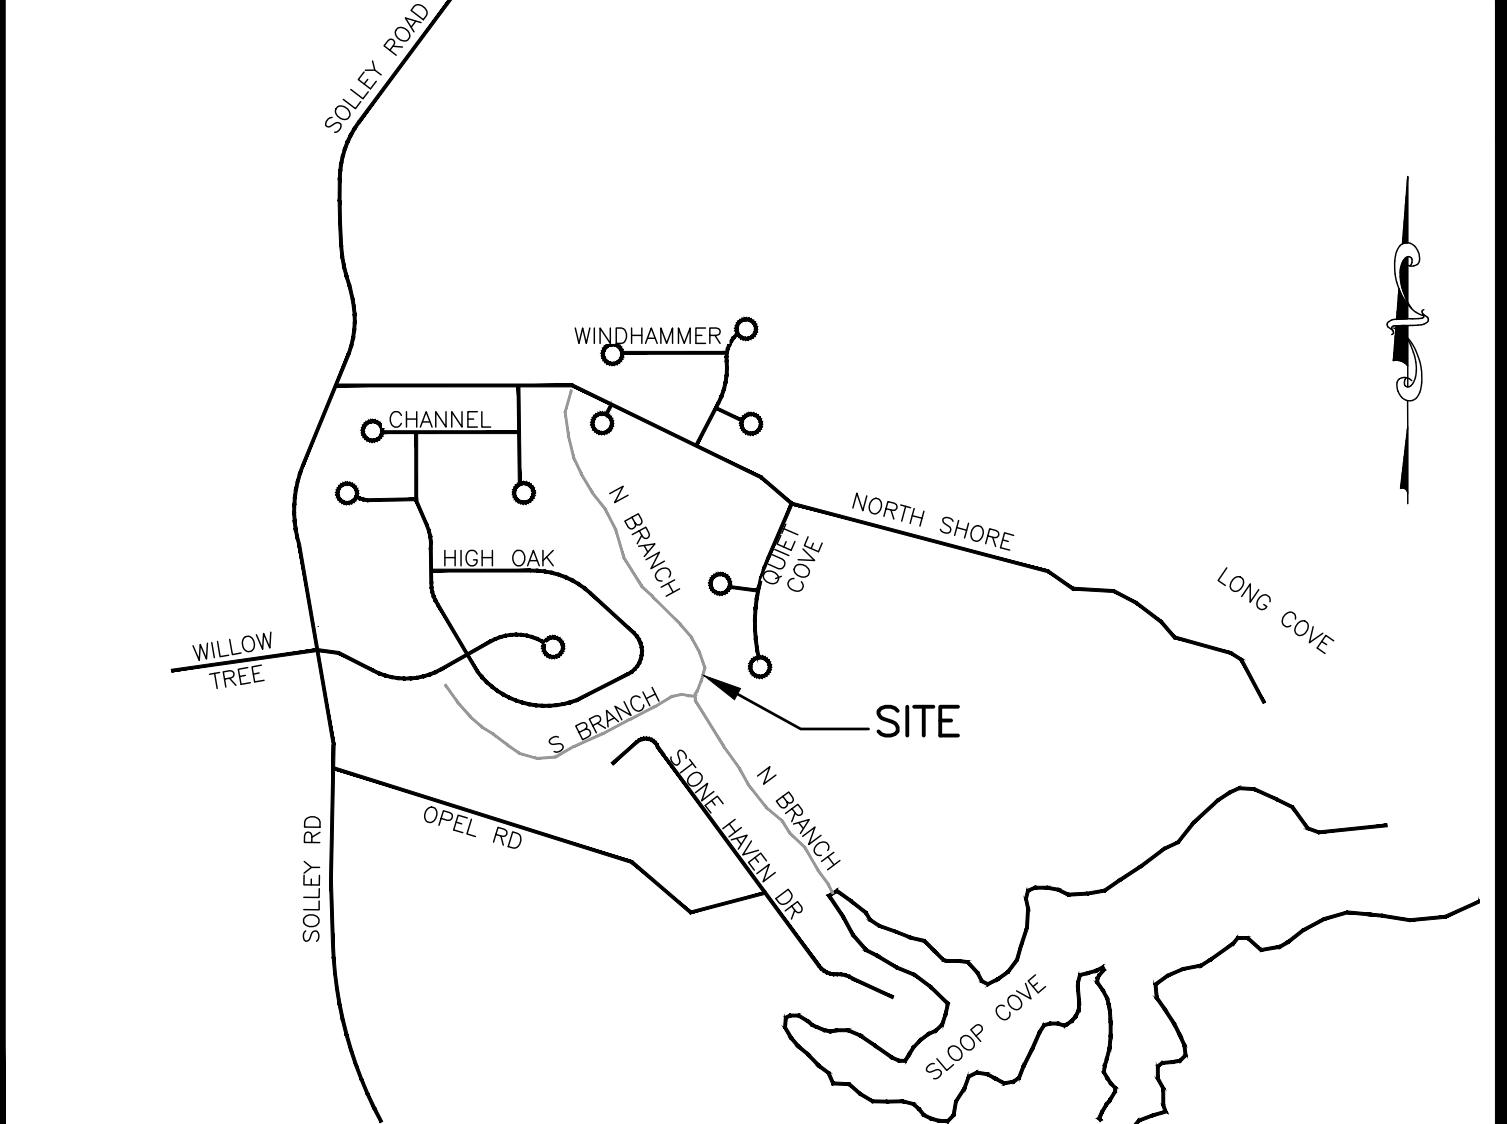

VICINITY MAP

SCALE: 1"=1000'

ADC MAP 505 GRID K6/K7

OWNER/DEVELOPER/APPLICANT	
717-627-4440 fax: 717-627-4660 landstudies.com land@landstudies.com 315 North Street Lititz, PA 17543	CIVIL ENGINEER A.A. County ID #721 Dewberry 2101 Gaither Road Suite #340 Rockville, MD 20850 Contact: Joanne M. Cheek, Senior Associate Phone: (301) 337-2856 Fax: (301) 258-7607

REVISIONS	
NO	Description
1	Revise 100-yr floodplain
2	ADRESSED AA COUNTY COMMENTS
3	ADRESSED AA COUNTY COMMENTS
4	ADRESSED AA COUNTY COMMENTS

ANNE ARUNDEL COUNTY			
DEPARTMENT OF PUBLIC WORKS			
STREAM RESTORATION PLAN			
APPROVED	DATE	APPROVED	DATE
CHIEF ENGINEER		PROJECT MANAGER	
APPROVED	DATE	APPROVED	DATE
ASSISTANT CHIEF ENGINEER		CHIEF, RIGHT OF WAY	
SHEET NO: 1 OF 39		PROJECT NO: 50017963	
		PROPOSAL NO:	

13
3rd District

CONSTRUCTION NOTES

1. THE CONTRACTOR SHALL NOTIFY THE MARYLAND DEPARTMENT OF THE ENVIRONMENT (MDE) WATER MANAGEMENT ADMINISTRATION (WMA) AT (410) 537-3510 SEVEN (7) DAYS BEFORE COMMENCING ANY LAND DISTURBING ACTIVITY AND SHALL BE REQUIRED TO HOLD A PRE-CONSTRUCTION MEETING BETWEEN PROJECT REPRESENTATIVES AND A REPRESENTATIVE OF WMA.
2. MAINTAIN ALL SEDIMENT CONTROL PRACTICES ACCORDING TO MARYLAND 2011 STANDARDS UNTIL THE ENTIRE SITE IS STABILIZED.
3. STAGING AND STOCKPILING SHALL BE LOCATED WITHIN THE LOD AS DETERMINED BY THE PROJECT DESIGNER AND CONTRACTOR AND WITH THE MDE INSPECTOR'S APPROVAL OR ON AN AS NEEDED BASIS DURING CONSTRUCTION. THIS MOSTLY APPLIES TO FURNISHED ROCK AND/OR SALVAGED WOODY MATERIALS BEING TEMPORARILY STORED IN CLOSE PROXIMITY TO LOCATIONS WHERE THEY WILL BE USED FOR PROPOSED STRUCTURES. EXCESS CUT WILL BE HAULED TO THE TEMPORARY STOCKPILE LOCATED NEAR THE NORTH BRANCH (NB) / SOUTH BRANCH (SB) CONFLUENCE UNTIL IT IS USED FOR FILL ALONG THE NORTH BRANCH.
4. ACTIVE FLOW SHALL BE DIVERTED AROUND THE WORK AREA USING A SERIES OF TEMPORARY PUMP-AROUND BYPASS (TPB). ALTHOUGH THE EXISTING CHANNEL IS TYPICALLY DRY DURING THE SUMMER MONTHS, THE TPB SHOULD HAVE PUMP CAPACITY TO EFFECTIVELY MANAGE A DISCHARGE OF AT LEAST 2 CFS. IF NECESSARY, SUMPS SHALL BE CREATED TO PROVIDE ADEQUATE DEPTH FOR PUMP WITHDRAWAL. UNDER LOW FLOW CONDITIONS, FLOW MAY BE DISCHARGED THROUGH A FILTER BAG AT AN UNDISTURBED AREA OR PREVIOUSLY COMPLETED (AND STABILIZED) AREA WITHIN THE LOD. IF FLOW EXCEEDS CAPACITY OF A FILTER BAG, FLOW MAY BE DISCHARGED INTO THE EXISTING CHANNEL DOWNSTREAM OF THE PROJECT REACH UTILIZING A FOUNTAIN OR OTHER ENERGY DISSIPATION DEVICE AS AGREED TO BY THE PROJECT DESIGNER AND CONTRACTOR AND WITH THE MDE INSPECTOR'S APPROVAL.

5. TEMPORARY ACCESS BRIDGE (TB) CROSSINGS SHALL BE INSTALLED ACROSS THE EXISTING CHANNEL AS NECESSARY TO PROVIDE ACCESS TO BOTH SIDES OF THE CHANNEL. THE LOCATIONS OF TB's MAY VARY FROM PLANS IF NECESSARY.

6. TEMPORARY BYPASS CHANNELS SHALL BE CONSTRUCTED AS NECESSARY TO MINIMIZE TEMPORARY ACCESS BRIDGE CROSSINGS AND IMPROVE THE EFFICIENCY OF CONSTRUCTION WHILE MAINTAINING CONVEYANCE OF ACTIVE FLOW.

7. CLEARING AND GRUBBING OF THE UNDERSTORY SHALL BE LIMITED ONLY TO THOSE AREAS WITHIN THE PROPOSED LIMIT OF DISTURBANCE.

8. EVERY ATTEMPT SHALL BE MADE TO PROTECT EXISTING TREES WITHIN THE PROPOSED LIMIT OF DISTURBANCE ESPECIALLY THOSE WITH DBH'S GREATER THAN 12 INCHES. TREES THAT MUST BE REMOVED AS WELL AS OTHER PREVIOUSLY FALLEN TREES SHALL BE SALVAGED, PROCESSED, AND STOCKPILED ON-SITE TO BE USED FOR PROPOSED LOG SILLS AND WOODY DEBRIS / BURIED LOG STRUCTURES. NO WOODY MATERIAL WILL BE EXPORTED FROM THE SITE.

9. THE PROPOSED VALLEY BOTTOM AND SIDE SLOPES SHALL BE FILLED OR EXCAVATED TO SUBGRADE ELEVATIONS 4-6" BELOW PROPOSED FINAL GRADE.

10. 4.5" OF FURNISHED COMPOST COMPOSED OF A MIXTURE OF UNPROCESSED WOOD CHIPS AND SOIL (SEE SPECIFICATIONS IN PROJECT MANUAL) SHALL BE INSTALLED OVER THE PROPOSED VALLEY BOTTOM AND SIDE SLOPES TO MEET PROPOSED FINAL GRADE.

11. 31 ROCK SILL GRADE CONTROL STRUCTURES SHALL BE INSTALLED ACCORDING TO DETAILS AT LOCATIONS INDICATED ON PLANS.

12. 26 LOG SILL GRADE CONTROL STRUCTURES SHALL BE INSTALLED ACCORDING TO DETAILS AT LOCATIONS INDICATED ON PLANS

13. A MINIMUM OF 80 WOODY DEBRIS / BURIED LOG STRUCTURES SHALL BE INSTALLED ACCORDING TO DETAILS AT LOCATIONS INDICATED ON PLANS OR AS IDENTIFIED BY PROJECT DESIGNER OR CONSTRUCTION MANAGER.

14. PROPOSED STRUCTURES (ROCK SILLS, LOG SILLS, AND WOODY DEBRIS / BURIED LOG STRUCTURES) SHALL BE INSTALLED UNDER THE DIRECT SUPERVISION OF AND/OR SUBJECT TO THE APPROVAL OF THE PROJECT DESIGNER OR CONSTRUCTION MANAGER. IF STRUCTURE INSTALLATION AND PERFORMANCE ARE NOT IN ACCORDANCE WITH THE DETAILS AND SPECIFICATIONS, THE STRUCTURE SHALL BE RE-SET OR REINSTALLED IN ACCORDANCE WITH THE DESIGN DETAILS AND SPECIFICATIONS.

15. THE LOCATION, ORIENTATION, COMPOSITION, AND AMOUNT OF ALL PROPOSED STRUCTURES MAY BE MODIFIED FROM THE PLANS UNDER DIRECTION OF THE PROJECT DESIGNER OR CONSTRUCTION MANAGER AS NECESSARY DURING CONSTRUCTION.

16. IT HAS BEEN CALCULATED THAT THE TOTAL CUT AND FILL WILL BE BALANCED WHEN TAKING INTO ACCOUNT THE VOLUME ASSOCIATED WITH FURNISHED COMPOST AND PROPOSED STRUCTURES. CONSTRUCTION HAS BEEN SEQUENCED IN A MANNER IN WHICH EXCESS CUT MATERIAL WILL BE GENERATED AND TRANSPORTED TO AREAS REQUIRING FILL AS EFFICIENTLY AS POSSIBLE. FOR EXAMPLE, THE MAJORITY OF CUT WILL OCCUR NEAR THE NB/SB CONFLUENCE, WHILE A SIGNIFICANT AMOUNT OF FILL IS REQUIRED ALONG THE MAJORITY OF NORTH BRANCH. AS SUCH, MATERIAL GENERATED NEAR THE CONFLUENCE MUST BE HAULED OR PUSHED IN AN UPSTREAM DIRECTION TO BRING THE VALLEY BOTTOM OF NORTH BRANCH UP TO PROPOSED SUBGRADE ELEVATIONS. IT IS ANTICIPATED THAT A RELATIVE EQUAL BALANCE OF CUT AND FILL WILL OCCUR ALONG THE MAJORITY OF THE SOUTH BRANCH. AS A RESULT, THE SOUTH BRANCH SHALL BE CONSTRUCTED IN AN UPSTREAM TO DOWNSTREAM DIRECTION AND THE NORTH BRANCH SHALL BE CONSTRUCTED IN A DOWNSTREAM TO UPSTREAM DIRECTION.

17. IF NECESSARY, SEDIMENT-LADEN WATER WITHIN UNFILLED PORTIONS OF THE EXISTING CHANNEL SHALL BE PUMPED THROUGH A FILTER BAG, AS SPECIFIED IN DETAILS, AND DISCHARGED WITHIN AN STABLE, UNDISTURBED AREA OR A PREVIOUSLY COMPLETED / STABILIZED AREA WITHIN THE LOD.

18. AT THE END OF EACH WORK DAY, THE CONTRACTOR SHALL ESTABLISH STABLE TEMPORARY CONNECTIONS FROM THE WORK AREA TO THE EXISTING CHANNEL (ALONG THE SOUTH BRANCH GRADING ZONE) OR THE COMPLETED PROPOSED VALLEY BOTTOM (ALONG THE NORTH BRANCH GRADING ZONE).


19. TYPE D SOIL STABILIZATION MATTING SHALL BE INSTALLED OVER THE PROPOSED VALLEY BOTTOM SURFACE UPON FINAL GRADE. THE ENDS OF THE MATTING SHALL BE KEYED INTO THE EXISTING GROUND BY 6" (MINIMUM). THE PROPOSED VALLEY BOTTOM SHALL BE SEEDED WITH THE PROPOSED FLOODPLAIN SEED MIX PRIOR TO INSTALLING MATTING.

20. TYPE A SOIL STABILIZATION MATTING SHALL BE INSTALLED ON GRADED SIDE SLOPES. THE PROPOSED SIDE SLOPES SHALL BE SEEDED WITH THE PROPOSED STABILIZATION SEED MIX PRIOR TO INSTALLING MATTING.


21. ALL REMAINING DISTURBED AREAS SHALL BE STABILIZED WITH THE PROPOSED

2019 STREAM RESTORATION

1. TEMPORARY STABILIZATION NOTES:
 - 1.1. TEMPORARY STABILIZATION FOR ANY DISTURBED AREAS ON THE FLOODPLAIN AND TERRACES ADJACENT TO THE RESTORED STREAM CHANNEL SHALL BE CONSIDERED ACHIEVED USING ONE OF THE FOLLOWING MEASURES.
 - 1.1.1. THE DISTURBED AREA IS UNIFORMLY COVERED WITH 2 TO 4 INCHES OF WOOD CHIPS.
 - 1.1.2. THE DISTURBED AREA HAS BEEN SEEDED WITH ANNUAL RYE GRASS FOLLOWING THE TEMPORARY SEEDING APPLICATION PERIODS FOUND UNDER THE ANNE ARUNDEL SOIL CONSERVATION DISTRICT'S (AASCD) VEGETATIVE ESTABLISHMENT SPECIFICATION OR 2011 STANDARDS AND STANDARD AND SPECIFICATIONS FOR SOIL EROSION AND SEDIMENT CONTROL. NO SOIL TEST, LIME OR FERTILIZER WILL BE REQUIRED.
1. PERMANENT STABILIZATION NOTES:
 - 1.1. PERMANENT STABILIZATION FOR CONSTRUCTED STREAM BANKS GREATER THAN 6 INCHES SHALL BE CONSIDERED ACHIEVED WHEN ALL STREAM BANKS ARE SEEDED (NATIVE SEED MIX) AND LINED WITH A FULLY BIODEGRADABLE STABILIZATION MATTING WITH APPROPRIATE STRENGTH PROPERTIES DEPENDENT ON LOCAL SHEAR STRESS CONDITIONS.
 - 1.2. PERMANENT STABILIZATION FOR DISTURBED FLOODPLAIN AND TERRACES ADJACENT TO THE RESTORED STREAM CHANNEL SHALL BE CONSIDERED ACHIEVED USING ONE OF THE FOLLOWING MEASURES:
 - 1.2.1. THE DISTURBED AREA IS COVERED WITH 2 TO 4 INCHES OF COMPOST (APPLIED OVER ANY WOOD CHIPS USED FOR TEMPORARY STABILIZATION) AND THE NATIVE PLANTING PLAN (INCLUDING PERMANENT SEEDING) HAS BEEN IMPLEMENTED.
 - 1.2.2. THE DISTURBED AREA IS COVERED WITH 2 TO 4 INCHES OF WOOD CHIPS TRACKED INTO SOIL AND THE NATIVE PLANTING PLAN (INCLUDING PERMANENT SEEDING) HAS BEEN IMPLEMENTED.
 - 1.2.3. THE DISTURBED AREA IS COVERED WITH 2 TO 4 INCHES OF TOPSOIL (FURNISHED OR SALVAGED) AND FULLY BIODEGRADABLE STABILIZATION MATTING INSTALLED PER MANUFACTURER'S INSTRUCTIONS AND A NATIVE PLANTING PLAN (INCLUDING PERMANENT SEEDING) HAS BEEN IMPLEMENTED, REGARDLESS OF SOIL TREATMENT
 - 1.2.4. THE DISTURBED AREAS SHALL RECEIVE HYDROSEEDING OR FLEXIBLE GROWTH MEDIUM (FGM) AFTER THE ESTABLISHMENT OF FINAL GRADES AND MICROTOPOGRAPHY (IF APPLICABLE) IN ACCORDANCE WITH THE PROJECT CONSTRUCTION DETAILS OR LANDSCAPING PLANS.
 - 1.2.5. THE DISTURBED AREA HAS ADEQUATE VEGETATIVE ESTABLISHMENT WITH 95% GROUNDCOVER

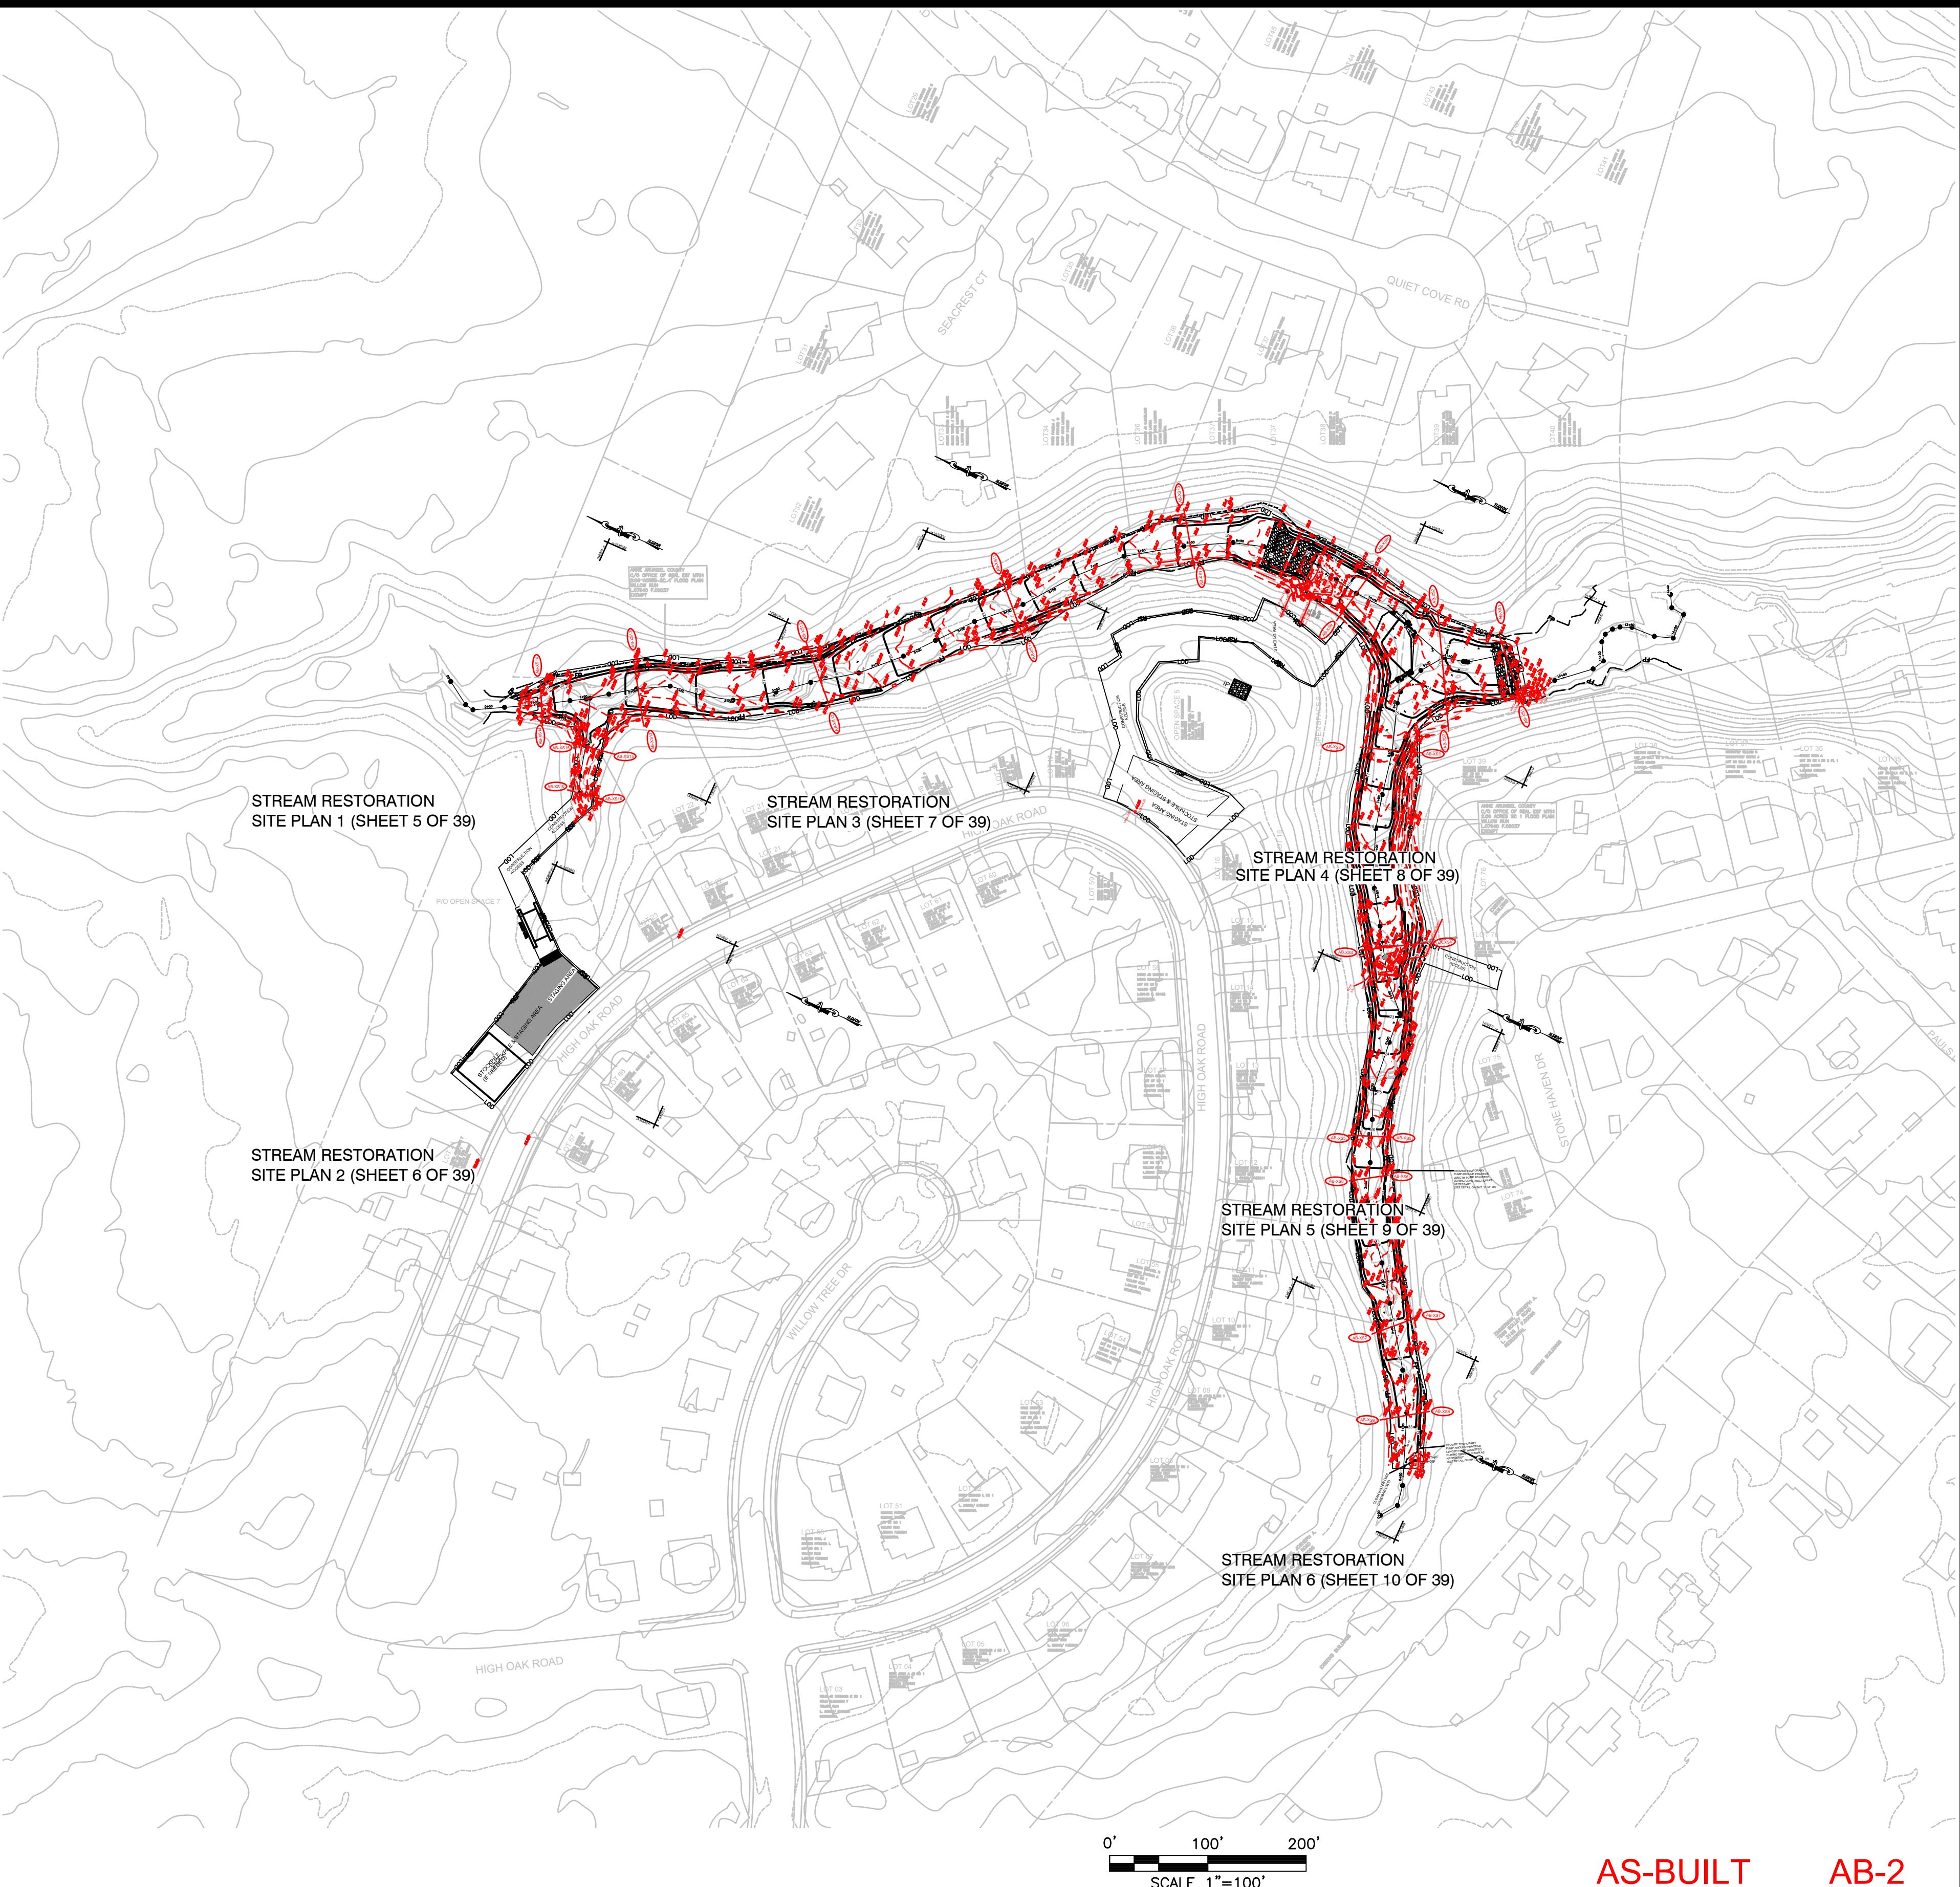


AS-BUILT AB-2


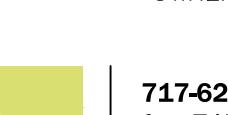
OWNER/DEVELOPER/APPLICANT		CIVIL ENGINEER A.A. County ID #721		REVISIONS			
 717-627-4440 fax: 717-627-4660 landstudies.com land@landstudies.com 315 North Street Lititz, PA 17543		 Dewberry PA 042324 2101 Gaither Road Suite #340 Rockville, MD 20850 Contact: Joanne M. Cheok, Senior Associate Phone: (301) 337-2856 Fax: (301) 258-7607		ANNE ARUNDEL COUNTY DEPARTMENT OF PUBLIC WORKS STREAM RESTORATION PLAN OVERVIEW SLOOP COVE RETROFIT SITE 1 Anne Arundel County 3rd District Tax Map 16 Grid 05			
				Professional Certification: I hereby certify that these documents were prepared or approved by me, and that I am a duly licensed professional engineer under the laws of the State of Maryland, License No. 213 Expiration Date:			
NO	Description		BY	DATE			
1	Revise 100-yr floodplain		LSI/ DEW	1/2021			
2	ADDRESSED AA COUNTY COMMENTS		CG/ DEW	9/07/22	APPROVED	DATE	APPROVED
3	ADDRESSED AA COUNTY COMMENTS		LSI/ DEW	11/01/22	SCALE:	As Shown	STREAM RESTORATION PLAN
4	ADDRESSED AA COUNTY COMMENTS		LSI/ DEW	01/10/23	DRAWN BY:	BJF/R. Anchors	
				CHECKED BY:		J. Cheok	
				SHEET NO:		2/13	
				PROJECT NO:		501793	
				ASSISTANT CHIEF ENGINEER		CHIEF HIGHWAY	
						PROPOSAL NO:	

MATCHLINE SITE PLAN 3 (SHEET 4 OF 14)

EXISTING LEGEND

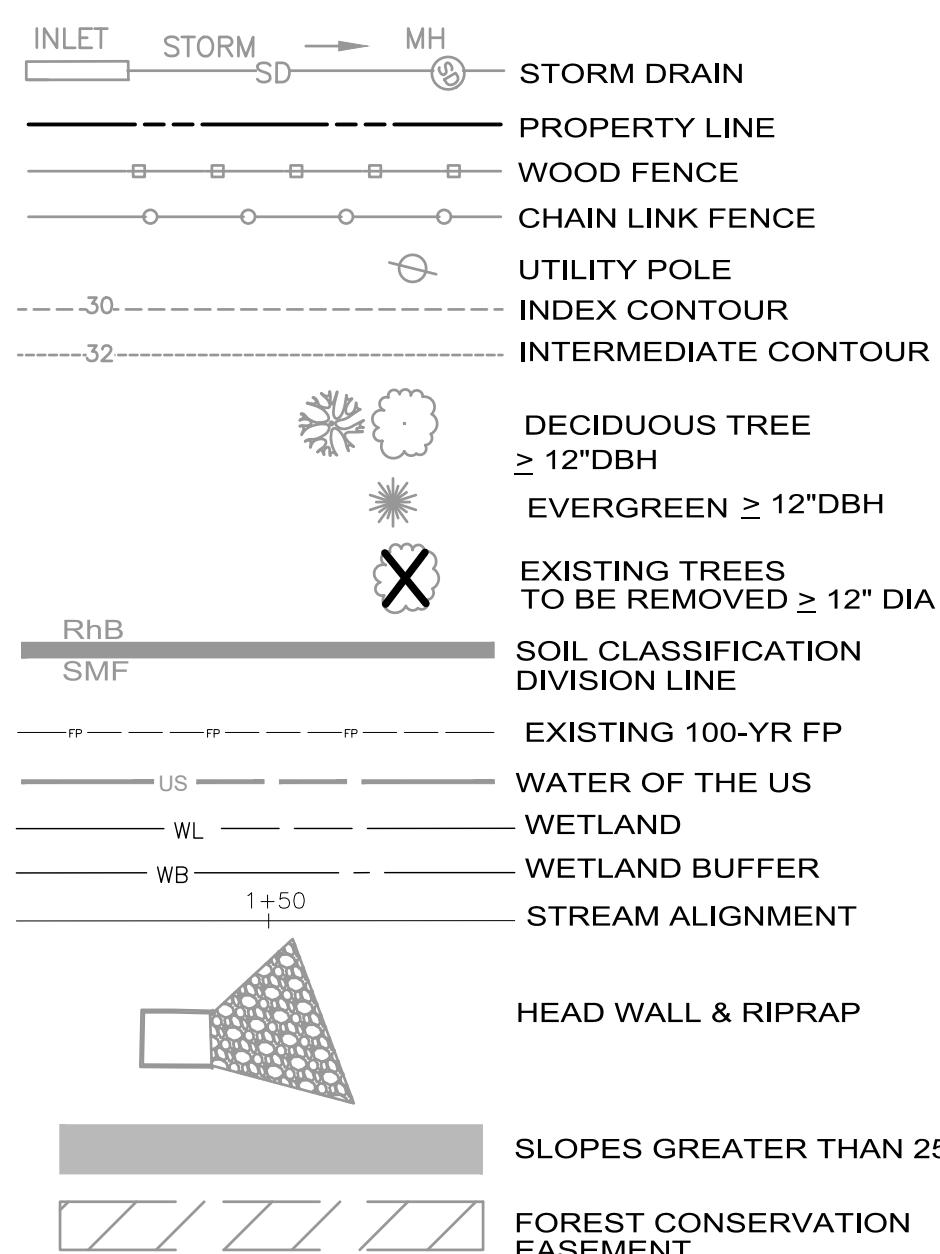

PROPOSED LEGEND

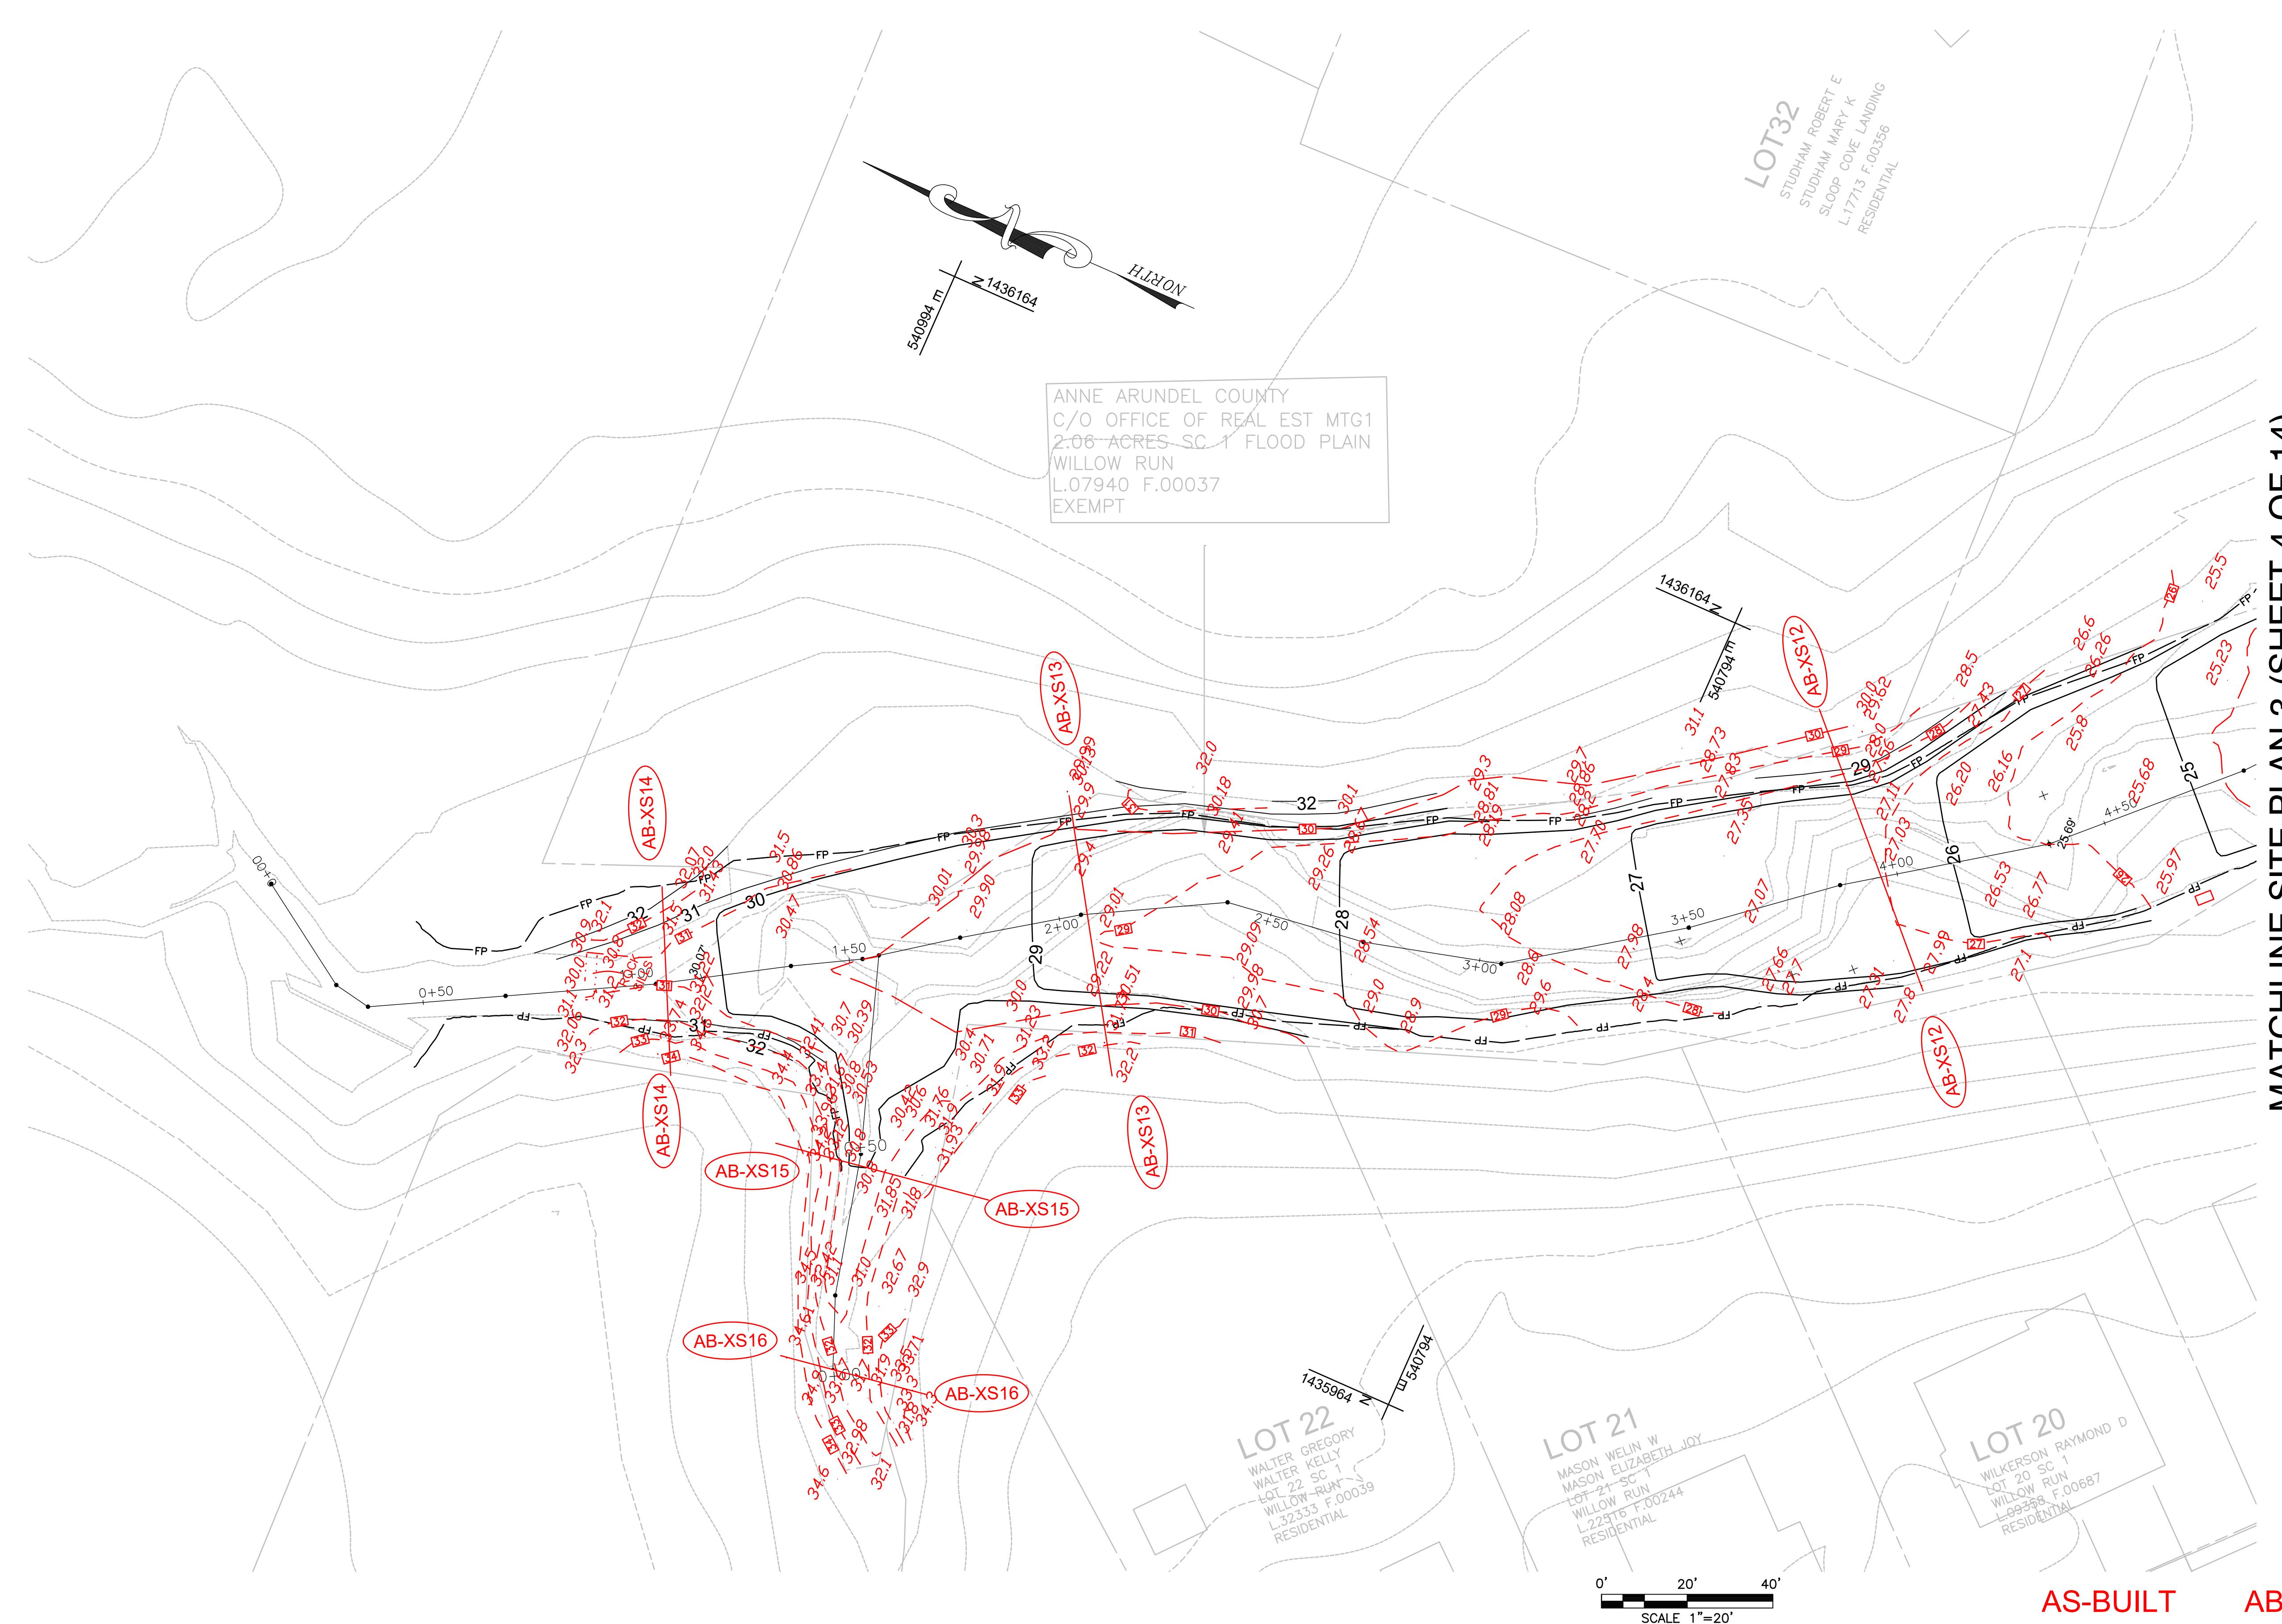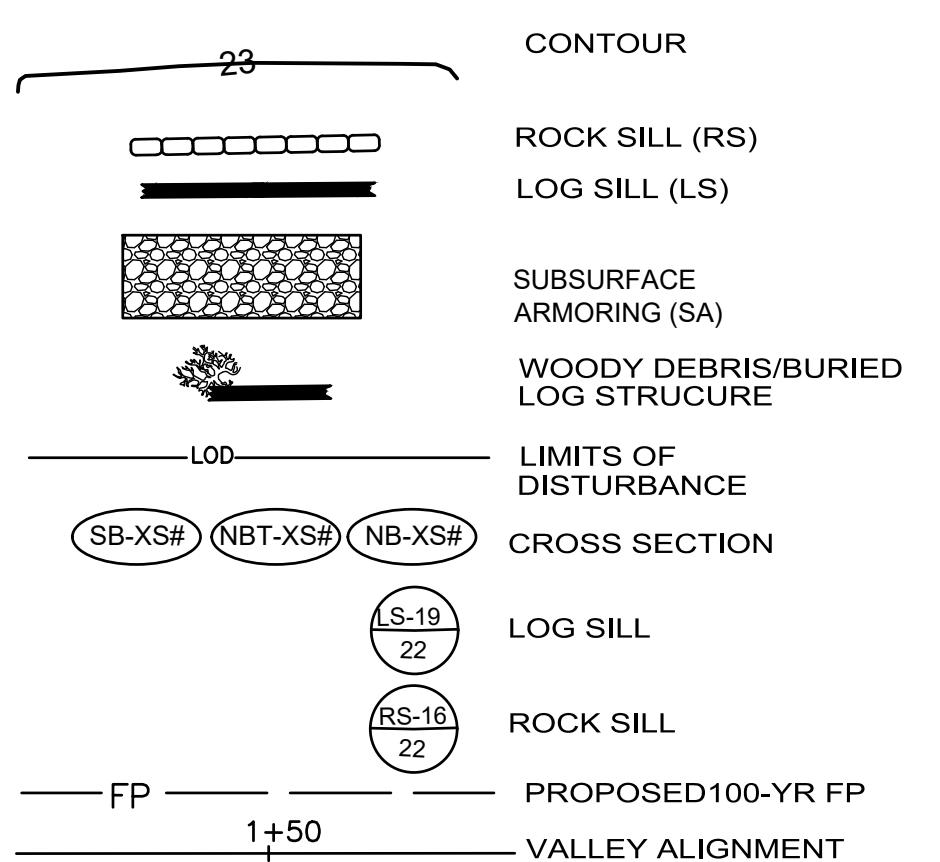

OWNER/DEVELOPER/APPLICANT
717-627-4440 fax: 717-627-4660 landstudies.com 315 North Street Lititz, PA 17543

CIVIL ENGINEER A.A. County ID #721
Dewberry 2101 Gaither Road Suite #340 Rockville, MD 20850 Contact: Joanne M. Cheok, Senior Associate Phone: (301) 337-2856 Fax: (301) 258-7607

Professional Certification: I hereby certify that these documents were prepared or approved by me, and that I am a duly licensed professional engineer under the laws of the State of Maryland.
License No.:
Expiration Date:


REVISIONS			
NO.	Description	BY	DATE
1	Revise 100-yr floodplain	LSI/ DEW	1/2021
2	ADDRESSED AA COUNTY COMMENTS	CG/ DEW	9/07/22
3	ADDRESSED AA COUNTY COMMENTS	LSI/ DEW	11/01/22
4	ADDRESSED AA COUNTY COMMENTS	LSI/ DEW	01/10/23

ANNE ARUNDEL COUNTY					
DEPARTMENT OF PUBLIC WORKS					
STREAM RESTORATION PLAN					
APPROVED	DATE	APPROVED	DATE	SCALE:	As Shown
CHIEF ENGINEER		PROJECT MANAGER		DRAWN BY:	Buf/R. Anchors
APPROVED	DATE	APPROVED	DATE	CHECKED BY:	J. Cheok
ASSISTANT CHIEF ENGINEER		CHIEF, RIGHT OF WAY		SHEET NO.:	34 OF 39
				PROJECT NO.:	50017963
				PROPOSAL NO.:	





14
3rd District

RESTORATION SITE PLAN 1
SLOOP COVE RETROFIT SITE 1
Tax Map 16 Grid 05

Anne Arundel County

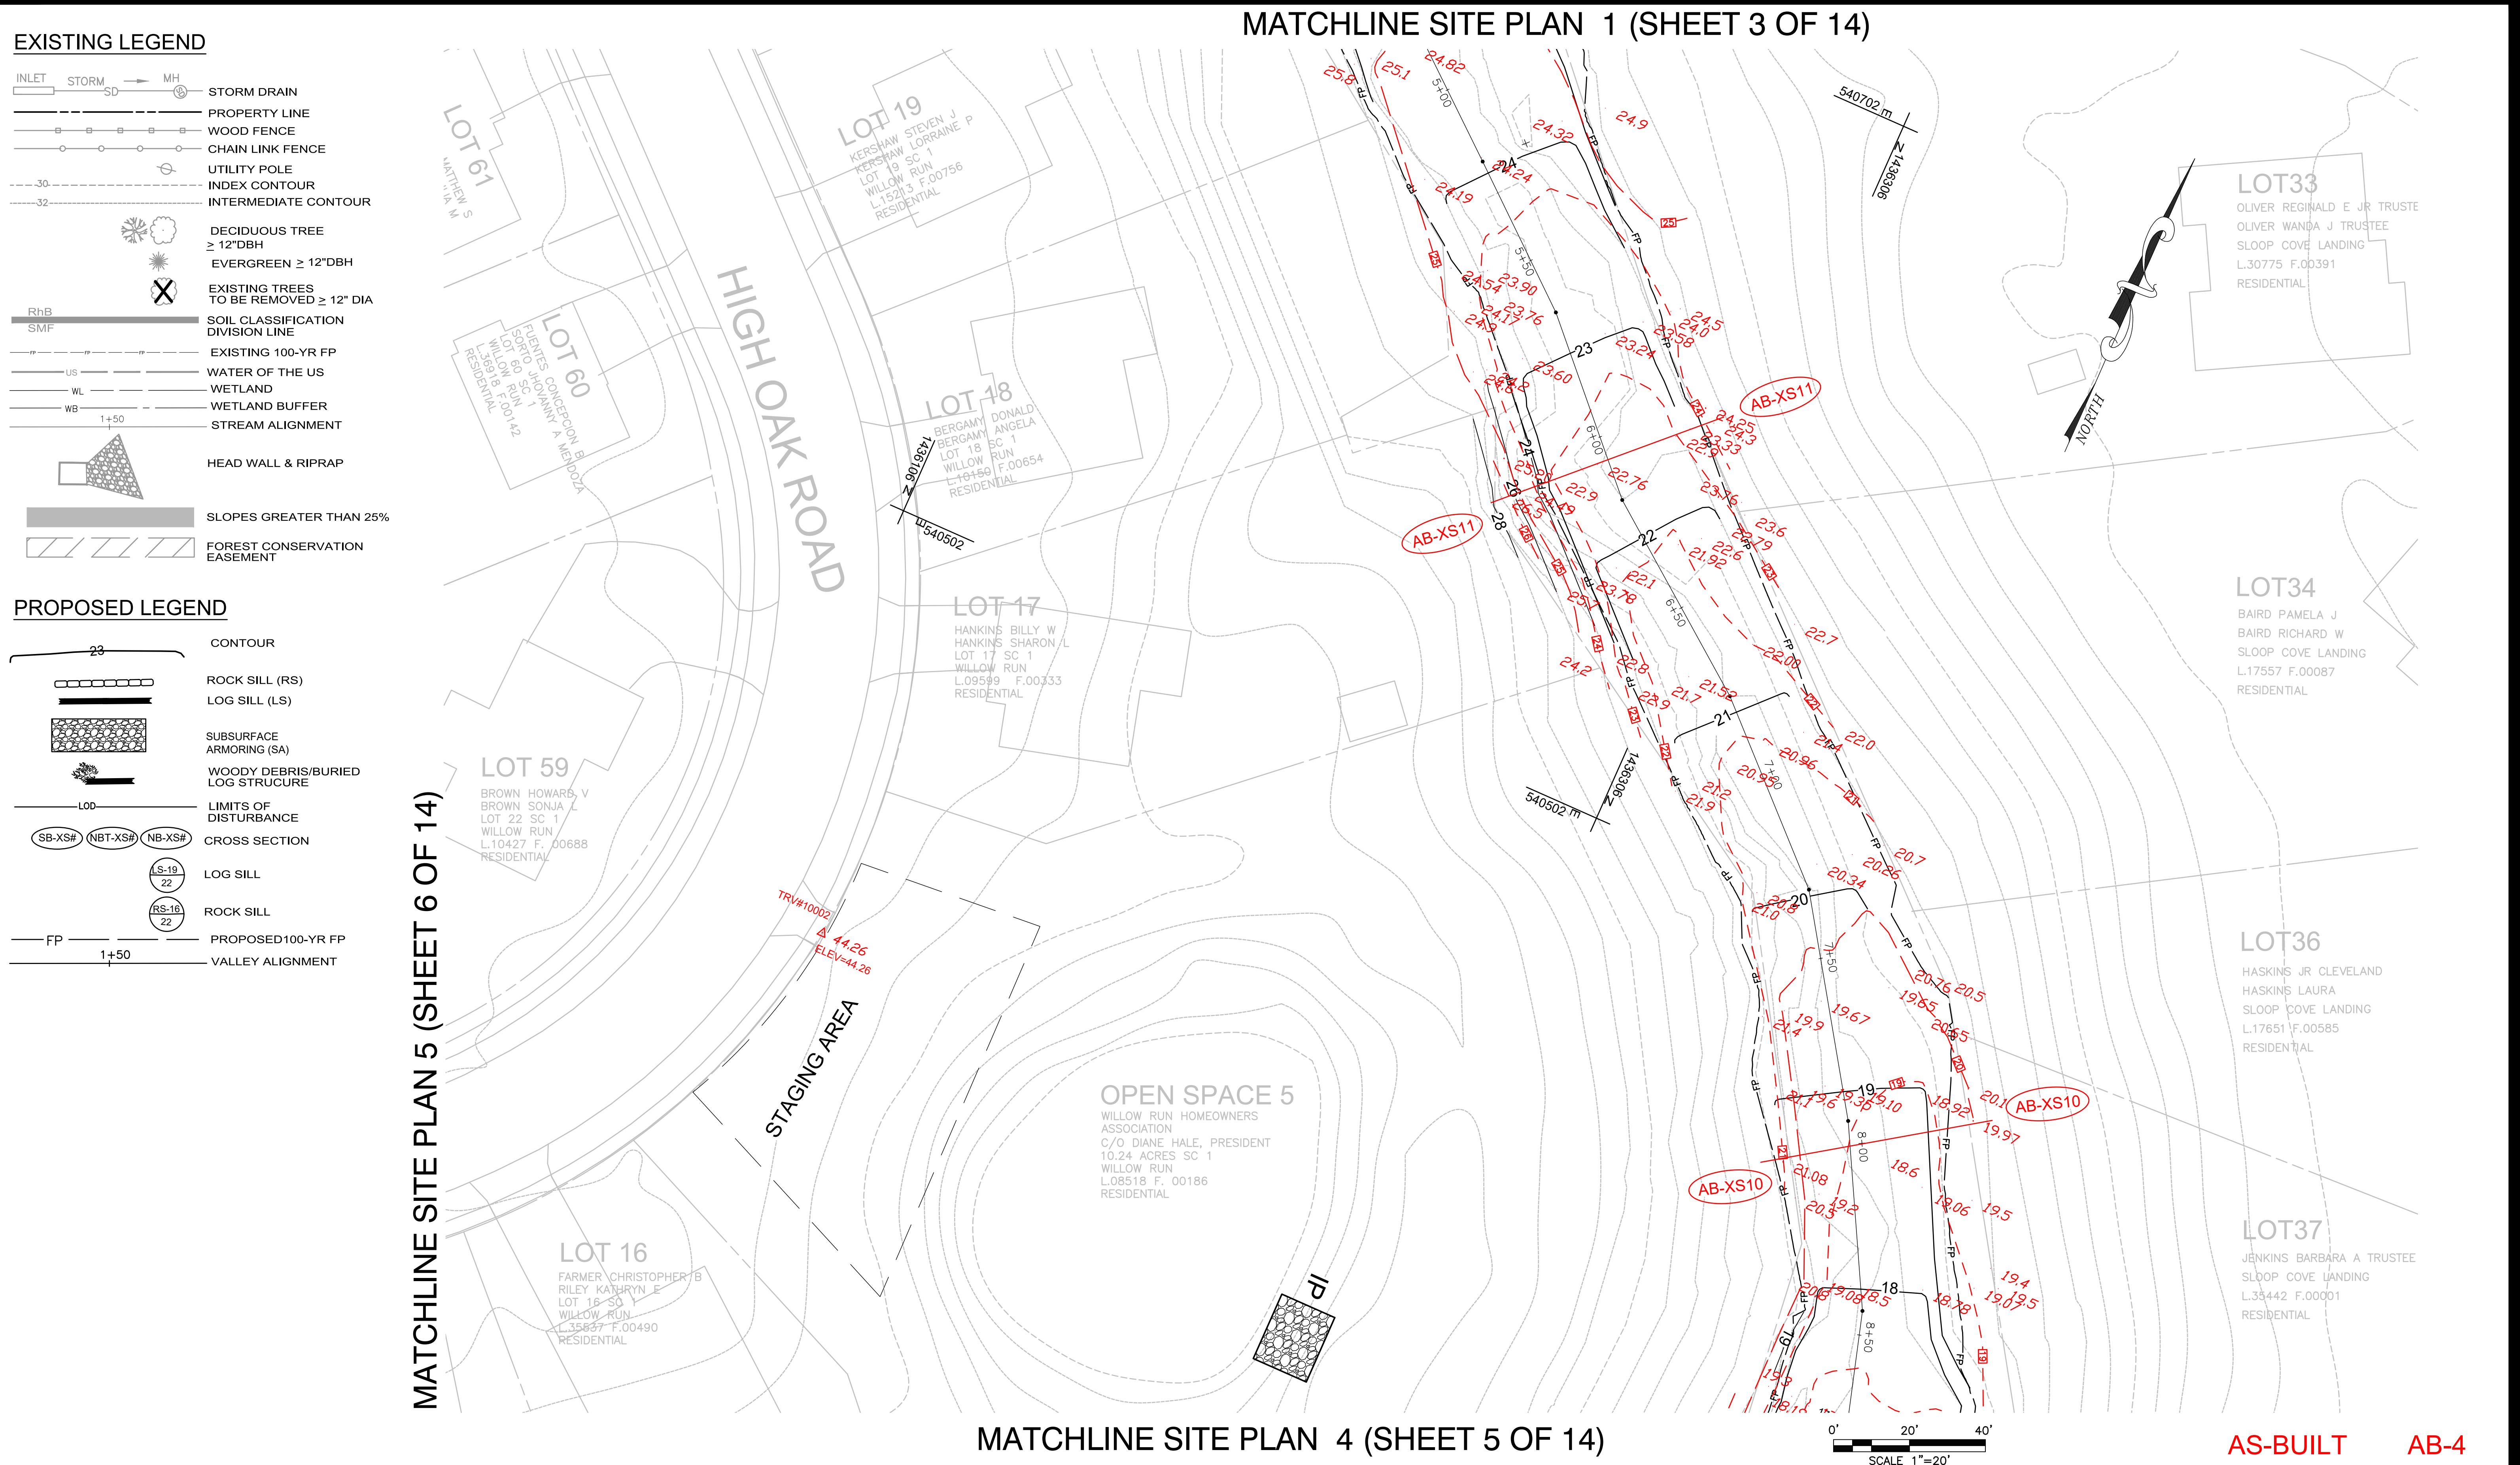

OWNER/DEVELOPER/APPLICANT		CIVIL ENGINEER A.A. County ID #721		REVISIONS		ANNE ARUNDEL COUNTY					
717-627-4440 fax: 717-627-4660 landstudies.com 315 North Street Lititz, PA 17543		Professional Certification: I hereby certify that these documents were prepared or approved by me, and that I am a duly licensed professional engineer under the laws of the State of Maryland.	License No. Expiration Date:	1	Revise 100-yr floodplain	LSI/ DEW	1/2021	DEPARTMENT OF PUBLIC WORKS			
		2	ADDRESSED AA COUNTY COMMENTS	CG/ DEW	9/07/22	APPROVED	DATE	APPROVED	DATE	SCALE: As Shown	
		3	ADDRESSED AA COUNTY COMMENTS	LSI/ DEW	11/01/22	CHIEF ENGINEER	PROJECT MANAGER	DRAWN BY: BuF/R. Anchors	CHECKED BY: J. Cheok	SHEET NO: 47 OF 39	
		4	ADDRESSED AA COUNTY COMMENTS	LSI/ DEW	01/10/23	APPROVED	DATE	ASSISTANT CHIEF ENGINEER	CHIEF, RIGHT OF WAY	PROJECT NO: 50017963	
										PROPOSAL NO: 3rd District	
14										RESTORATION SITE PLAN 3 SLOOP COVE RETROFIT SITE 1 Tax Map 16 Grid 05	
Anne Arundel County											

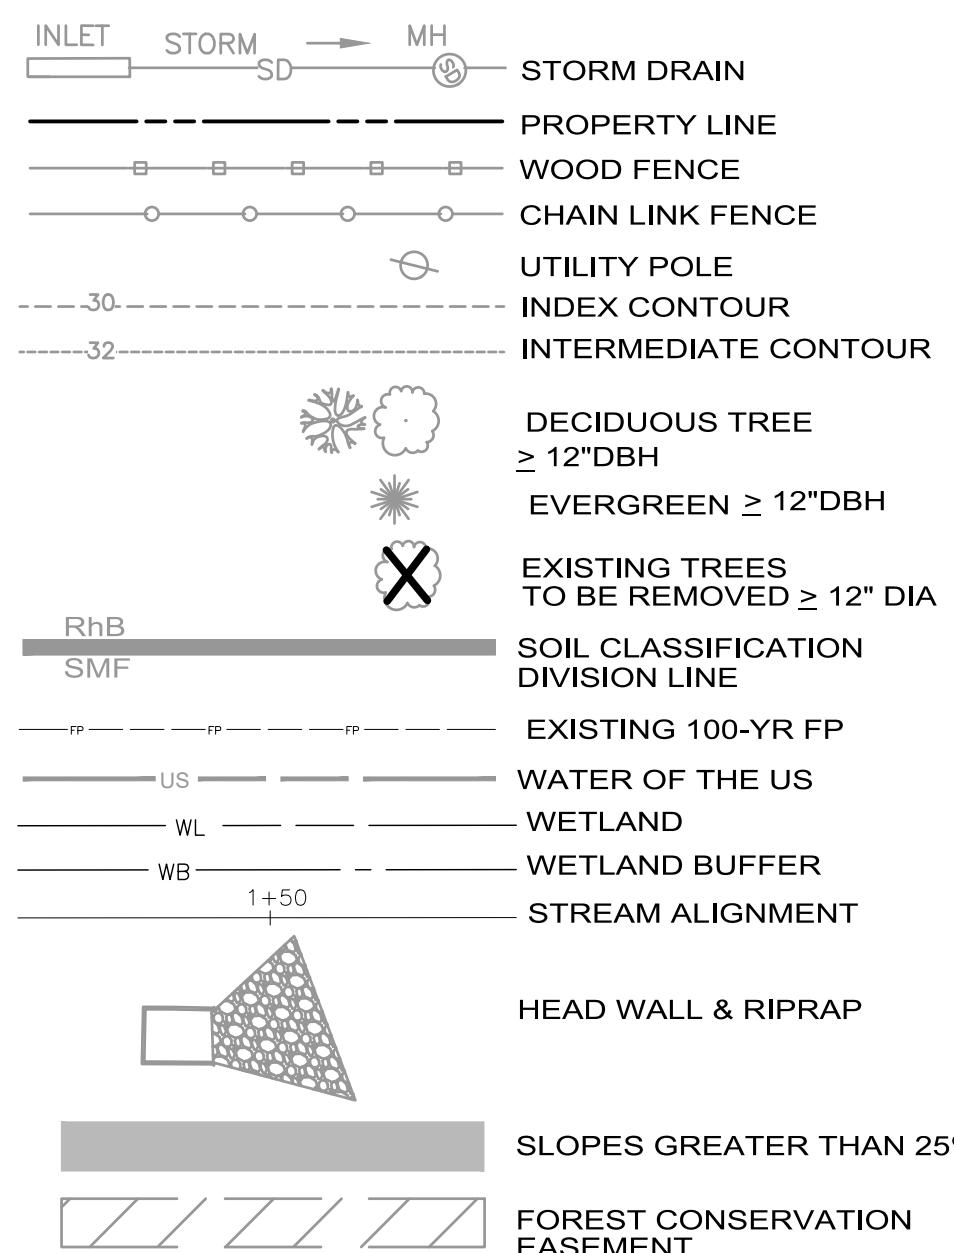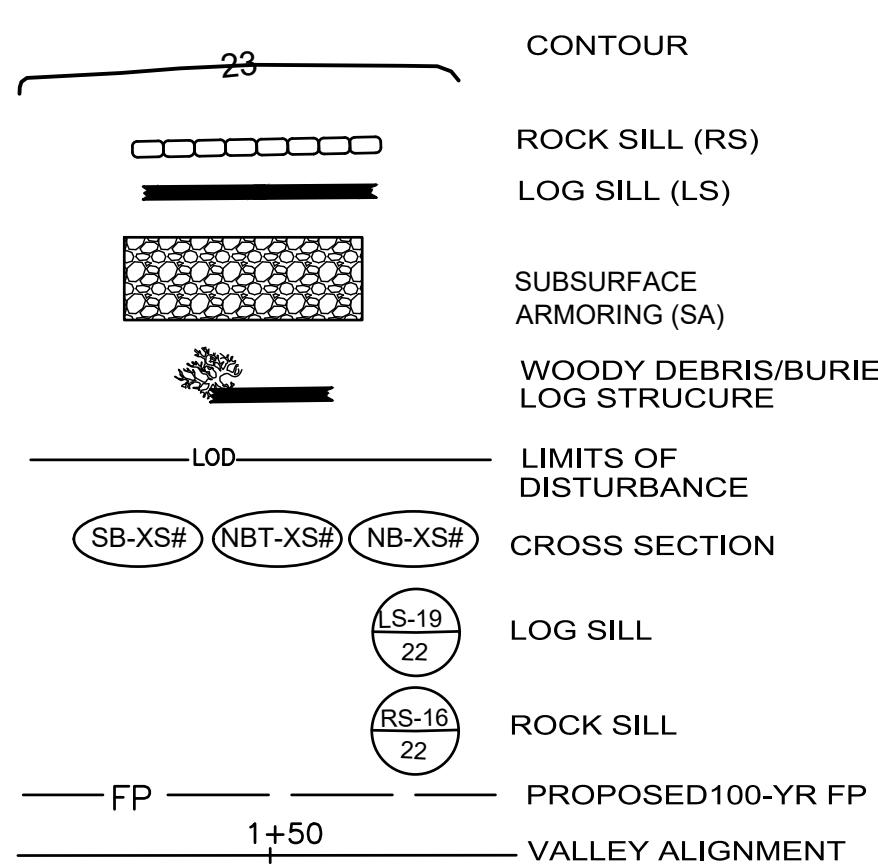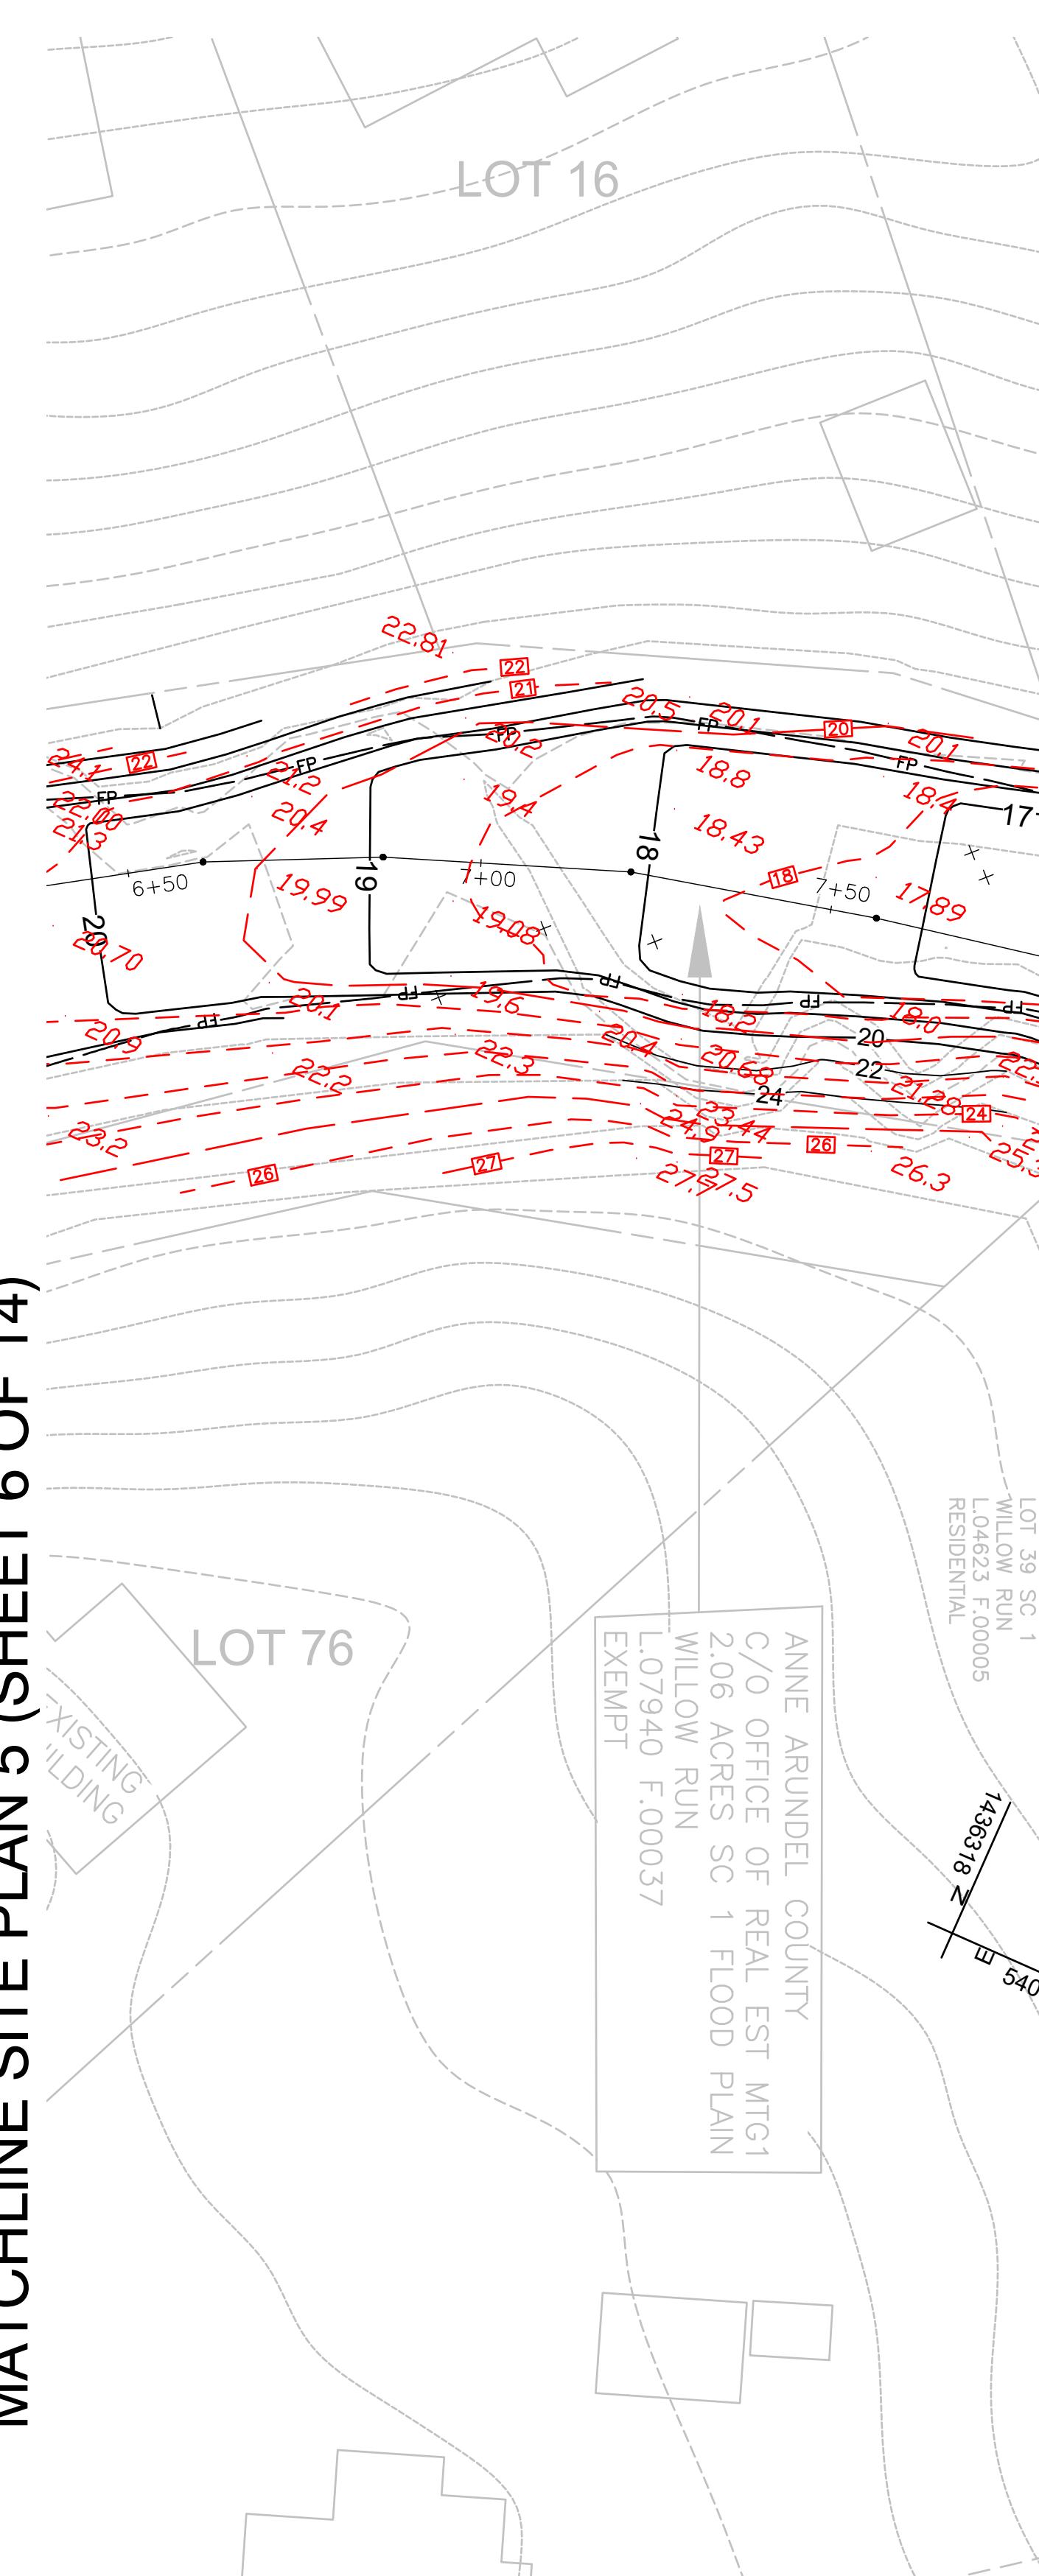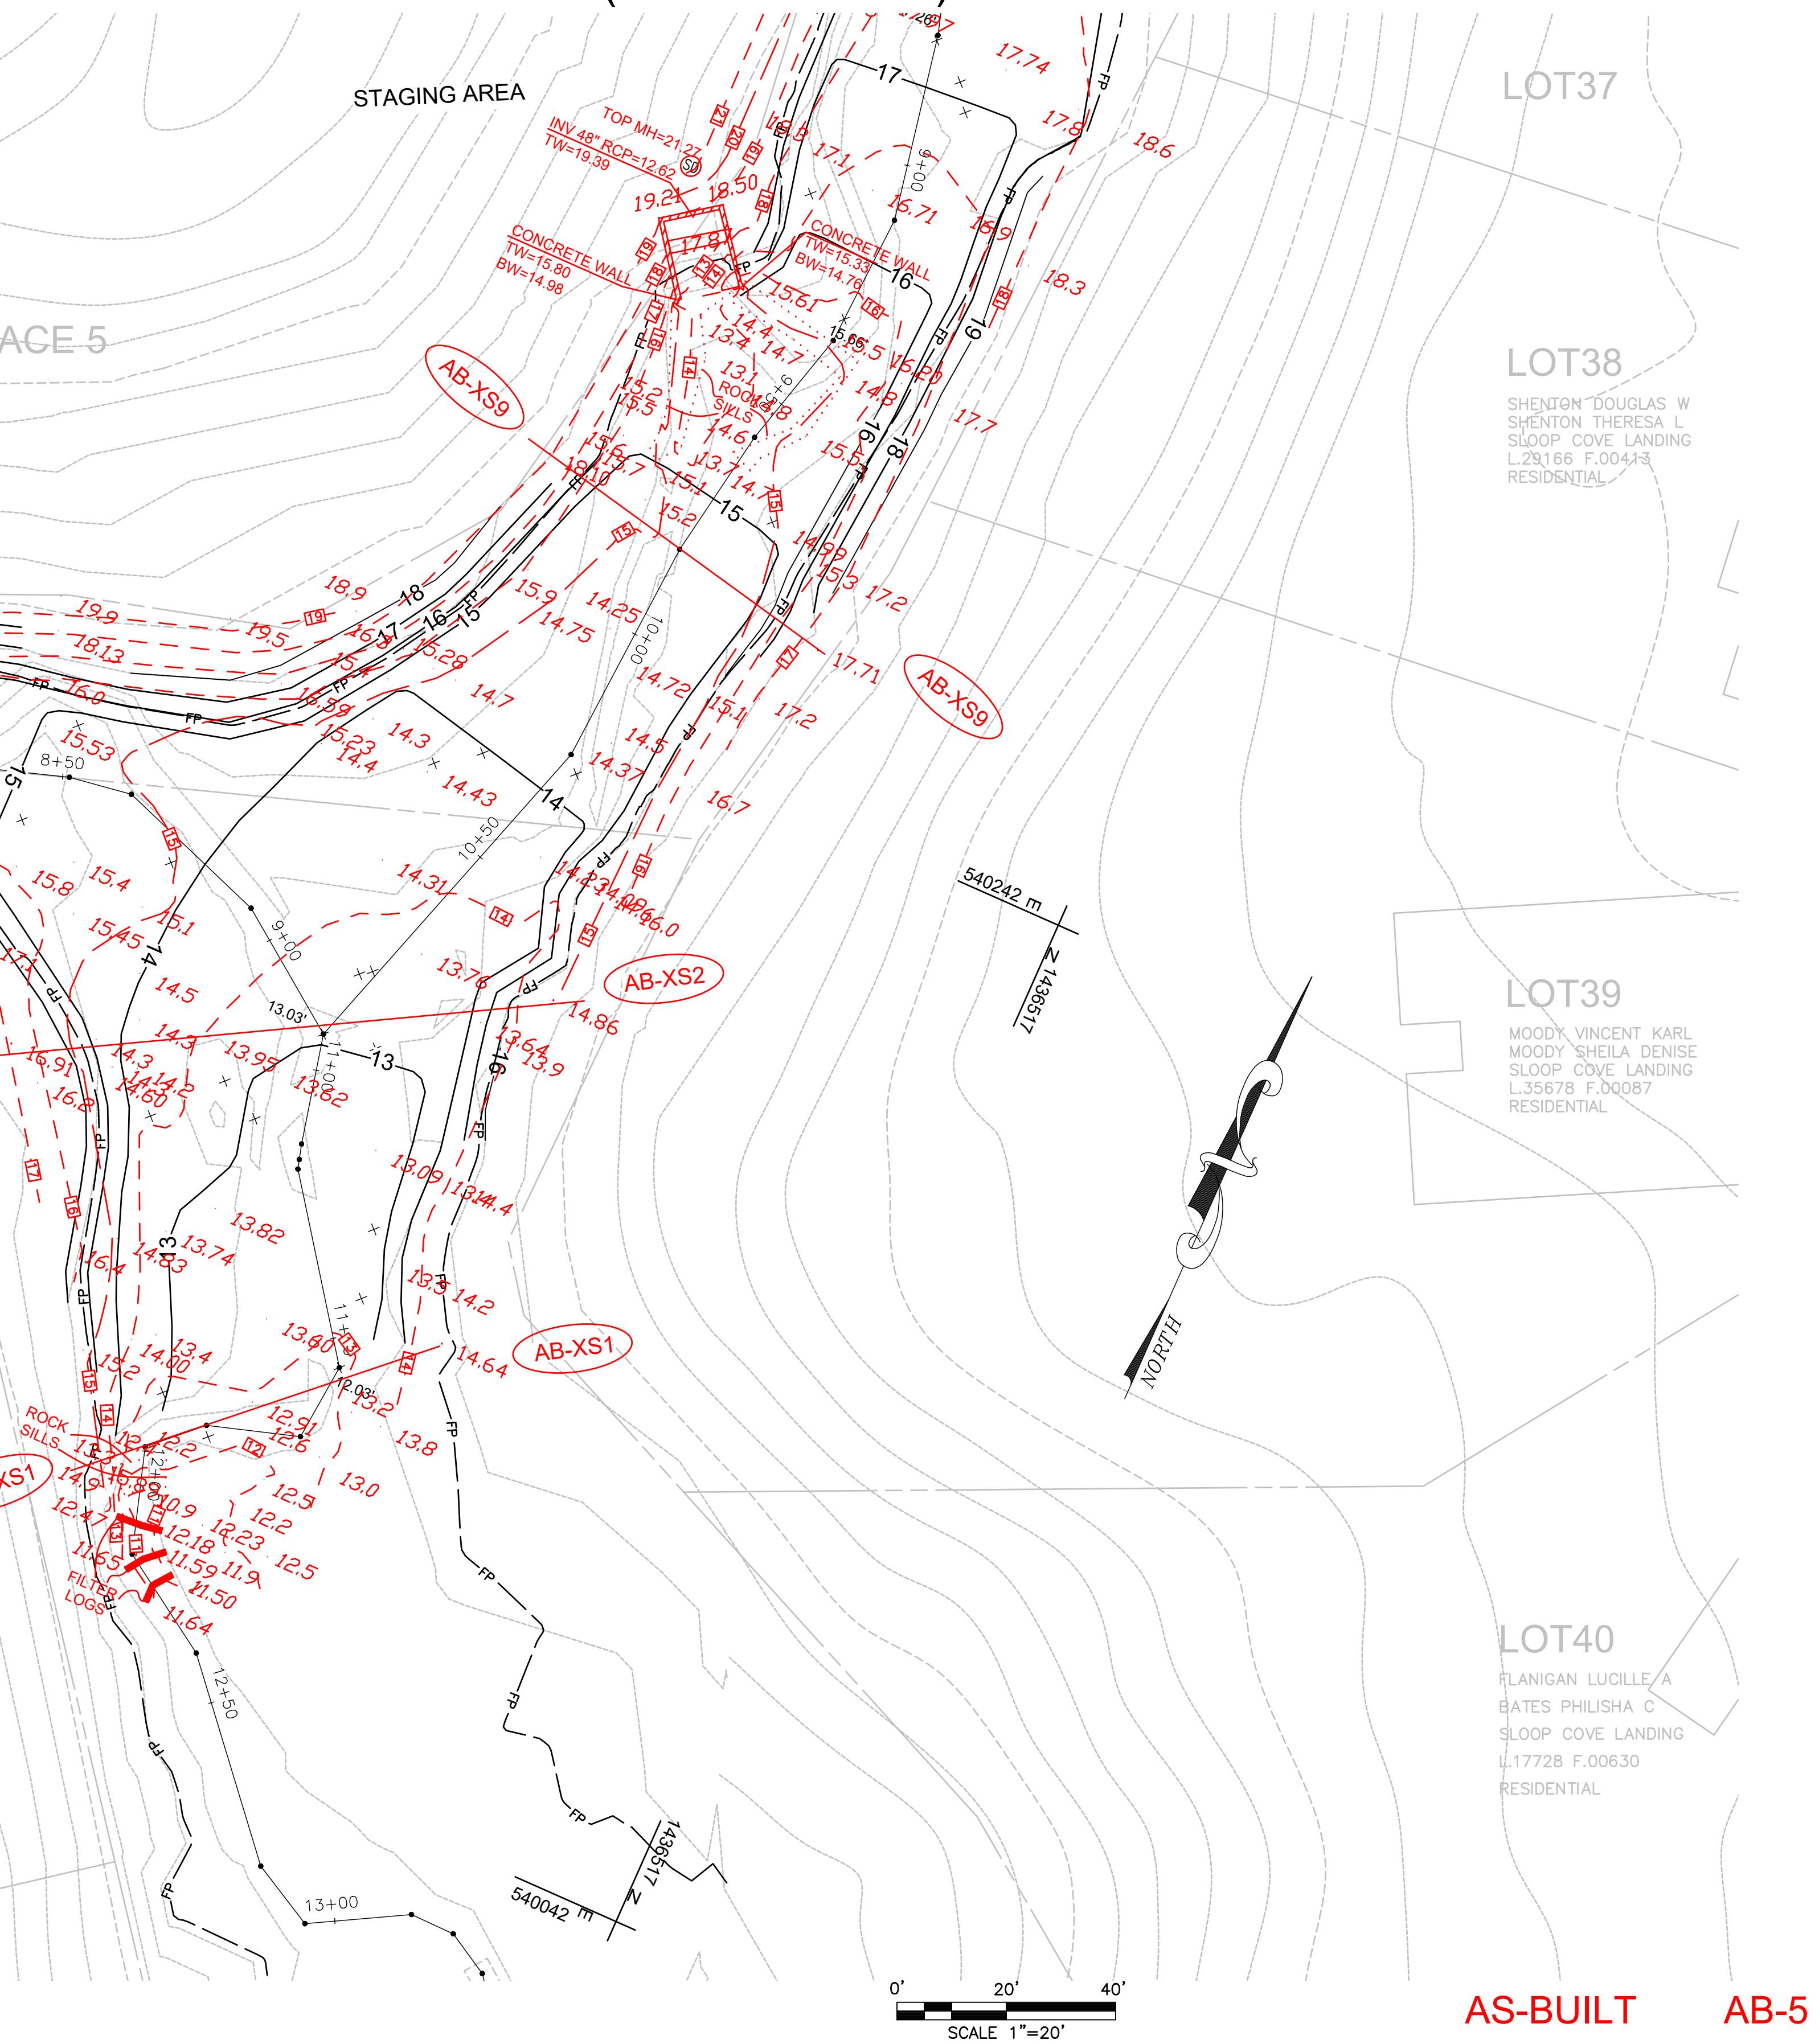EXISTING LEGEND

PROPOSED LEGEND

MATCHLINE SITE PLAN 5 SHEET 6 OF 14

MATCHLINE SITE PLAN 3 (SHEET 4 OF 14)


OWNER/DEVELOPER/APPLICANT
717-627-4440 fax: 717-627-4660 landstudies.com 315 North Street Lititz, PA 17543

CIVIL ENGINEER A.A. County ID #721
Dewberry 2101 Gaither Road Suite #340 Rockville, MD 20850 Contact: Joanne M. Cheok, Senior Associate Phone: (301) 337-2856 Fax: (301) 258-7607

Professional Certification: I hereby certify that these documents were prepared or approved by me, and that I am a duly licensed professional engineer under the laws of the State of Maryland.
License No.:
Expiration Date:

REVISIONS			
NO.	Description	BY	DATE
1	Revise 100-yr floodplain	LSI/ DEW	1/2021
2	ADDRESSED AA COUNTY COMMENTS	CG/ DEW	9/07/22
3	ADDRESSED AA COUNTY COMMENTS	LSI/ DEW	11/01/22
4	ADDRESSED AA COUNTY COMMENTS	LSI/ DEW	01/10/23

ANNE ARUNDEL COUNTY					
DEPARTMENT OF PUBLIC WORKS					
STREAM RESTORATION PLAN					
APPROVED	DATE	APPROVED	DATE	SCALE:	As Shown
CHIEF ENGINEER		PROJECT MANAGER		DRAWN BY:	Buf/R. Anchors
APPROVED	DATE	APPROVED	DATE	CHECKED BY:	J. Cheok
ASSISTANT CHIEF ENGINEER		CHIEF, RIGHT OF WAY		SHEET NO.:	51 OF 39
				PROJECT NO.:	50017963
				PROPOSAL NO.:	

**RESTORATION SITE PLAN 4
SLOOP COVE RETROFIT SITE 1**


Tax Map 16 Grid 05

Anne Arundel County


14

MATCHLINE SITE PLAN 4 (SHEET 5 OF 14)


EXISTING LEGEND

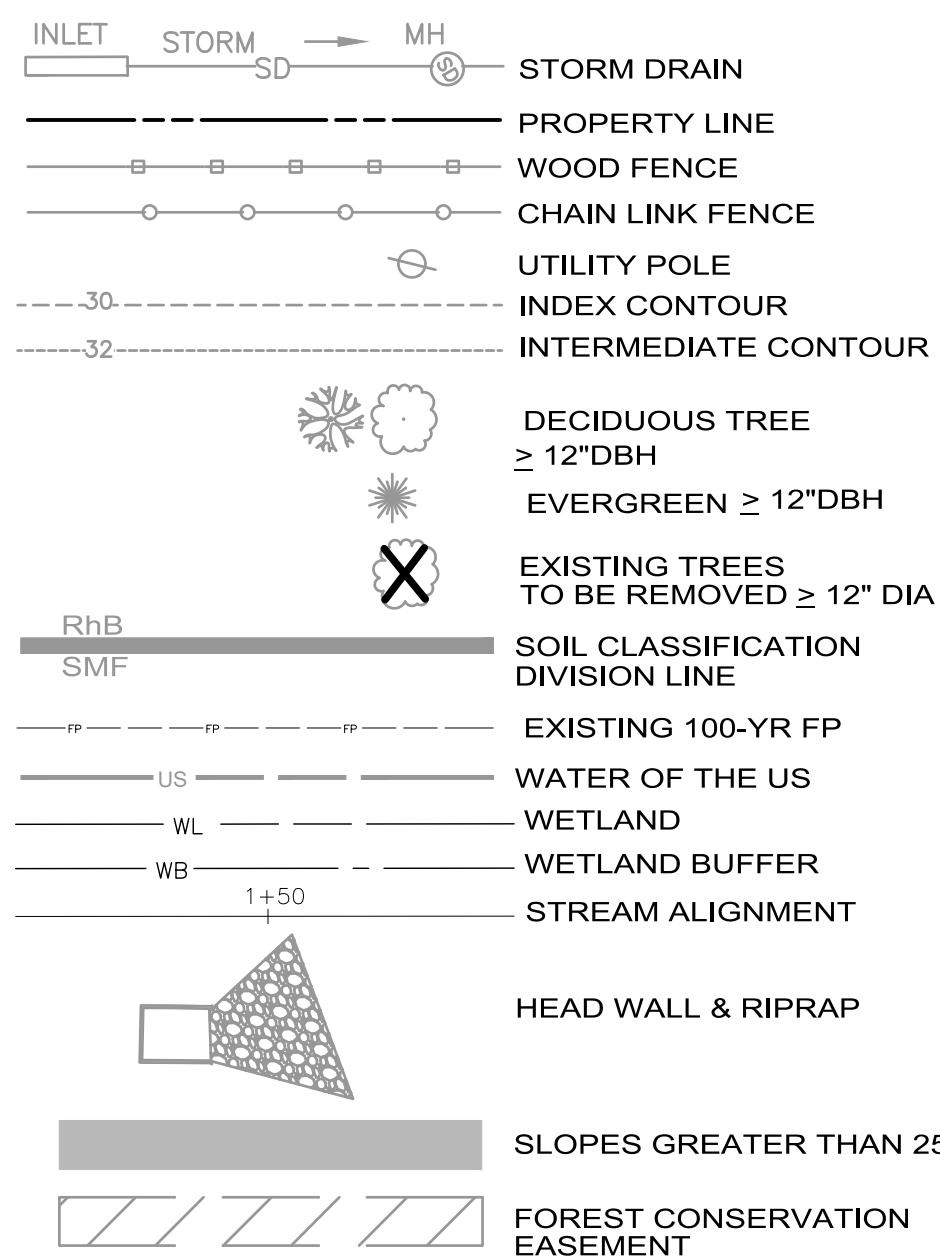

PROPOSED LEGEND

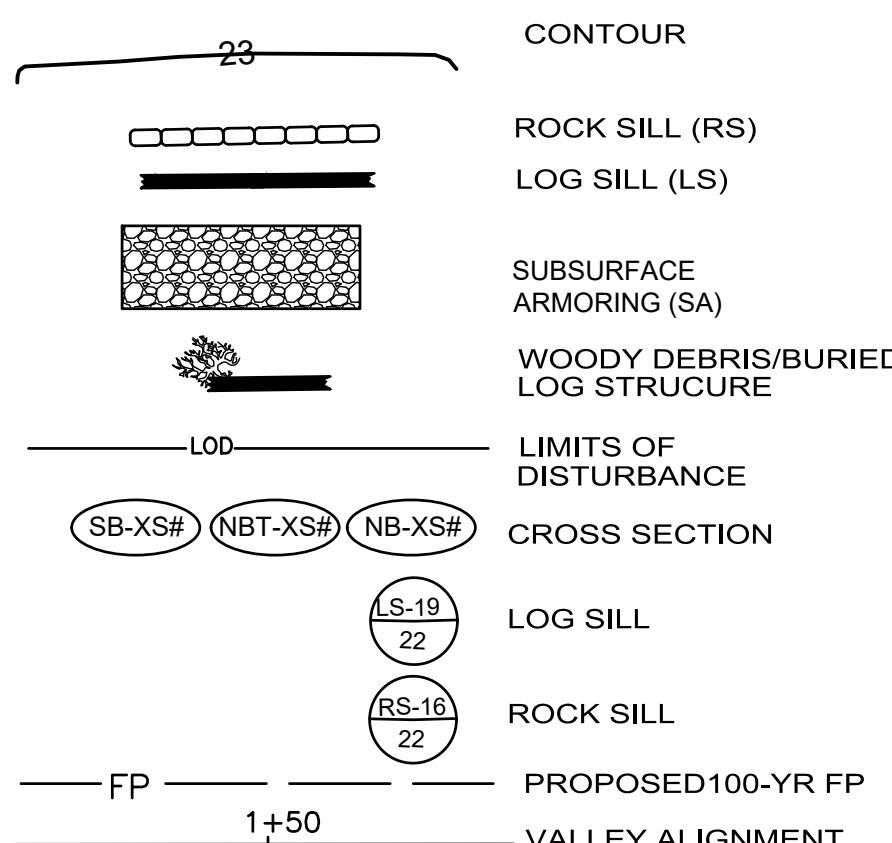

HIGH OAK ROAD

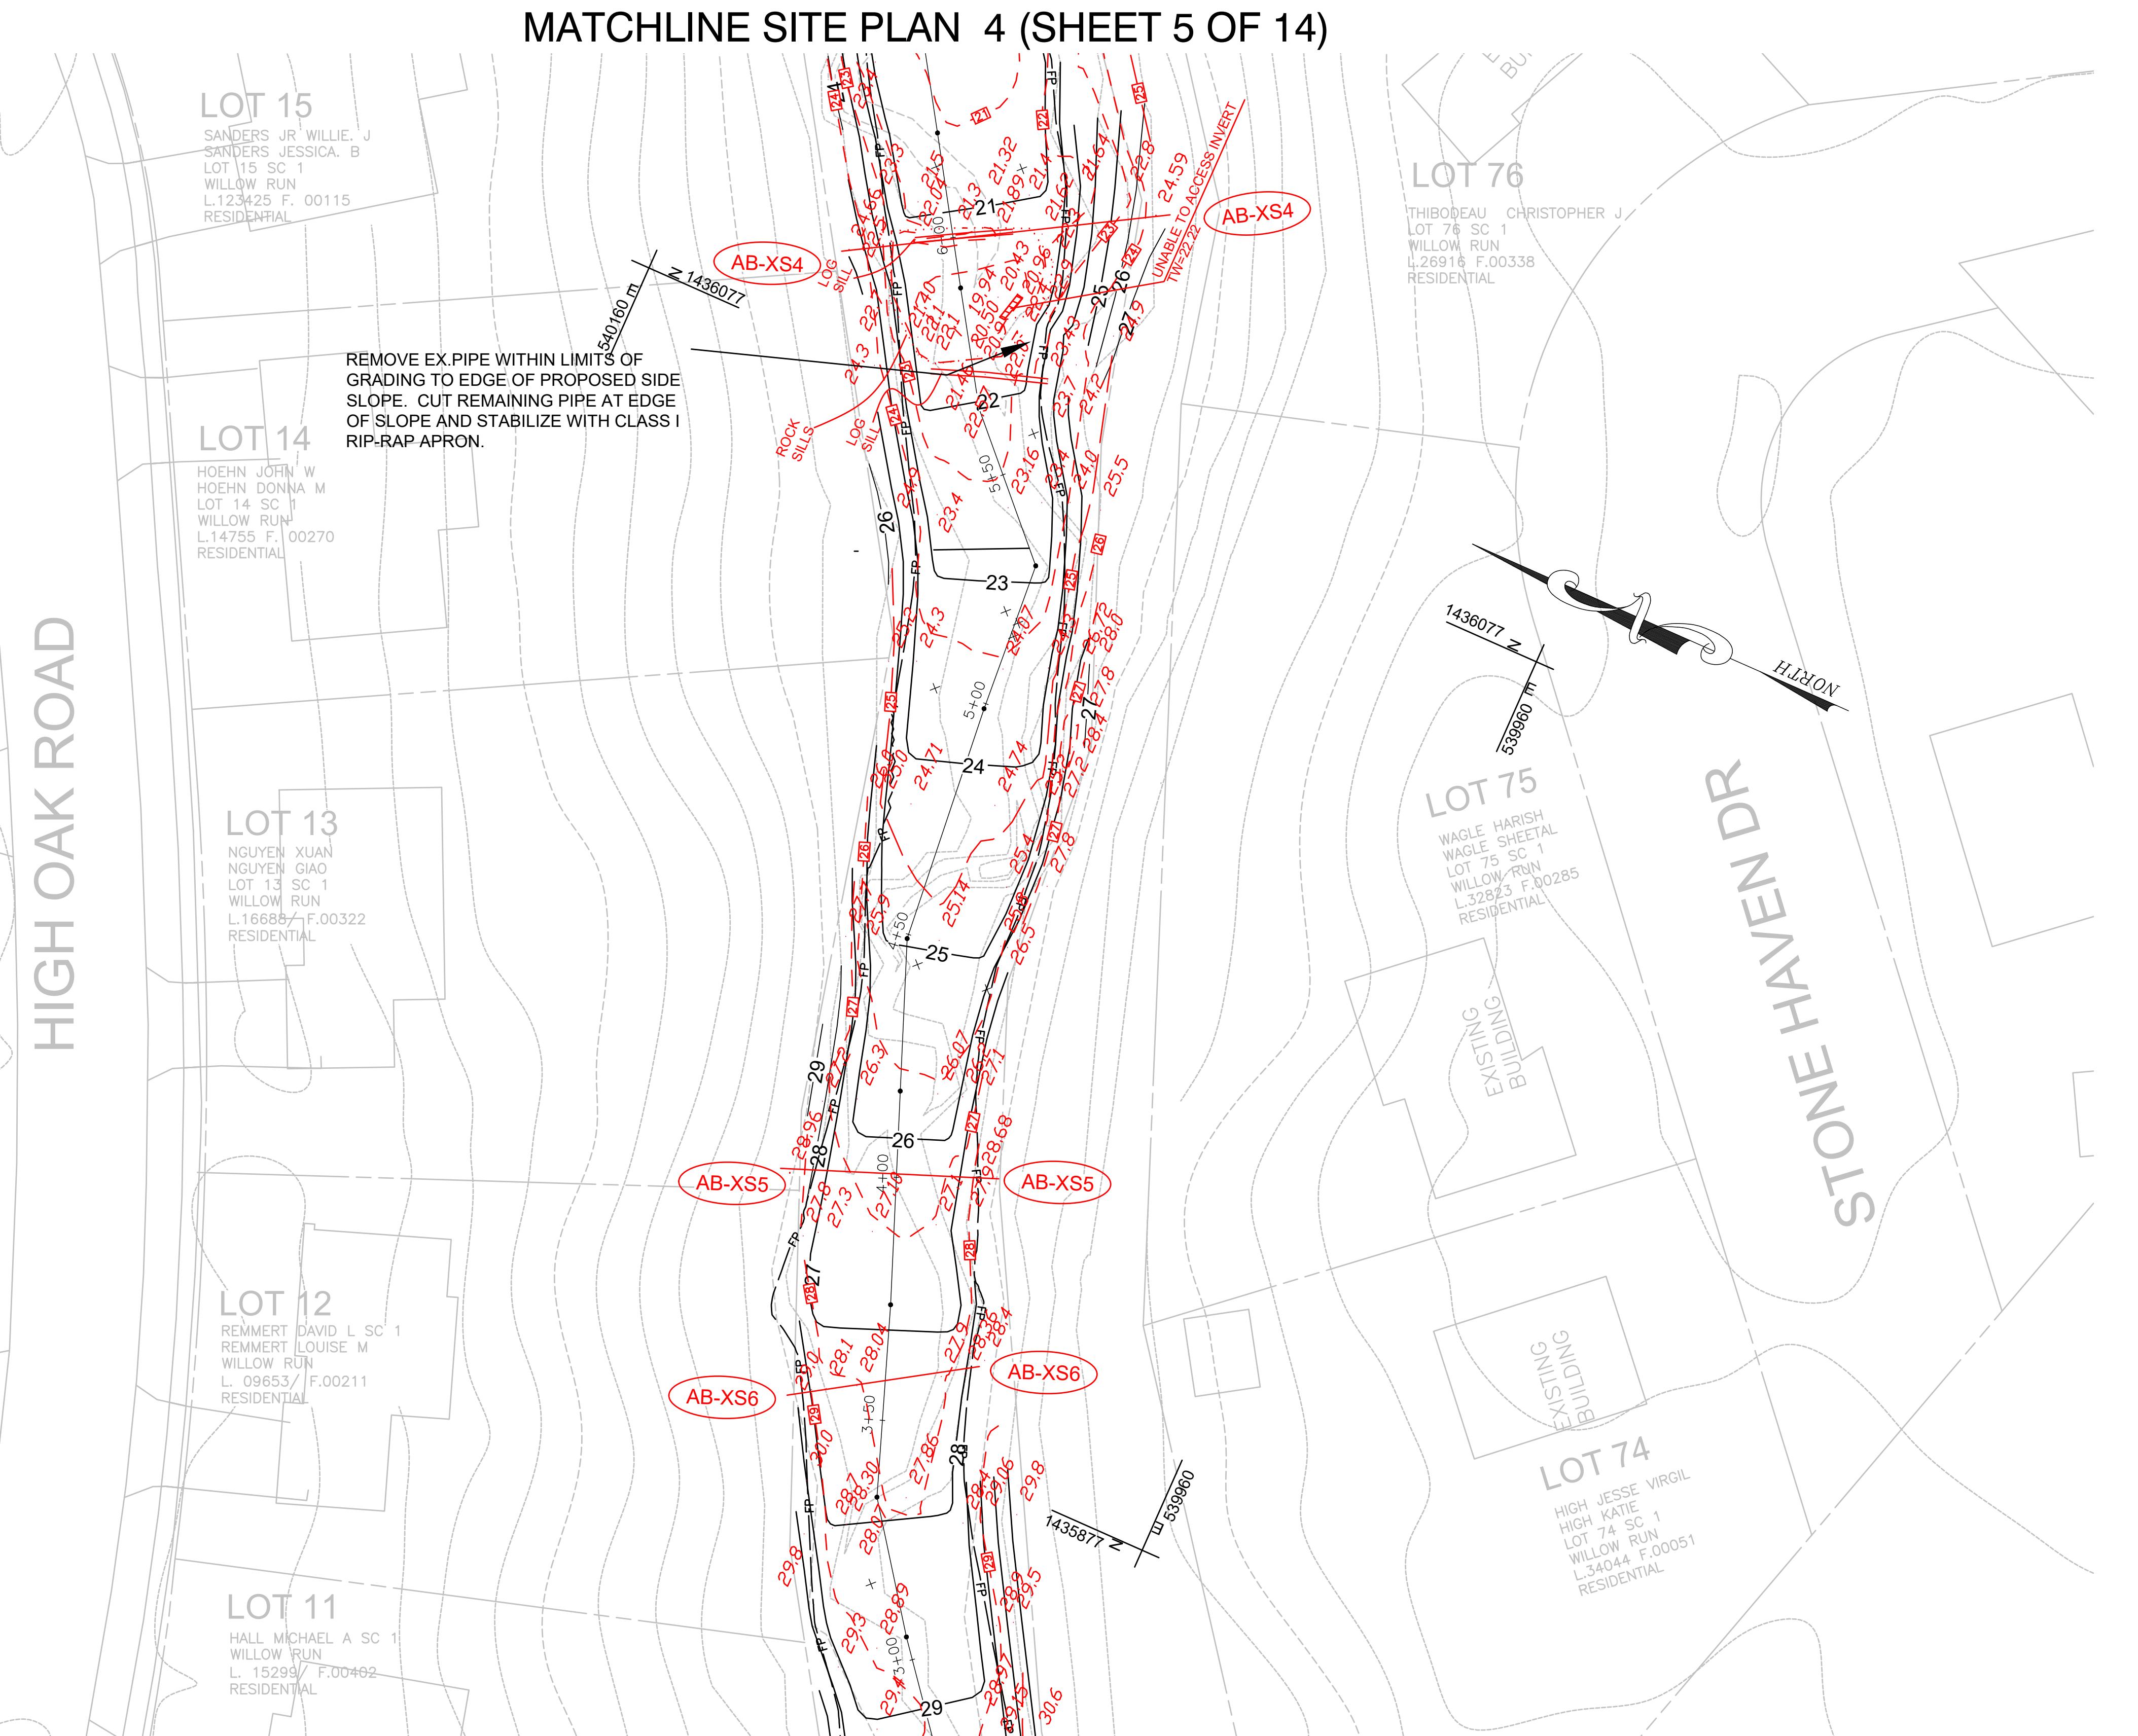


MATCHLINE SITE PLAN 6 (SHEET 7 OF 14)

0' 20' 40'
SCALE 1"=20'

AS-BUILT AB-6

OWNER/DEVELOPER/APPLICANT	CIVIL ENGINEER A.A. County ID #721
717-627-4440 fax: 717-627-4660 landstudies.com 315 North Street Lititz, PA 17543	Dewberry 2101 Gaither Road Suite #340 Rockville, MD 20850 Contact: Joanne M. Cheok, Senior Associate Phone: (301) 337-2856 Fax: (301) 258-7607

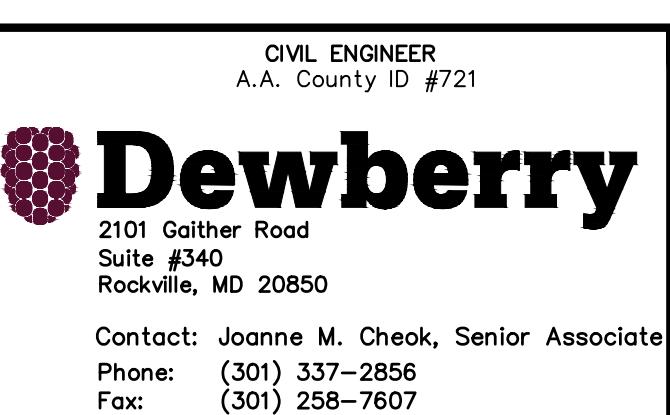

Professional Certification: I hereby certify that these documents were prepared or approved by me, and that I am a duly licensed professional engineer under the laws of the State of Maryland.
License No.:
Expiration Date:

REVISIONS			
NO	Description	BY	DATE
1	Revise 100-yr floodplain	LSI/ DEW	1/2021
2	ADDRESSED AA COUNTY COMMENTS	CG/ DEW	9/07/22
3	ADDRESSED AA COUNTY COMMENTS	LSI/ DEW	11/01/22
4	ADDRESSED AA COUNTY COMMENTS	LSI/ DEW	01/10/23

ANNE ARUNDEL COUNTY			
DEPARTMENT OF PUBLIC WORKS			
APPROVED	DATE	APPROVED	DATE
CHIEF ENGINEER		PROJECT MANAGER	
APPROVED	DATE	APPROVED	DATE
ASSISTANT CHIEF ENGINEER		CHIEF, RIGHT OF WAY	
DRAWN BY: Buf/R. Anchors CHECKED BY: J. Cheok SHEET NO: 6 / 39 PROJECT NO: 50017963 PROPOSAL NO:			


14
3rd District

RESTORATION SITE PLAN 5
SLOOP COVE RETROFIT SITE 1
Tax Map 16 Grid 05



Anne Arundel County

MATCHLINE SITE PLAN 5 (SHEET 6 OF 14)

EXISTING LEGEND

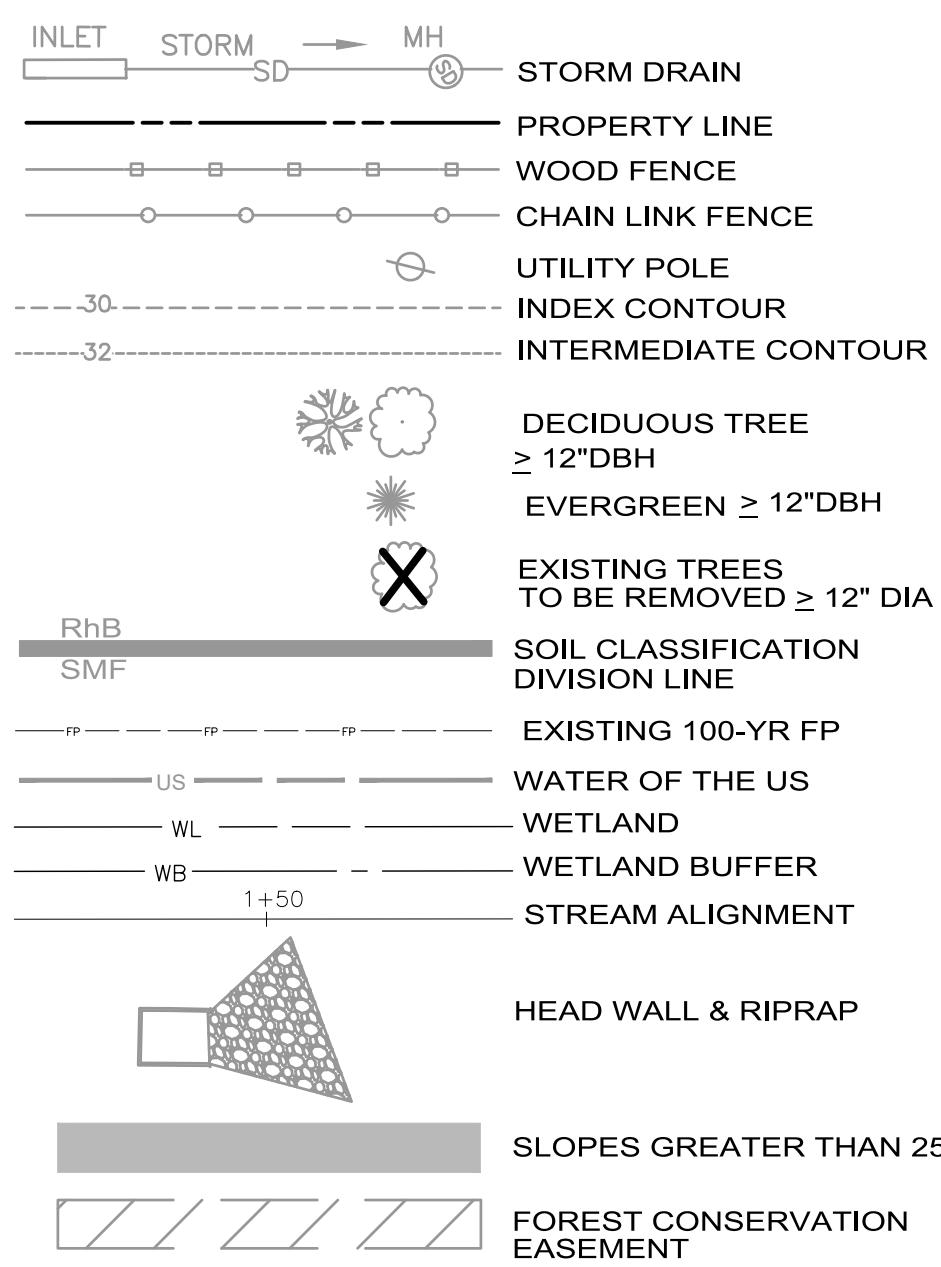


PROPOSED LEGEND

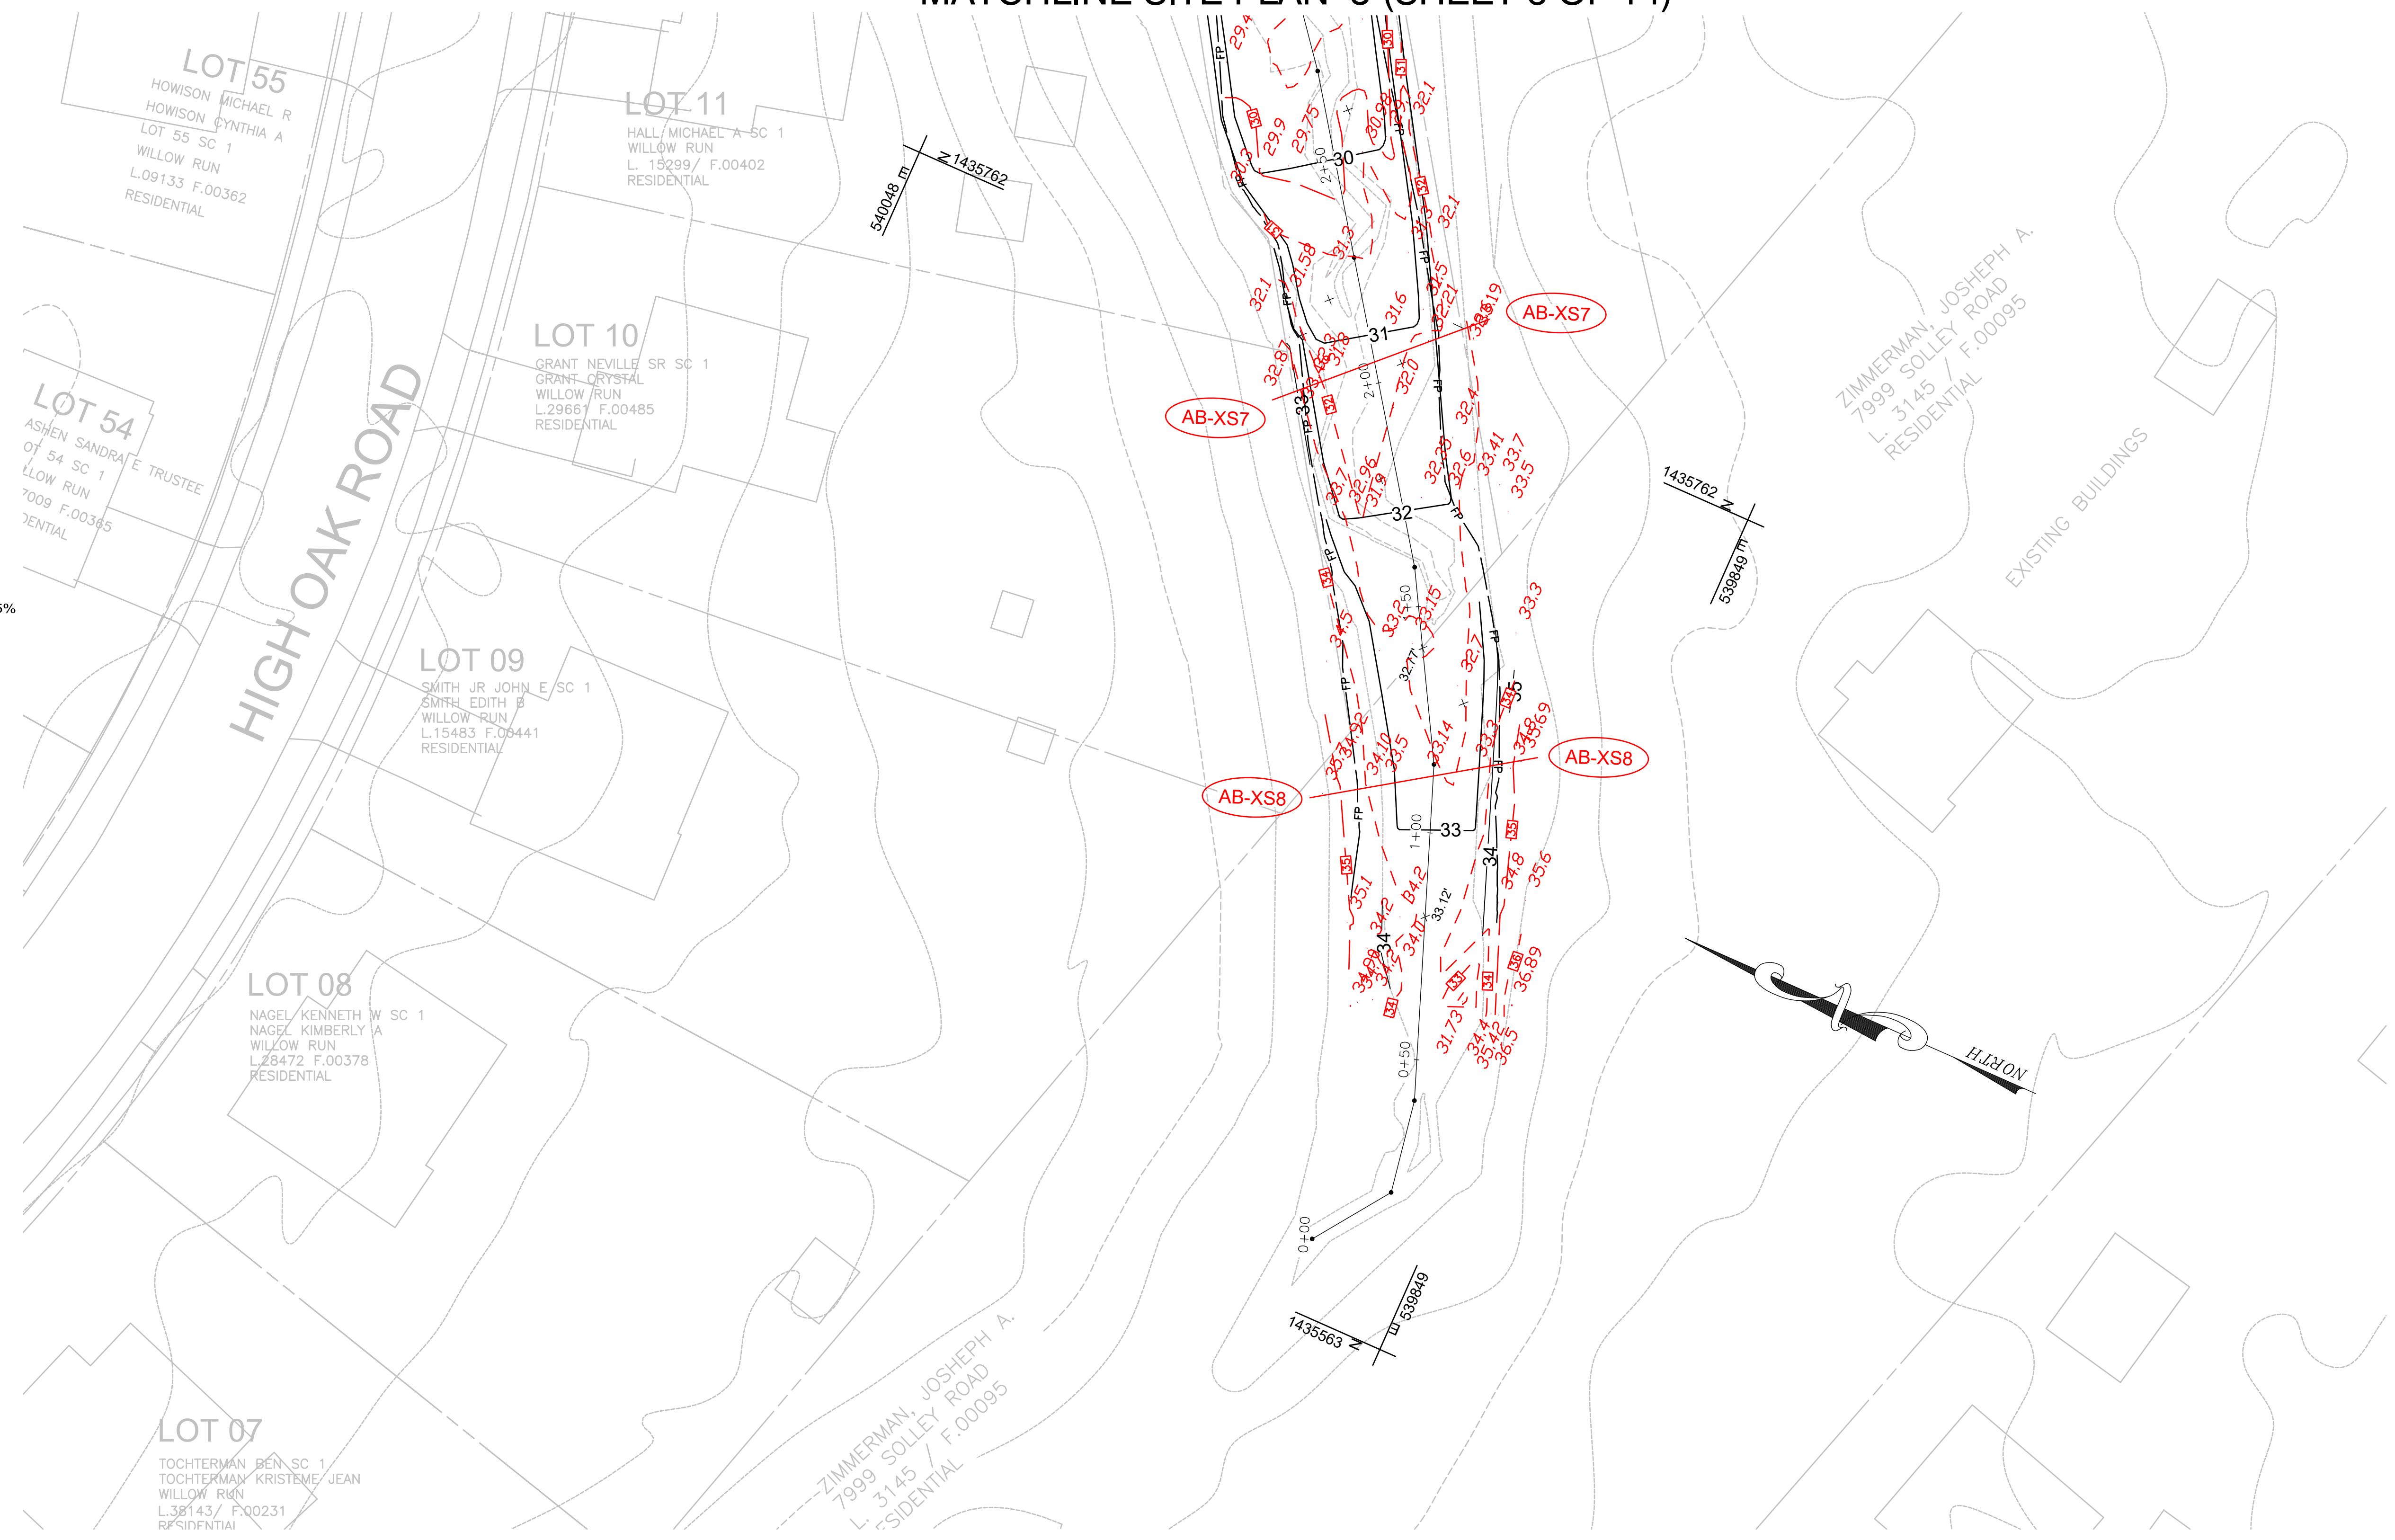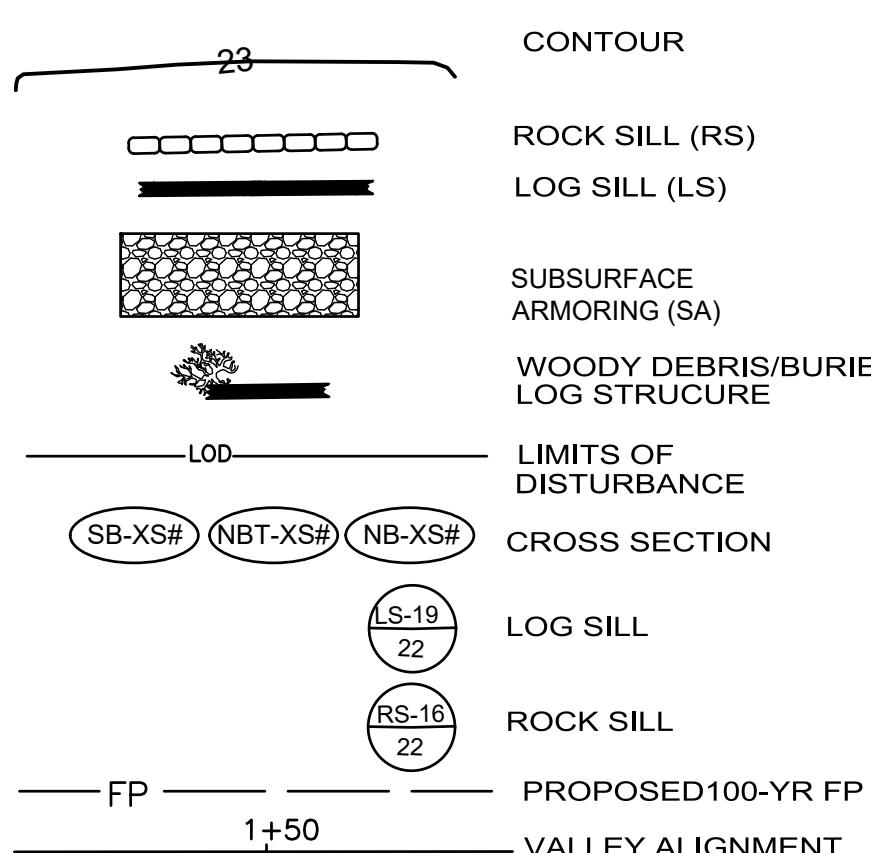

0' 20' 40'
SCALE 1"=20'

AS-BUILT AB-7

OWNER/DEVELOPER/APPLICANT	CIVIL ENGINEER	
717-627-4440 fax: 717-627-4660 landstudies.com 315 North Street Lititz, PA 17543	A.A. County ID #721	

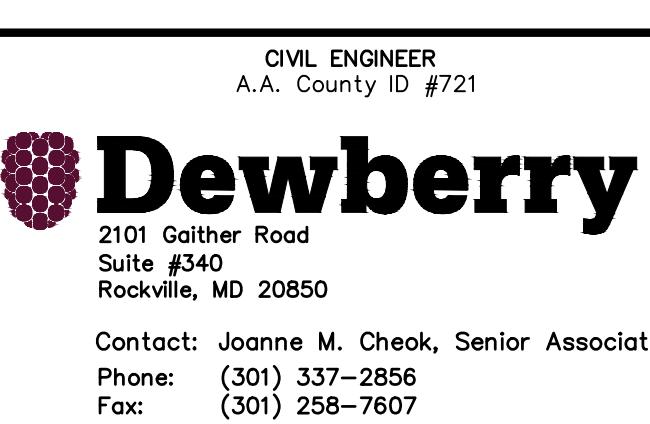

Professional Certification: I hereby certify that these documents were prepared or approved by me, and that I am a duly licensed professional engineer under the laws of the State of Maryland.
License No.:
Expiration Date:

REVISIONS			
NO.	Description	BY	DATE
1	Revise 100-yr floodplain	LSI/ DEW	1/2021
2	ADDRESSED AA COUNTY COMMENTS	CG/ DEW	9/07/22
3	ADDRESSED AA COUNTY COMMENTS	LSI/ DEW	11/01/22
4	ADDRESSED AA COUNTY COMMENTS	LSI/ DEW	01/10/23



ANNE ARUNDEL COUNTY			
DEPARTMENT OF PUBLIC WORKS			
STREAM RESTORATION PLAN			
APPROVED	DATE	APPROVED	DATE
CHIEF ENGINEER		PROJECT MANAGER	
APPROVED	DATE	APPROVED	DATE
ASSISTANT CHIEF ENGINEER		CHIEF, RIGHT OF WAY	
		PROPOSAL NO:	

14

3rd District

RESTORATION SITE PLAN 6
SLOOP COVE RETROFIT SITE 1
Tax Map 16 Grid 05

Anne Arundel County


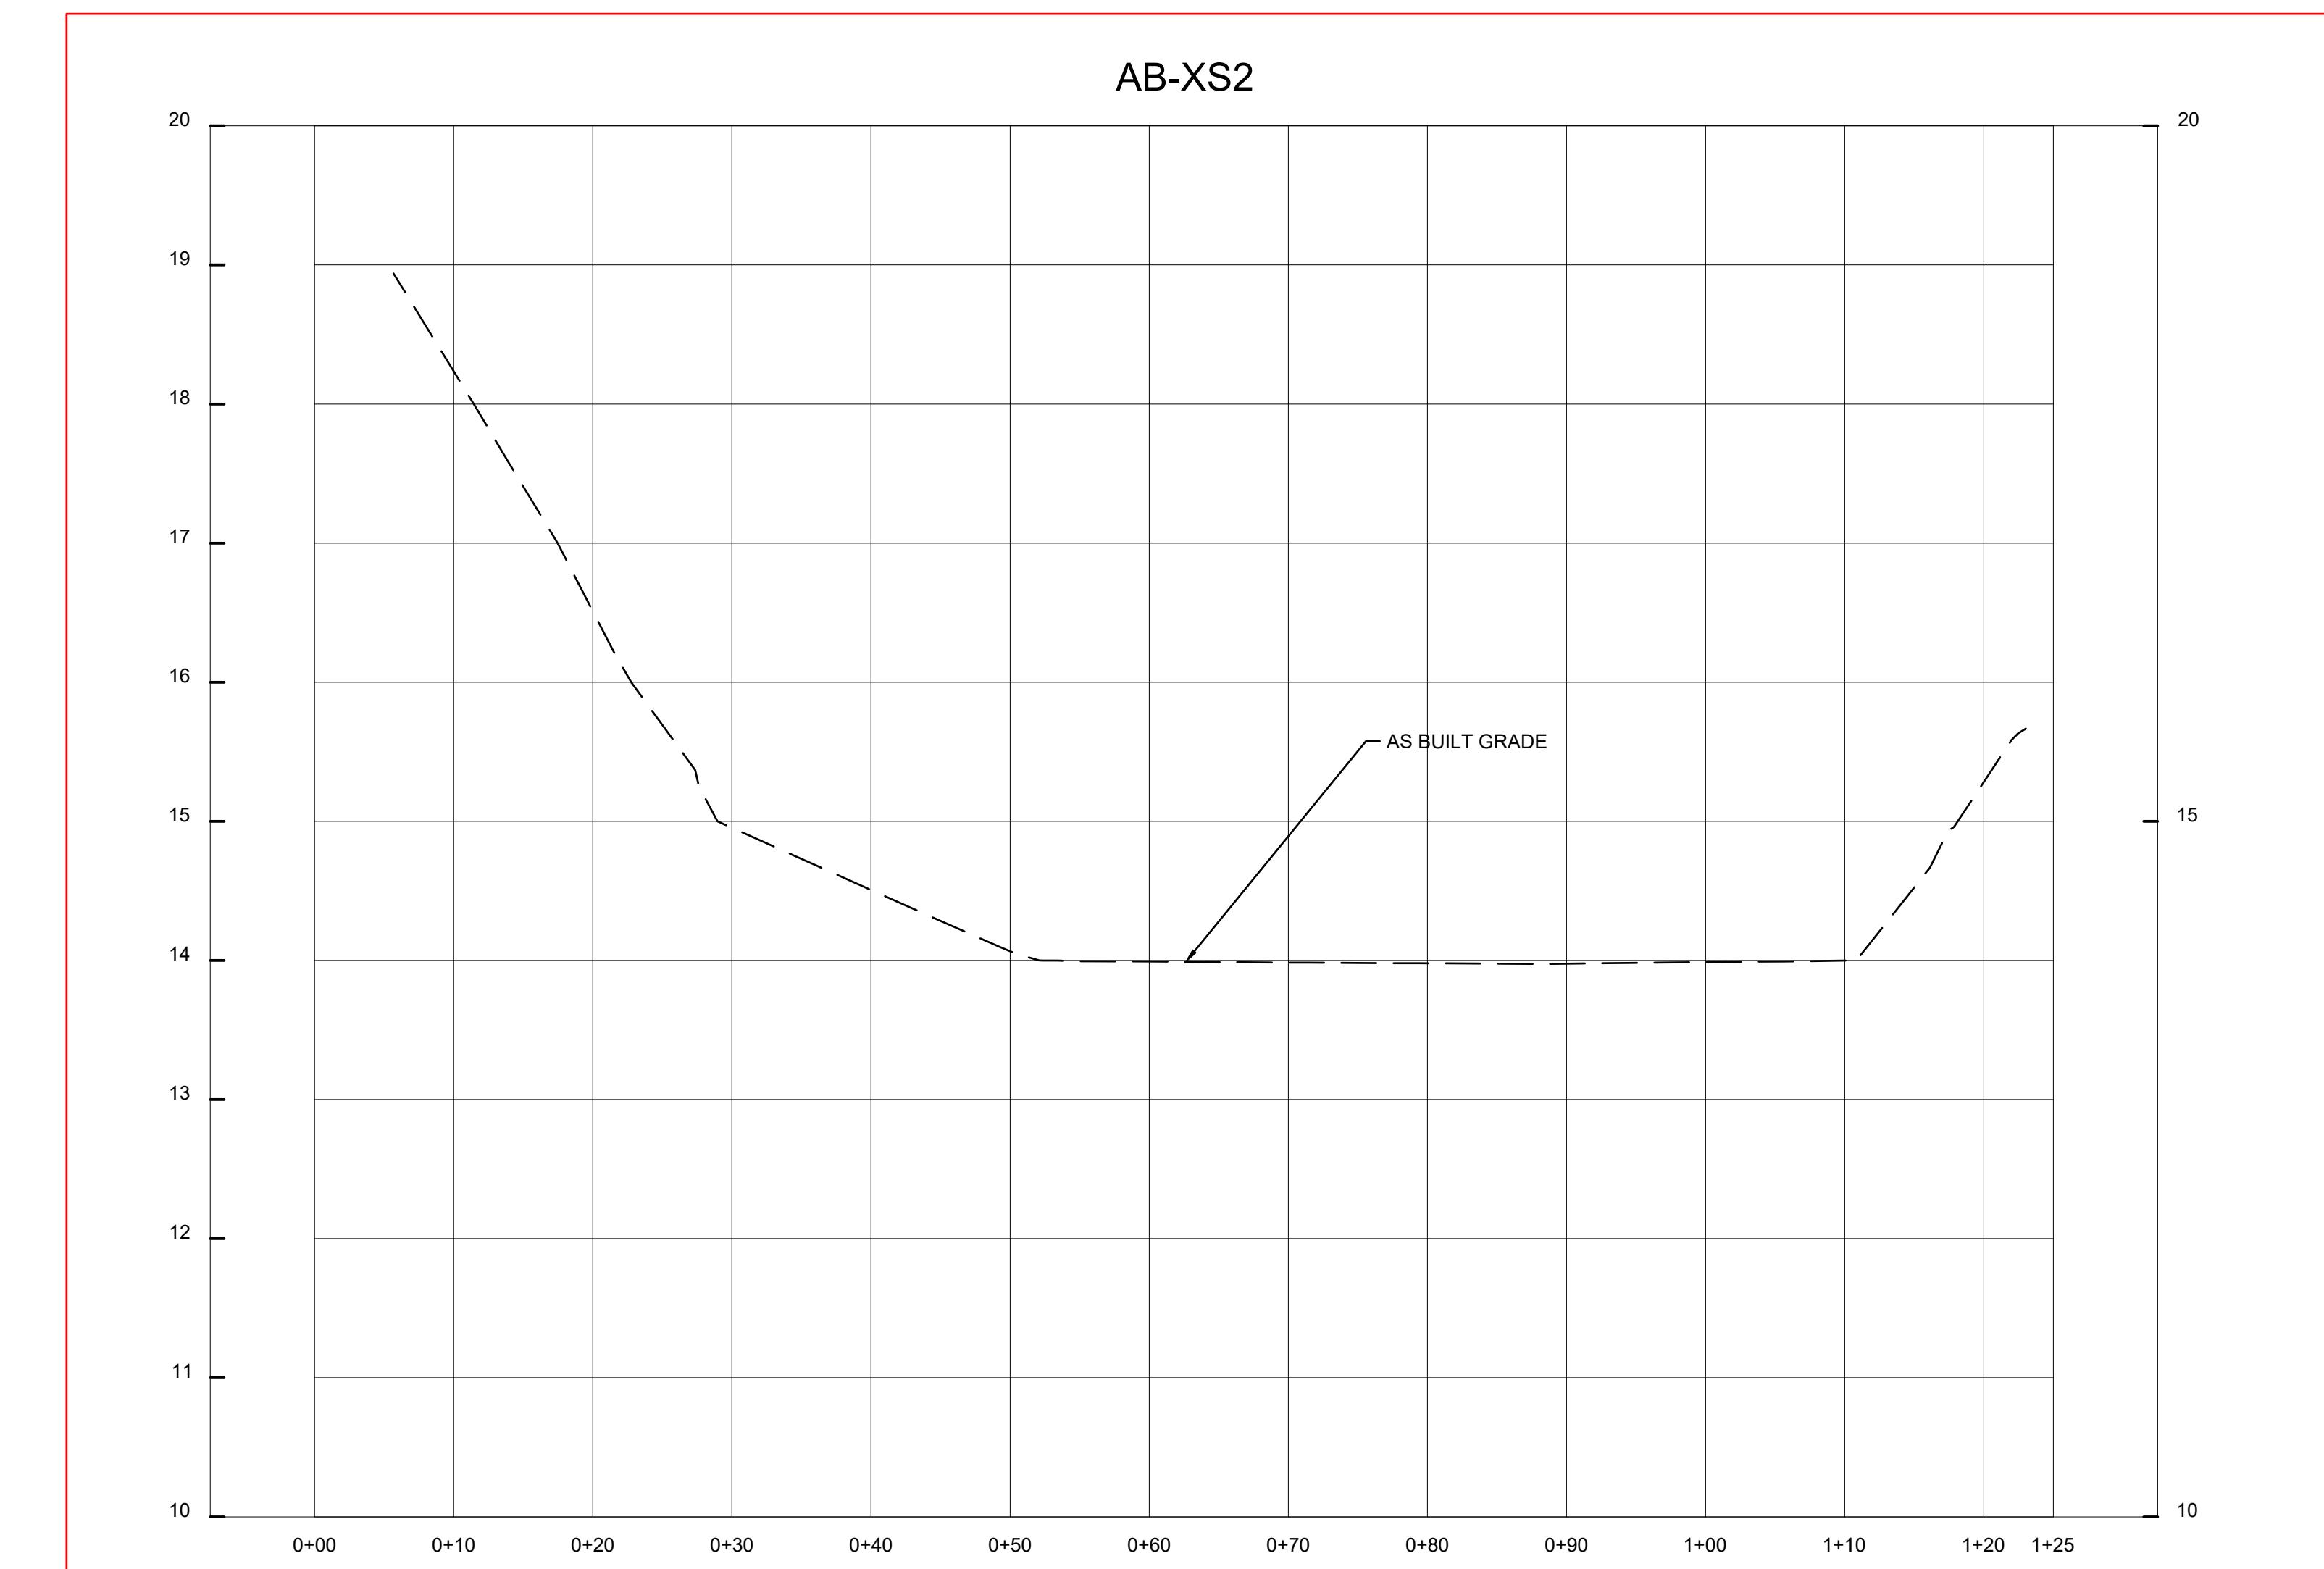
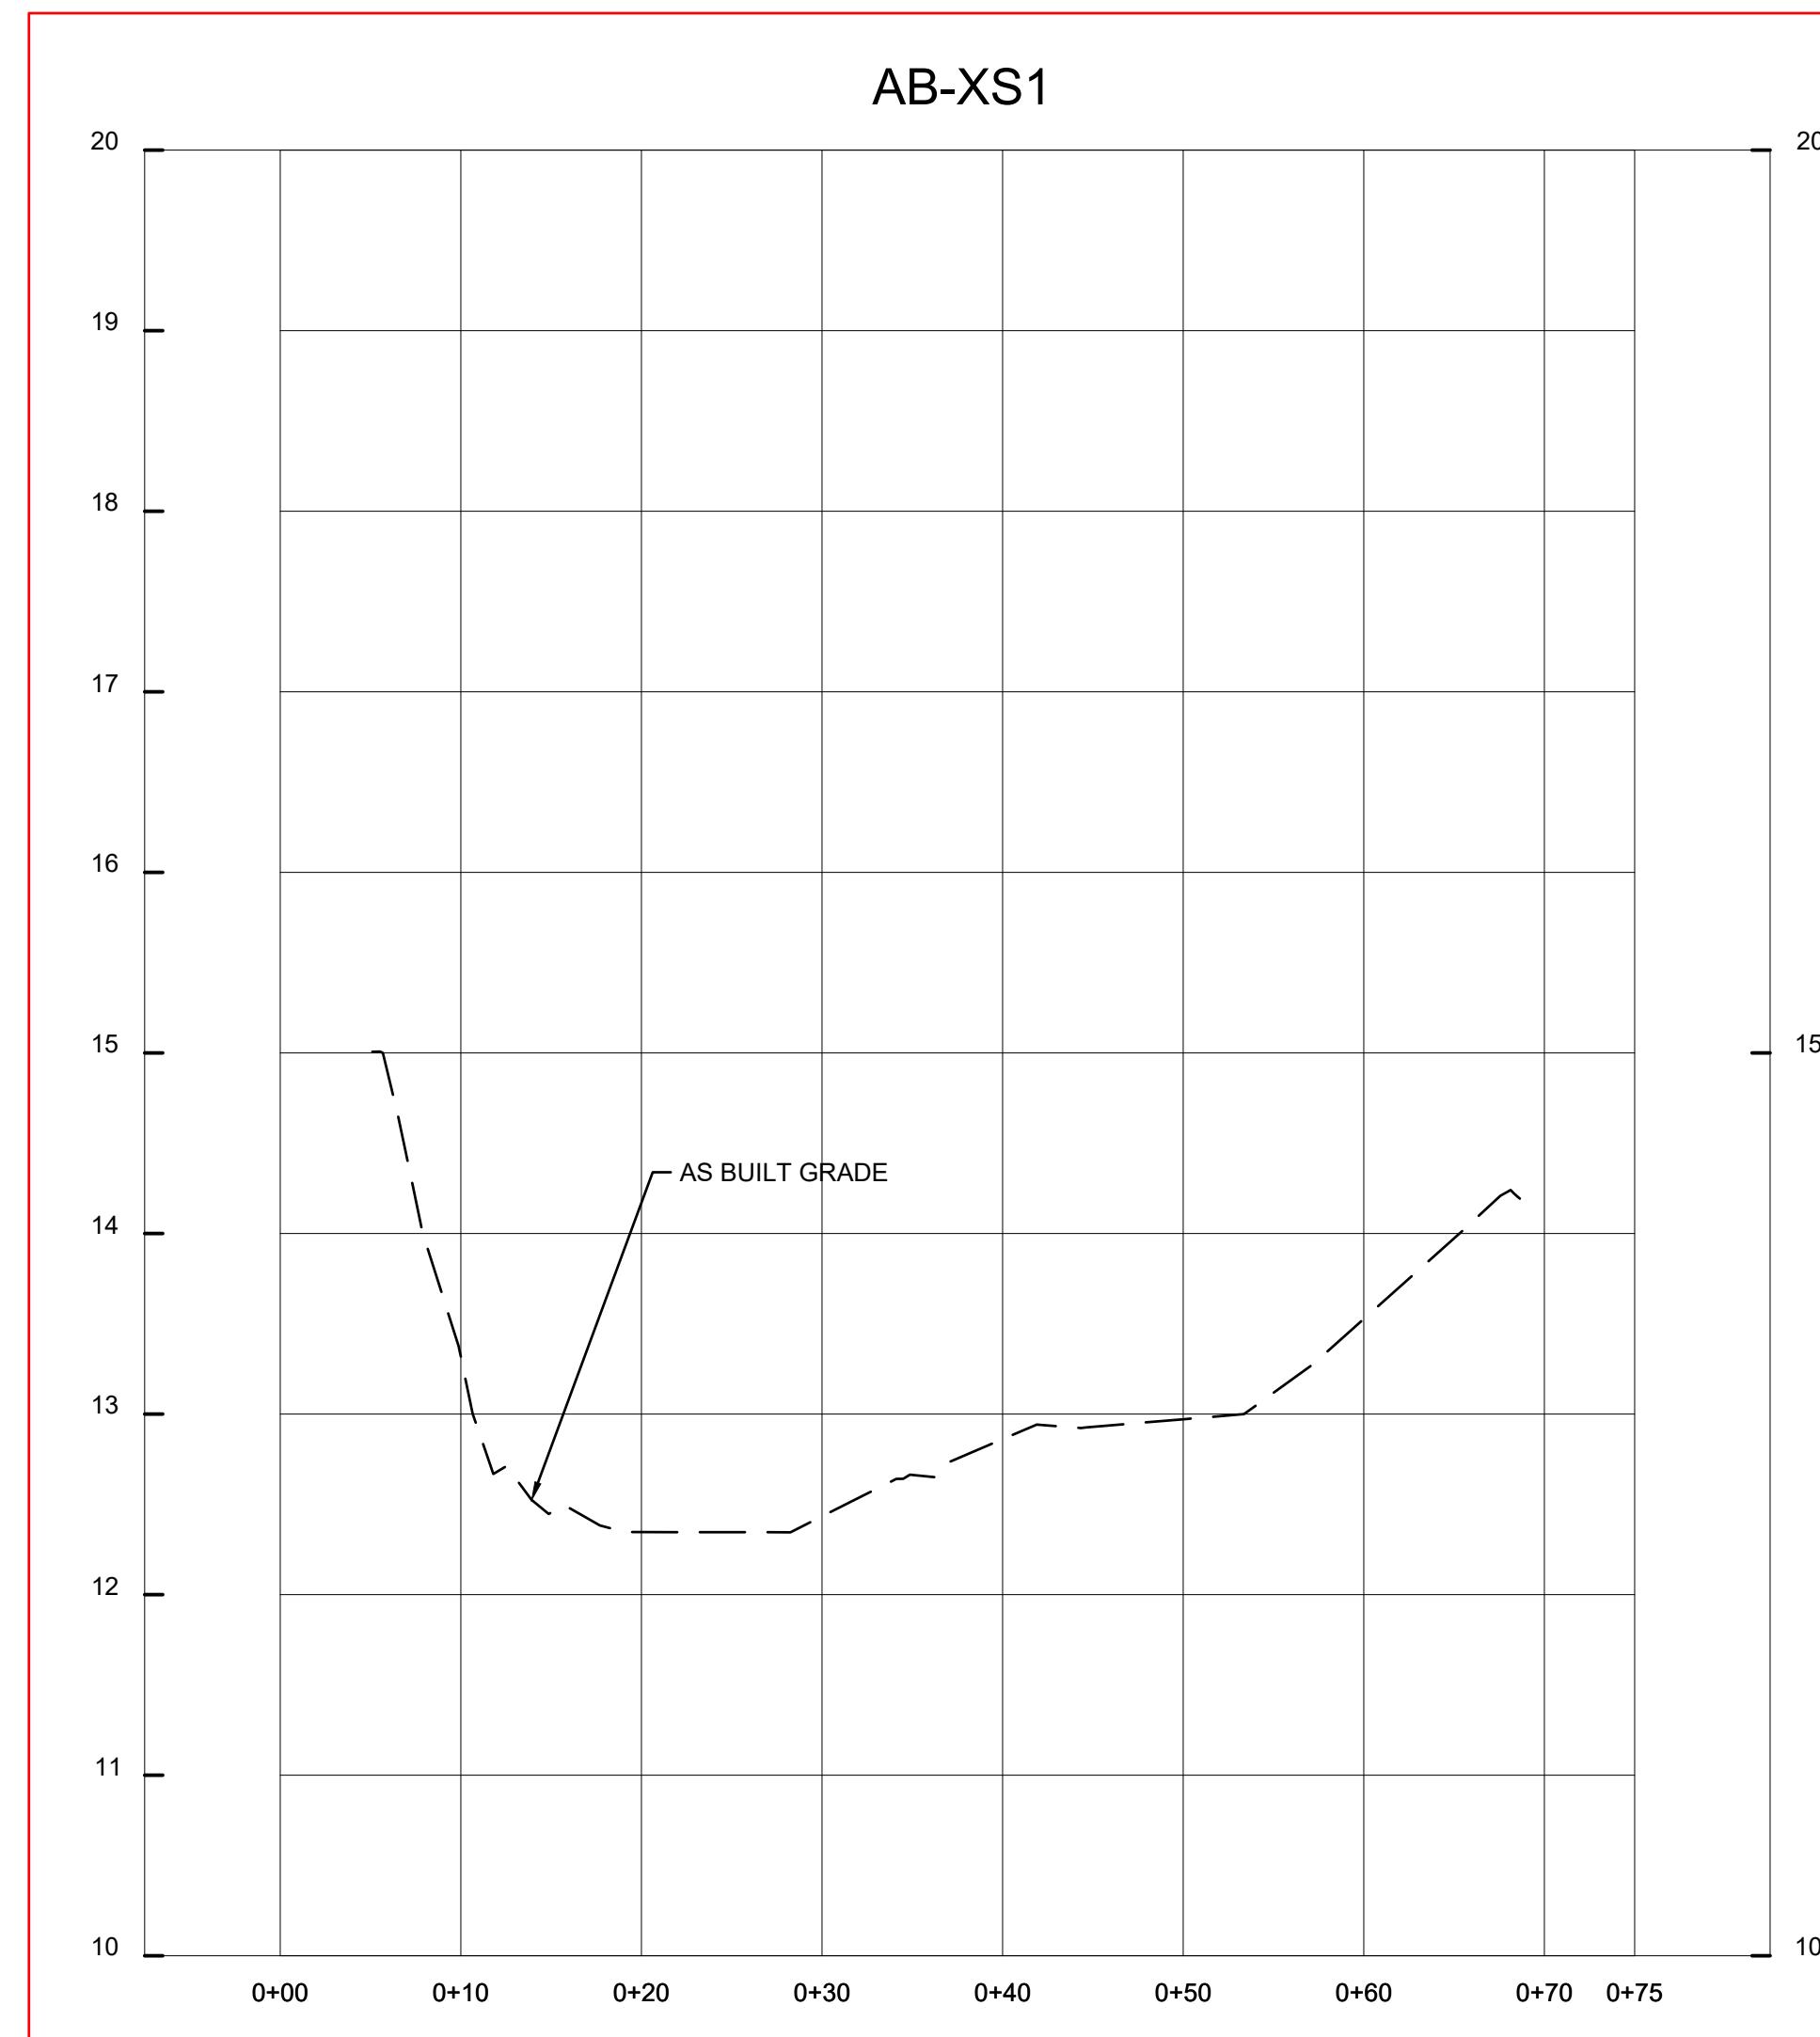


HORIZ: 1" = 10'
VERT: 1" = 1'

AS-BUILT AB-8

OWNER/DEVELOPER/APPLICANT  717-627-4440 fax: 717-627-4660 landstudies.com land@landstudies.com 315 North Street Lititz, PA 17543	CIVIL ENGINEER A.A. County ID #721  2101 Galter Road Suite #340 Rockville, MD 20850 Contact: Joanne M. Cheek, Senior Associate Phone: (301) 337-2856 Fax: (301) 258-7607	Professional Certification: I hereby certify that these documents were prepared or approved by me, and that I am a duly licensed professional engineer under the laws of the State of Maryland. License No. Expiration Date:	REVISIONS	ANNE ARUNDEL COUNTY DEPARTMENT OF PUBLIC WORKS STREAM RESTORATION PLAN								
1	Description	BY	DATE	APPROVED	DATE	APPROVED	DATE	SCALE: As Shown	SHEET NO: 87 OF 39			
2	Revise 100-yr floodplain	LSI/ DEW	1/2021					DRAWN BY: Buff/R. Anchors	PROJECT NO: 50017963			
3	ADDRESSED AA COUNTY COMMENTS	CG/ DEW	9/07/22					CHIEF ENGINEER	PROPOSAL NO: 13			
4	ADDRESSED AA COUNTY COMMENTS	LSI/ DEW	11/01/22					PROJECT MANAGER	3rd District			
								APPROVED	DATE	APPROVED	DATE	
								ASSISTANT CHIEF ENGINEER	CHIEF, RIGHT OF WAY			




SLOOP COVE RETROFIT SITE 1
Tax Map 16 Grid 05
Anne Arundel County

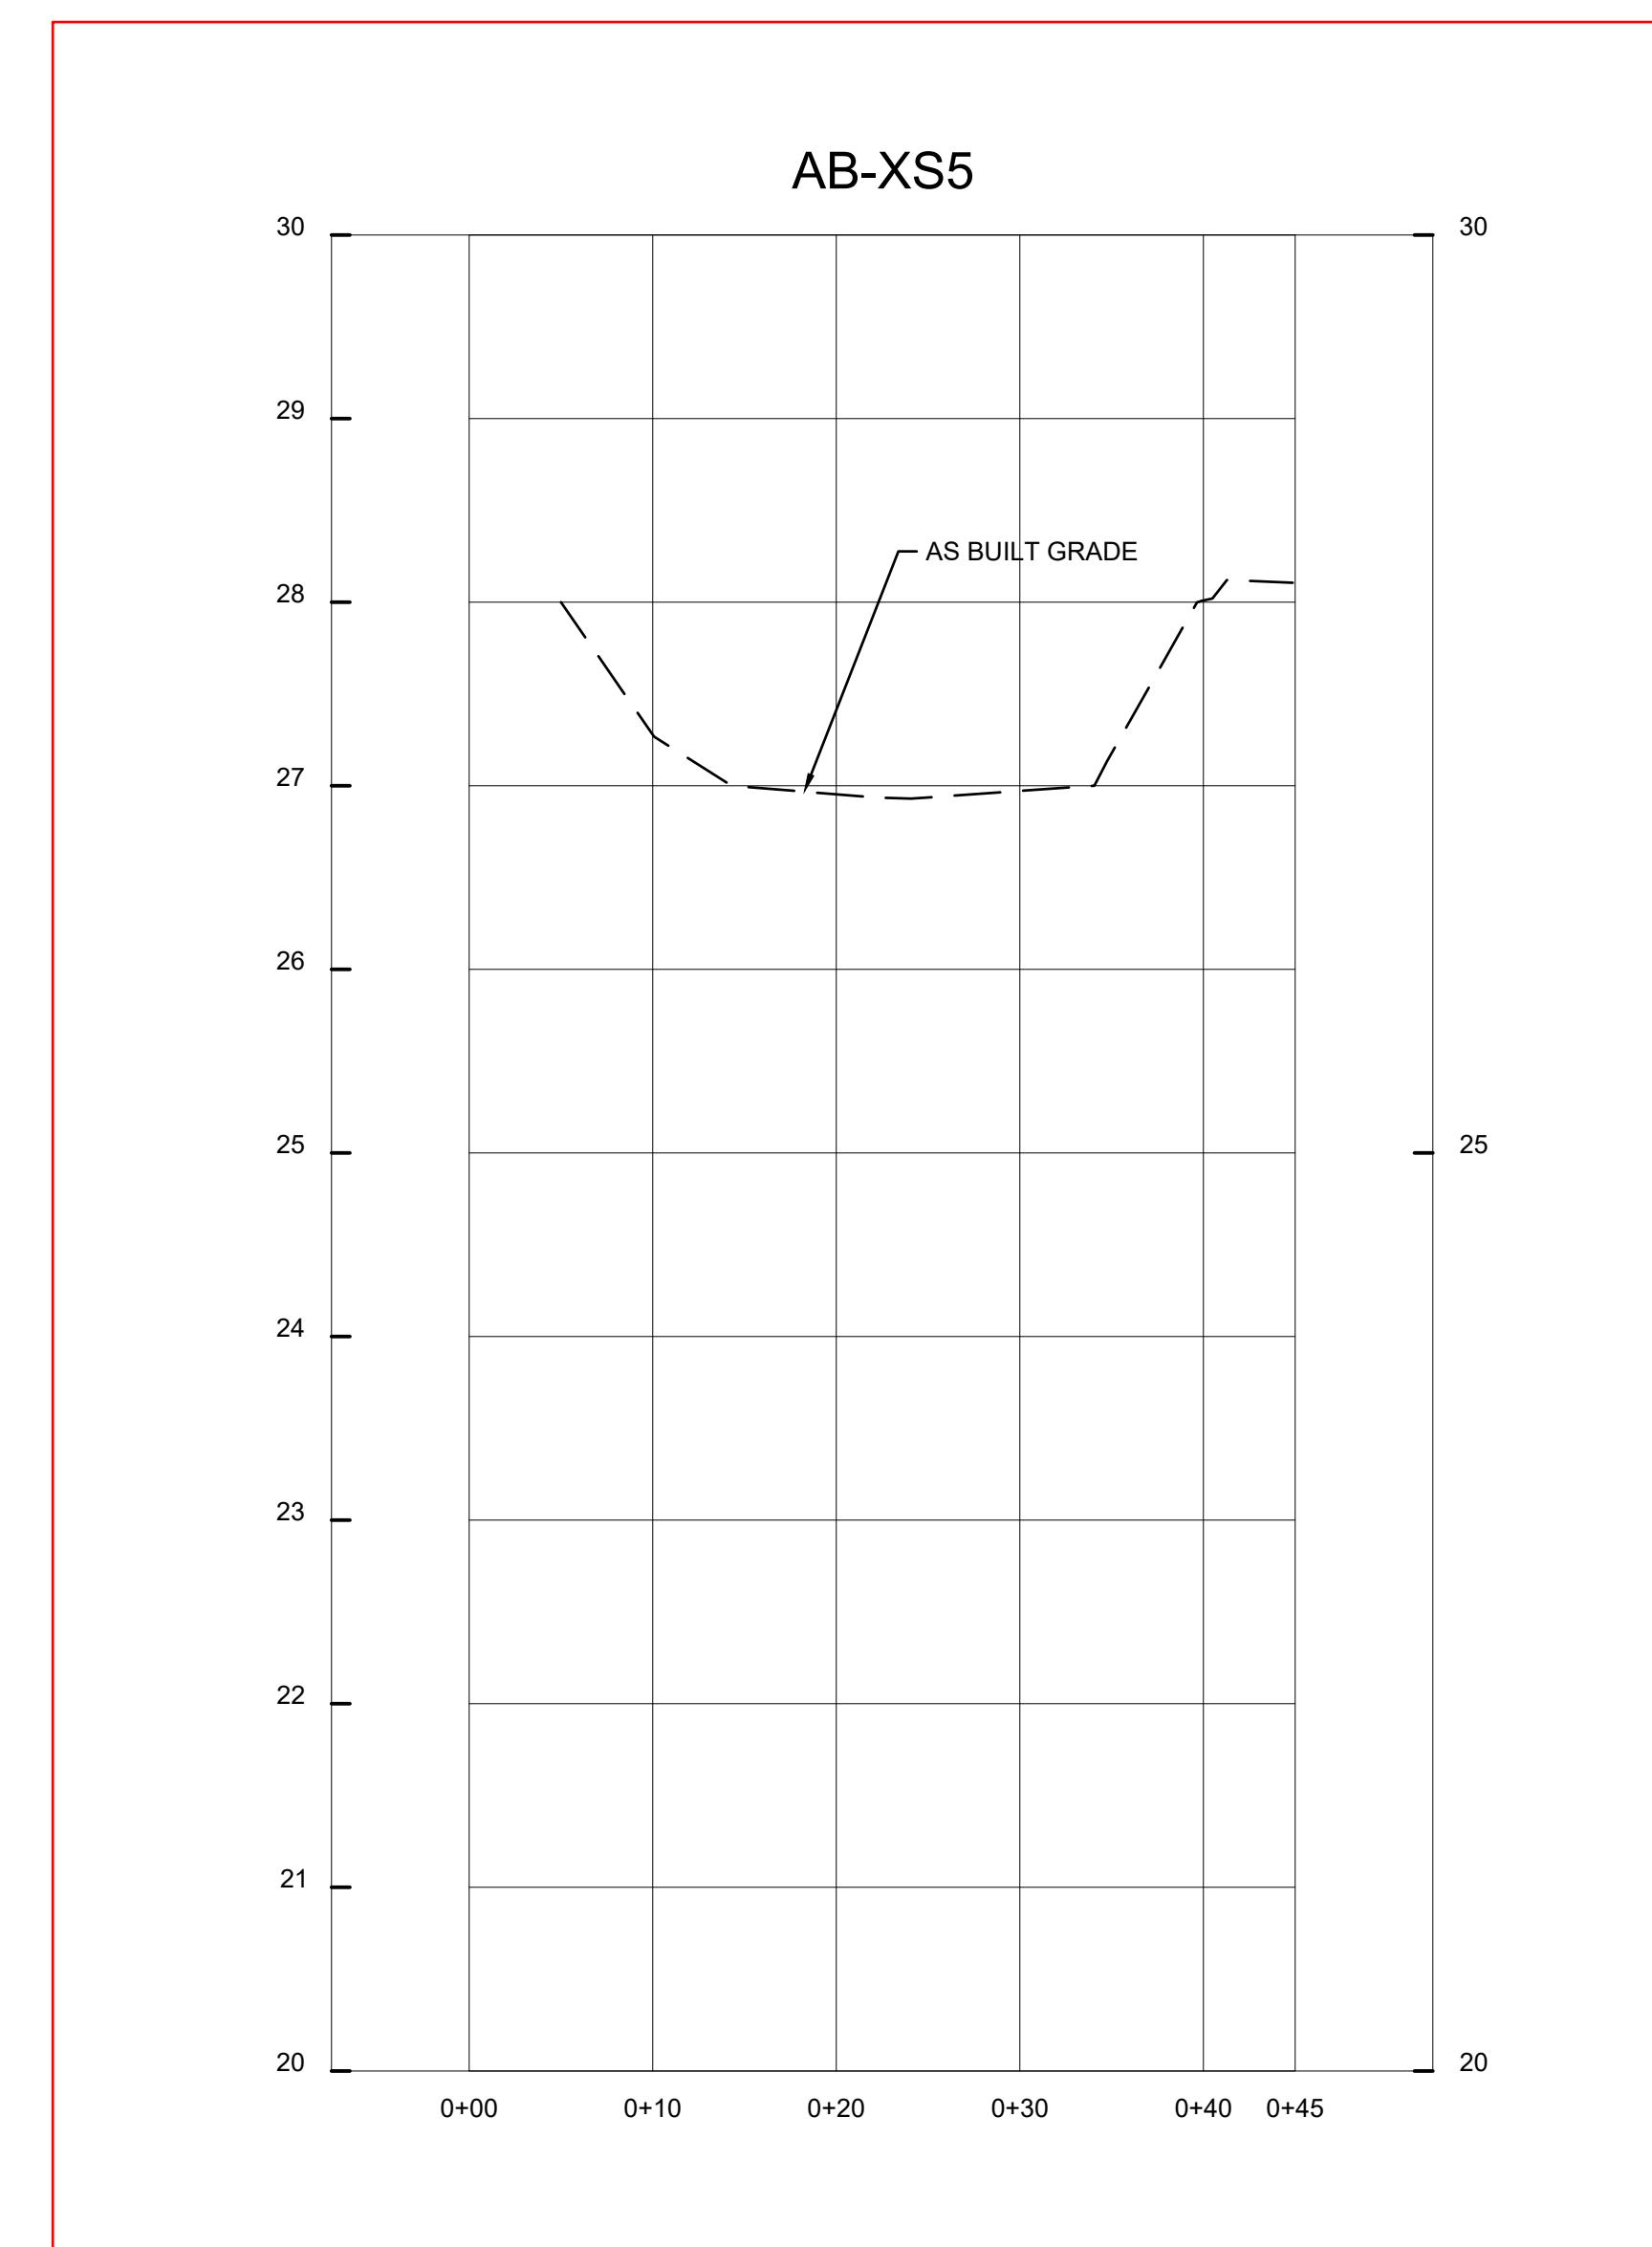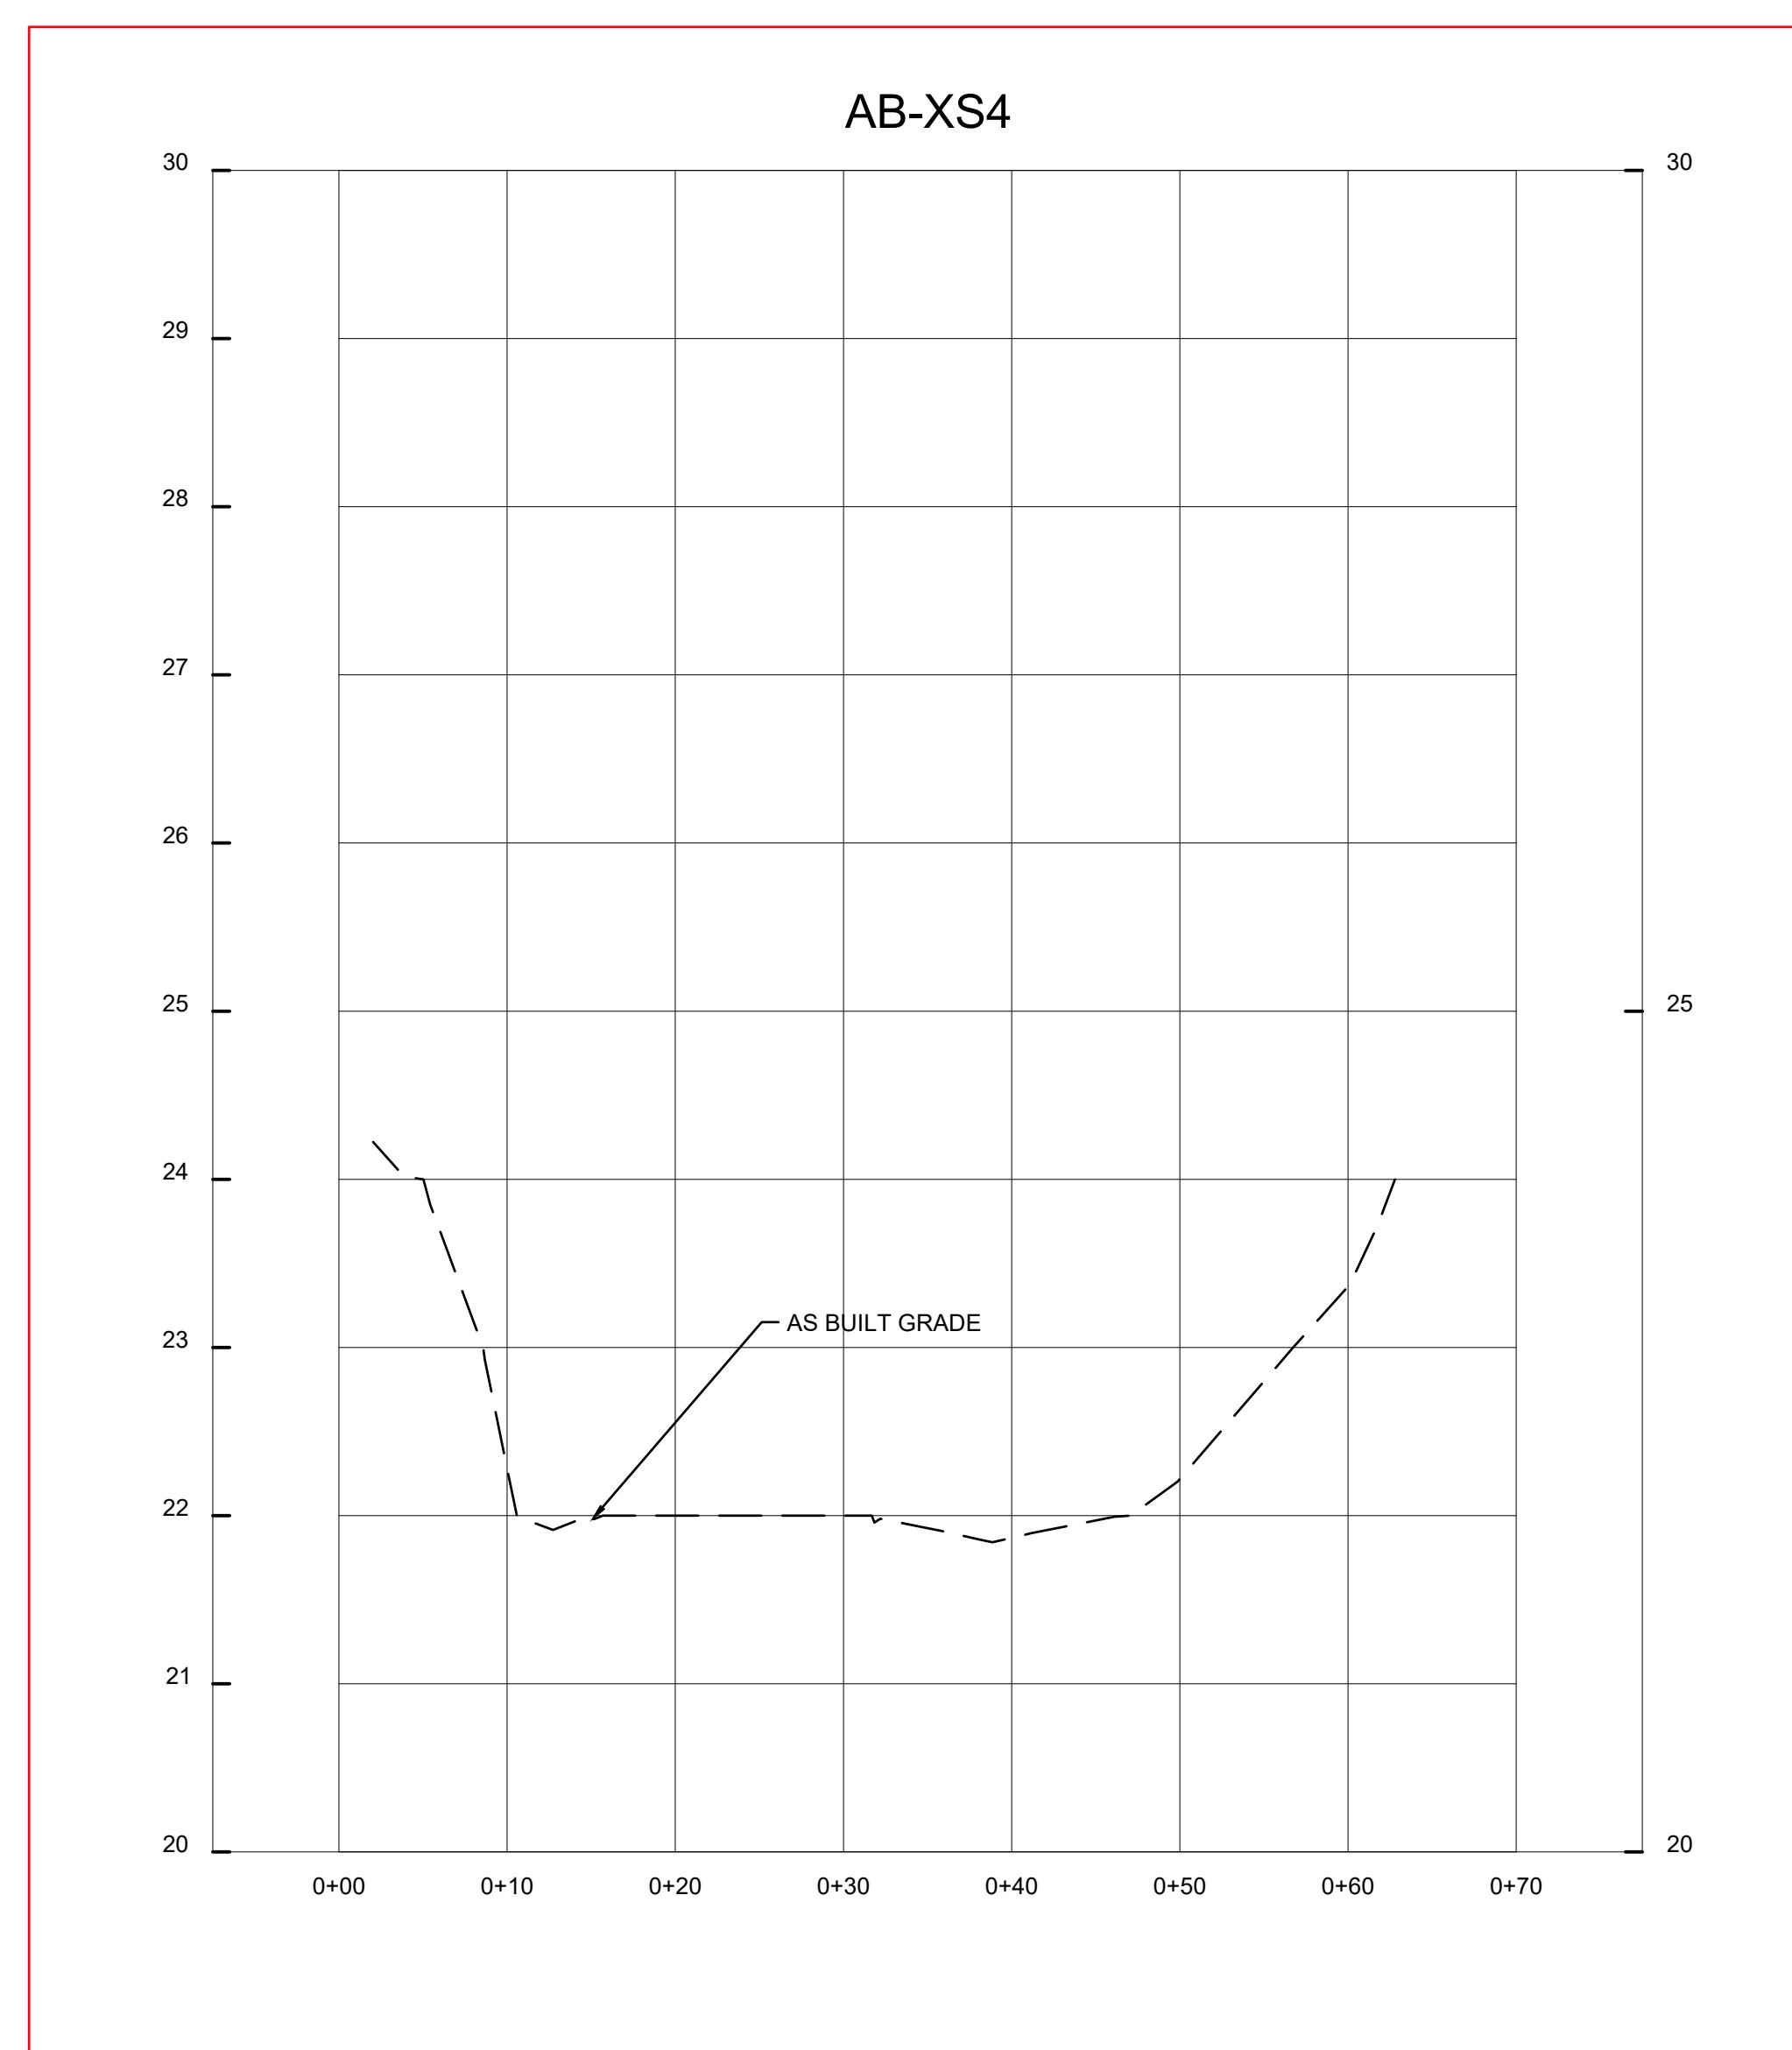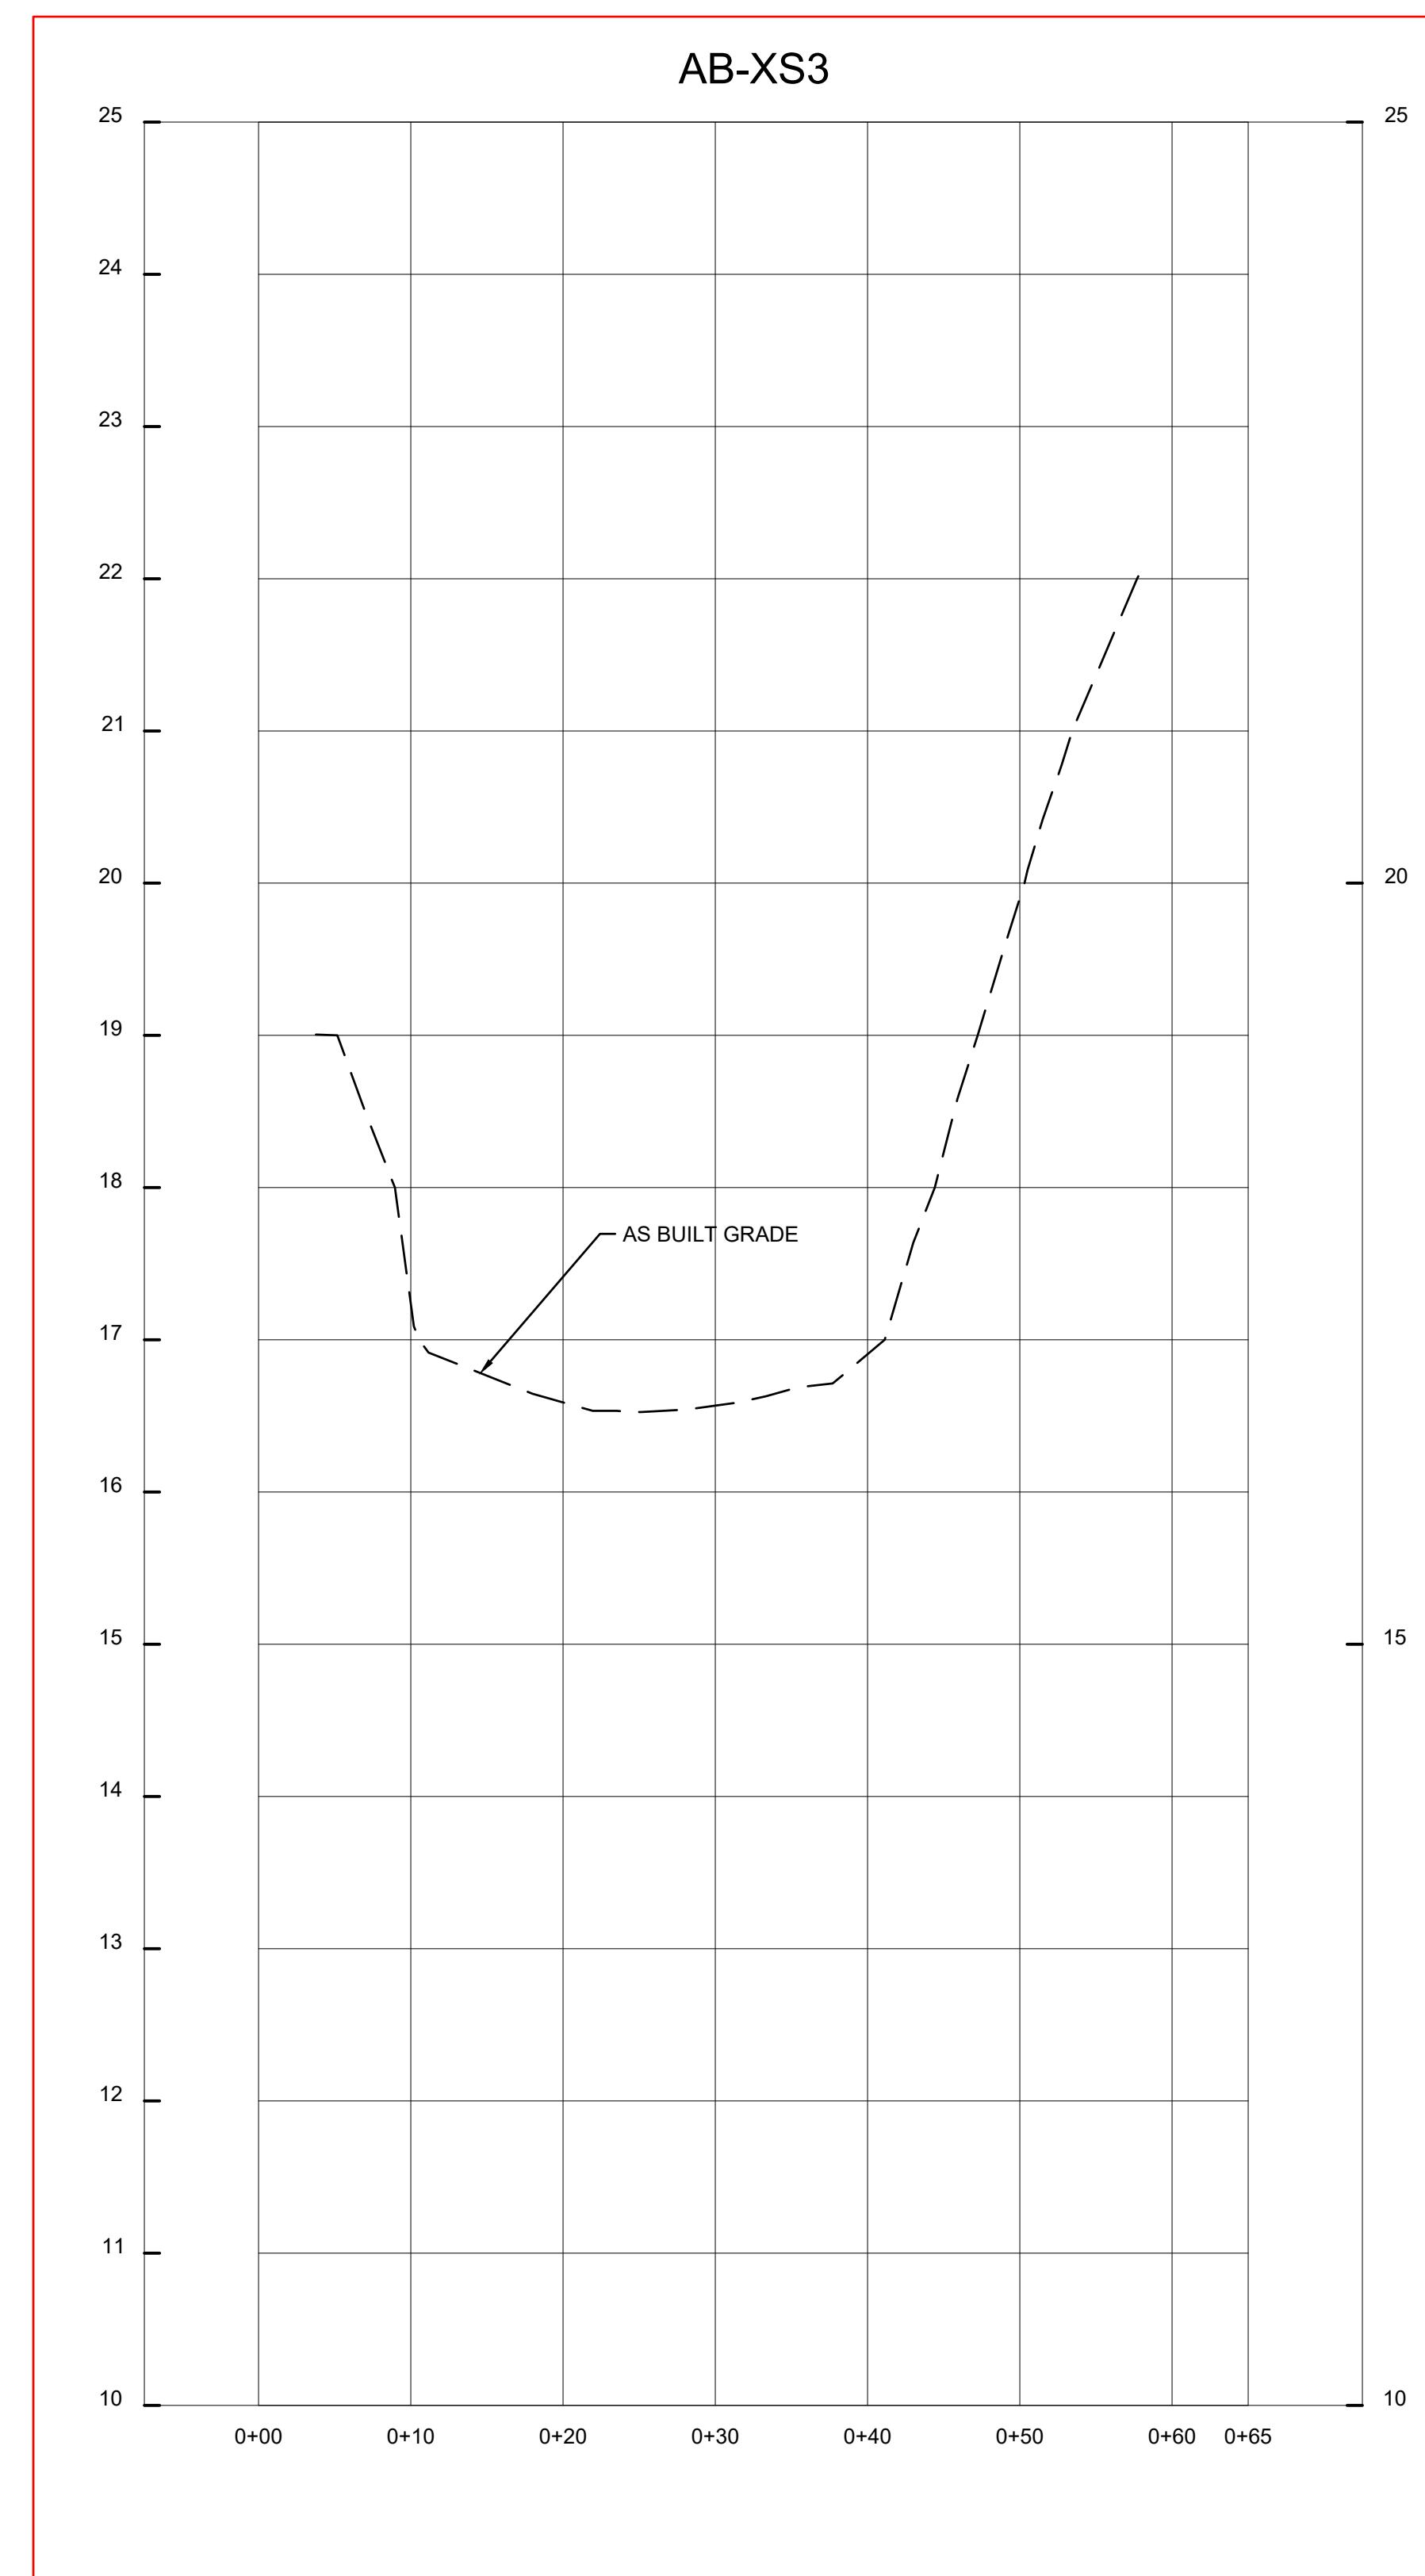

HORIZ: 1" = 10'
VERT: 1" = 1'

AS-BUILT AB-9




OWNER/DEVELOPER/APPLICANT		CIVIL ENGINEER A.A. County ID #721	REVISIONS				ANNE ARUNDEL COUNTY				
	717-627-4440 fax: 717-627-4660 landstudies.com 315 North Street Litz, PA 17543	 2101 Gaither Road Suite #340 Rockville, MD 20850 Contact: Joanne M. Cheek, Senior Associate Phone: (301) 337-2856 Fax: (301) 258-7607	Professional Certification: I hereby certify that these documents were prepared or approved by me, and that I am a duly licensed professional engineer under the laws of the State of Maryland. License No. Expiration Date:	NO	Description	BY	DATE	DEPARTMENT OF PUBLIC WORKS			
				1	Revise 100-yr floodplain	LSI/ DEW	1/2021	APPROVED	DATE	APPROVED	DATE
				2	ADDRESSED AA COUNTY COMMENTS	CG/ DEW	9/07/22			SCALE:	As Shown
				3	ADDRESSED AA COUNTY COMMENTS	LSI/ DEW	11/01/22	CHIEF ENGINEER		DRAWN BY:	BJF/R. Anchors
				4	ADDRESSED AA COUNTY COMMENTS	LSI/ DEW	01/10/23	PROJECT MANAGER		CHECKED BY:	Check
								APPROVED	DATE	SHEET NO:	9 OF 36
								ASSISTANT CHIEF ENGINEER		PROJECT NO:	50017963
								CHIEF, RIGHT OF WAY		PROPOSAL NO:	
SLOOP COVE RETROFIT SITE 1 3rd District Tax Map 16 Grid 05 Anne Arundel County											

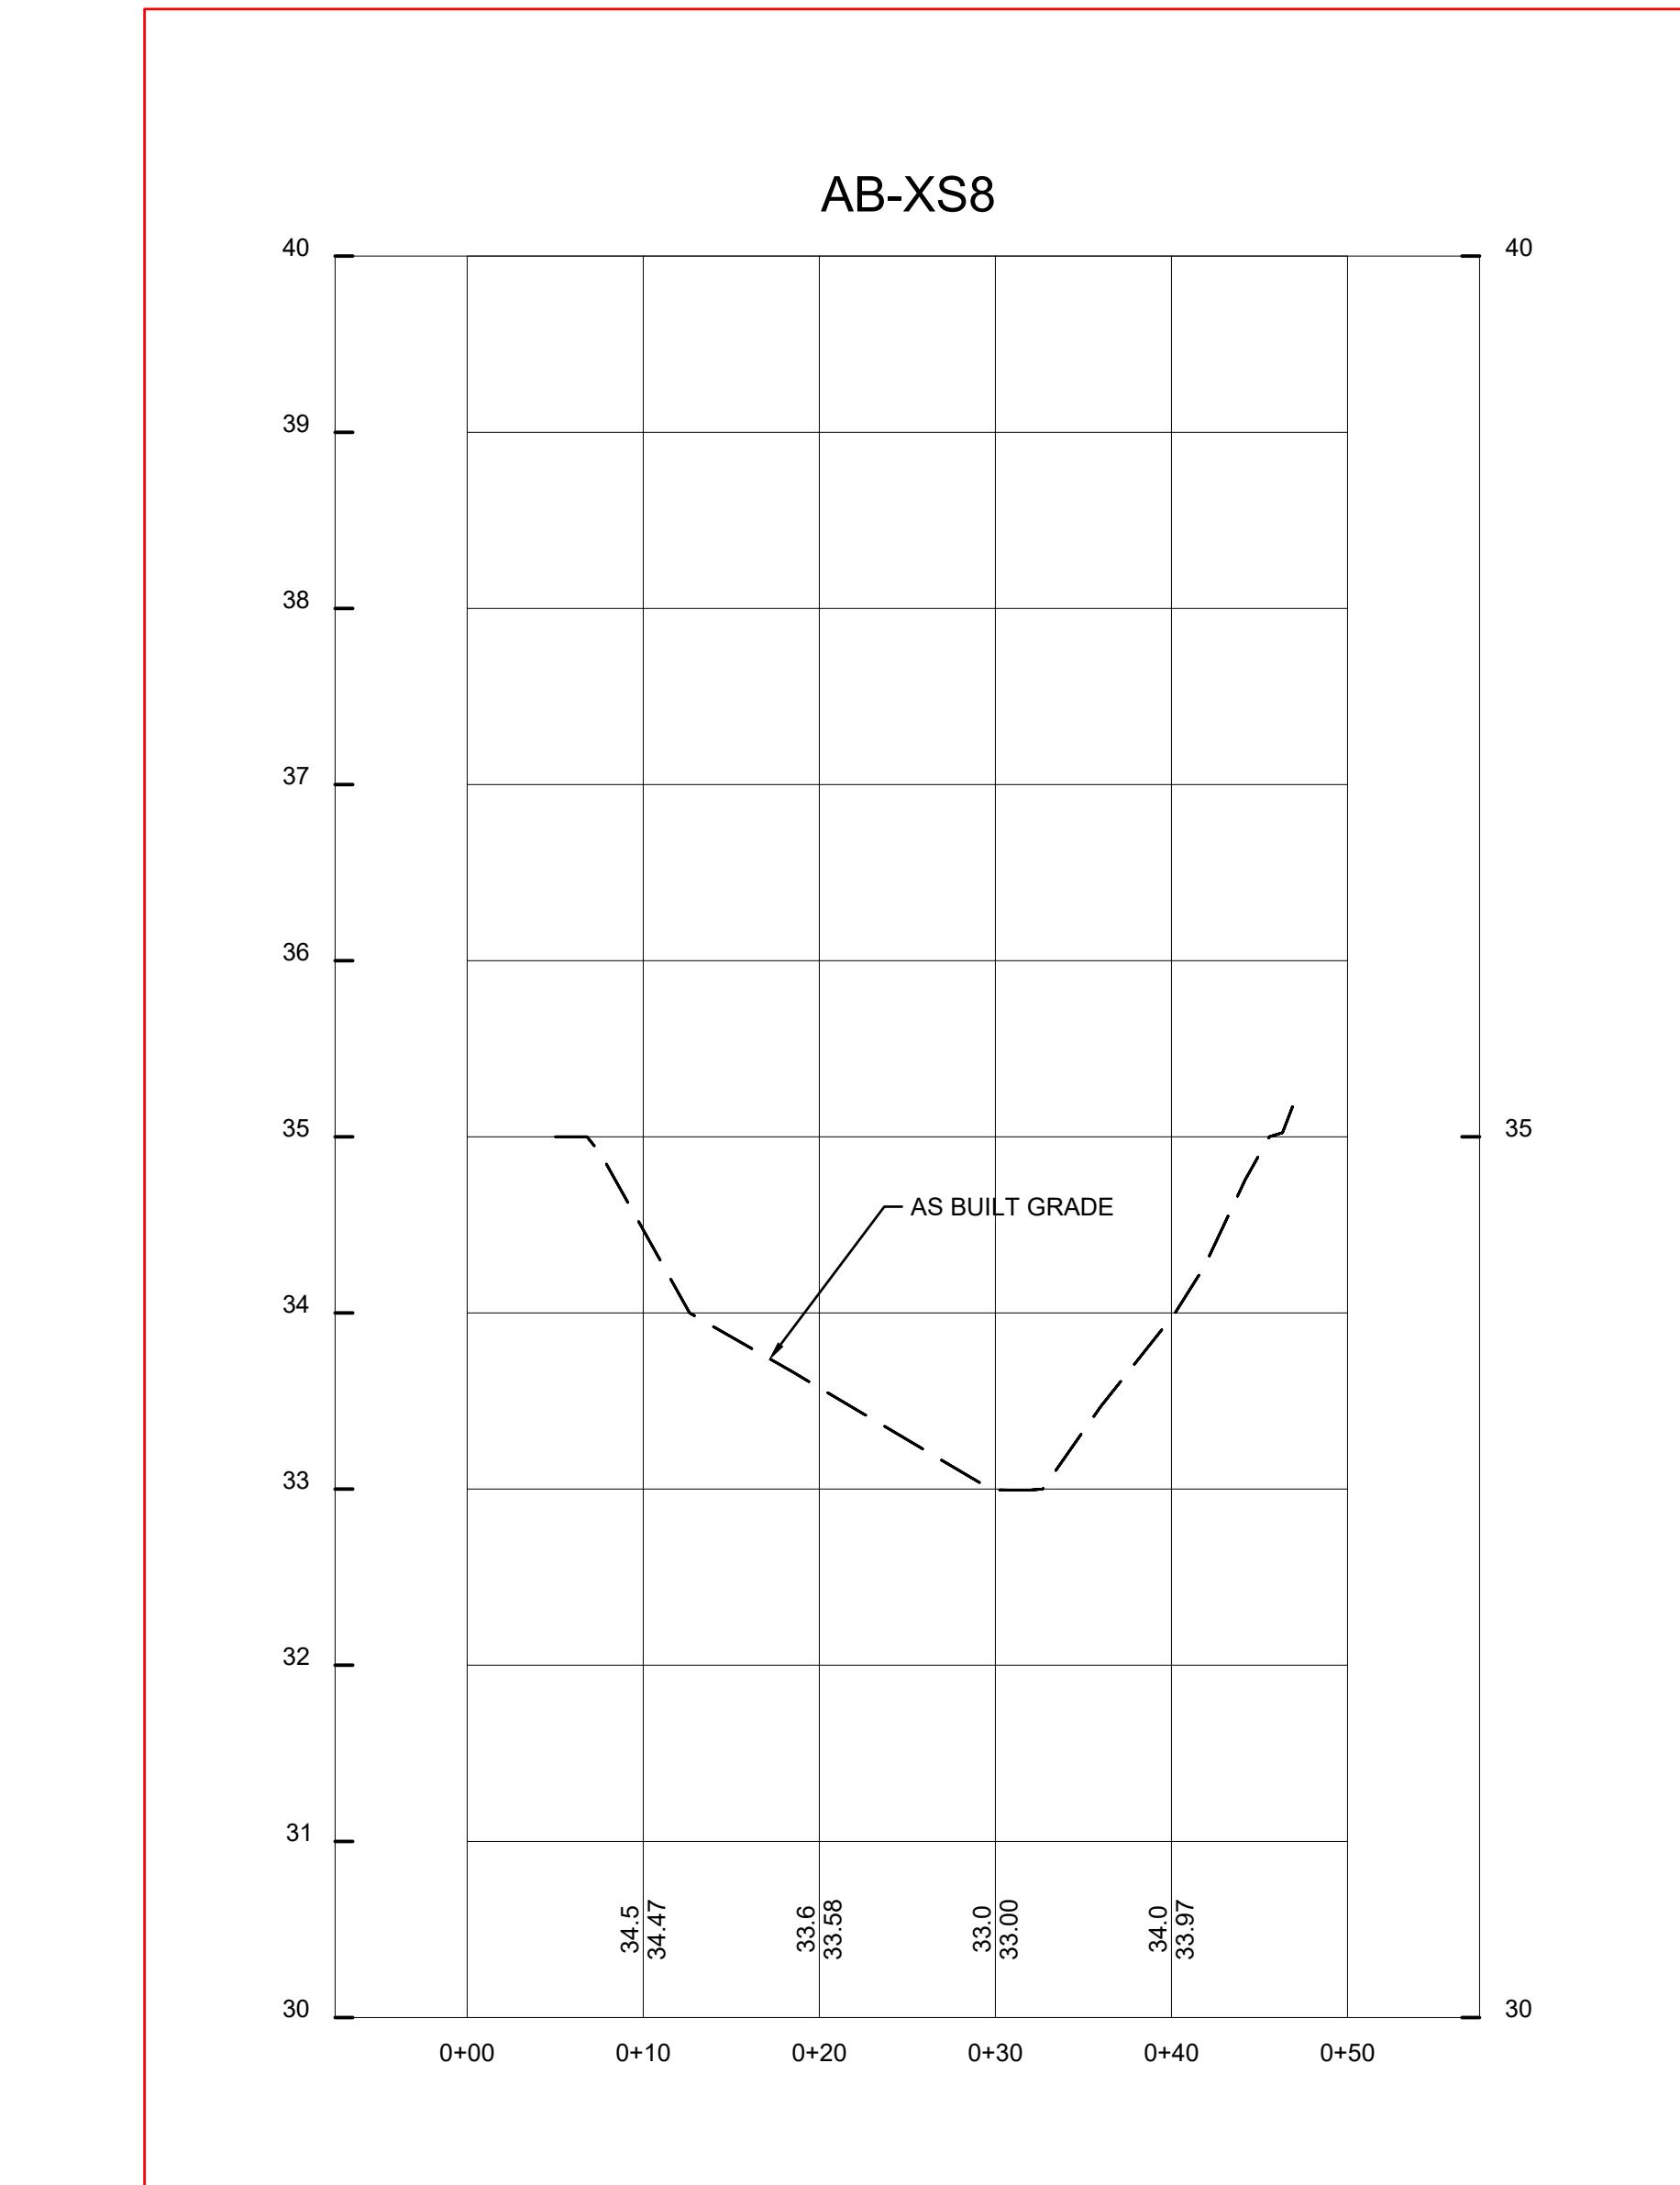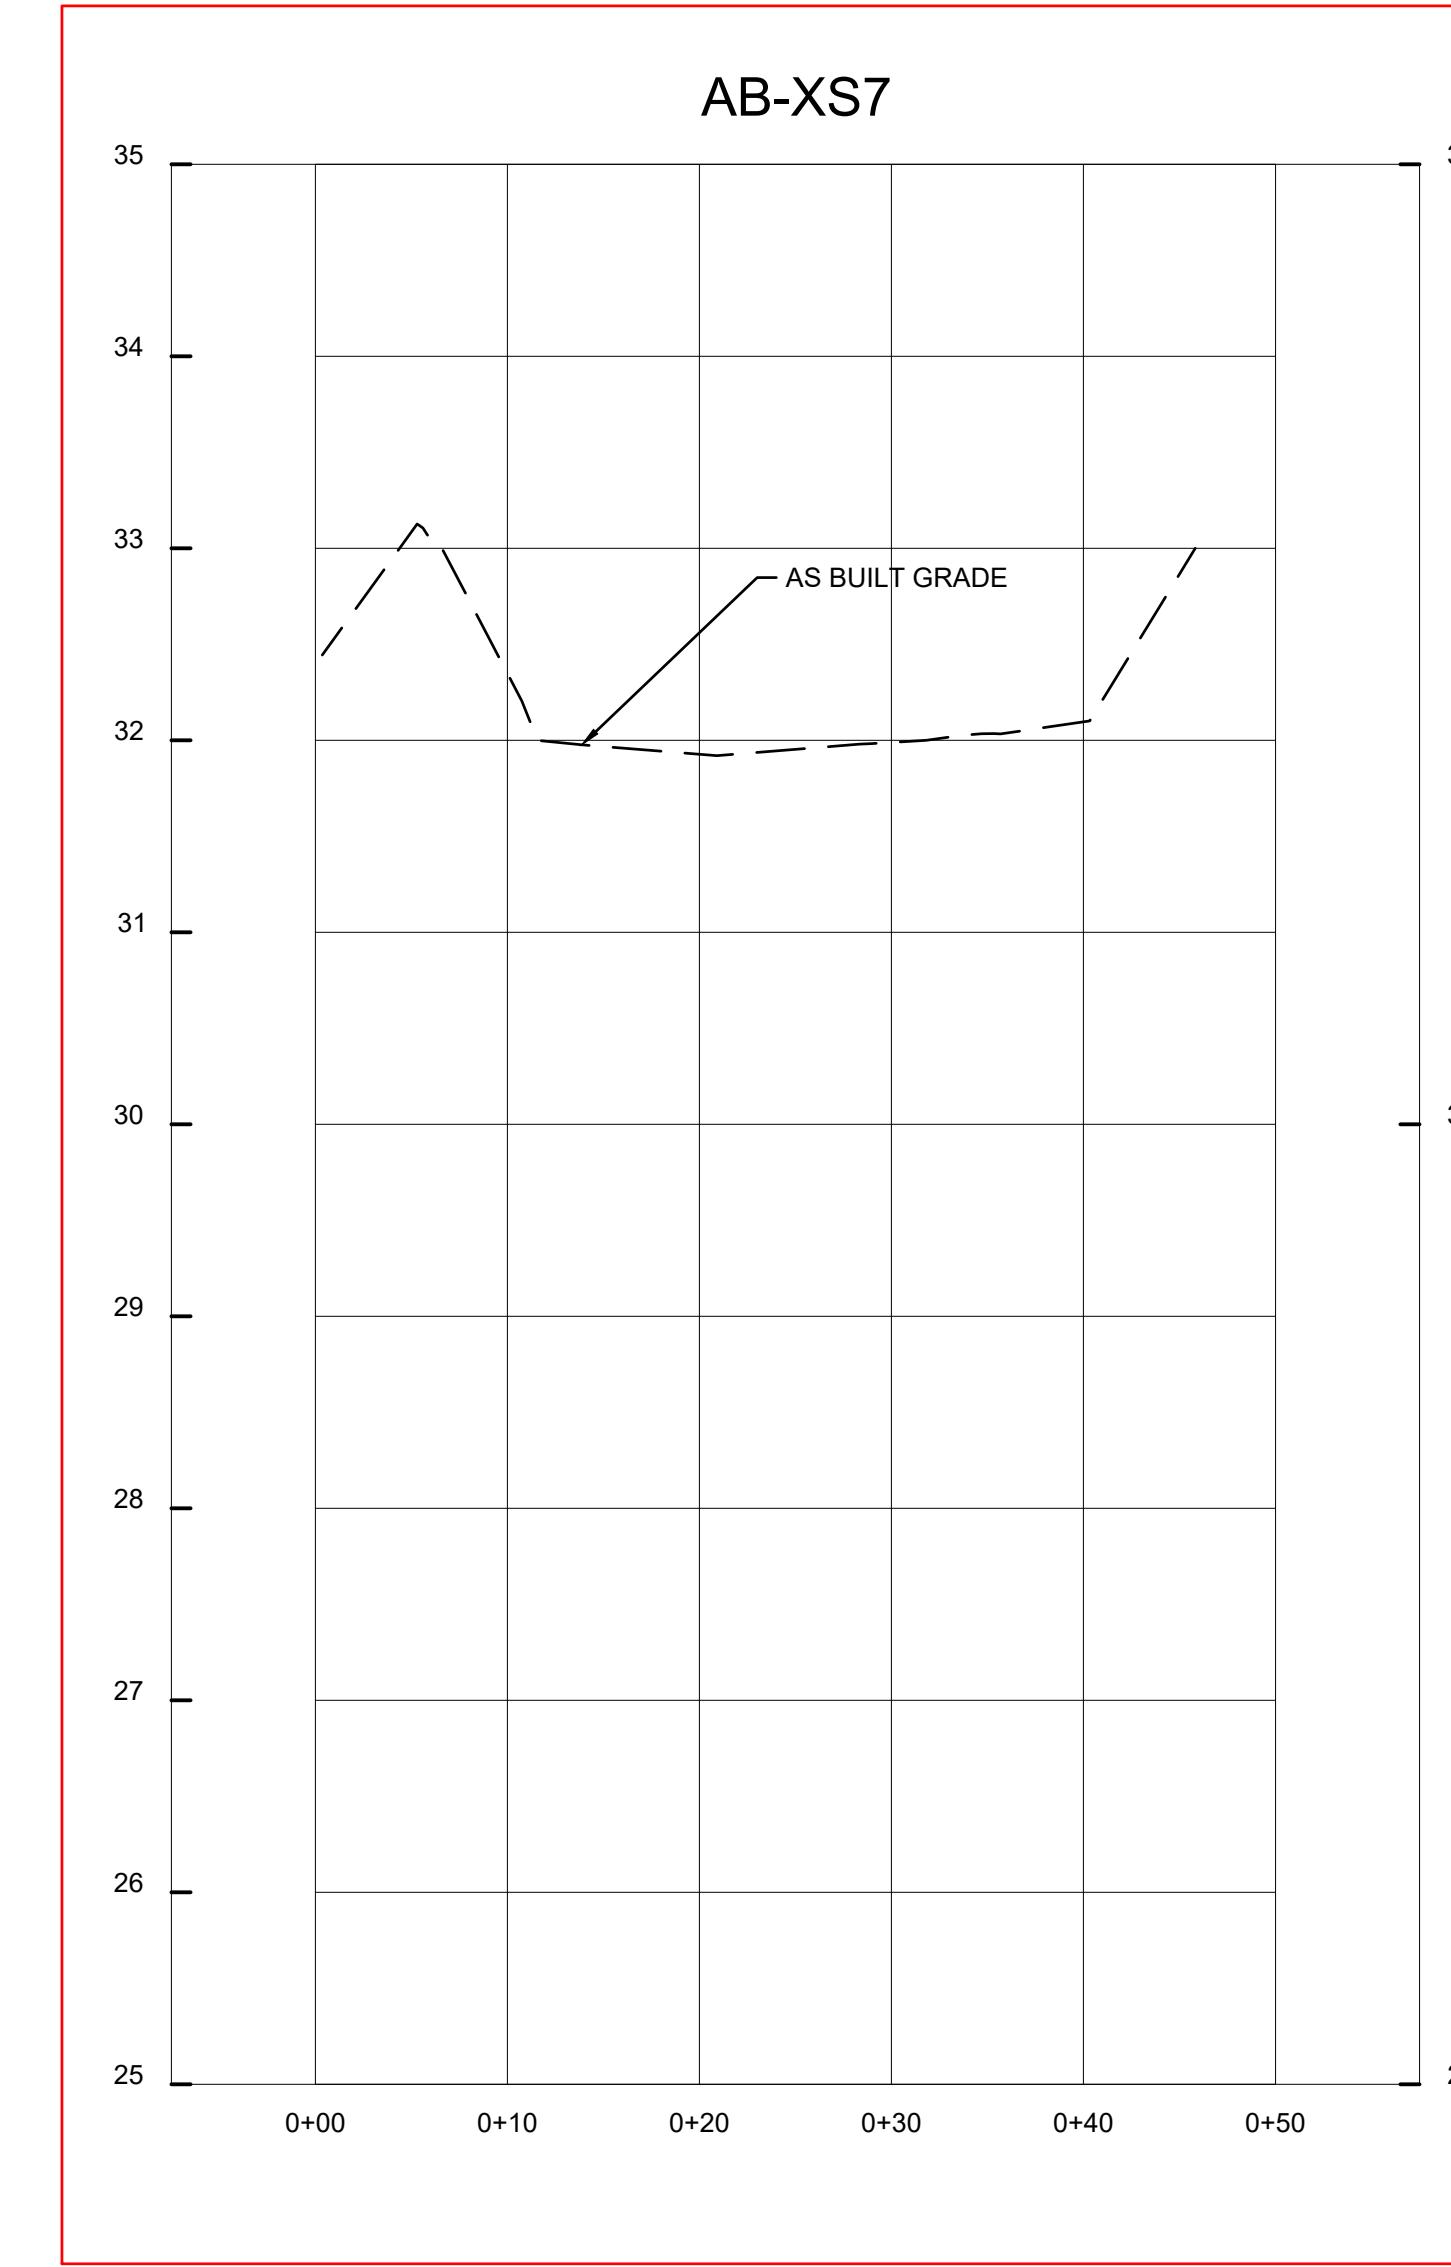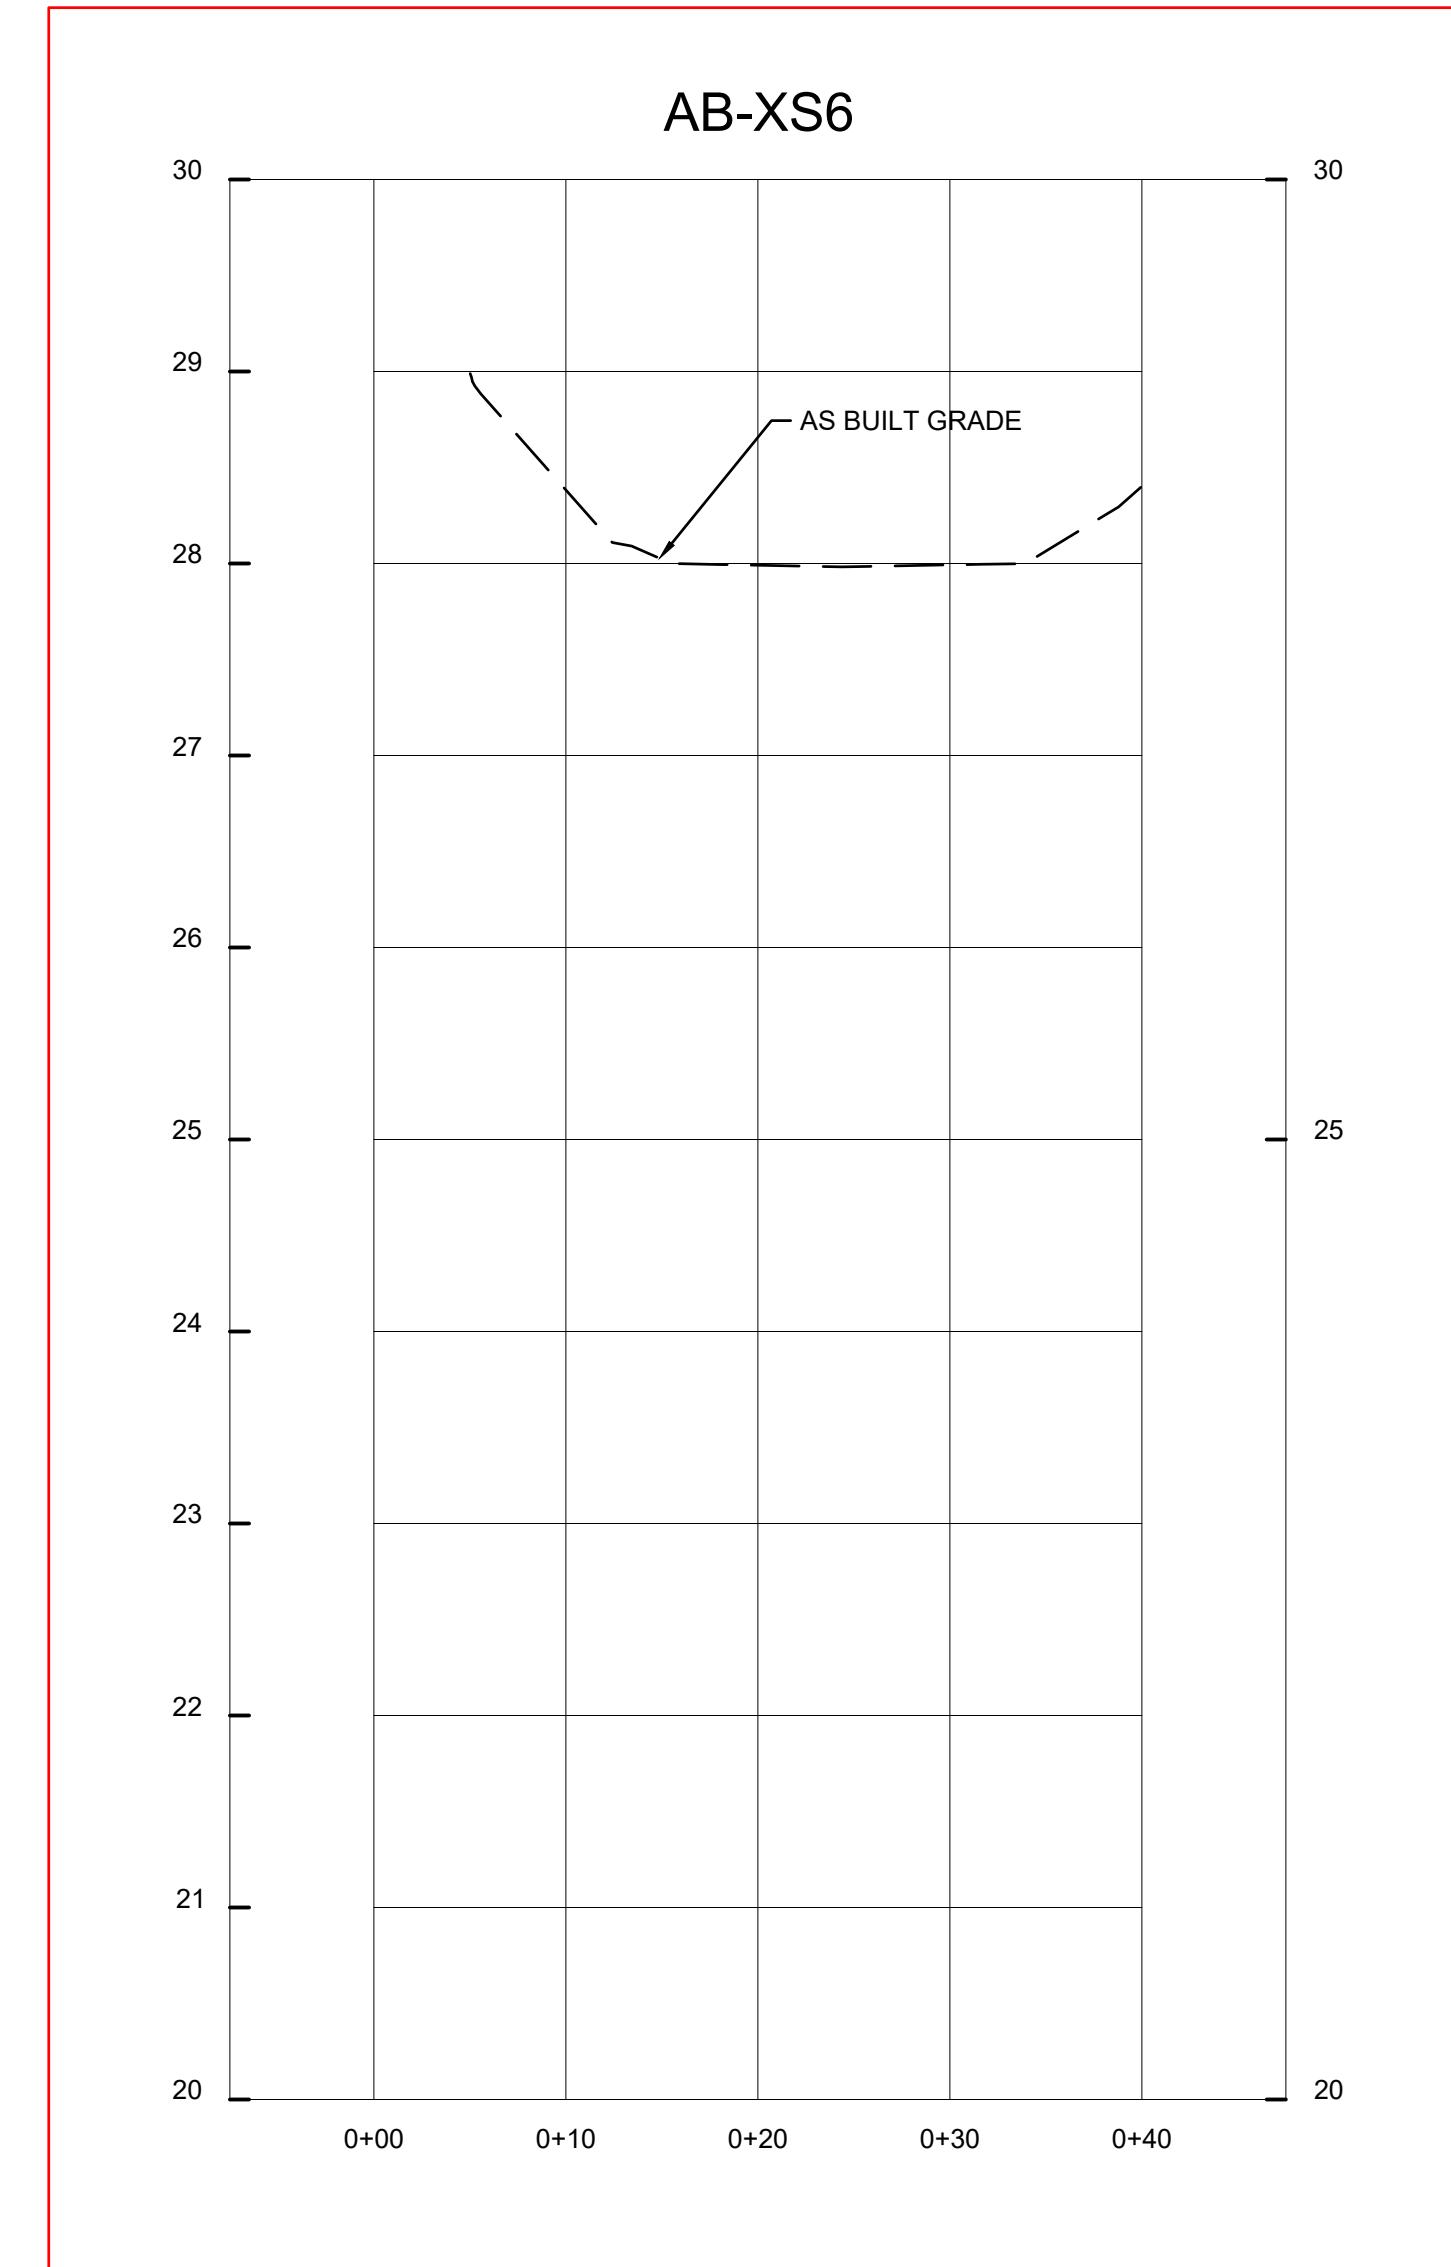

HORIZ: 1" = 10'
VERT: 1" = 1'

AS-BUILT AB-10



OWNER/DEVELOPER/APPLICANT  Dewberry 2101 Coitier Road Suite #340 Rockville, MD 20850 Contact: Joanne M. Cheok, Senior Associate Phone: (301) 337-2856 Fax: (301) 258-7607	CIVIL ENGINEER A.A. County ID #721  Dewberry 2101 Coitier Road Suite #340 Rockville, MD 20850 Professional Certification: I hereby certify that these documents were prepared or approved by me, and that I am a duly licensed professional engineer under the laws of the State of Maryland. License No.: Expiration Date:	REVISIONS <table border="1"> <thead> <tr> <th>NO.</th> <th>Description</th> <th>BY</th> <th>DATE</th> </tr> </thead> <tbody> <tr> <td>1</td> <td>Revise 100-yr floodplain</td> <td>LSI/ DEW</td> <td>1/2021</td> </tr> <tr> <td>2</td> <td>ADDRESSED AA COUNTY COMMENTS</td> <td>CG/ DEW</td> <td>9/07/22</td> </tr> <tr> <td>3</td> <td>ADDRESSED AA COUNTY COMMENTS</td> <td>LSI/ DEW</td> <td>11/01/22</td> </tr> <tr> <td>4</td> <td>ADDRESSED AA COUNTY COMMENTS</td> <td>LSI/ DEW</td> <td>01/10/23</td> </tr> </tbody> </table>	NO.	Description	BY	DATE	1	Revise 100-yr floodplain	LSI/ DEW	1/2021	2	ADDRESSED AA COUNTY COMMENTS	CG/ DEW	9/07/22	3	ADDRESSED AA COUNTY COMMENTS	LSI/ DEW	11/01/22	4	ADDRESSED AA COUNTY COMMENTS	LSI/ DEW	01/10/23	ANNE ARUNDEL COUNTY DEPARTMENT OF PUBLIC WORKS STREAM RESTORATION PLAN SHEET NO: 10 OF 13 PROJECT NO: 50017963 PROPOSAL NO: 3rd District Anne Arundel County
NO.	Description	BY	DATE																				
1	Revise 100-yr floodplain	LSI/ DEW	1/2021																				
2	ADDRESSED AA COUNTY COMMENTS	CG/ DEW	9/07/22																				
3	ADDRESSED AA COUNTY COMMENTS	LSI/ DEW	11/01/22																				
4	ADDRESSED AA COUNTY COMMENTS	LSI/ DEW	01/10/23																				

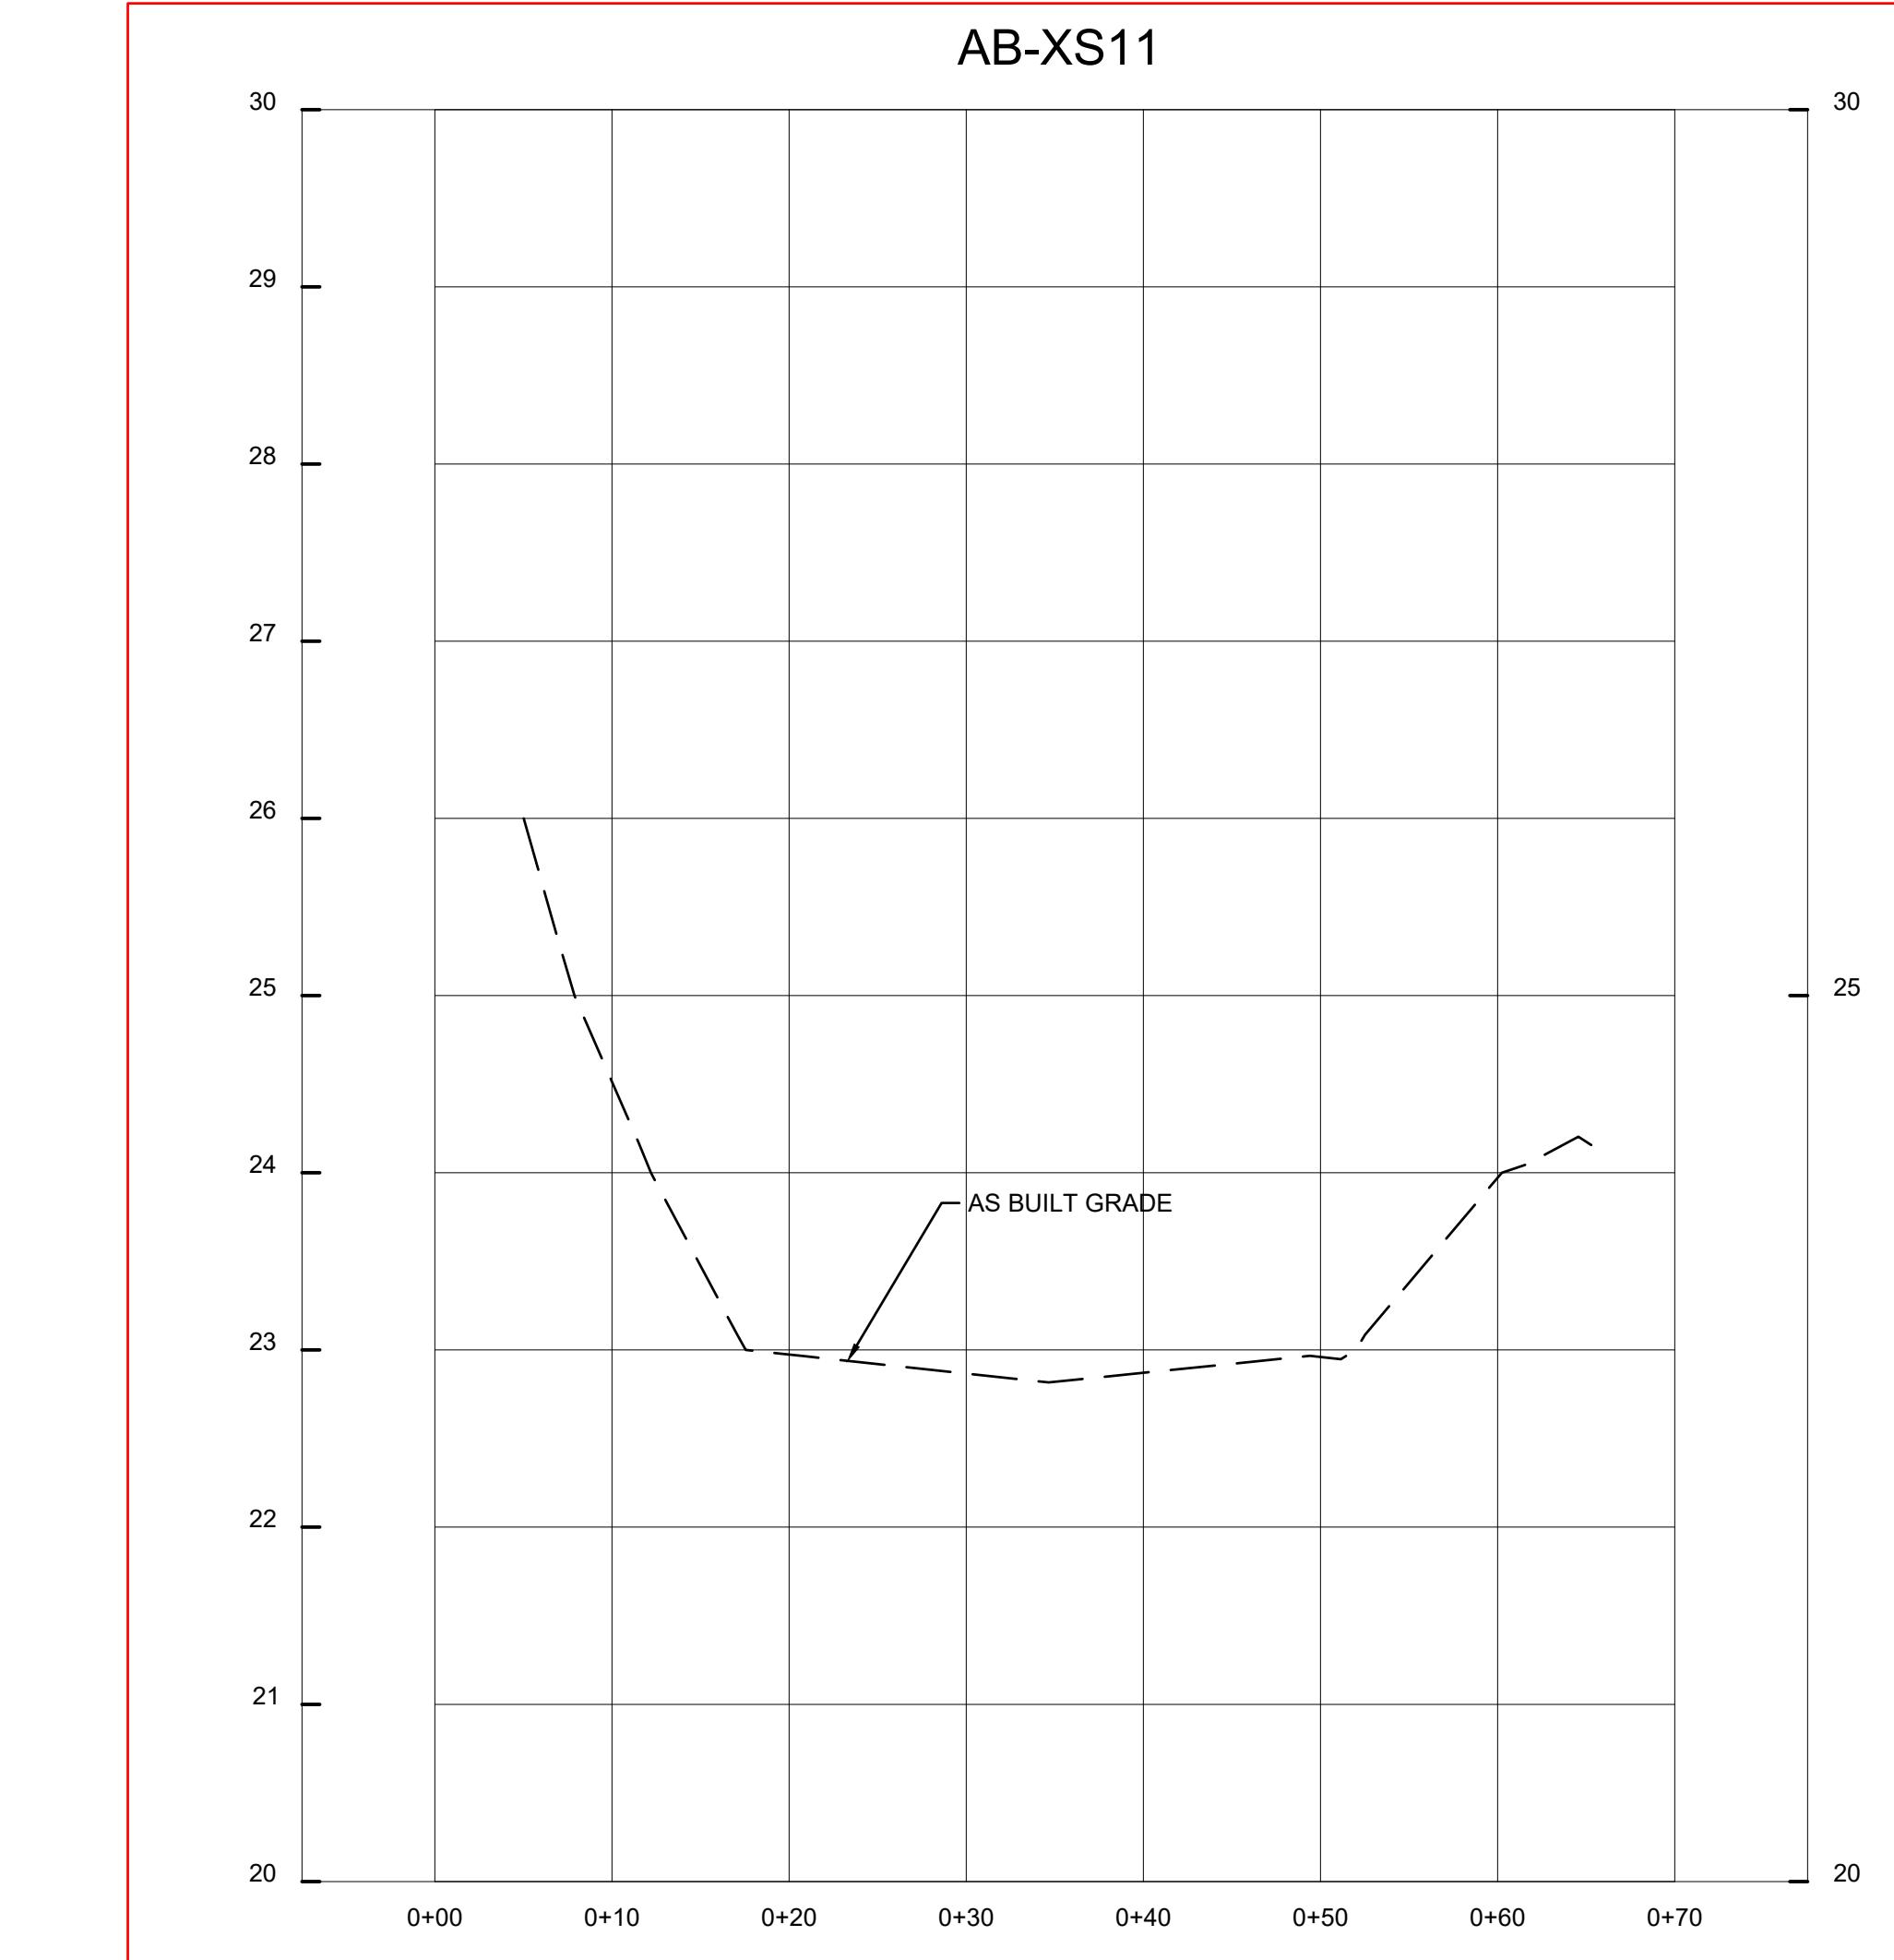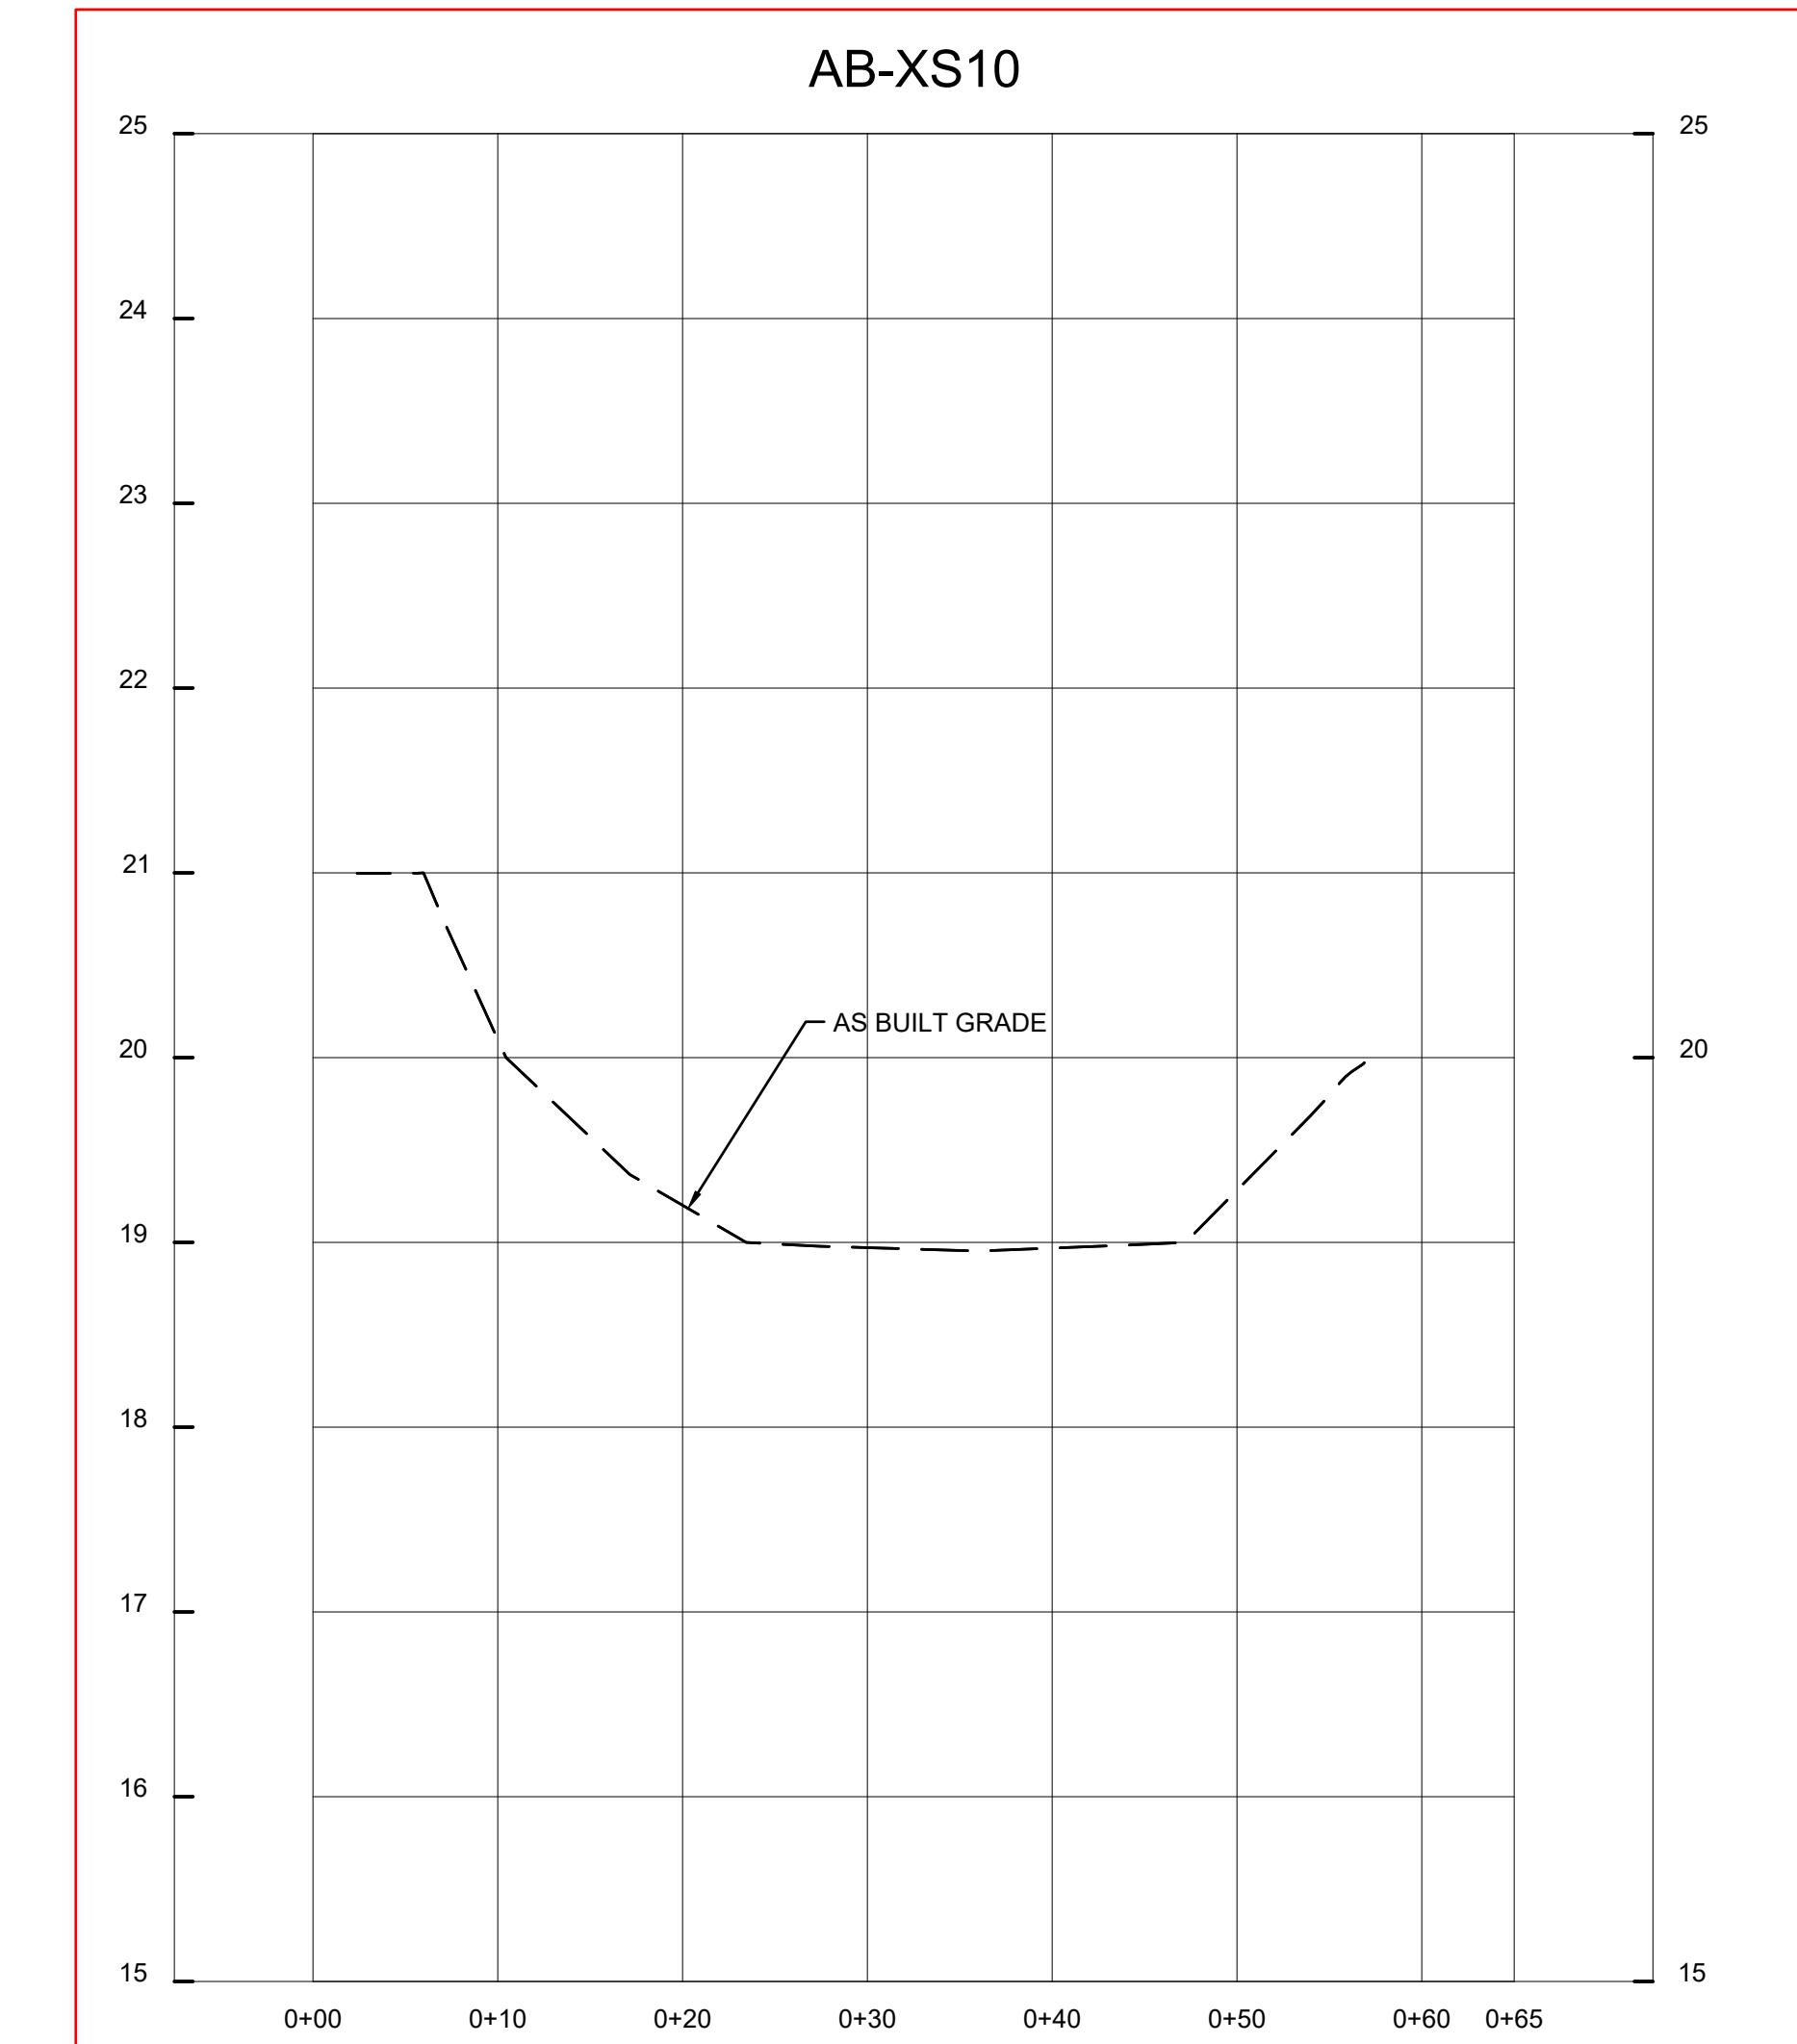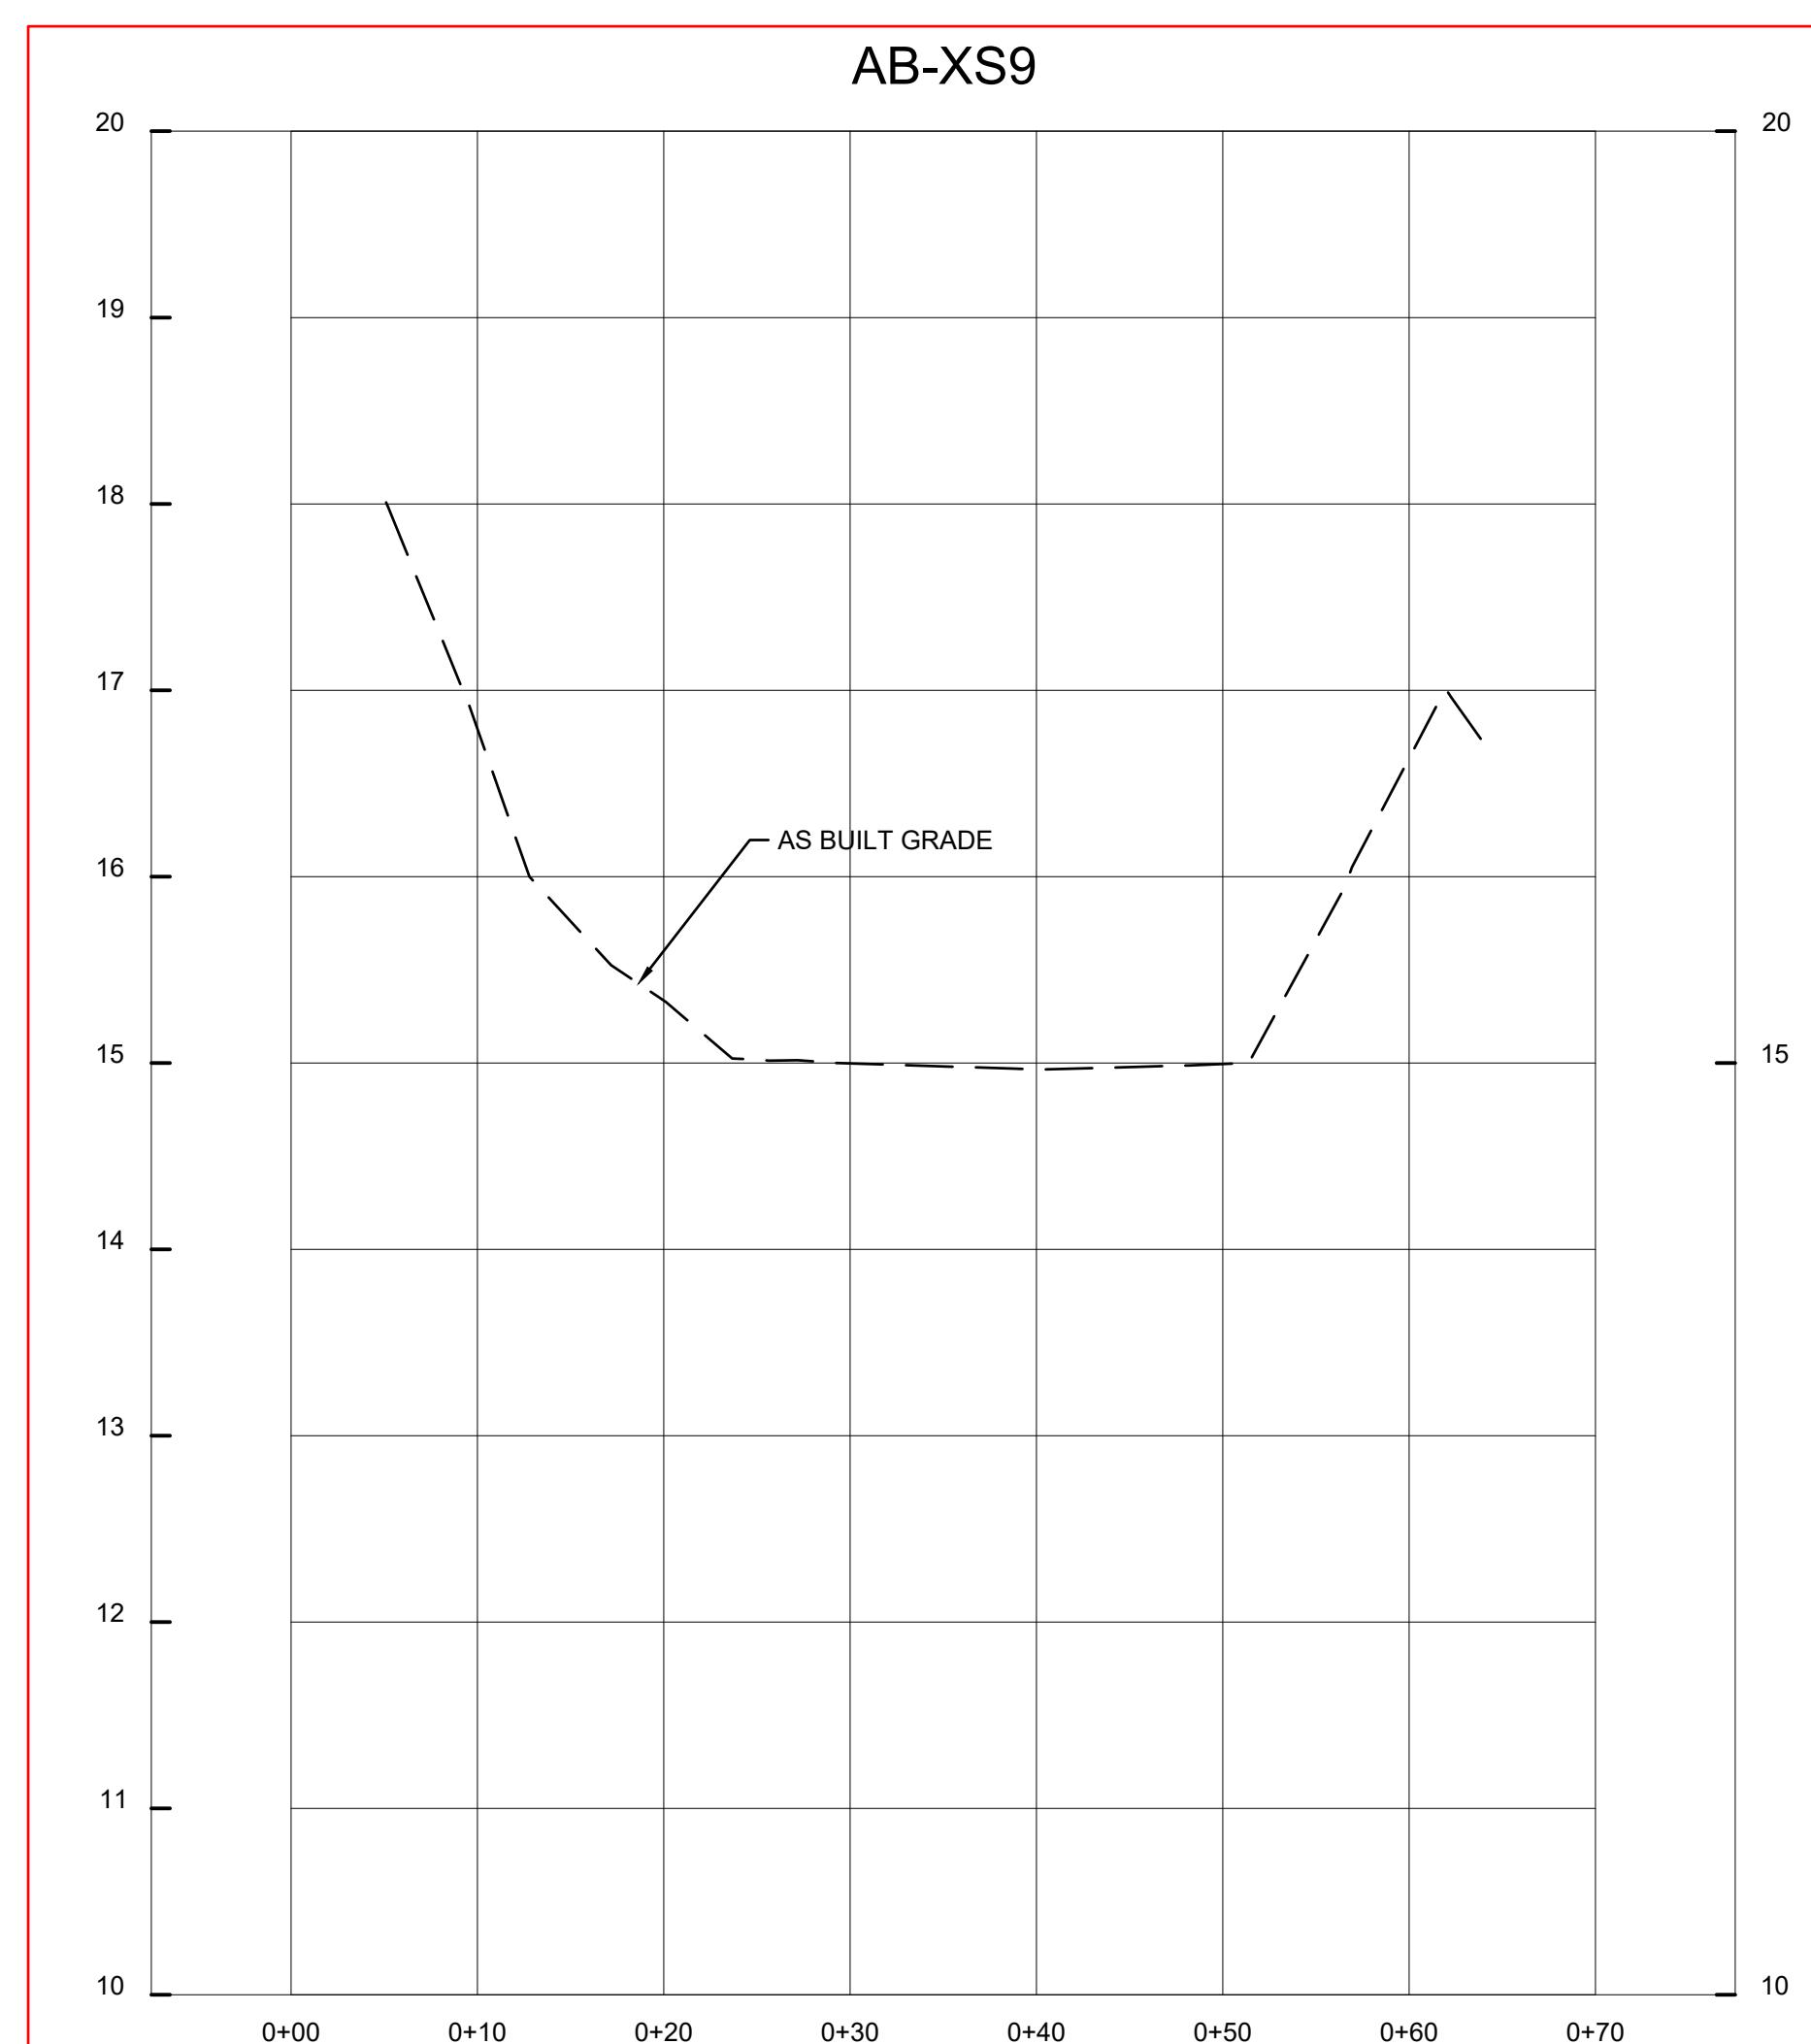

HORIZ: 1" = 10'
VERT: 1" = 1'

AS-BUILT AB-11

OWNER/DEVELOPER/APPLICANT  717-627-4440 fax: 717-627-4660 landstudies.com land@landstudies.com 315 North Street Lititz, PA 17543	CIVIL ENGINEER A.A. County ID #721  2101 Galter Road Suite #340 Rockville, MD 20850 Contact: Joanne M. Cheek, Senior Associate Phone: (301) 337-2856 Fax: (301) 258-7607	Professional Certification: I hereby certify that these documents were prepared or approved by me, and that I am a duly licensed professional engineer under the laws of the State of Maryland. License No.: Expiration Date:	REVISIONS	ANNE ARUNDEL COUNTY DEPARTMENT OF PUBLIC WORKS STREAM RESTORATION PLAN							
			NO	Description	BY	DATE	APPROVED	DATE	APPROVED	DATE	SCALE: As Shown
			1	Revise 100-yr floodplain	LSI/ DEW	1/2021					DRAWN BY: B.J./R. Anchors
			2	ADDRESSED AA COUNTY COMMENTS	CG/ DEW	9/07/22					CHECKED BY: J. Cheek
			3	ADDRESSED AA COUNTY COMMENTS	LSI/ DEW	11/01/22					SHEET NO: 11 OF 39
			4	ADDRESSED AA COUNTY COMMENTS	LSI/ DEW	01/10/23					PROJECT NO: 50017963
							CHIEF ENGINEER	PROJECT MANAGER			
							APPROVED	DATE	APPROVED	DATE	
							ASSISTANT CHIEF ENGINEER		CHIEF, RIGHT OF WAY		PROPOSAL NO:
											3rd District
SLOOP COVE RETROFIT SITE 1 Tax Map 16 Grid 05											
Anne Arundel County											

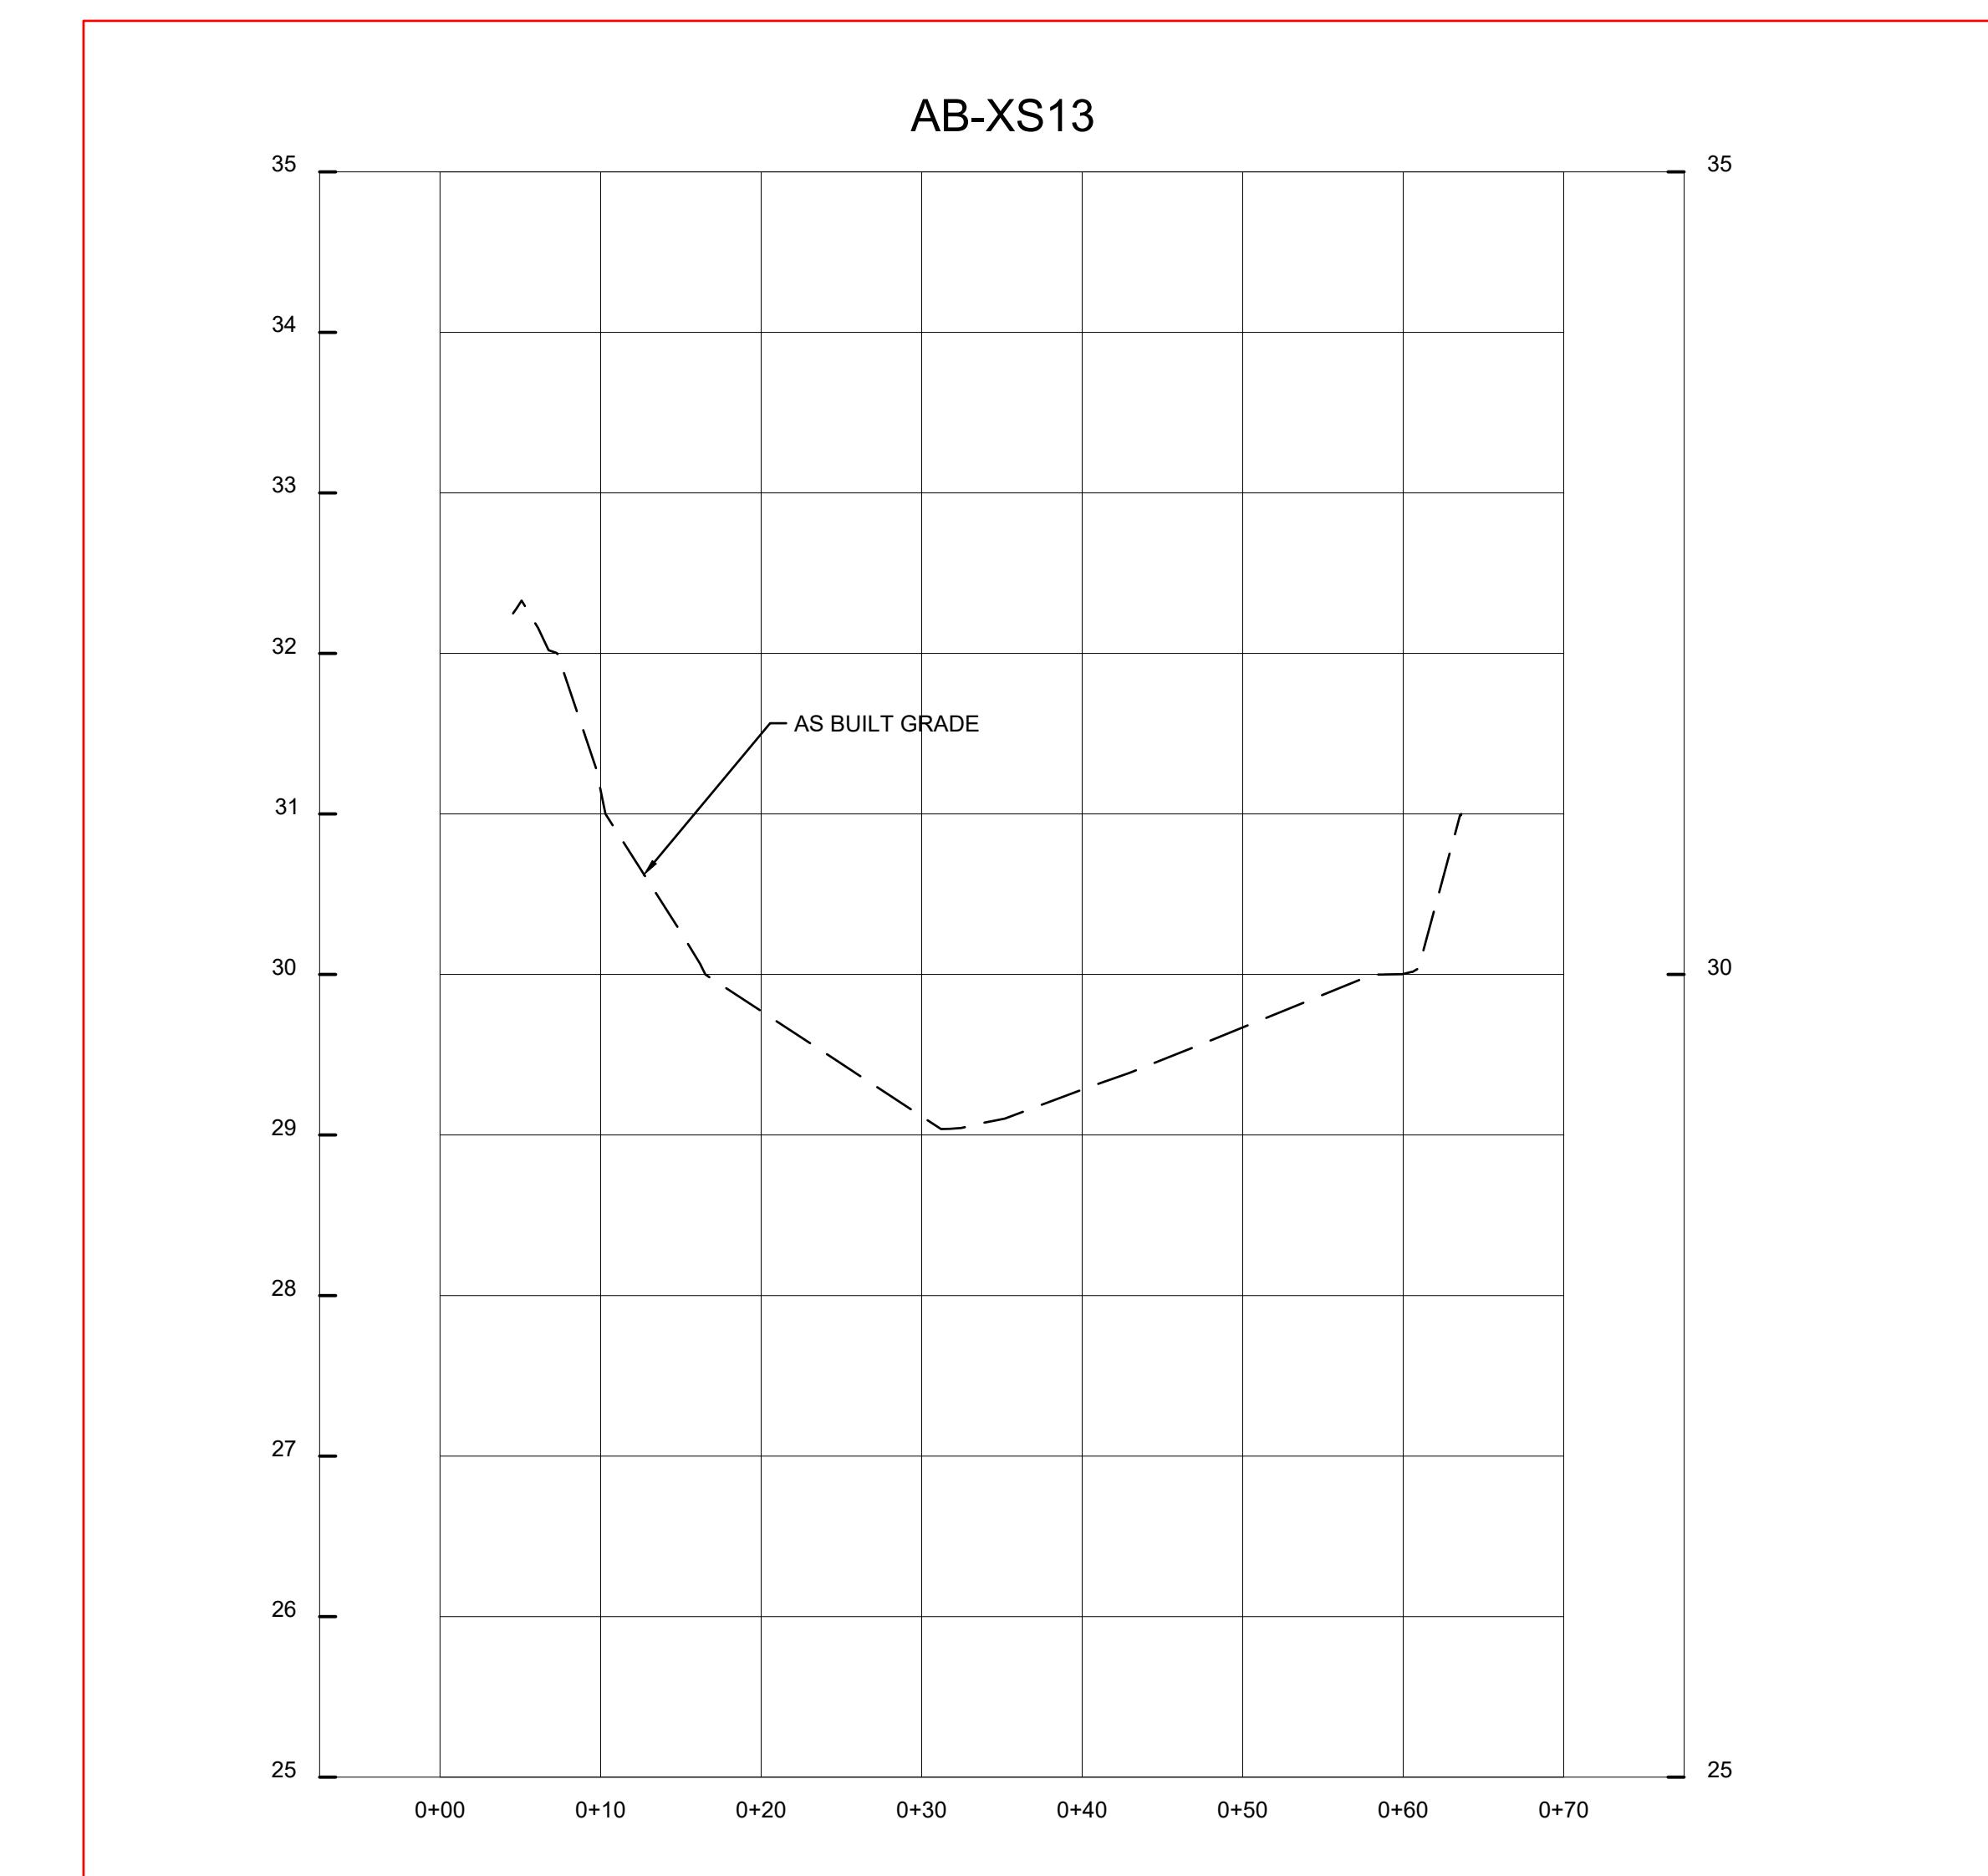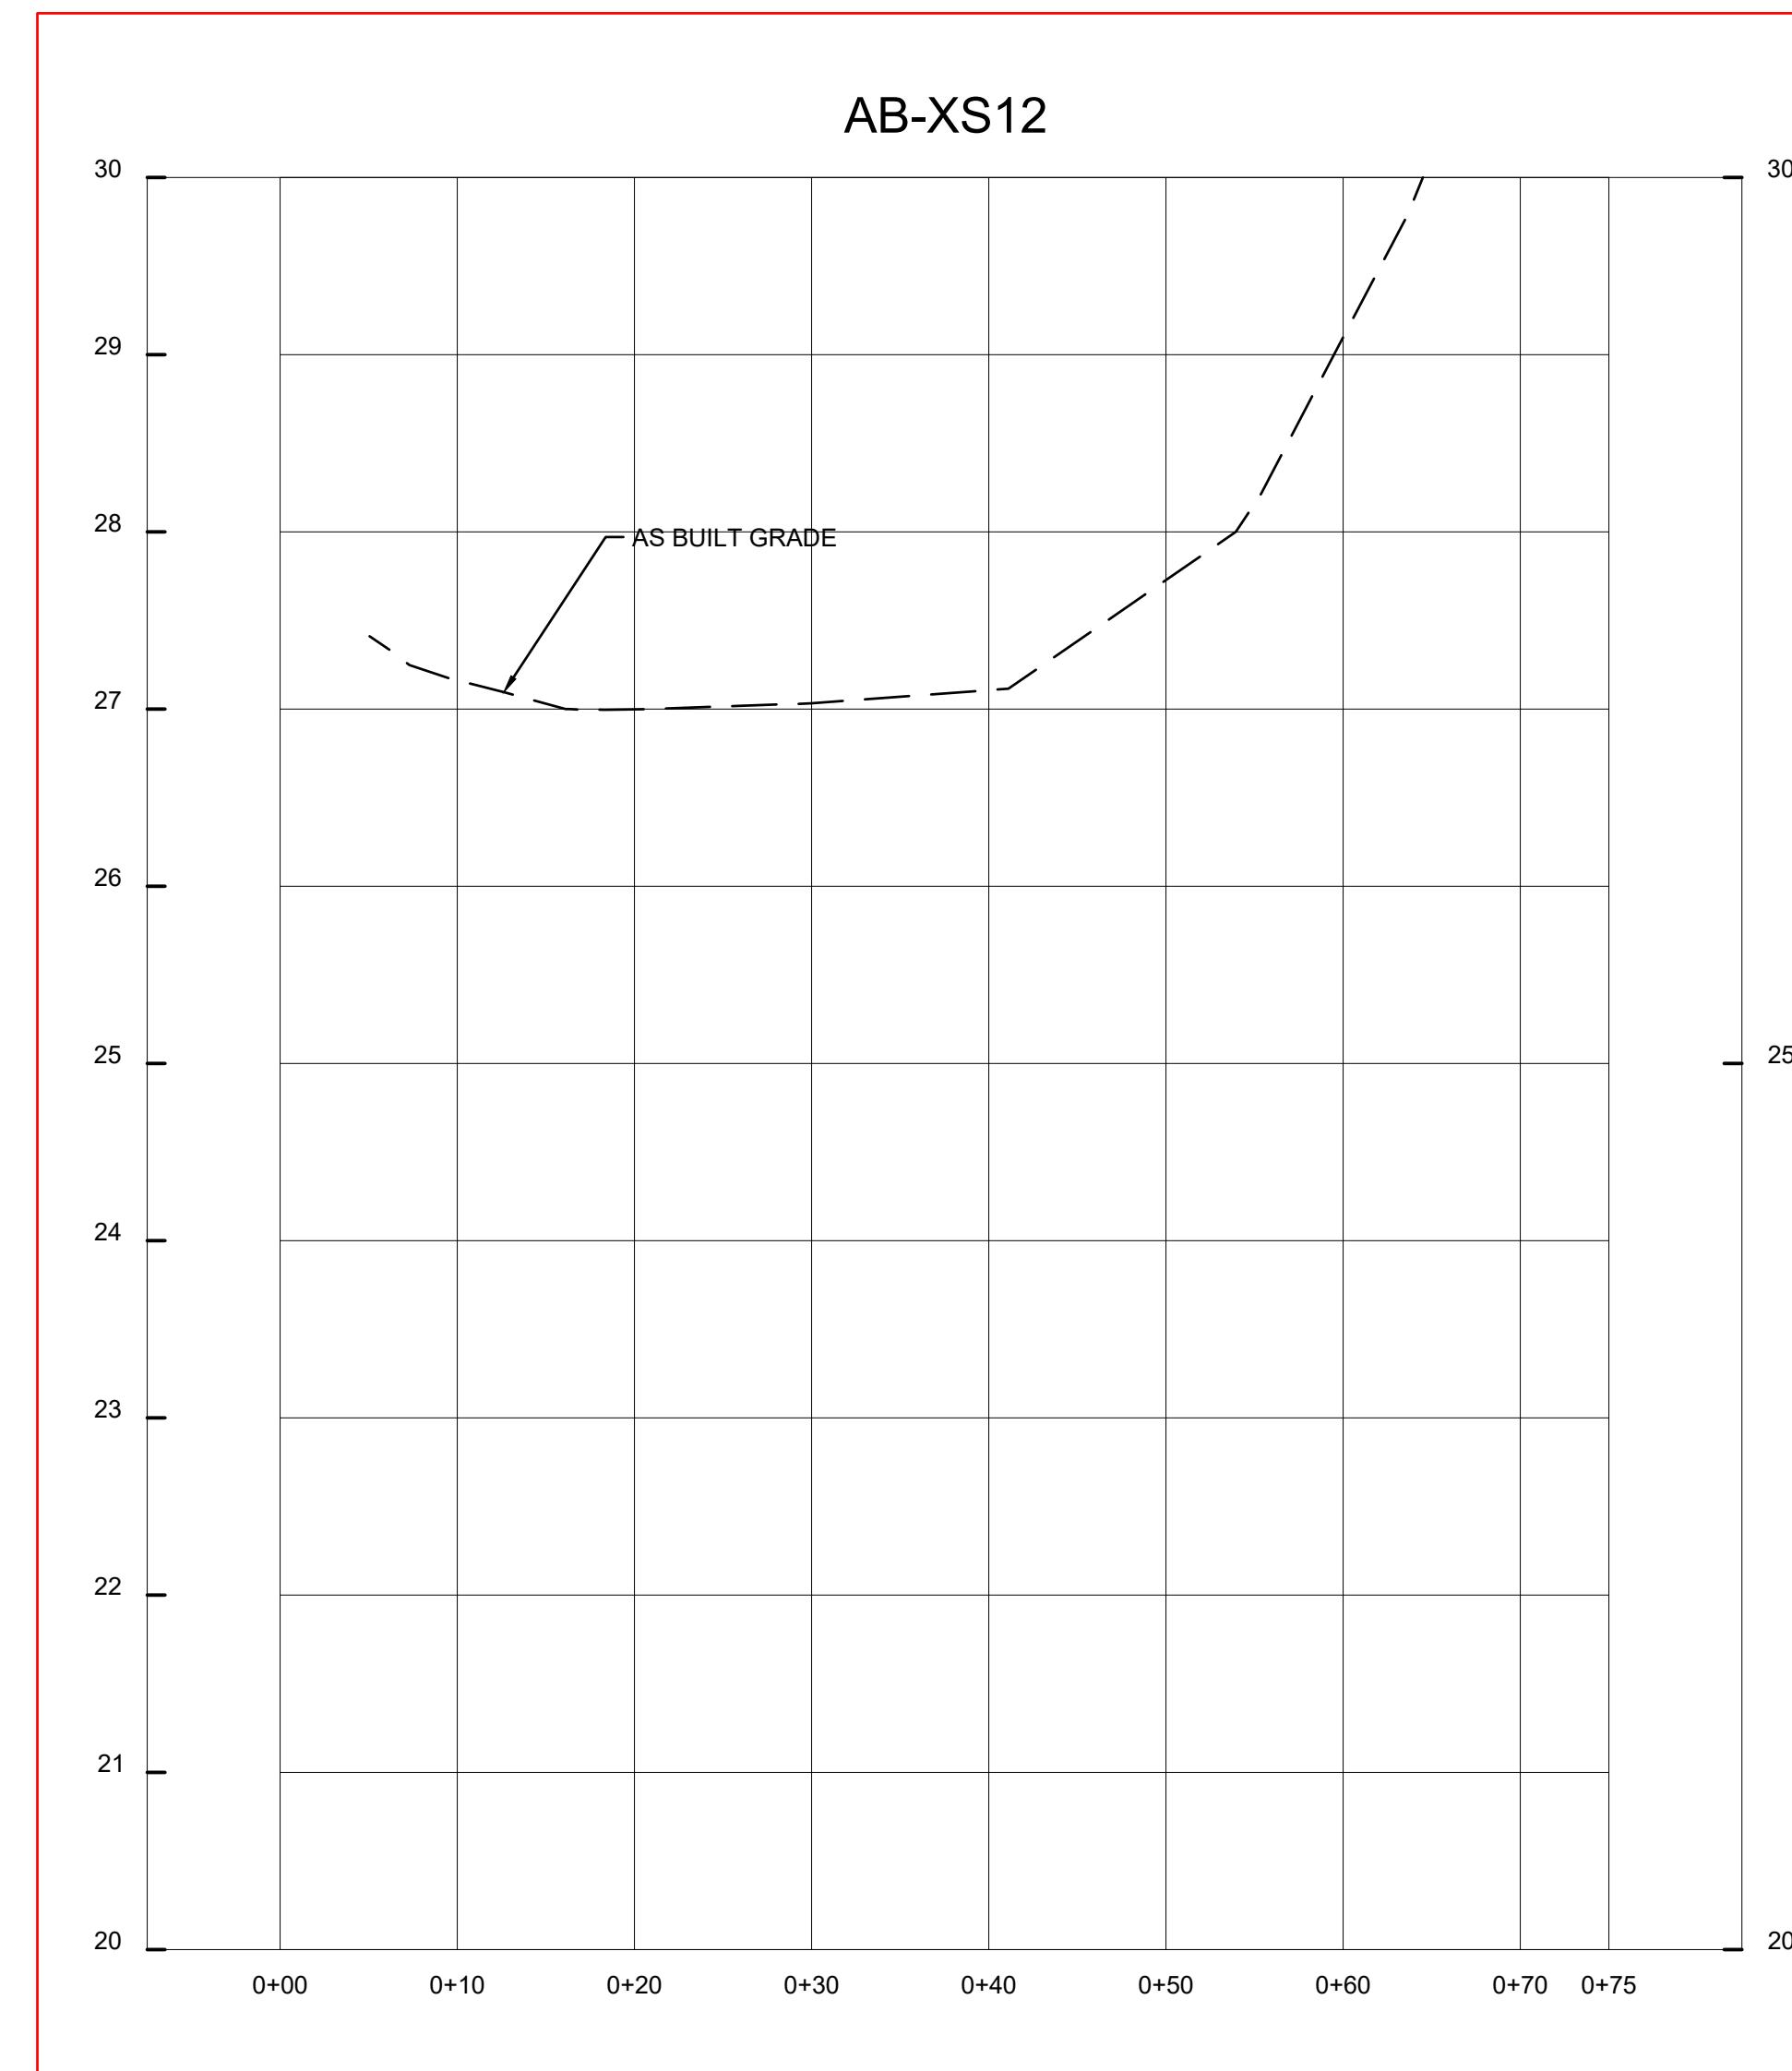

OWNER/DEVELOPER/APPLICANT		CIVIL ENGINEER A.A. County ID #721		REVISIONS		ANNE ARUNDEL COUNTY DEPARTMENT OF PUBLIC WORKS STREAM RESTORATION PLAN							
 717-627-4440 fax: 717-627-4660 landstudies.com land@landstudies.com 315 North Street Lititz, PA 17543		 Dewberry 2101 Galther Road Suite #340 Rockville, MD 20850 Contact: Joanne M. Cheek, Senior Associate Phone: (301) 337-2856 Fax: (301) 258-7607		Professional Certification: I hereby certify that these documents were prepared or approved by me, and that I am a duly licensed professional engineer under the laws of the State of Maryland. License No.: Expiration Date:		NO 1 2 3 4		Description Revise 100-yr. floodplain ADDRESSED AA COUNTY COMMENTS ADDRESSED AA COUNTY COMMENTS ADDRESSED AA COUNTY COMMENTS		BY LSI/ DEW CG/ DEW LSI/ DEW LSI/ DEW		DATE 1/2021 9/07/22 11/01/22 01/10/23	
						APPROVED CHIEF ENGINEER		APPROVED PROJECT MANAGER		APPROVED ASSISTANT CHIEF ENGINEER			
						DATE APPROVED DATE		DATE APPROVED DATE		DATE CHIEF, RIGHT OF WAY			
										SCALE: As Shown DRAWN BY: B.J. /R. Anchors CHECKED BY: J. Cheek SHEET NO: 12 OF 39 PROJECT NO: 50017963 PROPOSAL NO: 3rd District Tax Map 16 Grid 05 Anne Arundel County			

HORIZ: 1" = 10'
VERT: 1" = 1'




AS-BUILT AB-12

13

SLOOP COVE RETROFIT SITE 1

Tax Map 16 Grid 05

Anne Arundel County

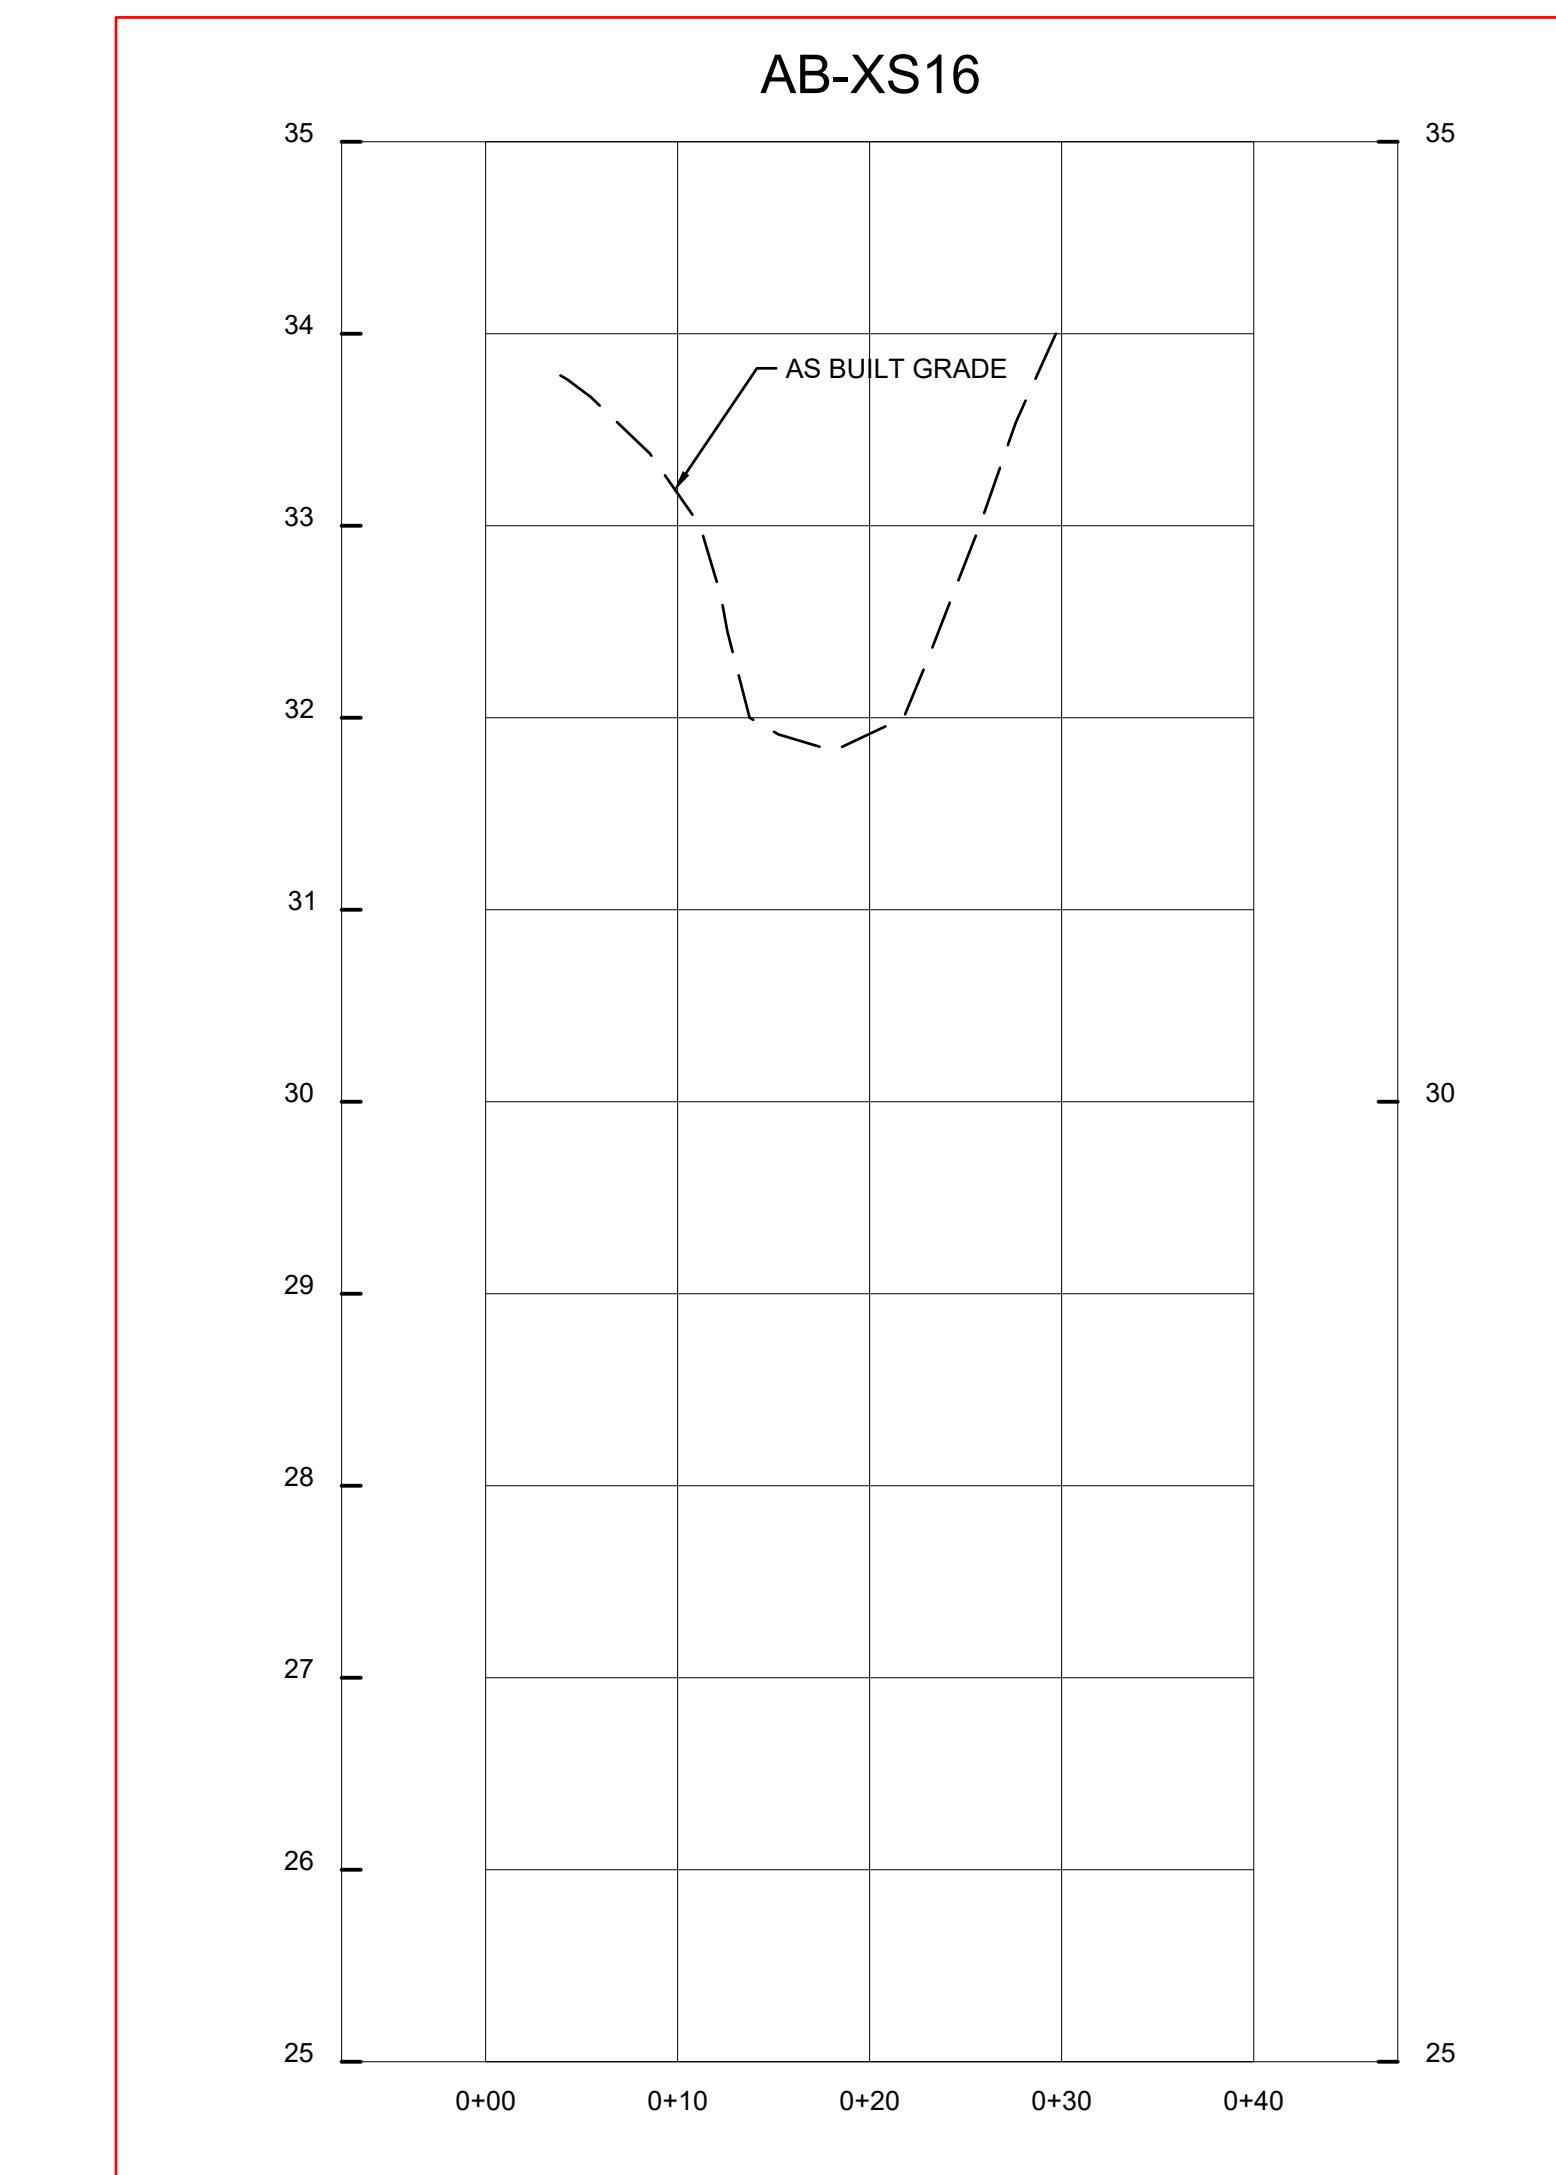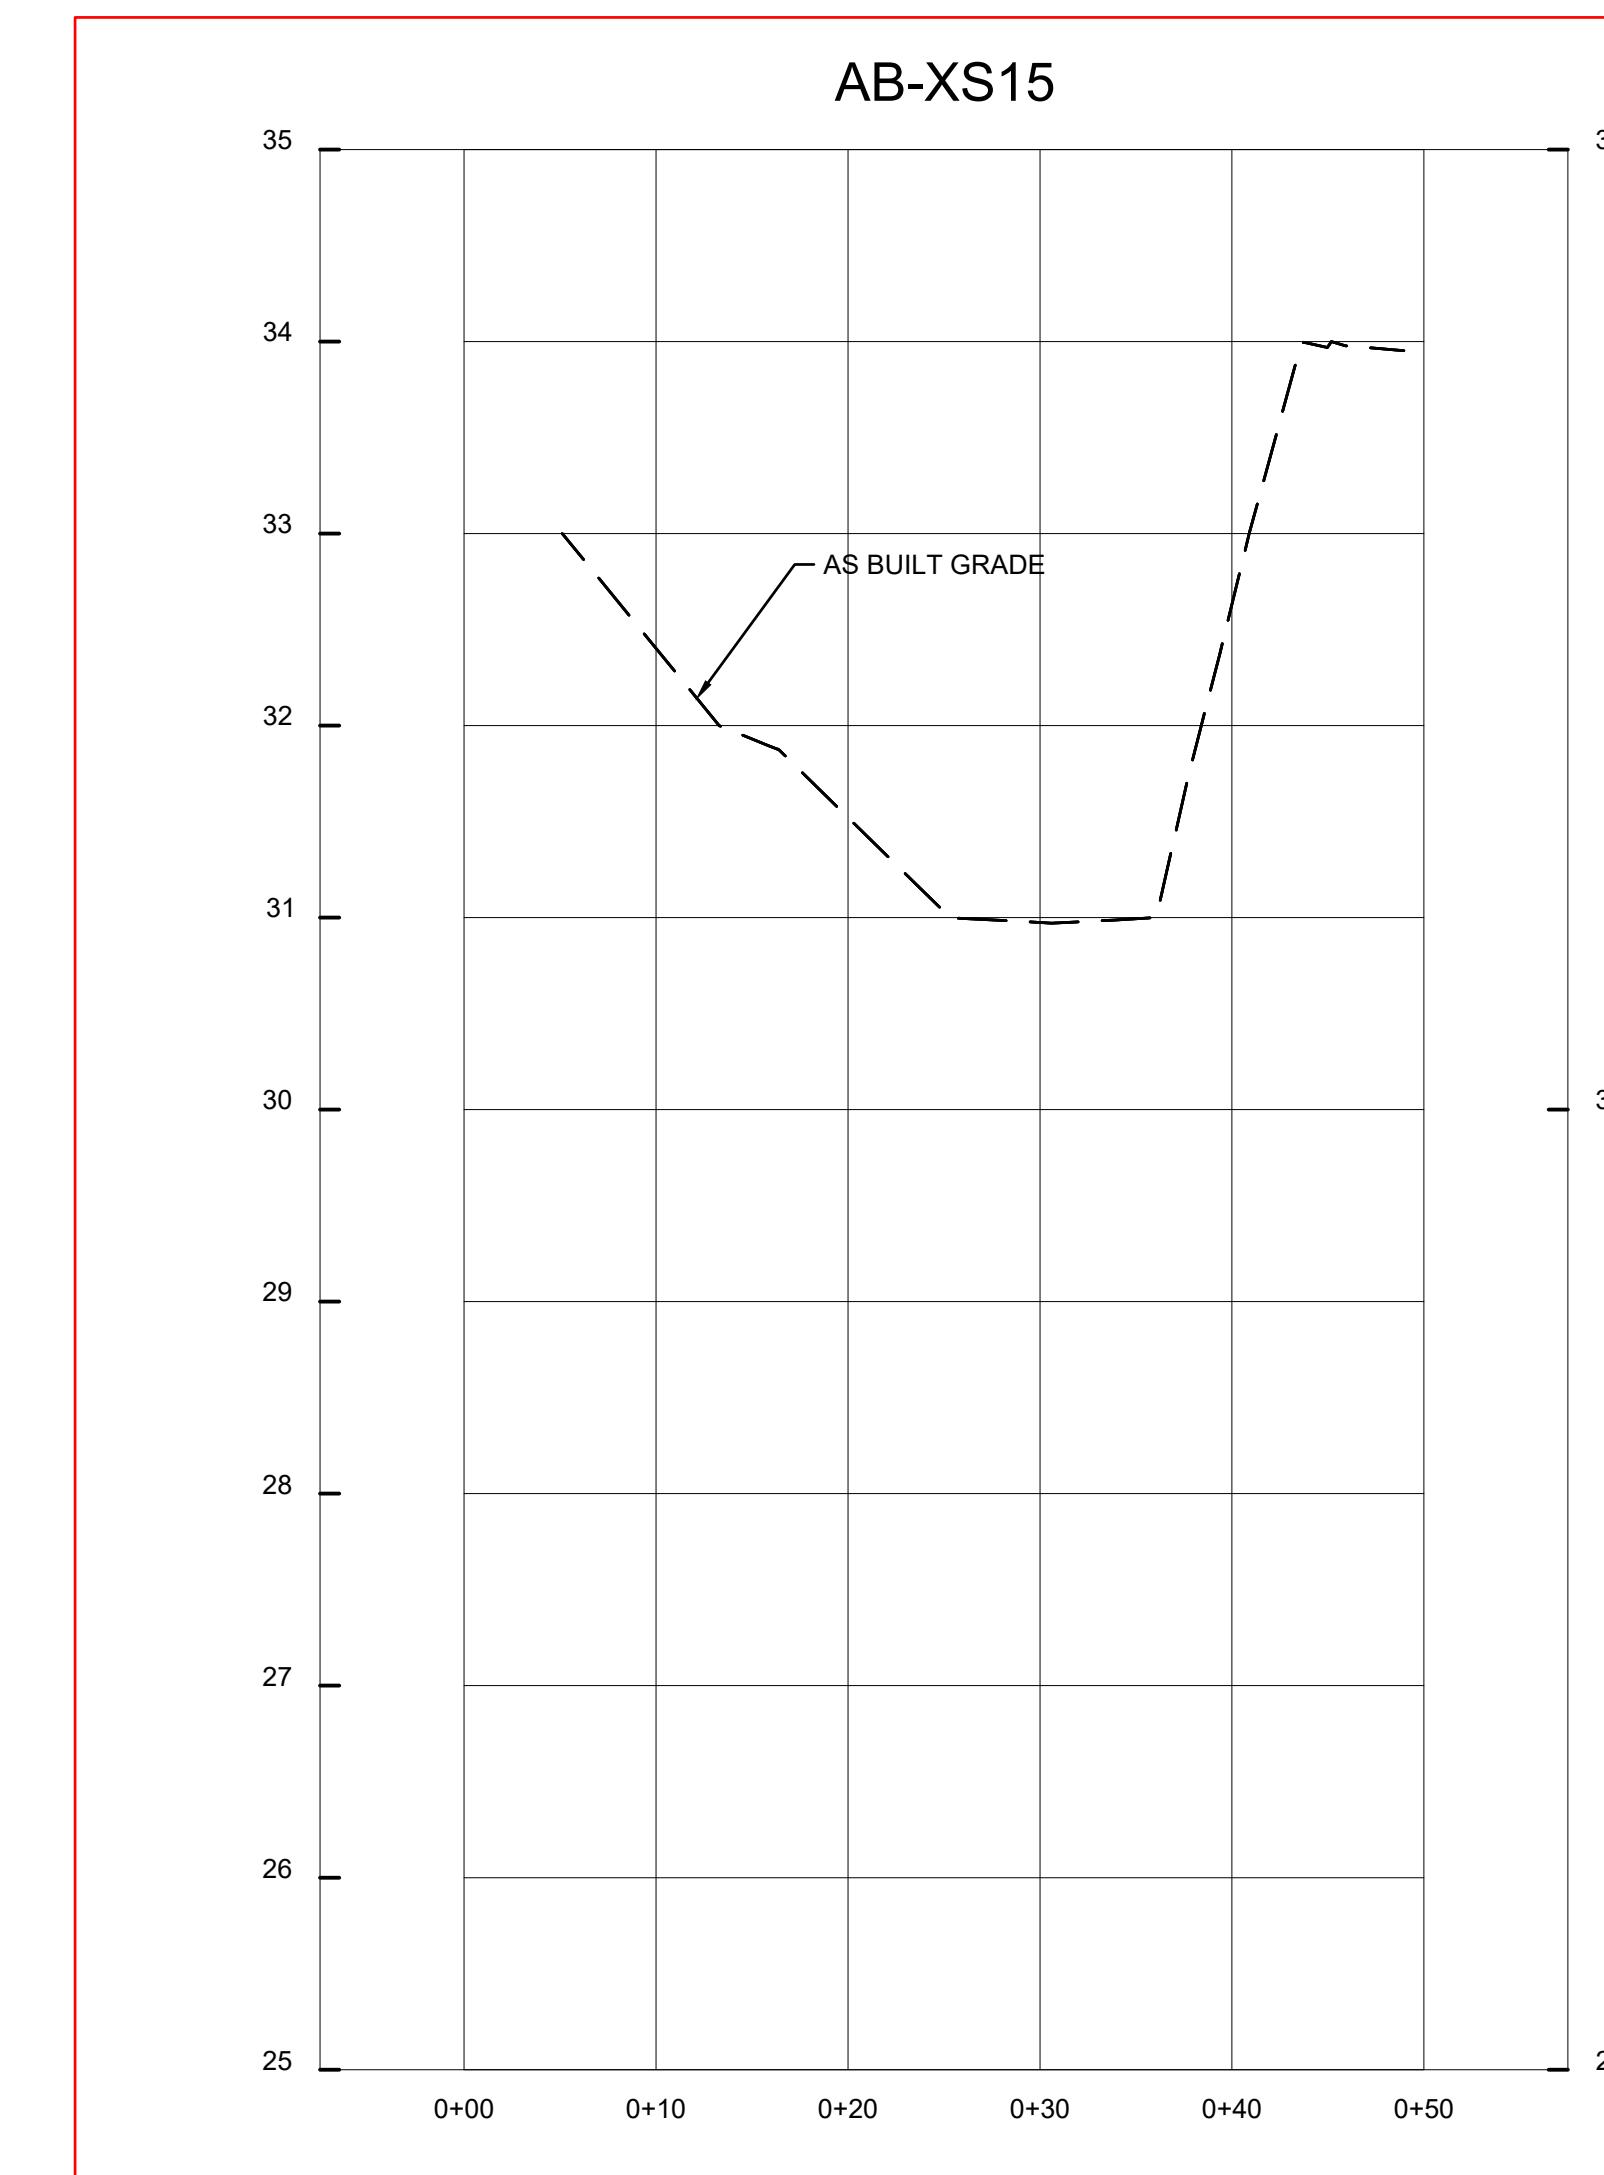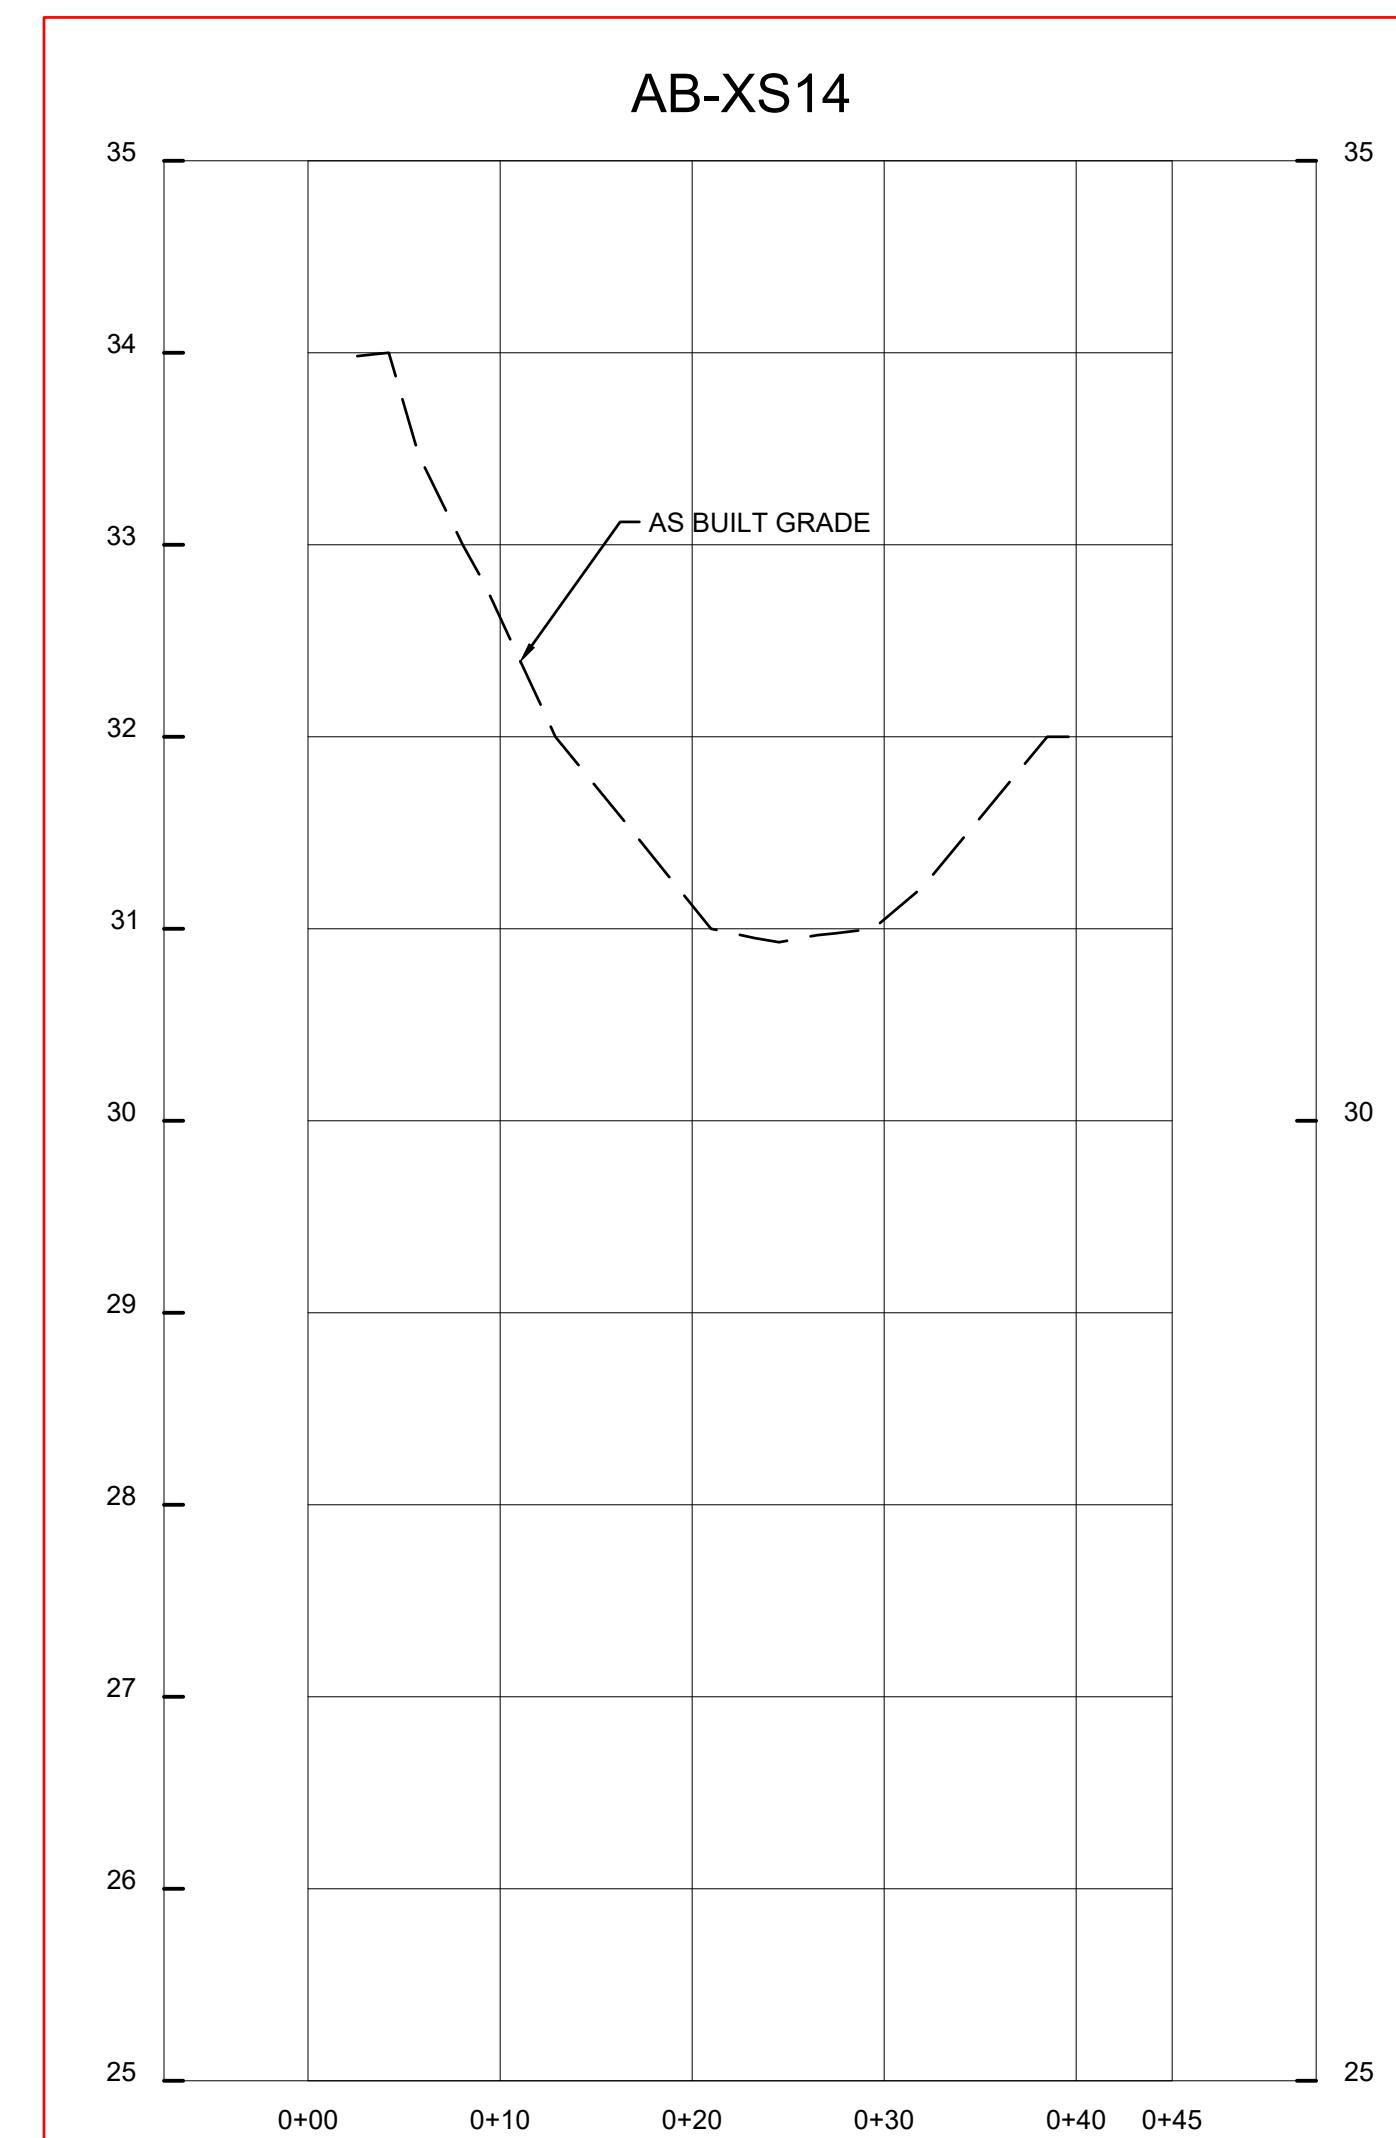

HORIZ: 1" = 10'
VERT: 1" = 1'

AS-BUILT AB-13

OWNER/DEVELOPER/APPLICANT  717-627-4440 fax: 717-627-4660 landstudies.com land@landstudies.com 315 North Street Lititz, PA 17543	CIVIL ENGINEER A.A. County ID #721  2101 Galther Road Suite #340 Rockville, MD 20850 Contact: Joanne M. Cheek, Senior Associate Phone: (301) 337-2856 Fax: (301) 258-7607	Professional Certification: I hereby certify that these documents were prepared or approved by me, and that I am a duly licensed professional engineer under the laws of the State of Maryland. License No.: Expiration Date:	REVISIONS	ANNE ARUNDEL COUNTY DEPARTMENT OF PUBLIC WORKS STREAM RESTORATION PLAN									
			NO	Description	BY	DATE	APPROVED	DATE	APPROVED	DATE	SCALE:	As Shown	
			1	Revise 100-yr floodplain	LSI/ DEW	1/2021					DRAWN BY:	B.J. R. Anchors	
			2	ADDRESSED AA COUNTY COMMENTS	CG/ DEW	9/07/22					CHECKED BY:	J. Cheek	
			3	ADDRESSED AA COUNTY COMMENTS	LSI/ DEW	11/01/22					SHEET NO.:	13 OF 39	
			4	ADDRESSED AA COUNTY COMMENTS	LSI/ DEW	01/10/23					PROJECT NO.:	50017963	
							CHIEF ENGINEER	PROJECT MANAGER					
							APPROVED	DATE	APPROVED	DATE			
							CHIEF, RIGHT OF WAY						
							ASSISTANT CHIEF ENGINEER						
3rd District												Tax Map 16 Grid 05	
Anne Arundel County												G02016740	